



NORTH

AS BUILT FLOOR PLAN

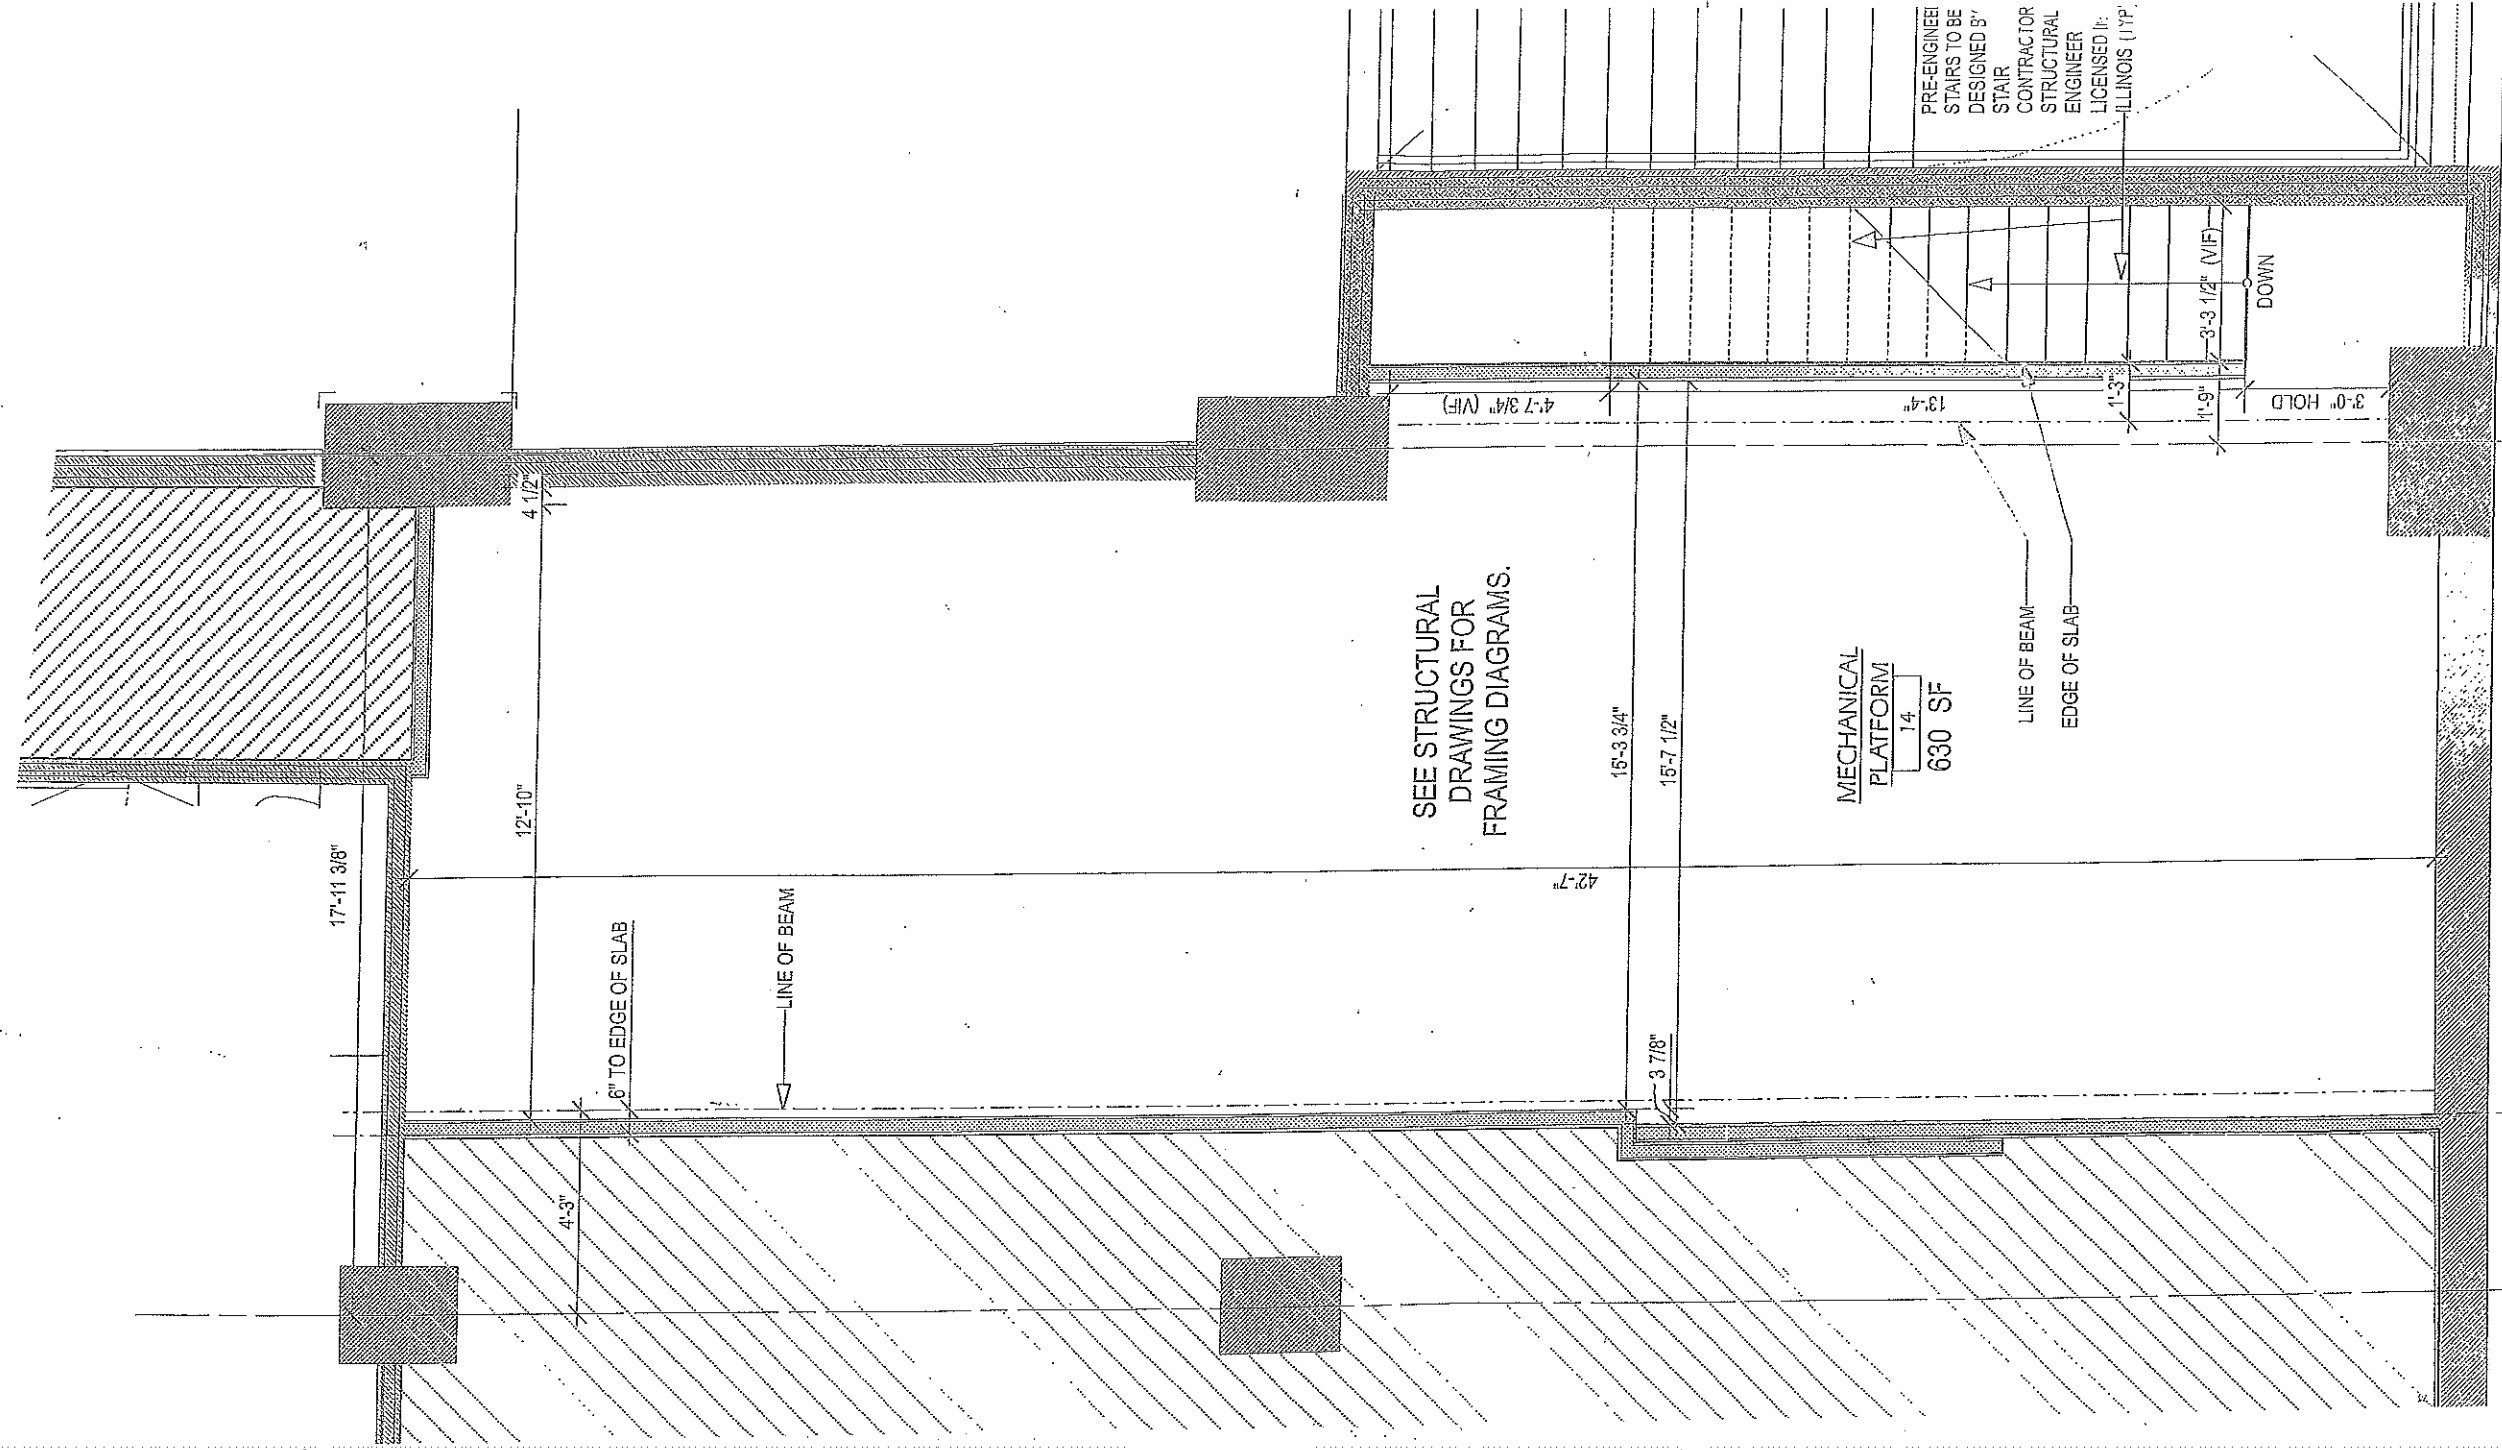

SEE STRUCTURAL DRAWINGS FOR FRAMING DIAGRAMS.

PRE-ENGINEER STAIRS TO BE DESIGNED BY STAIR CONTRACTOR STRUCTURAL ENGINEER LICENSED IN ILLINOIS (IYP)

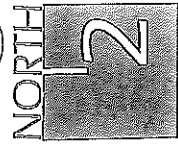

MECHANICAL MEZZANINE PLATFORM

SCALE: 1/4" = 1'-0"