

PREPARED FOR

Weichert Raines

PROJECT TYPE

FLOOR PLAN


PROJECT NAME

17475 Jovanna Drive

PROJECT ADDRESS

17475 Jovanna Drive,
 Homewood, IL

All floor plans created by Best FloorPlans, Inc. are intended to be used as a reference for design and construction and should not be considered a substitute for the services of a licensed structural engineer or licensed architect. Best FloorPlans, Inc. makes every reasonable effort to ensure the accuracy of the information found in our plans. However, every As-Built drawing inherently contains errors to some degree. It is the duty of the architect, contractor, designer or other licensed professional, as a consultant to the property owner, to determine the suitability of the As-Built plans prior to construction. Measurements should be field confirmed before commencing construction.

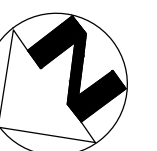

SCALE
 1/8" = 1'-0"


PROJECT
 10437

APPROVED BY
 MT

DATE
 08/26/21

SHEET

Unit 1D

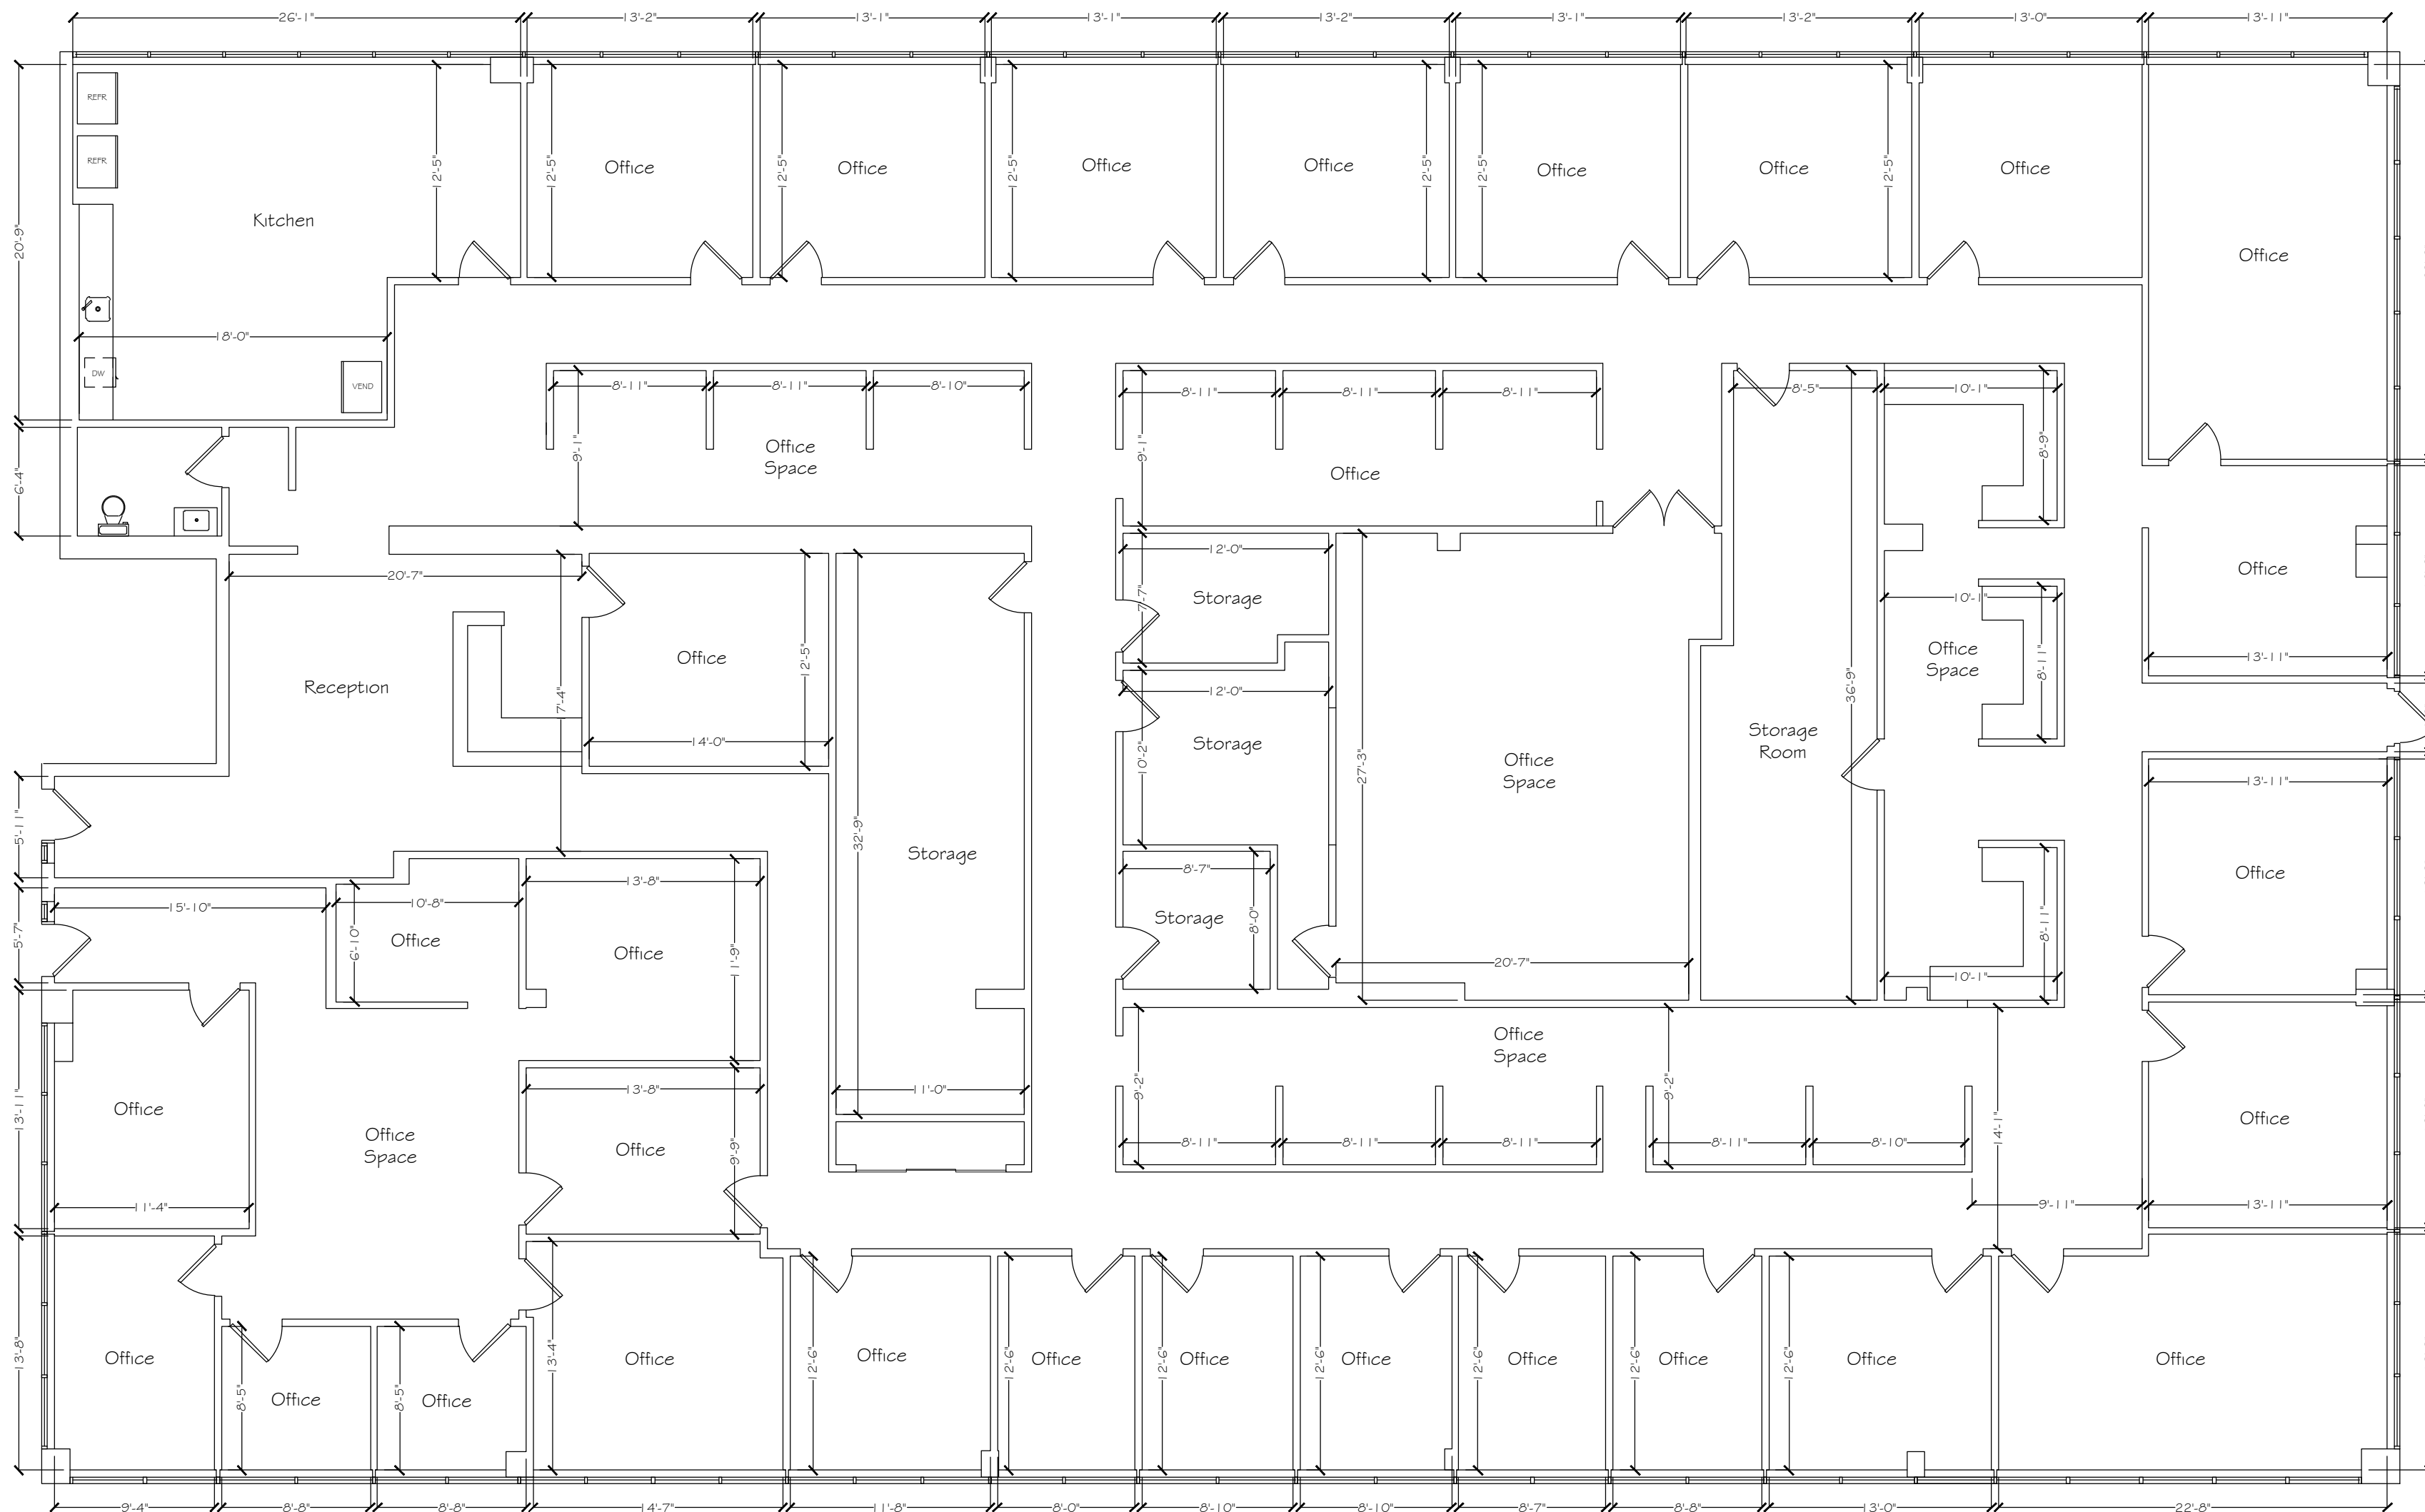

First Level - Unit 1D

SCALE: 1/8" = 1'-0"