


27'-4"

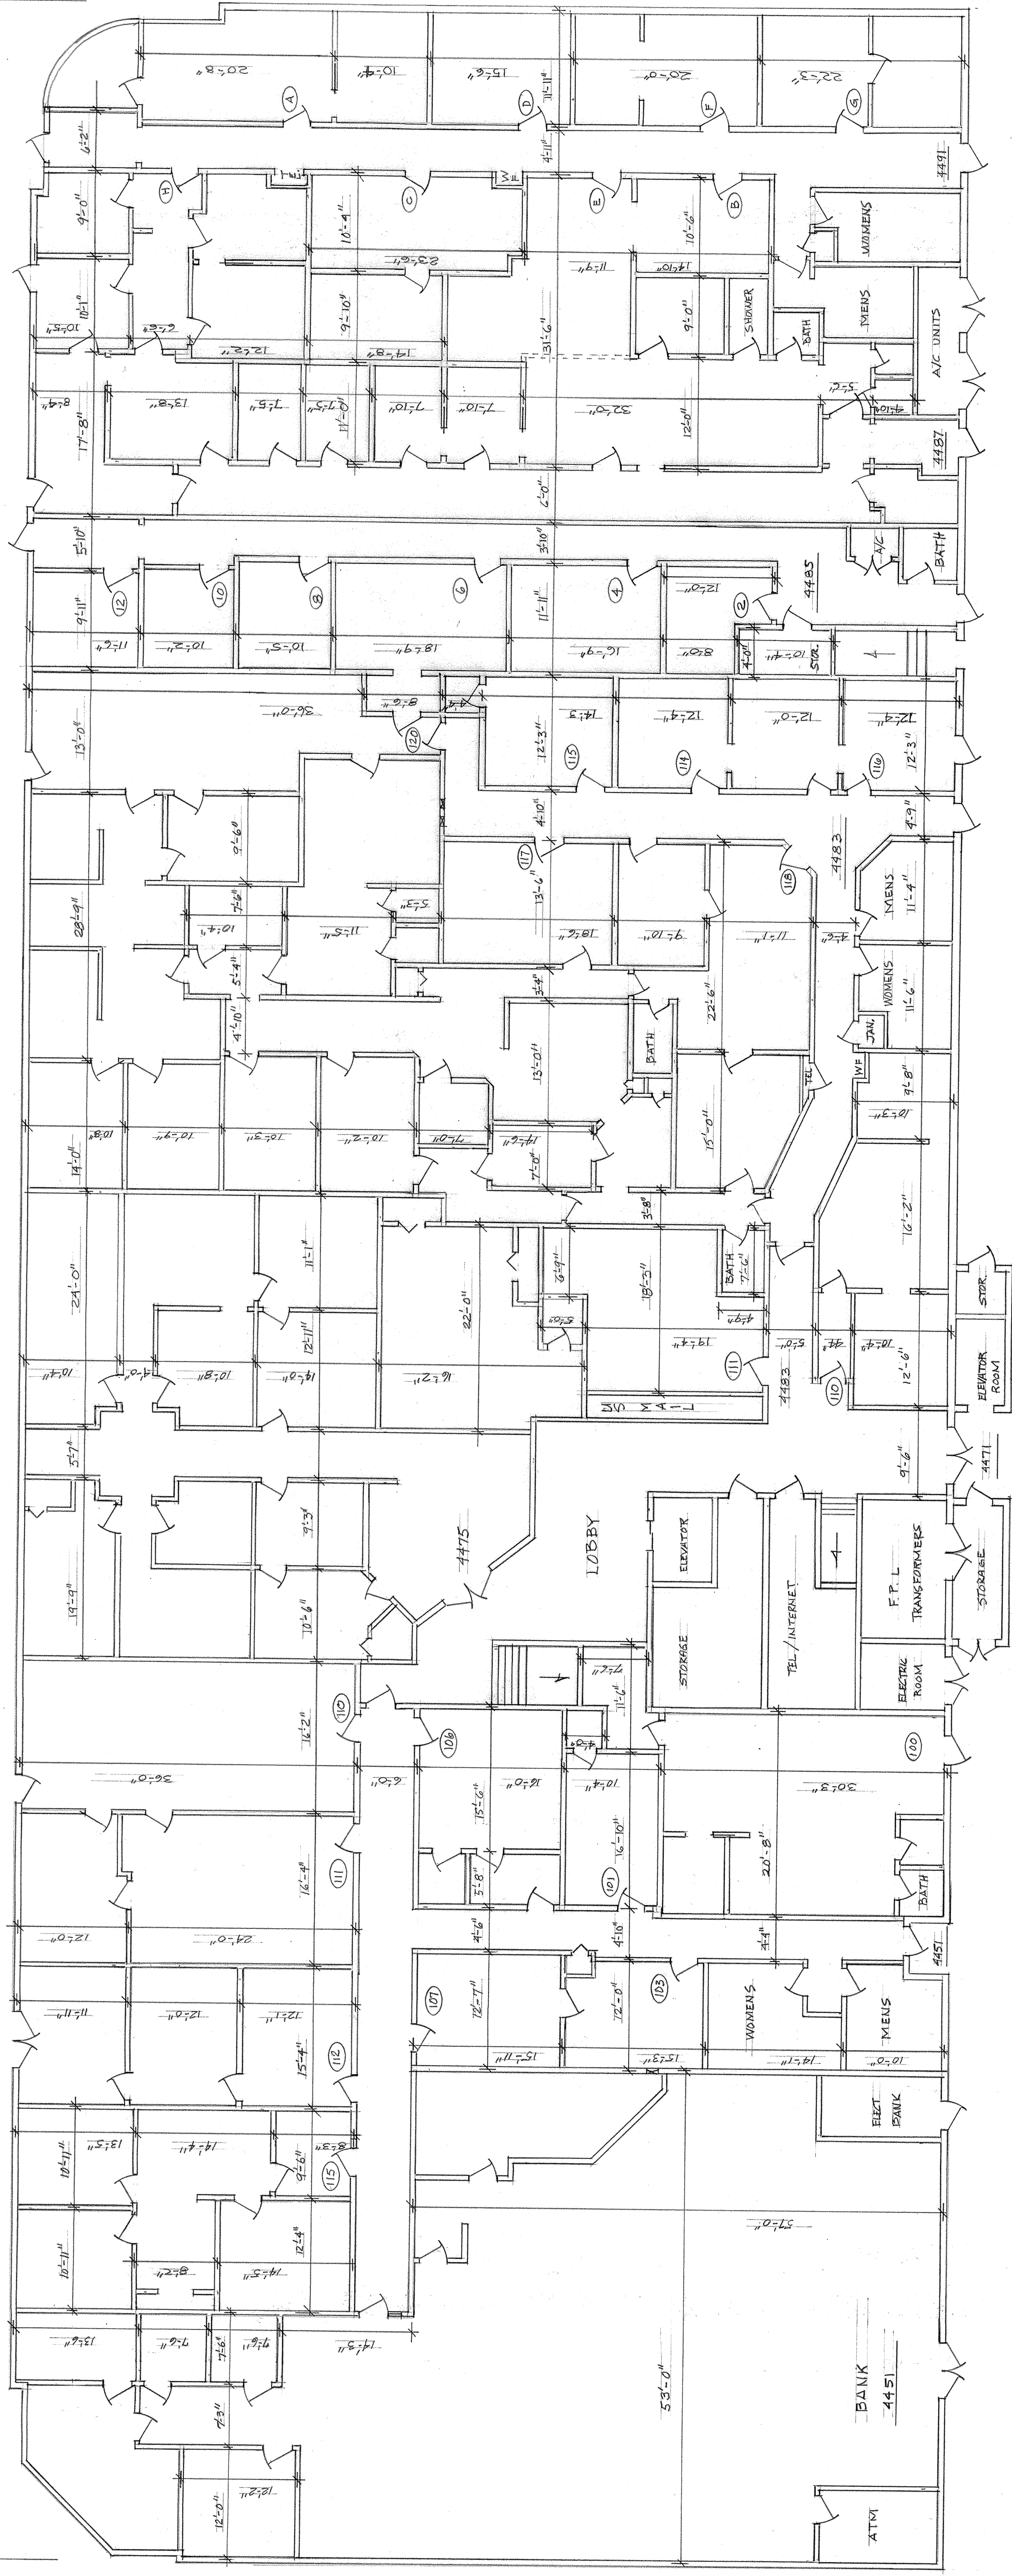

AS BUILT LAYOUT - FIRST FLOOR MIAMI SPRINGS OFFICE PLAZA

SCALE: 1/8" = 1'-0"

SUITE	SIZE	Sq. FOOTAGE	SUITE	SIZE	Sq. FOOTAGE	SUITE	SIZE	Sq. FOOTAGE	SUITE	SIZE	Sq. FOOTAGE
4451	BANK	4,099.32	110	36'-0" X 16'-2"	581.97	120	11'-6" X 9'-11"	114.04	E		511.23
100		701.46	111	36'-0" X 16'-4"	587.88	4485			F	20'-0" X 11'-11"	238.33
101	16'-3" X 10'-4" X 4'-0"	187.88	112	36'-0" X 15'-4"	551.88	193	16'-9" X 11'-11"	193.60	G	22'-3" X 11'-11"	245.14
103	15'-3" X 12'-0"	179.00	115	36'-0" X 21'-10"	785.98	4	18'-9" X 11'-11"	223.43	H		435.34
106	16'-0" X 20'-2"	322.65	4475		2671.00	6	16'-5" X 11'-11"	124.13		TOTAL Sq. FOOTAGE	20,682.65
107	15'-11" X 12'-7"	200.28	4483		470.60	8	11'-0" X 10'-2"	111.82			
			110			10		184.70			

MIAMI SPRINGS OFFICE PLAZA
4471 N.W. 36 STREET
REV: 9-9-13
SCALE: 1/8" = 1'-0"
SHEET 1 OF 2

FIRST FLOOR TOTAL Sq. FT. 27,400.00
SUITES 21,579.00
COMMON AREA 5,821.00