

Top: 1028.67
Invert: 1008.14

Asbuilt shows
sewer services
here and here

Top: 1042.29
Invert: 1032.82

Legend

Sewer System Valves
ValveType

- Air Relief

Sewer Manholes
ManholeType

- Standard

Sewer Gravity Mains
Diameter


- 8

Sewer Force Mains
Diameter

- 8

2 FT Contours

1 inch = 100 feet

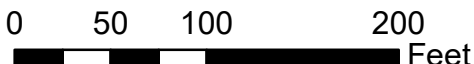

Disclaimer: The information contained herewith has been compiled from recorded deeds, plats, tax maps, surveys, and other public records, but may not reflect exact field conditions. Information is intended to be used for general locations only.