


501 W. State Street

Geneva, Illinois 60134

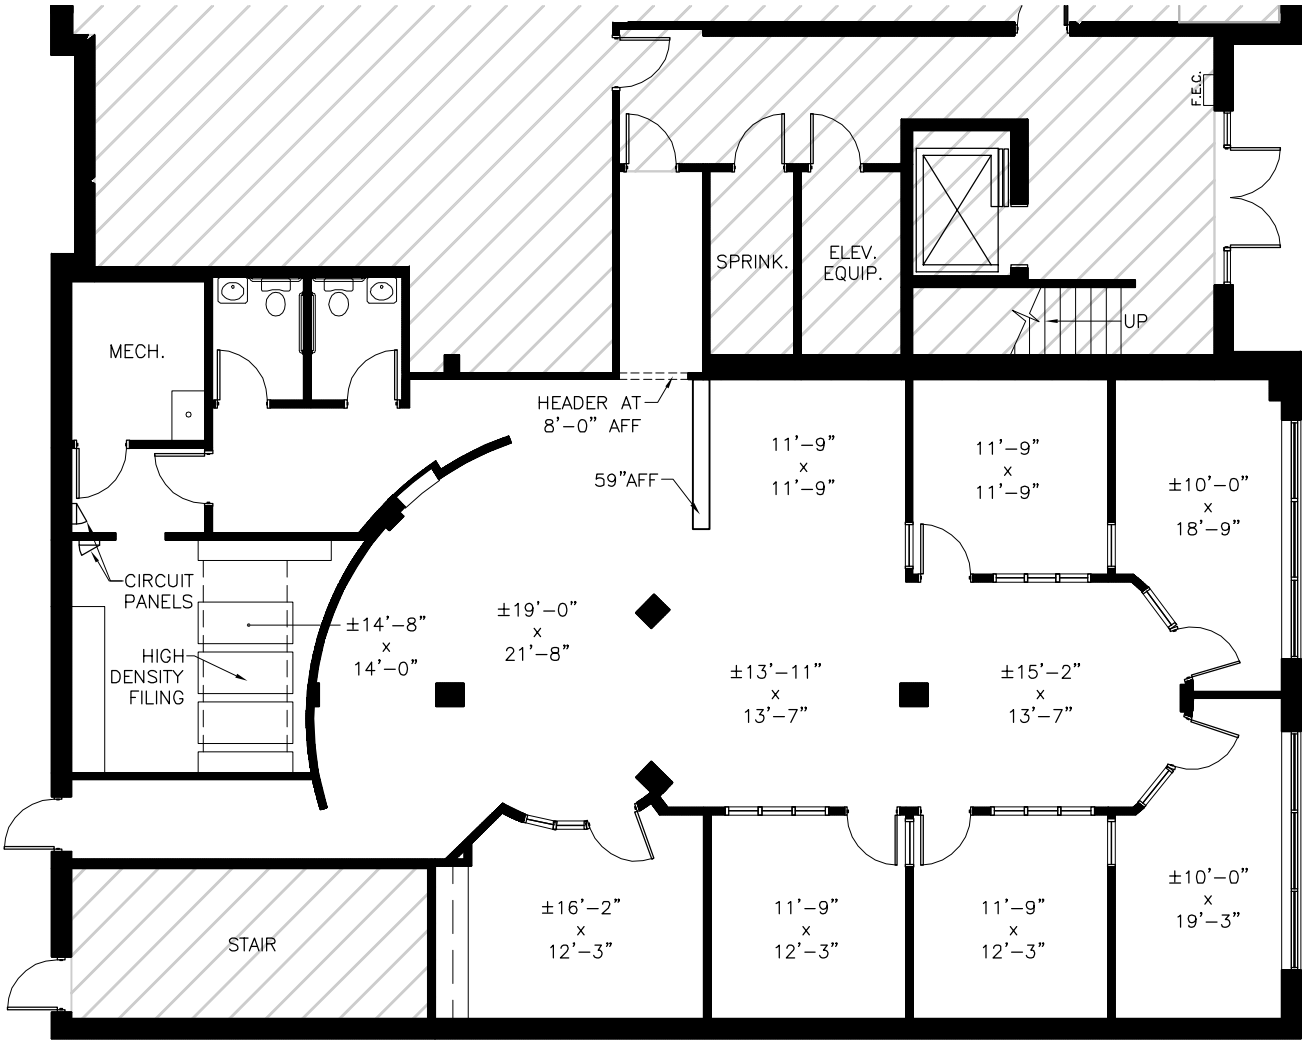

Suite # 102 - 'As-Built' Conditions

Scale: N.T.S.

