


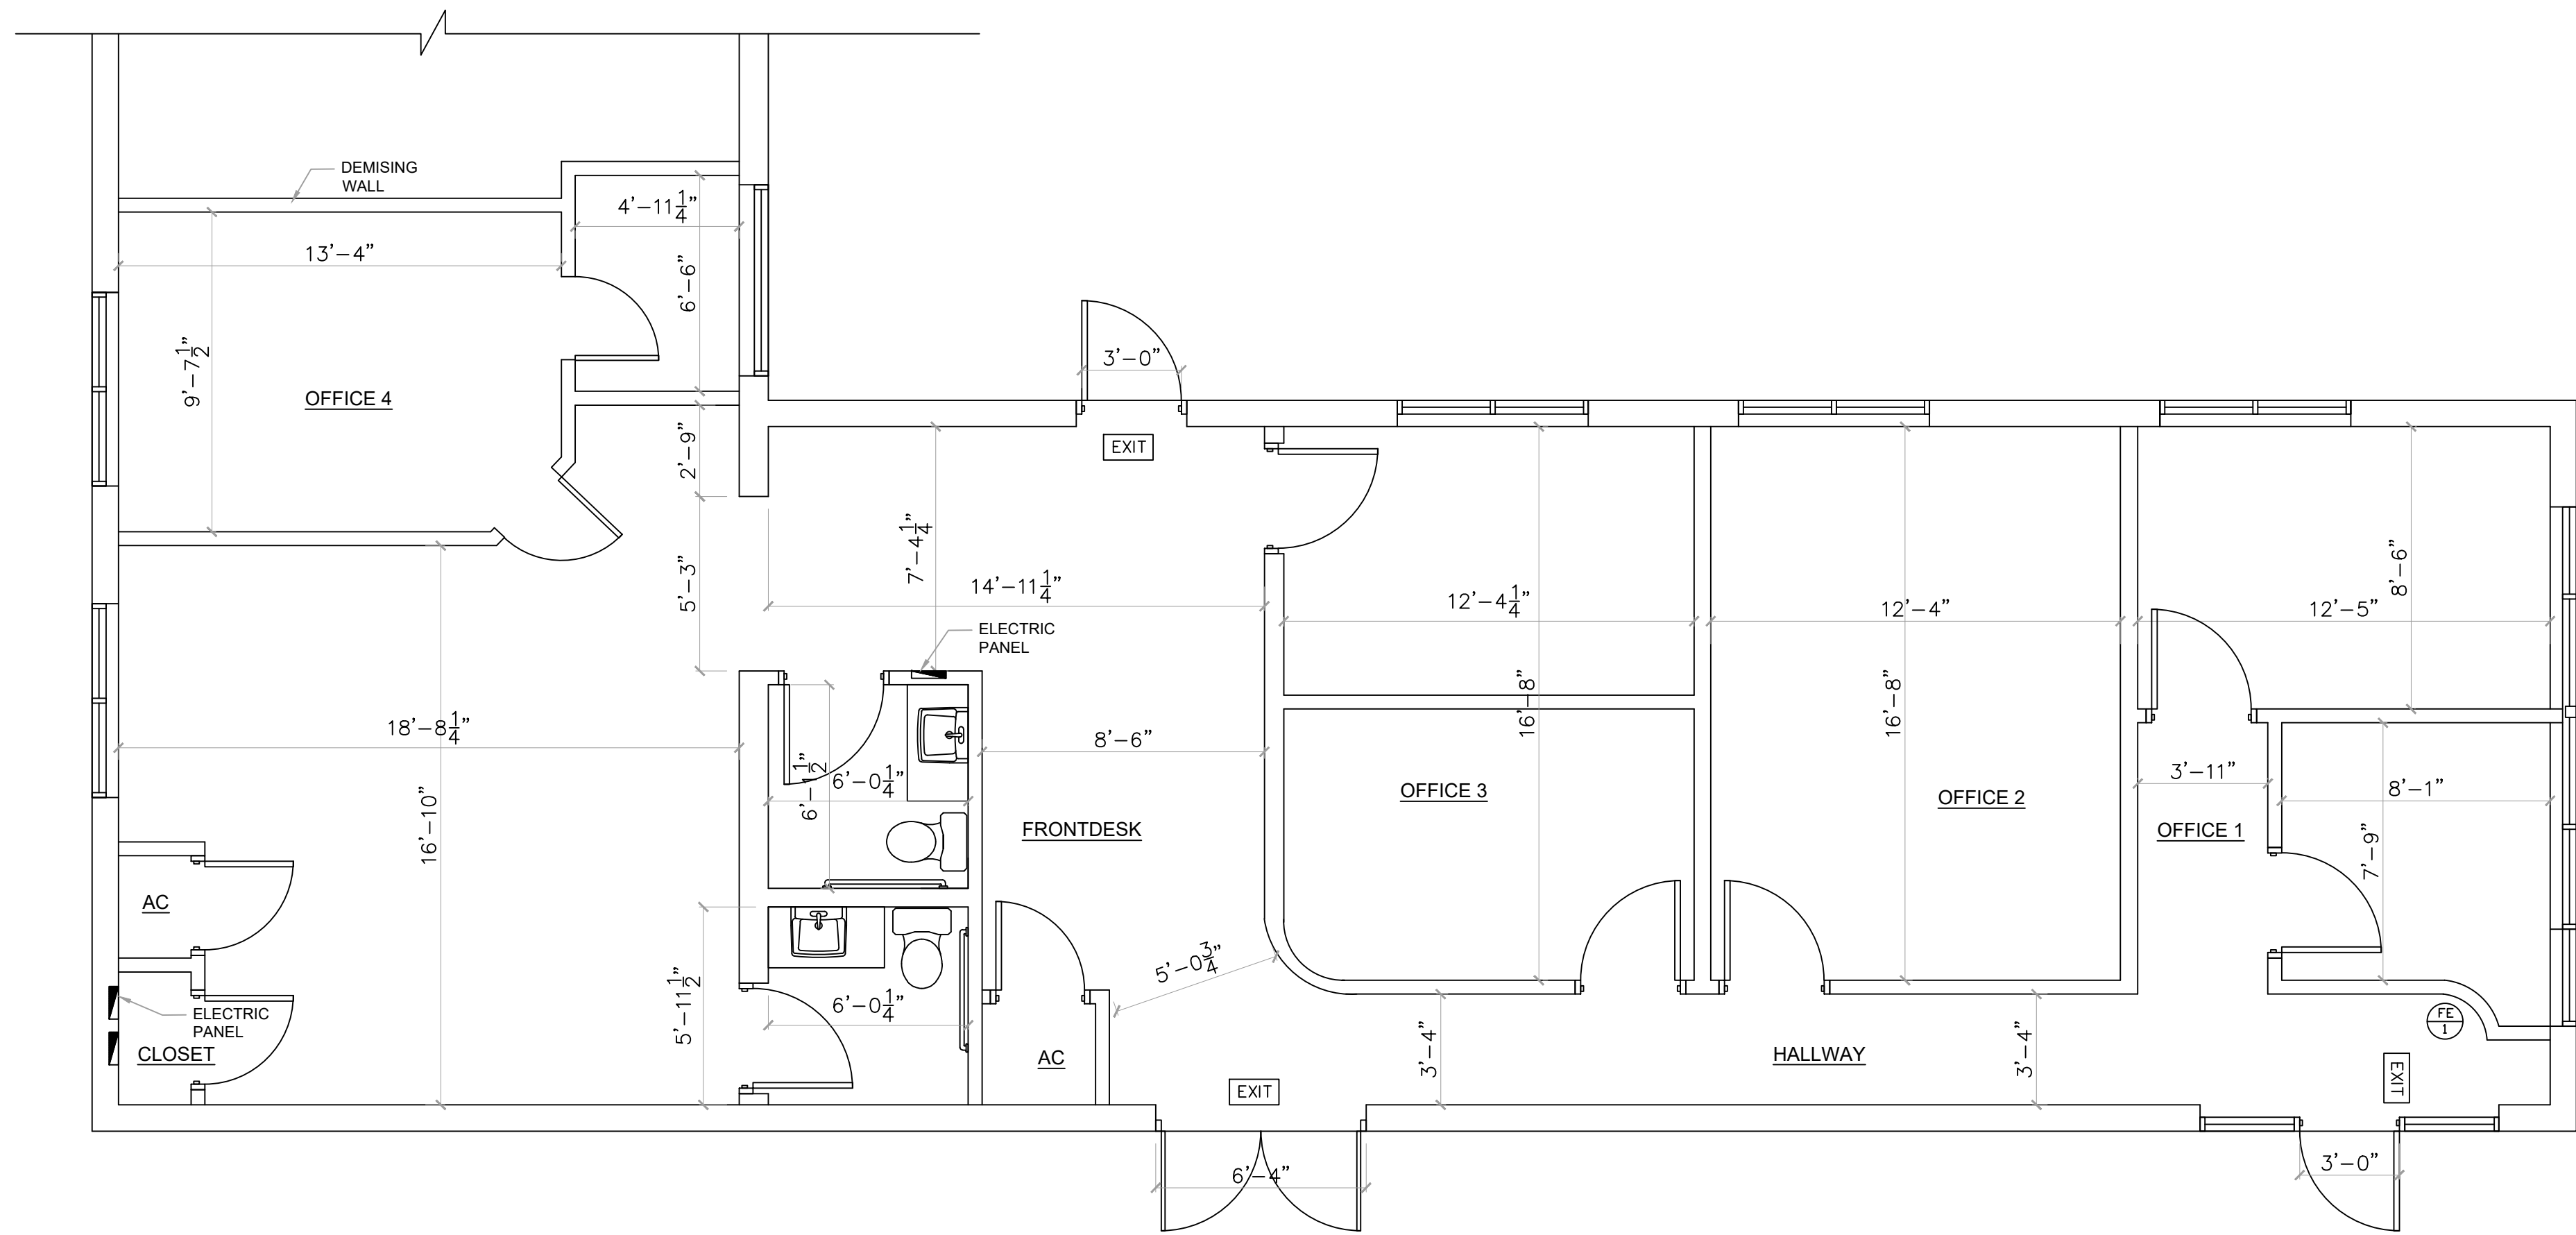

EXISTING FLOOR PLAN

SCALE: 1/4"=1'-0"

LEGEND


- EXIT EXIT LIGHT
- TWO HEADED EMERGENCY LIGHT

FIRE EXTINGUISHER LEGEND:

F.E. = 5 LB. "ABC" type BY G.C.
MOUNTED AT 48" A.F.F.

DO NOT SCALE DRAWINGS

No.	Revision	Date
1		
2		
3		
4		
5		

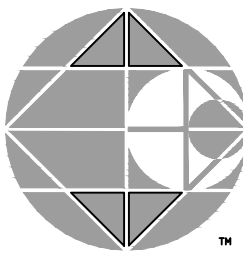

GARCIA • GHEZZI
ARCHITECTS INC.
MIAMI, FLORIDA
13014 S.W. 120th STREET
TEL: 786-573-4466
AA 26001271

AS-BUILT FLOOR PLAN

ESSENCE FOR WELLNESS
1553 SAN IGNACIO AVE SUITE B
CORAL GABLES, FL 33146

NOTE: OWNER, ARCHITECT, AND CONTRACTOR SHALL VERIFY ALL DIMENSIONS AND CONDITIONS OF THE EXISTING SPACE PRIOR TO CONSTRUCTION. THESE DRAWINGS ARE TO BE USED FOR INFORMATION ONLY AND SHALL NOT BE USED FOR REPRODUCTION OR REUSE WITHOUT THE EXPRESS WRITTEN CONSENT OF GARCIA GHEZZI ARCHITECTS, INC. THE CONTRACTOR SHALL VERIFY ALL DIMENSIONS AND CONDITIONS OF THE EXISTING SPACE PRIOR TO CONSTRUCTION. ANY DISCREPANCIES SHALL BE RESOLVED PRIOR TO CONSTRUCTION.

Scale: 1/4" = 1'-0"

Contract No. 21-46
Date: 11-14-21
Approved by: C.T.G.
Drawn by: A.B.

Sheets in Set: 1
Set No. A-1