


SCALE: 1"=20'-0"

17,382 RSF

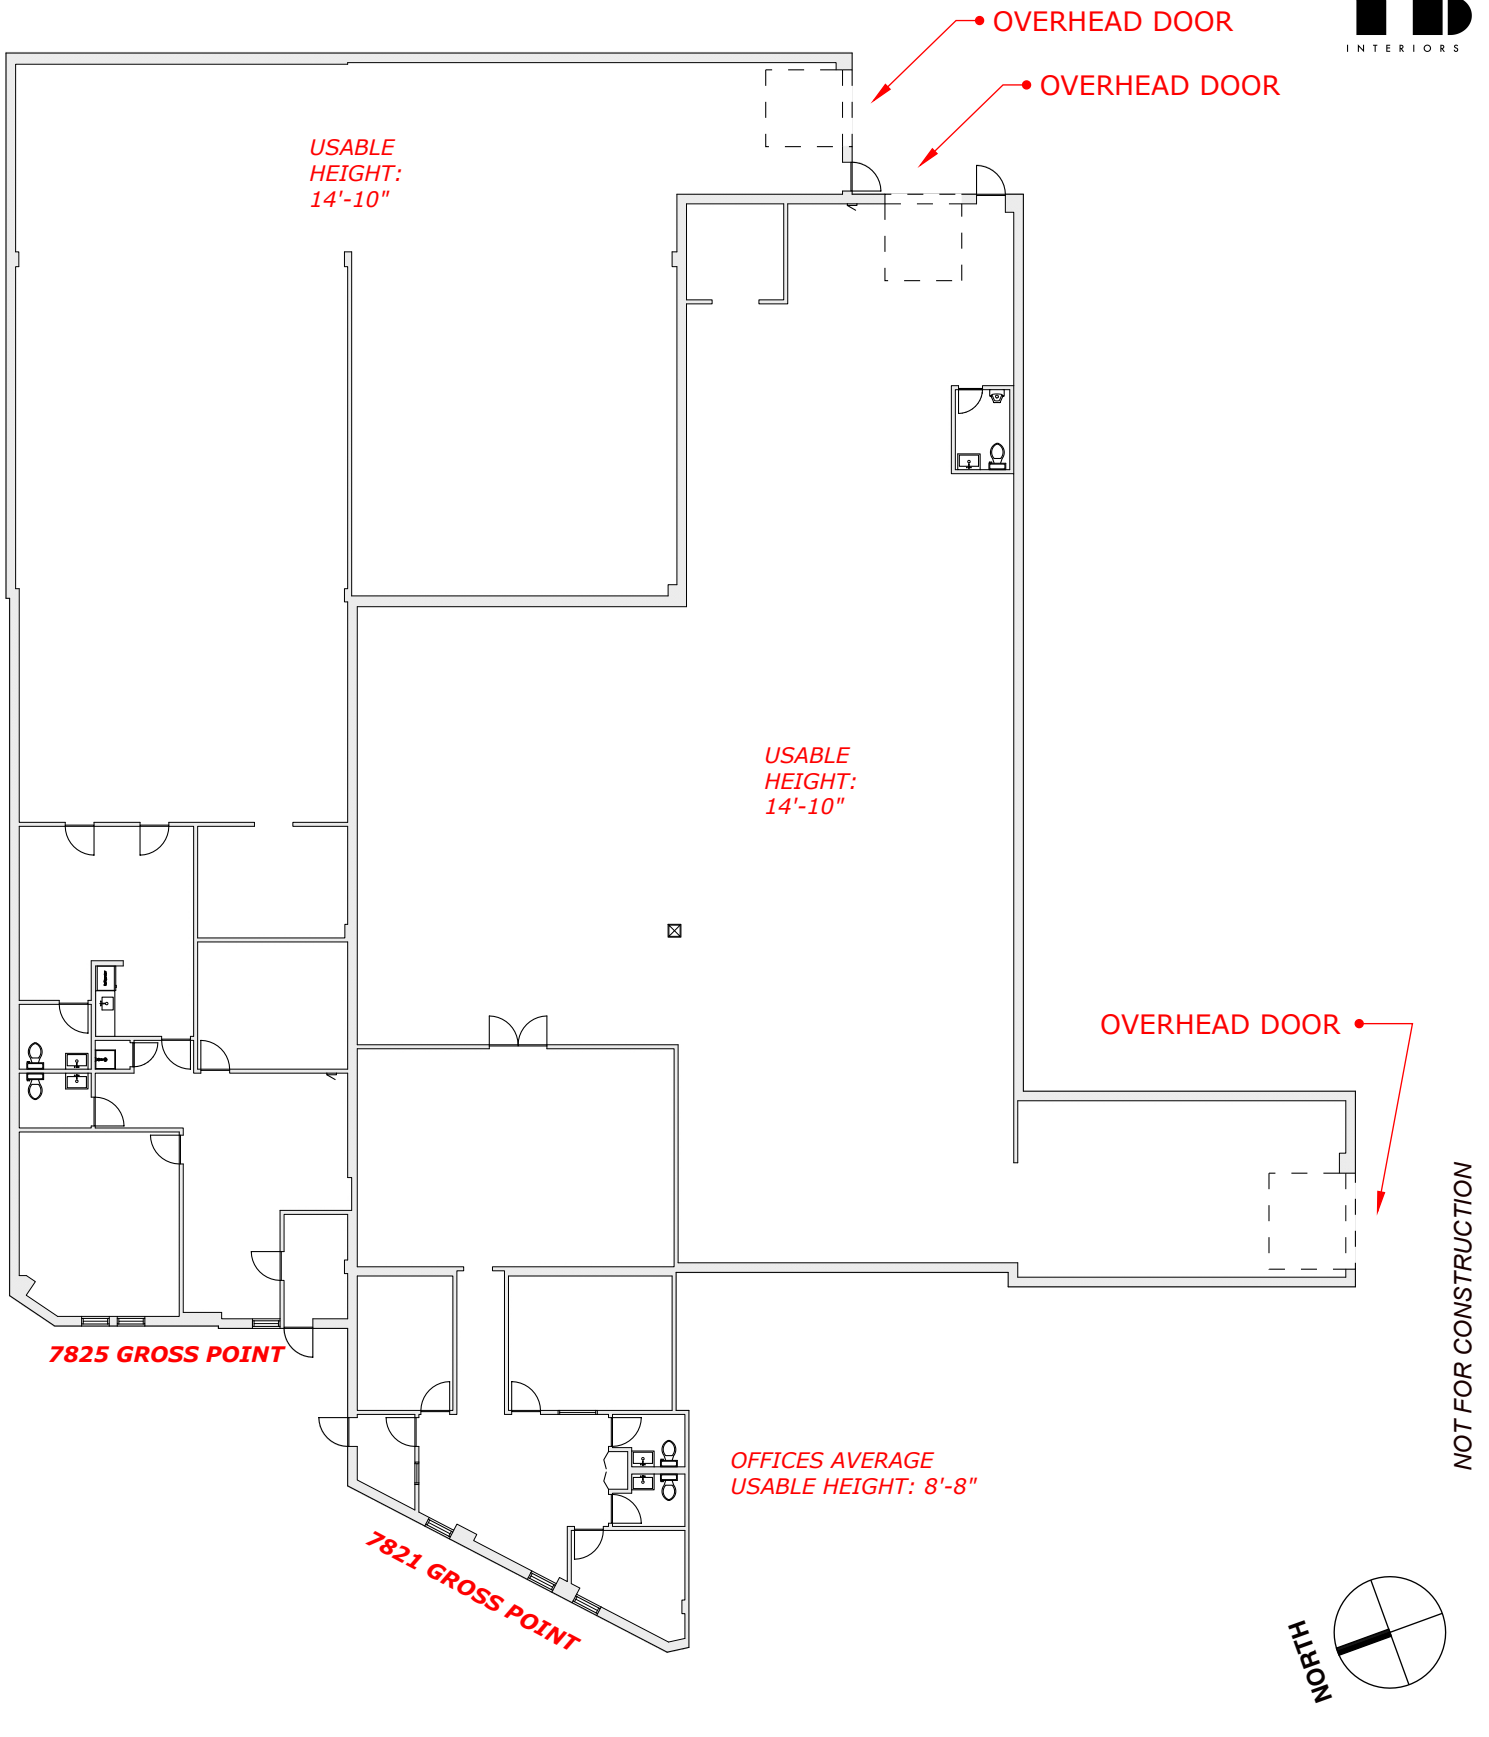

A.1

SITEPLAN

ISSUE
11.05.2025

DRAWN BY
YB

PROJECT
AS BUILT SITE PLAN

CLIENT
VANDON FORBES
7821 & 7825 Gross Point Rd
Skokie, IL 60077

YB INTERIORS LTD.
6111 N. Sacramento Ave.
Chicago, IL 60659

SCALE: 1/16"=1'-0"

8,060 RSF



OVERHEAD DOOR



USABLE
HEIGHT:
14'-10"

OFFICES AVERAGE
USABLE HEIGHT: 8'-10"

NOT FOR CONSTRUCTION

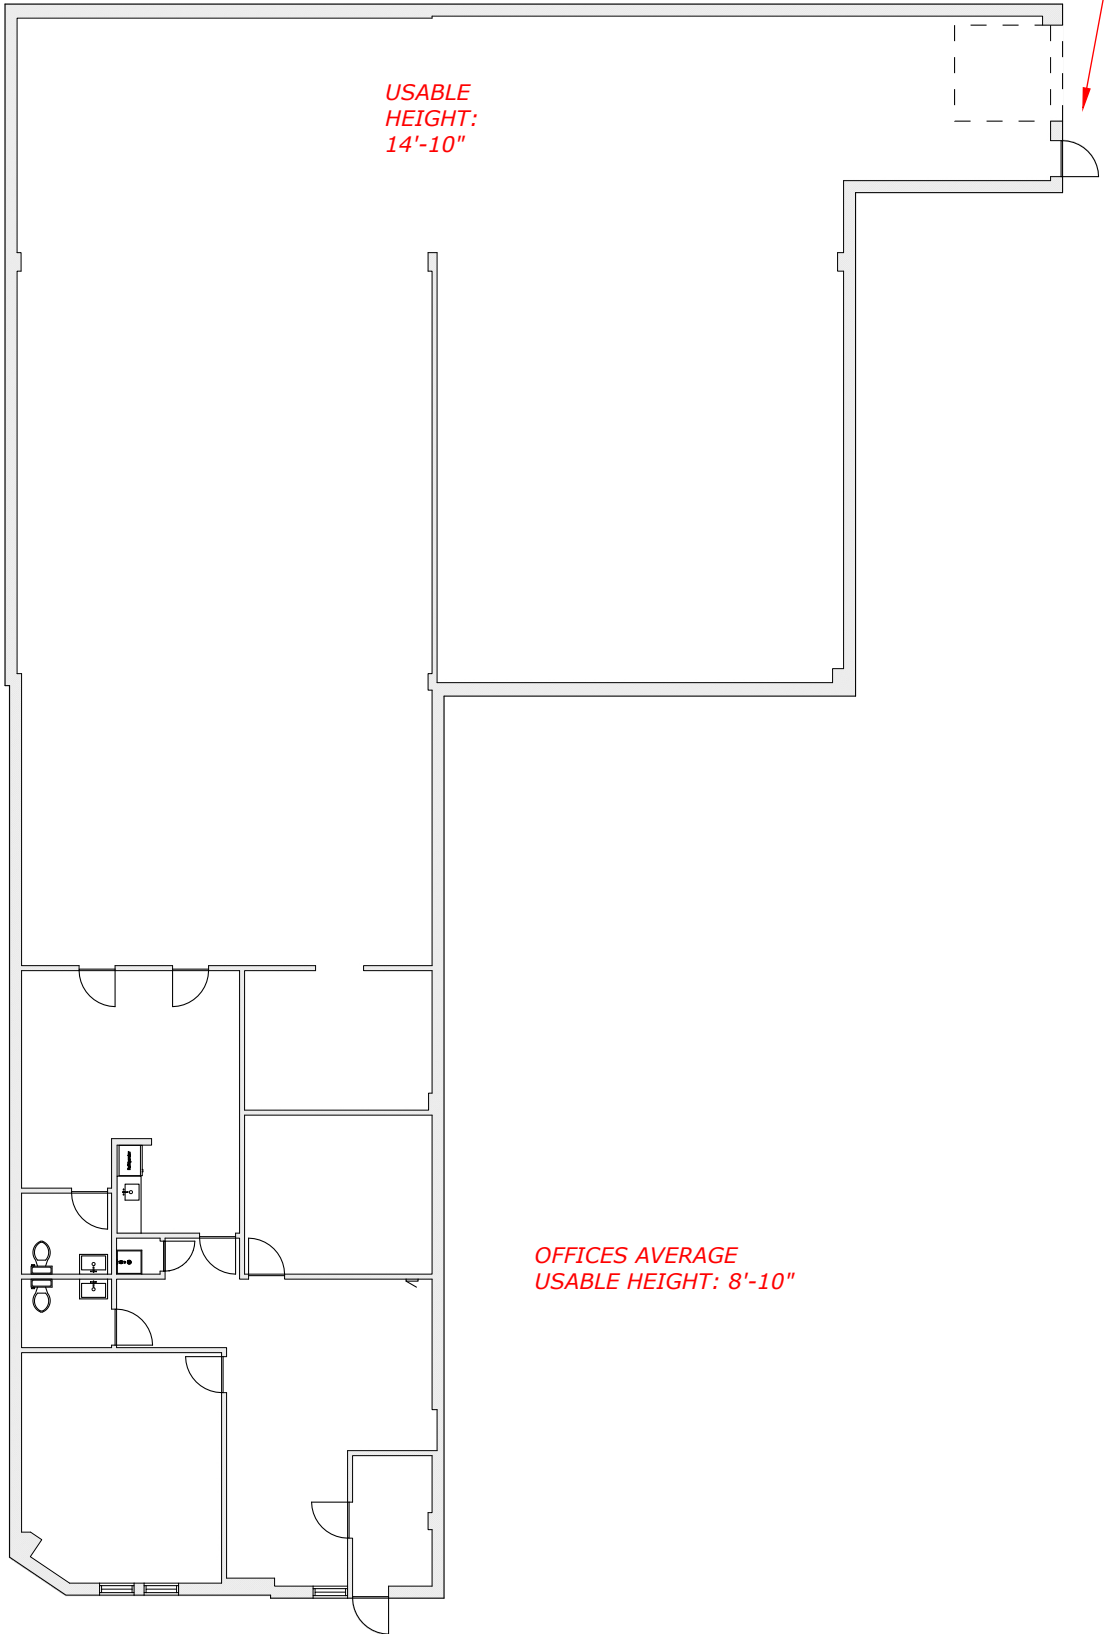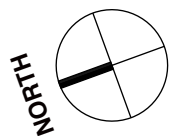

A.2

SITEPLAN

7825 GROSS POINT

ISSUE
11.05.2025

DRAWN BY
YB


PROJECT
AS BUILT SITE PLAN

CLIENT
VANDON FORBES
7821 & 7825 Gross Point Rd
Skokie, IL 60077


YB INTERIORS LTD.
6111 N. Sacramento Ave.
Chicago, IL 60659

SCALE: 1"=20'-0"

9,322 RSF

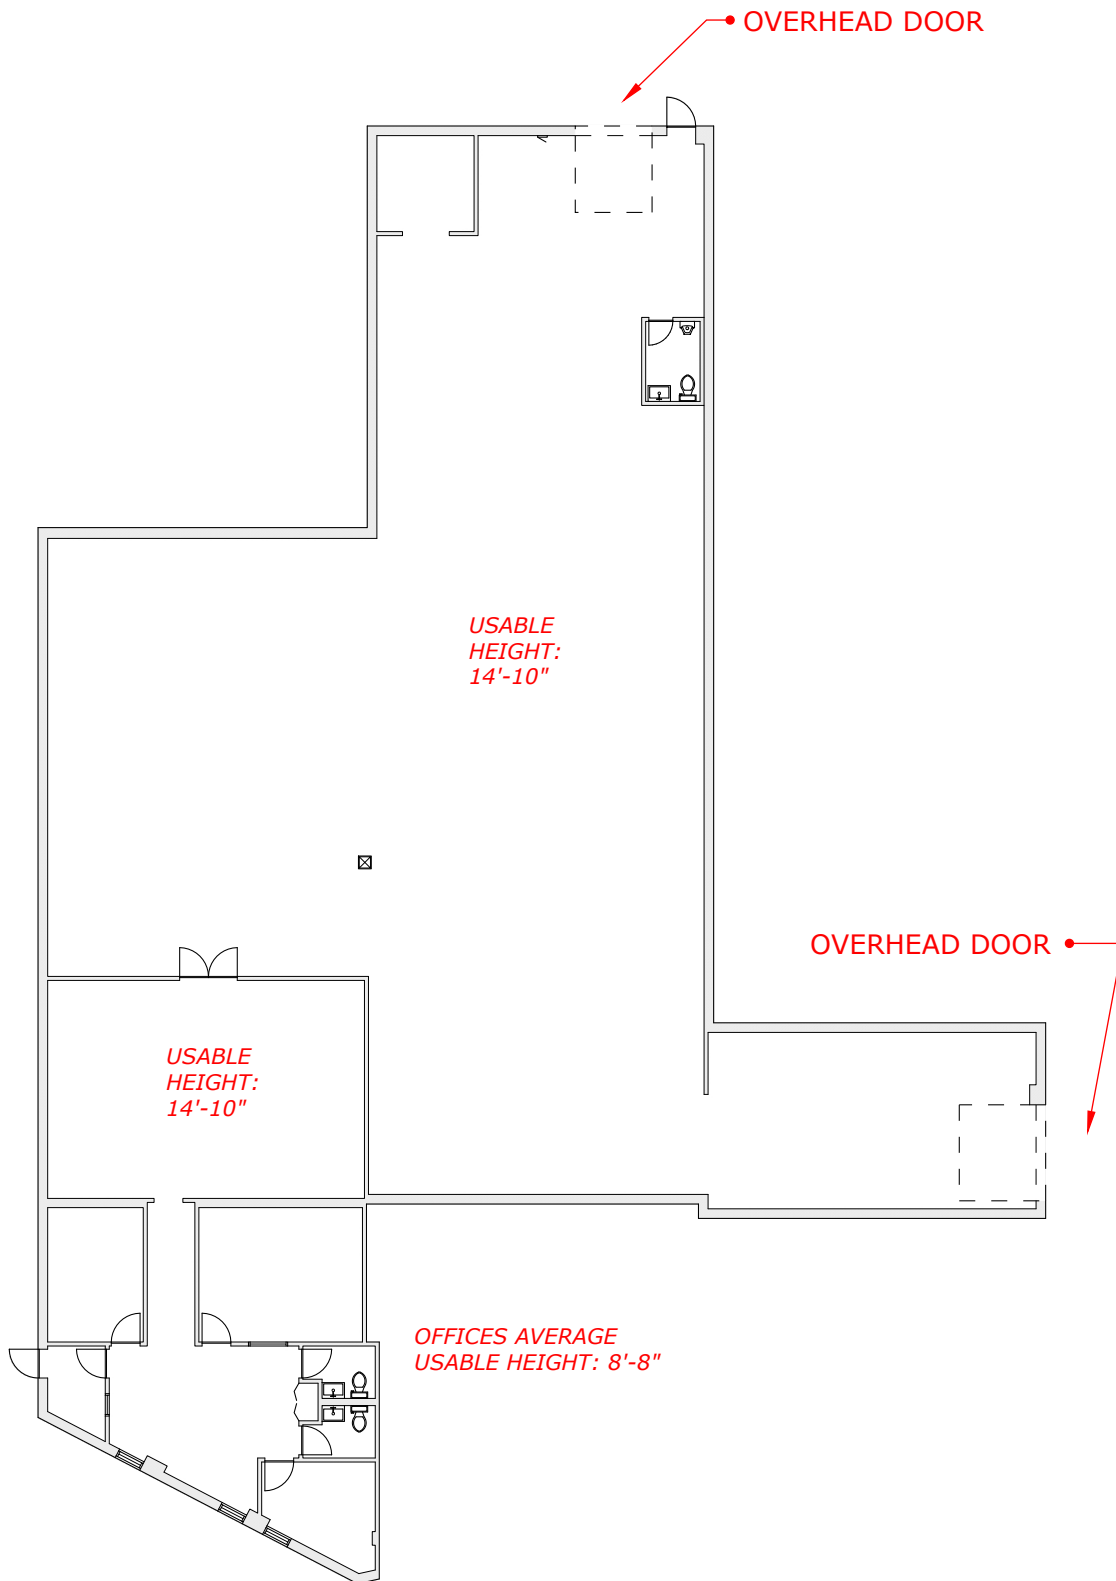

NOT FOR CONSTRUCTION

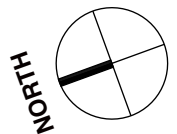

A.3

SITEPLAN

7821 GROSS POINT

ISSUE
11.05.2025

DRAWN BY
YB

PROJECT
AS BUILT SITE PLAN

CLIENT
VANDON FORBES
7821 & 7825 Gross Point Rd
Skokie, IL 60077

YB INTERIORS LTD.
6111 N. Sacramento Ave.
Chicago, IL 60659