


Scottsdale City Center

7201 East Camelback Road . Scottsdale

Suite 375 - 3,402 RSF

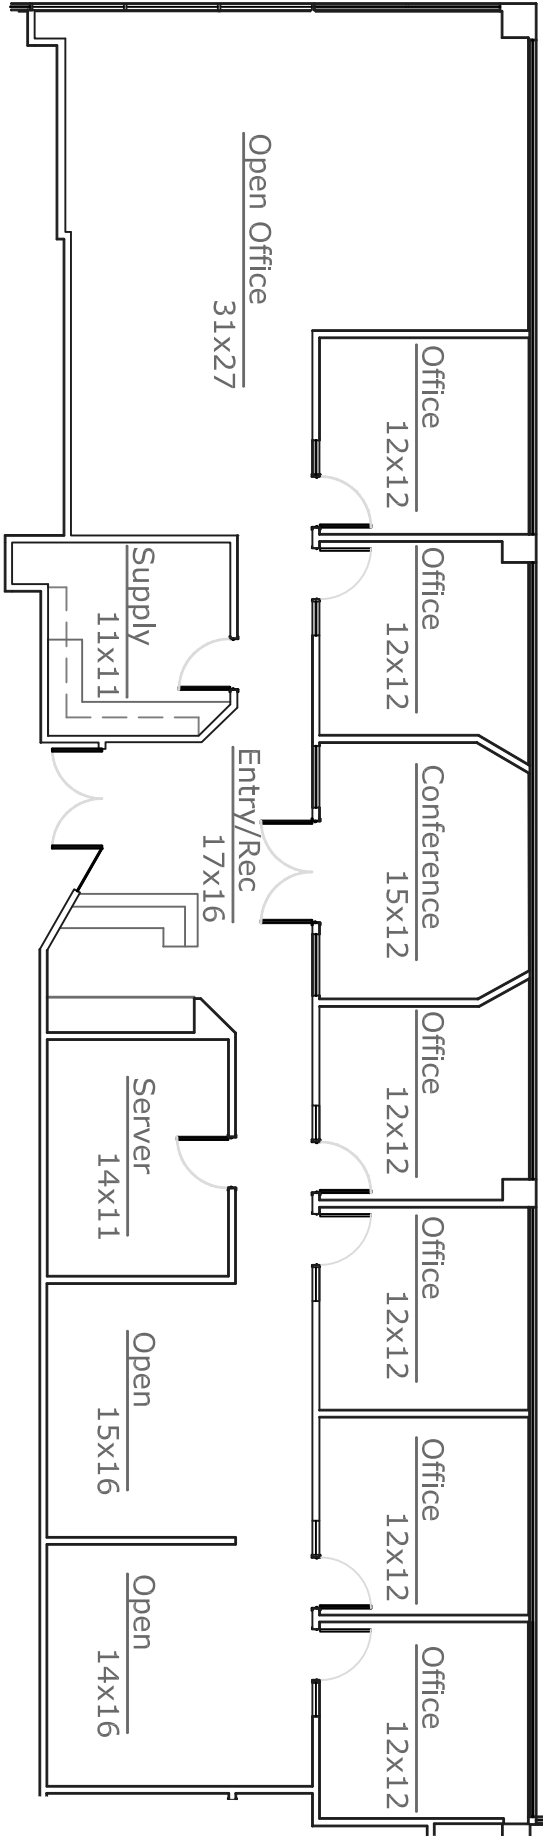

as-built

scale: nts

12.june.2006

*All dimensions are approximate and all information is of general nature.

precision**DIMENSIONS**

as-built . space plans
architectural design

6 0 2 . 7 9 0 . 6 4 1 2