






WALL TYPES

-  5/8" GYPSUM BOARD ON 3-5/8" METAL STUDS
-  6" BLOCK WALL
-  8" BLOCK WALL
-  12" BLOCK WALL




18,884 SF
FLOOR PLAN
 SCALE: 1/8"=1'-0"

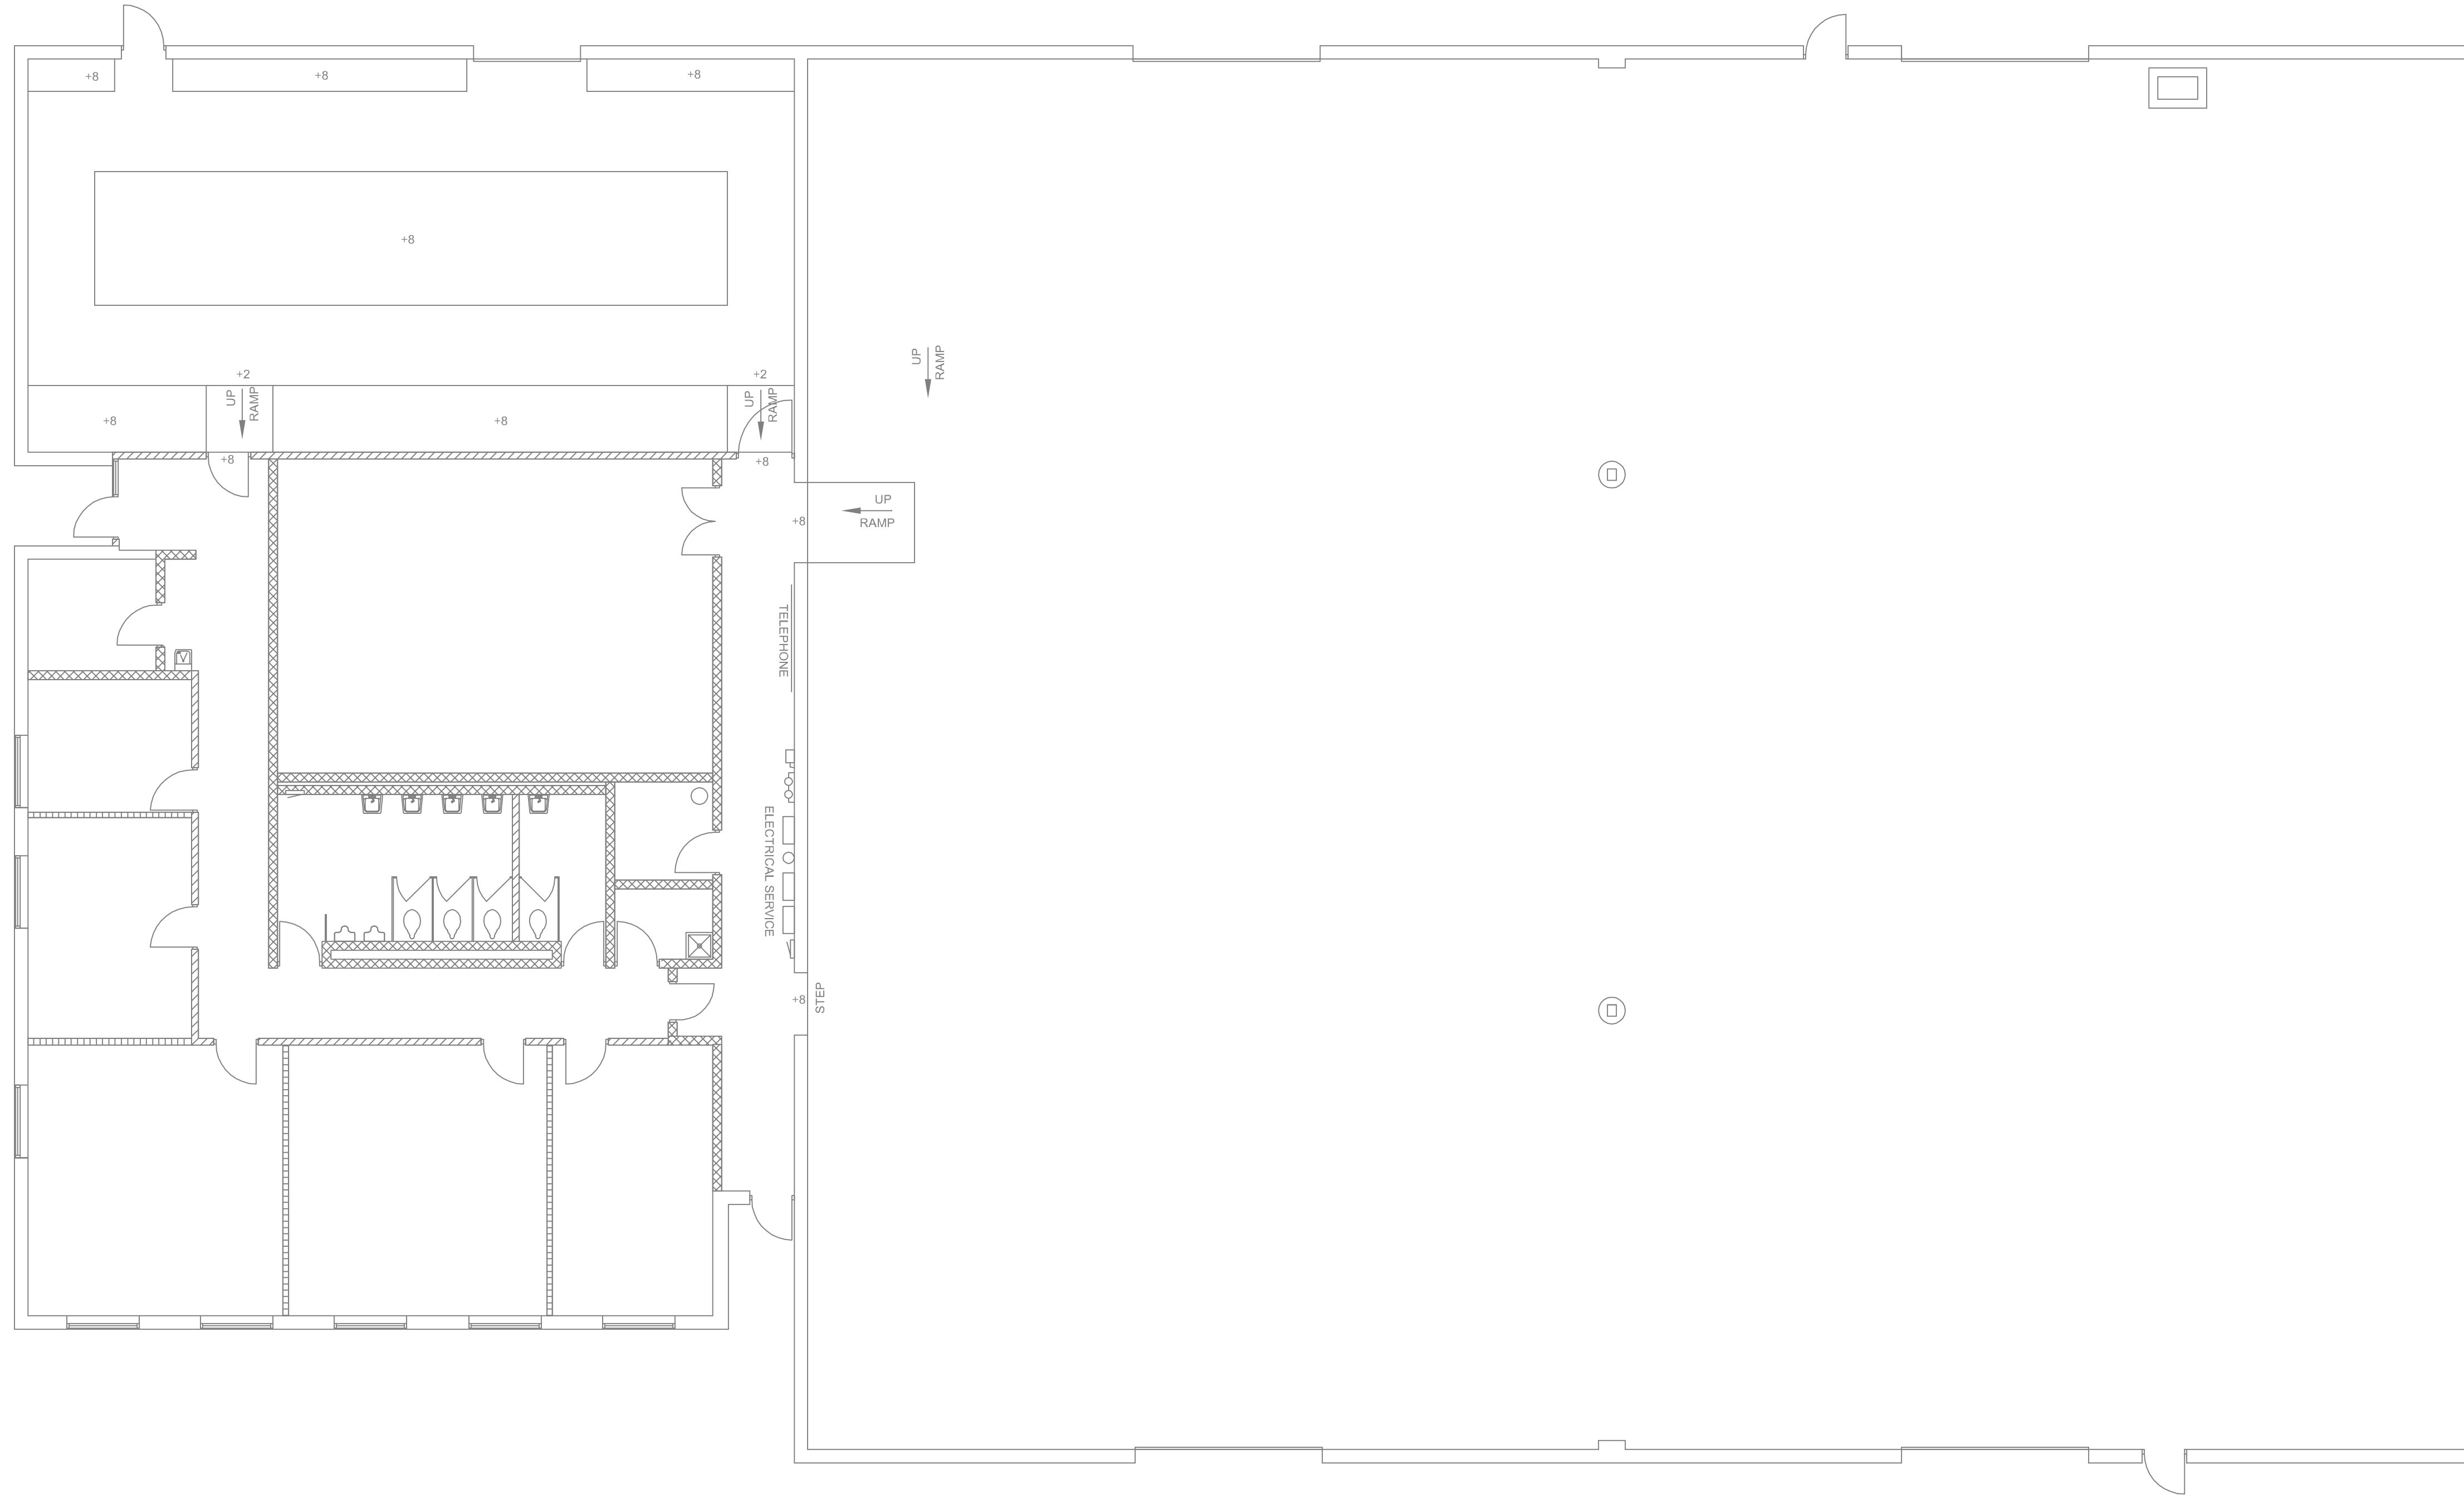275 GEORGETOWN LANE- AS BUILT
 275 GEORGETOWN LANE, VANPORT, PA 15009

FOR **LOCKAMP PROPERTIES, LLC**
 8150 PERRY HIGHWAY, SUITE 104, PITTSBURGH, PA 15237

SCOT KURTZ / ARCHITECT, PC 1617 FOREST RIDGE DRIVE, PITTSBURGH, PA 15237, (412)369-8757

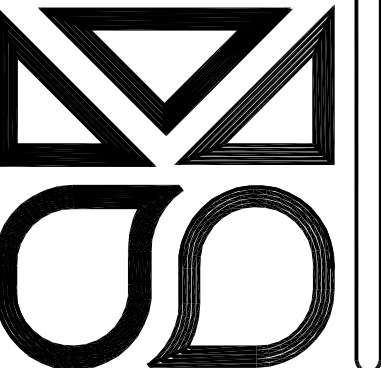

CHECKED BY

DRAWN BY

PROJECT NO.
190314

DATE
03/18/19

REVISIONS

DRAWING NO.
1
OF 1