


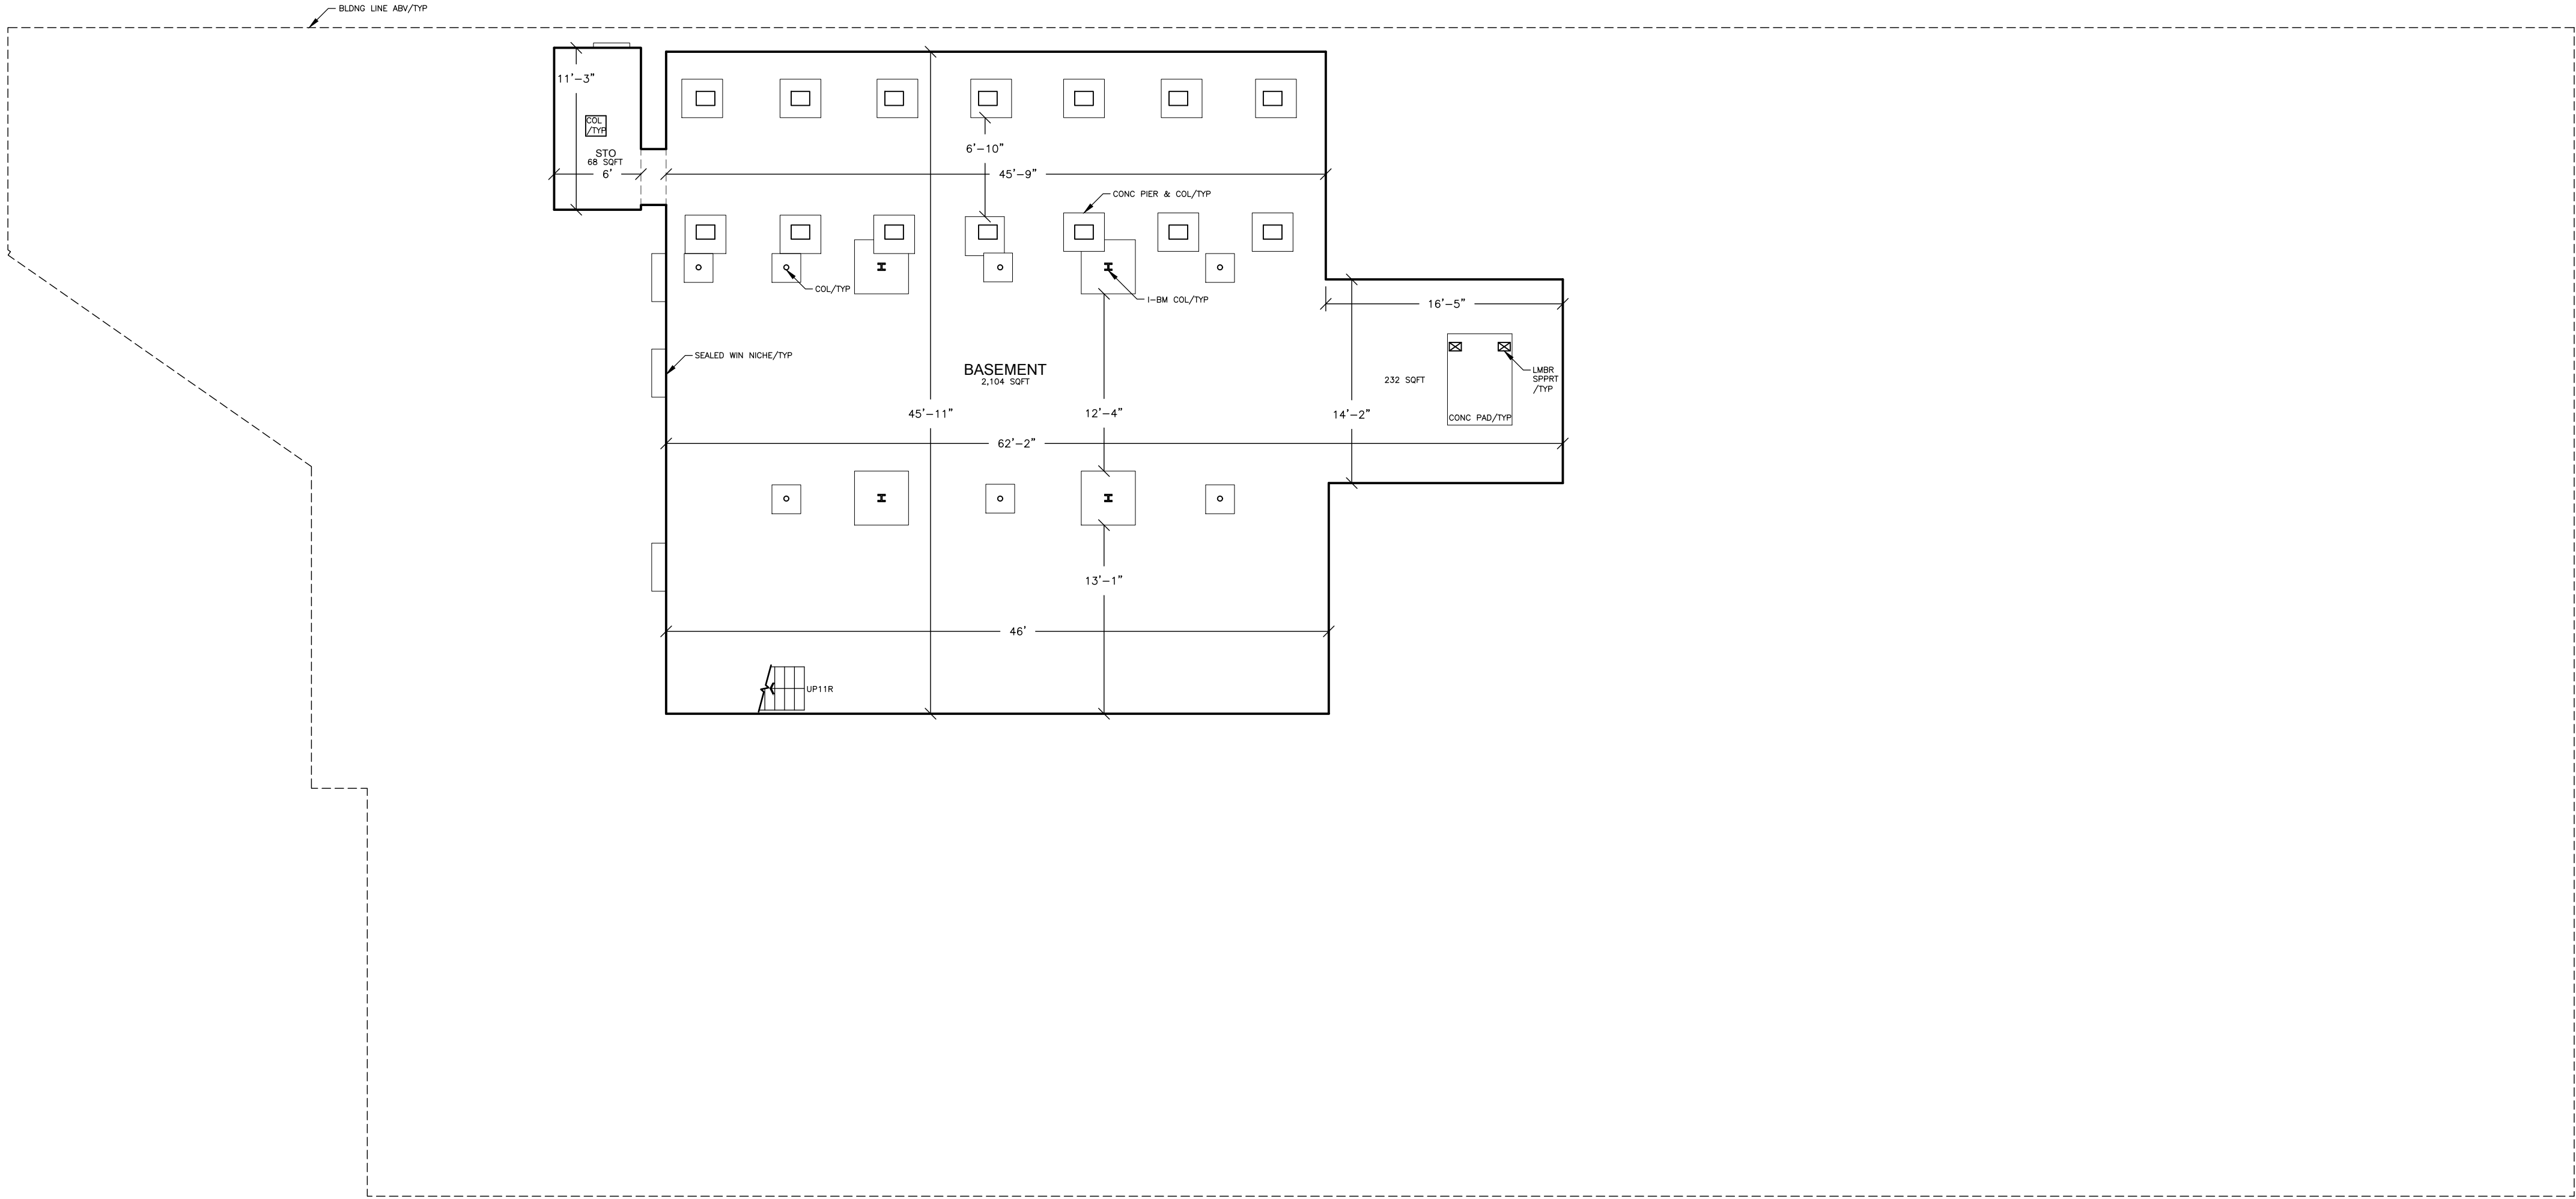

1 EXISTING BASEMENT LEVEL FLOOR PLAN
2,446 SQFT INTERIOR

THESE ARE BASIC FLOOR PLANS. NO INTERIOR ELEMENTS SHOWN,
UNLESS OTHERWISE NOTED.

ASBUILT CONDITIONS

www.asbuiltcondit i ons co m

SF (415) 230-0452

LA (323) 284-7817

NY (347) 354 -1758

DISCLAIMER
THIS DRAWING IS THE RESULT OF AN ARCHITECTURAL SURVEY
AND IS NOT TO BE USED FOR CONSTRUCTION, LEASING,
OR ANY OTHER PURPOSES WITHOUT THE VERIFICATION
OF THE SURVEYOR. IT SHOULD NOT BE USED
FOR EXACT MEASUREMENTS OR AS THE BASIS FOR PURCHASES
OF SPECIFIC ITEMS WITHOUT FIELD VERIFICATION.


24-42 JOHNES ST.
NEWBURGH, NY 12550

FLOOR PLAN

DRAWN BY: JJ FIELD SURVEY
AUDITED BY: JJ 12/08/2020-12/10/2020
CAT# 24-42- NY SHEET SIZE: 24x36

A-101

SCALE: 1/8"=1'0" 1 OF 3

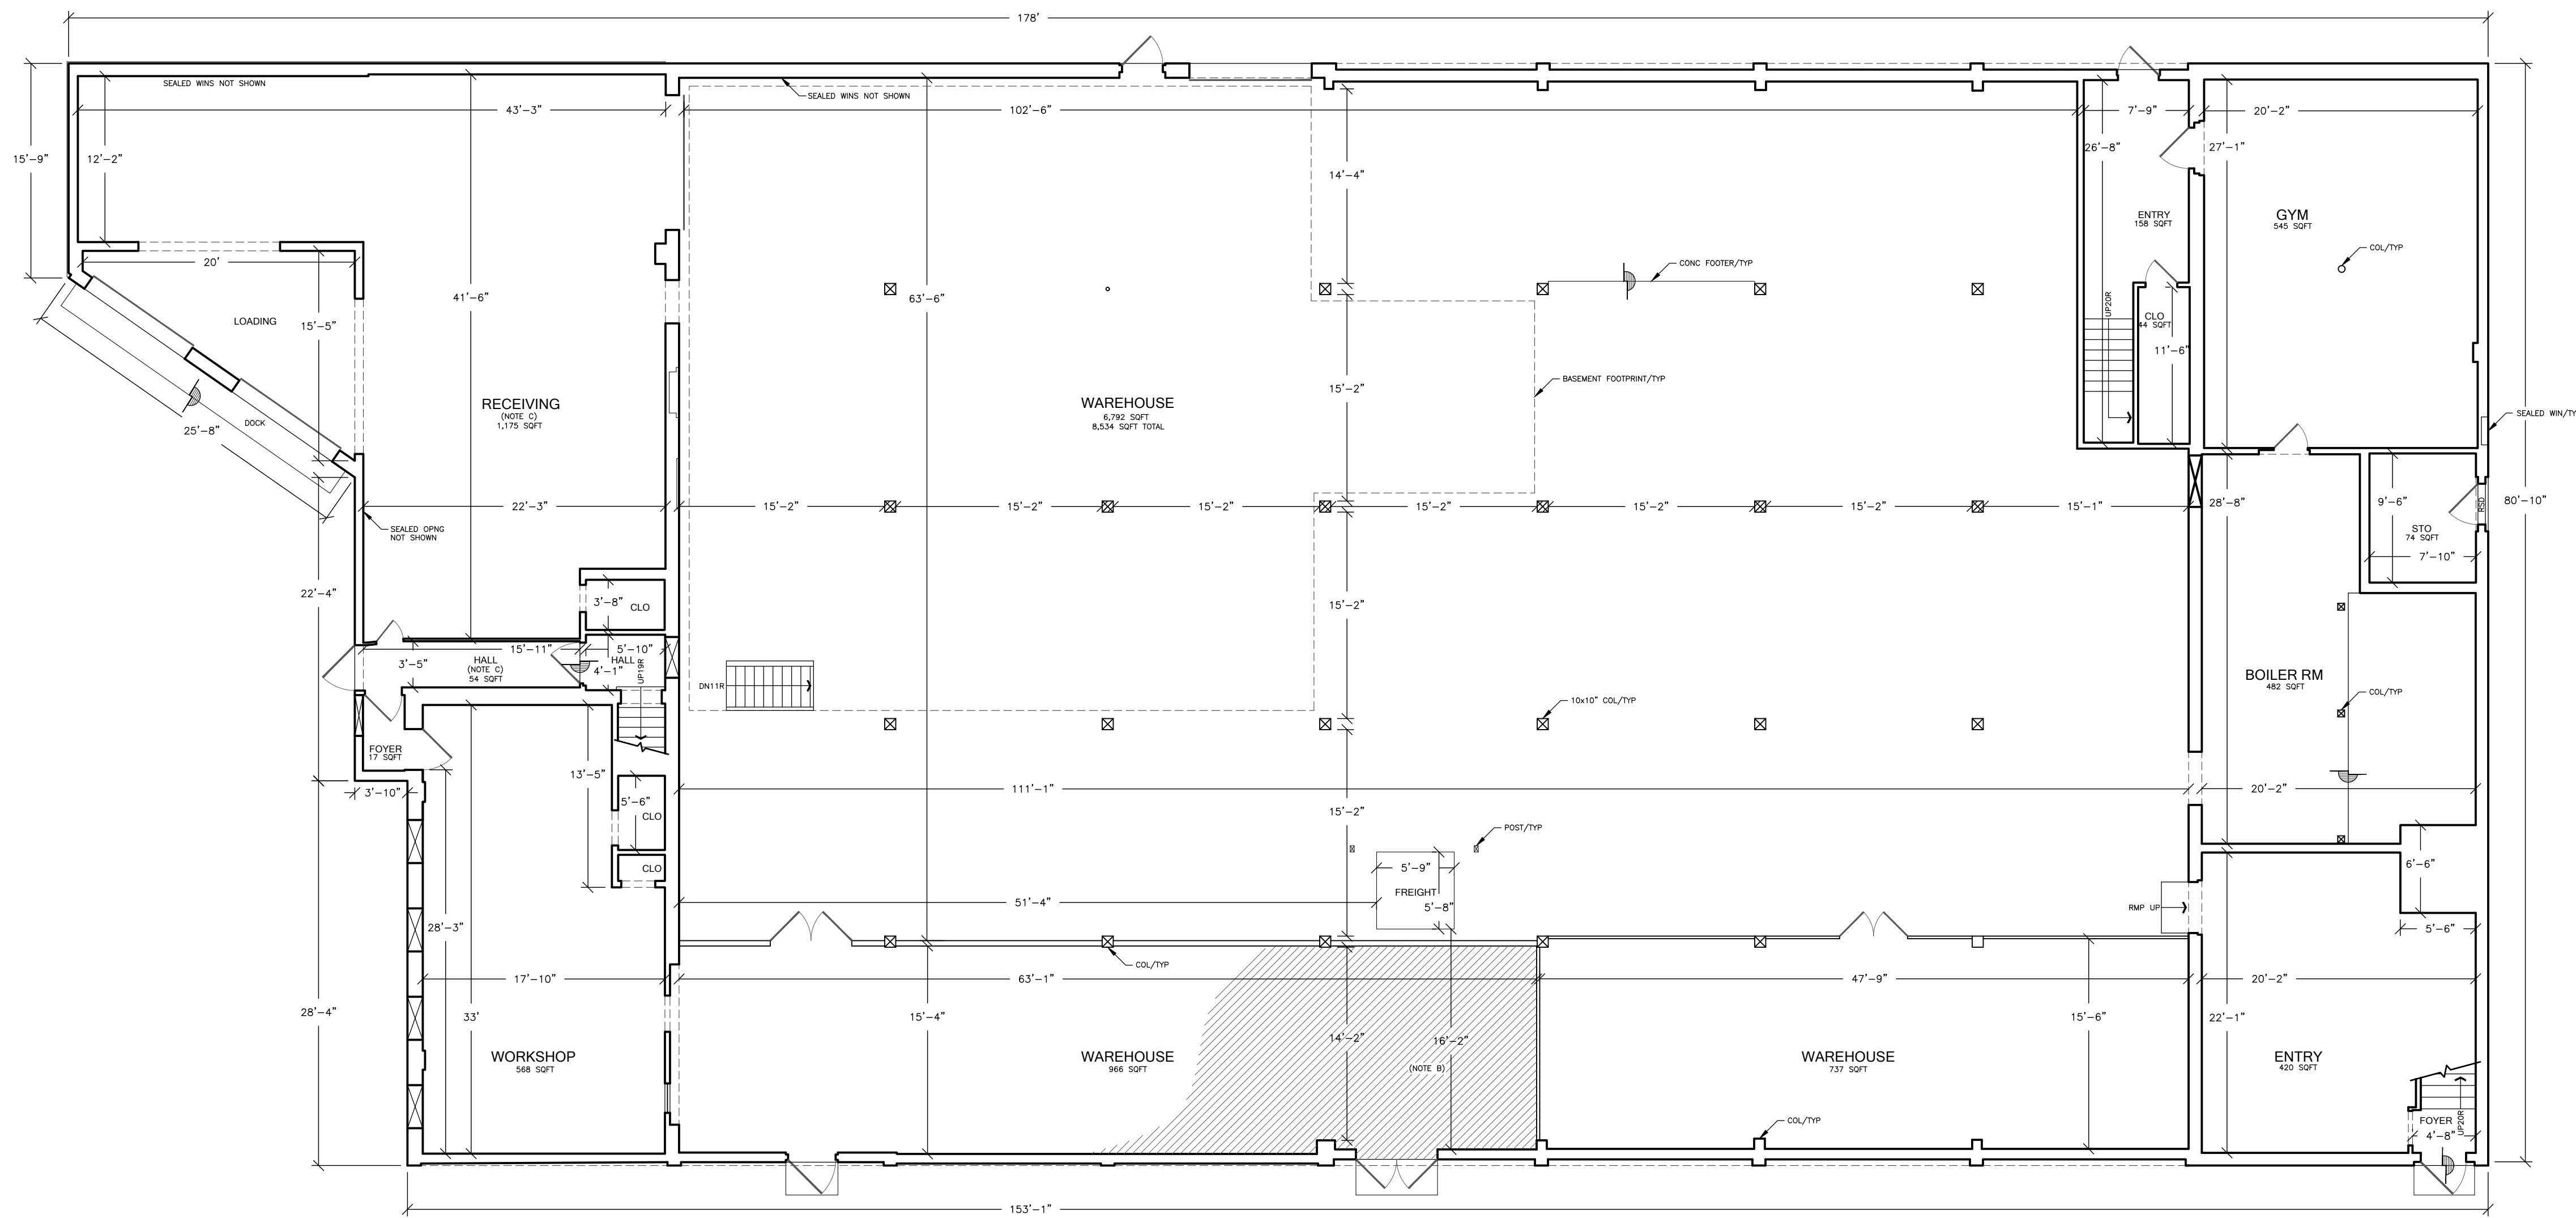

1 EXISTING ENTRY LEVEL FLOOR PLAN
13,106 SQFT INTERIOR
79 SQFT EXTERIOR

THESE ARE BASIC FLOOR PLANS. NO INTERIOR ELEMENTS SHOWN, UNLESS OTHERWISE NOTED.

NOTE B:
NOT ACCESSIBLE AT TIME OF DATA ACQUISITION, AREA NOT MEASURED.

NOTE C:
DUE TO DEVIATIONS IN WALL ANGLES AND SURFACES, SOME WALL LENGTHS ARE REPRESENTED AS TYPICAL.

ASBUILT CONDITIONS

www.asbuiltcondit i ons co m

SF (415) 230-0452

LA (323) 284-7817

NY (347) 354-1758

DISCLAIMER
THIS DRAWING IS THE RESULT OF AN ARCHITECTURAL SURVEY
CONDUCTED BY JAMES J. JOHNSON, INC. FOR THE PURPOSES OF
LEASING AND GENERAL PLANNING. IT SHOULD NOT BE USED
FOR EXACT MEASUREMENTS OR AS THE BASIS FOR PURCHASES
OF SPECIFIC ITEMS WITHOUT FIELD VERIFICATION.


24-42 JOHNES ST.
NEWBURGH, NY 12550

FLOOR PLAN

DRAWN BY: JJ FIELD SURVEY
AUDITED BY: JJ 12/08/2020-12/10/2020
CAT#_24-42_NY SHEET SIZE: 24x36

A-102

SCALE: 1/8"=1'0" 2 OF 3

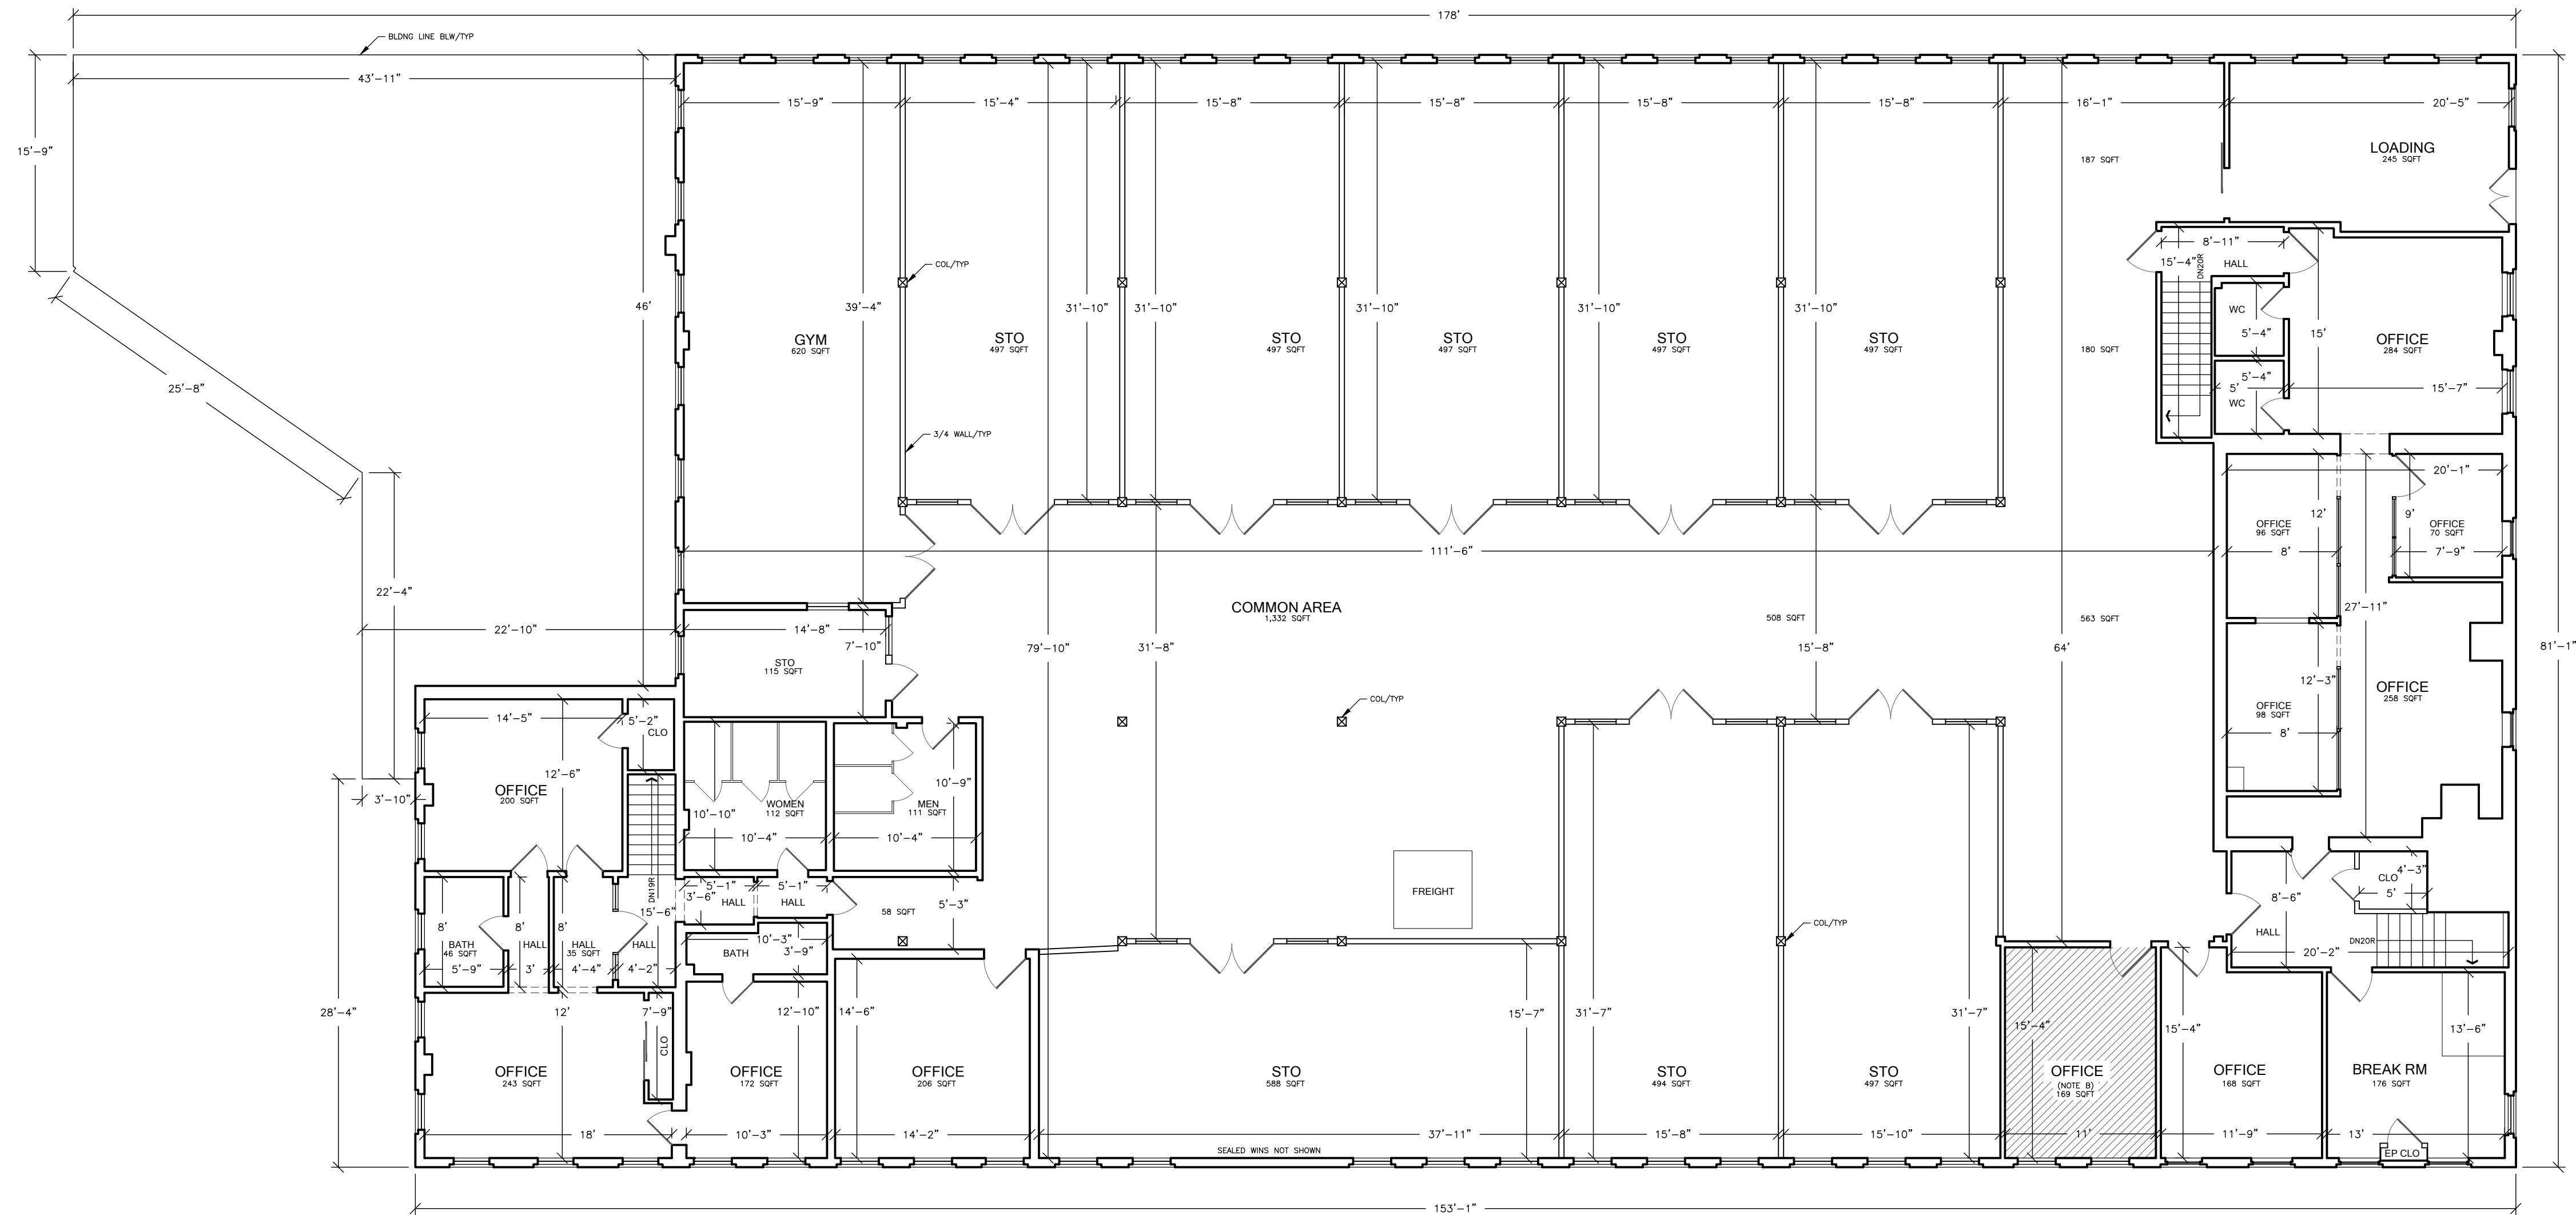

1 EXISTING SECOND LEVEL FLOOR PLAN
11,537 SQFT INTERIOR

THESE ARE BASIC FLOOR PLANS. NO INTERIOR ELEMENTS SHOWN, UNLESS OTHERWISE NOTED.

NOTE B:
NOT ACCESSIBLE AT TIME OF DATA ACQUISITION, AREA NOT MEASURED.

ASBUILT CONDITIONS

SF (415) 230-0452

LA (323) 284-7817

NY (347) 354-1758

DISCLAIMER
THIS DRAWING IS THE RESULT OF AN ARCHITECTURAL SURVEY. IT IS NOT TO BE USED FOR CONSTRUCTION, LEASING, AND GENERAL PLANNING. IT SHOULD NOT BE USED FOR EXACT MEASUREMENTS OR AS THE BASIS FOR PURCHASES OF SPECIFIC ITEMS WITHOUT FIELD VERIFICATION.

24-42 JOHNES ST.
NEWBURGH, NY 12550

FLOOR PLAN

DRAWN BY: JJ FIELD SURVEY
AUDITED BY: JJ 12/08/2020-12/10/2020
CAT# 24-42_NY SHEET SIZE: 24x36

A-103

SCALE: 1/8"=1'0"

3 OF 3

www.asbuiltcondit i ons co m