

NOTES:


STANDARD 3' WOOD DOORS
THRU-OUT EXCEPT
AS NOTED :

B- STEEL / FIRE DOOR

WALL THICKNESSES OMITTED
DIMENSIONS ARE INTERNAL
AS-BUILT
42'-6" X 39' FACILITY
STORAGE ABOVE OFFICE

INTERIOR WINDOW NOTATION:

- 1- 3' X 2' : 3' OFF FLOOR LEVEL
- 2- 2'-5" X 1'-6" : 4'-7" ABOVE FLOOR LEVEL
- 3- 1'-11" X 1'-4" : 5'-6" ABOVE FLOOR LEVEL

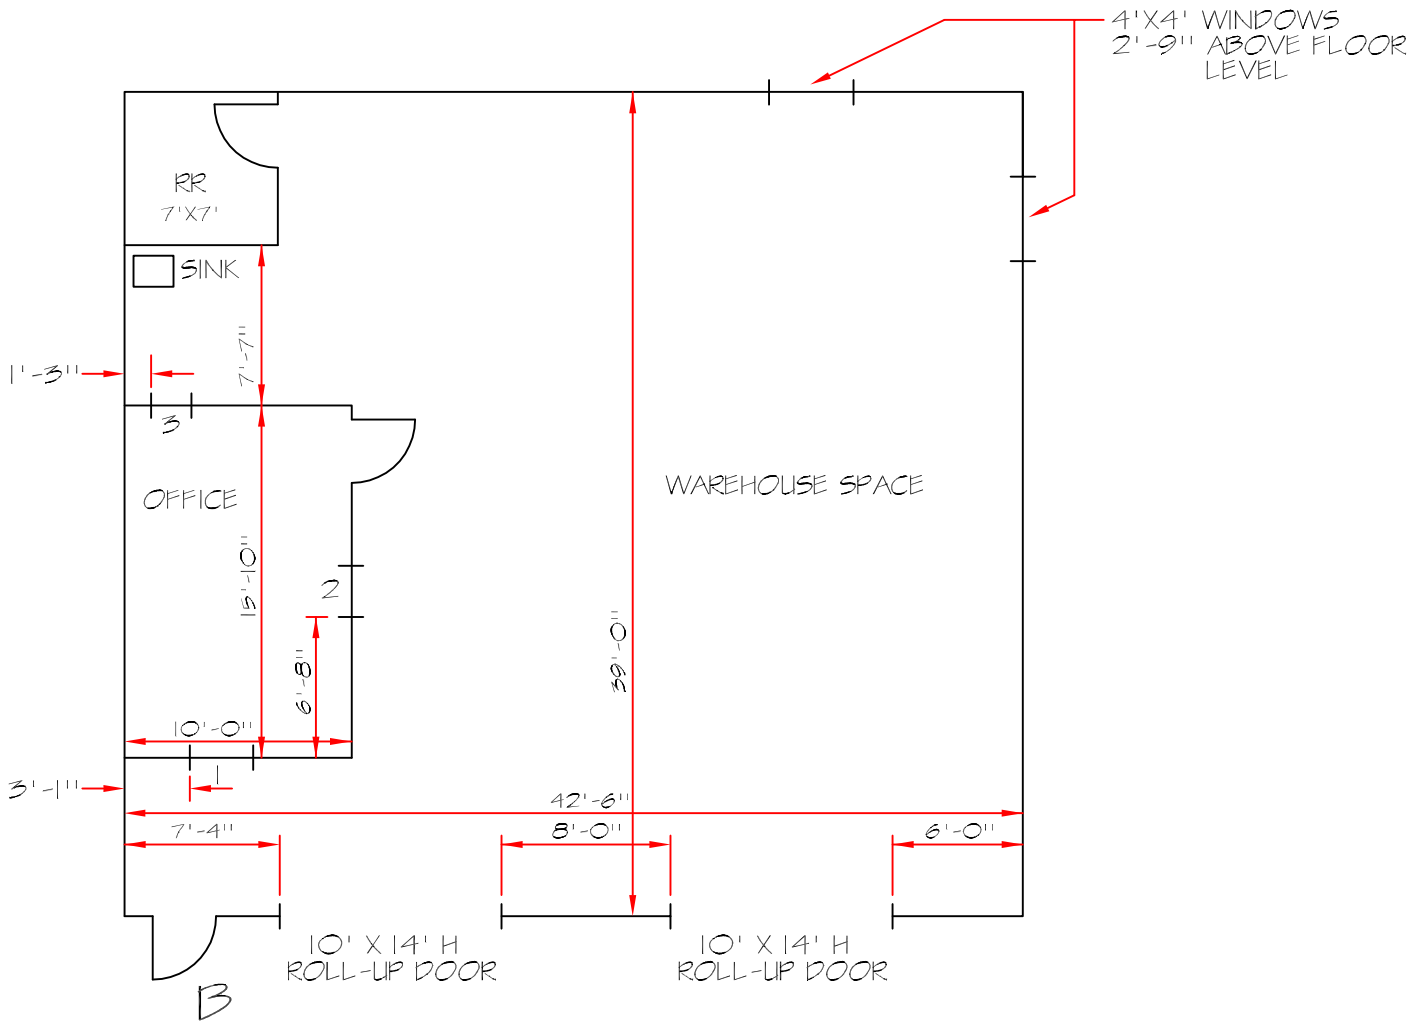

SUMMIT CAPITAL HOLDINGS
4502 35TH STREET STE 700
AS-BUILT DIMENSIONS
BY DIDIER A. BENICHO
407.242.5909