


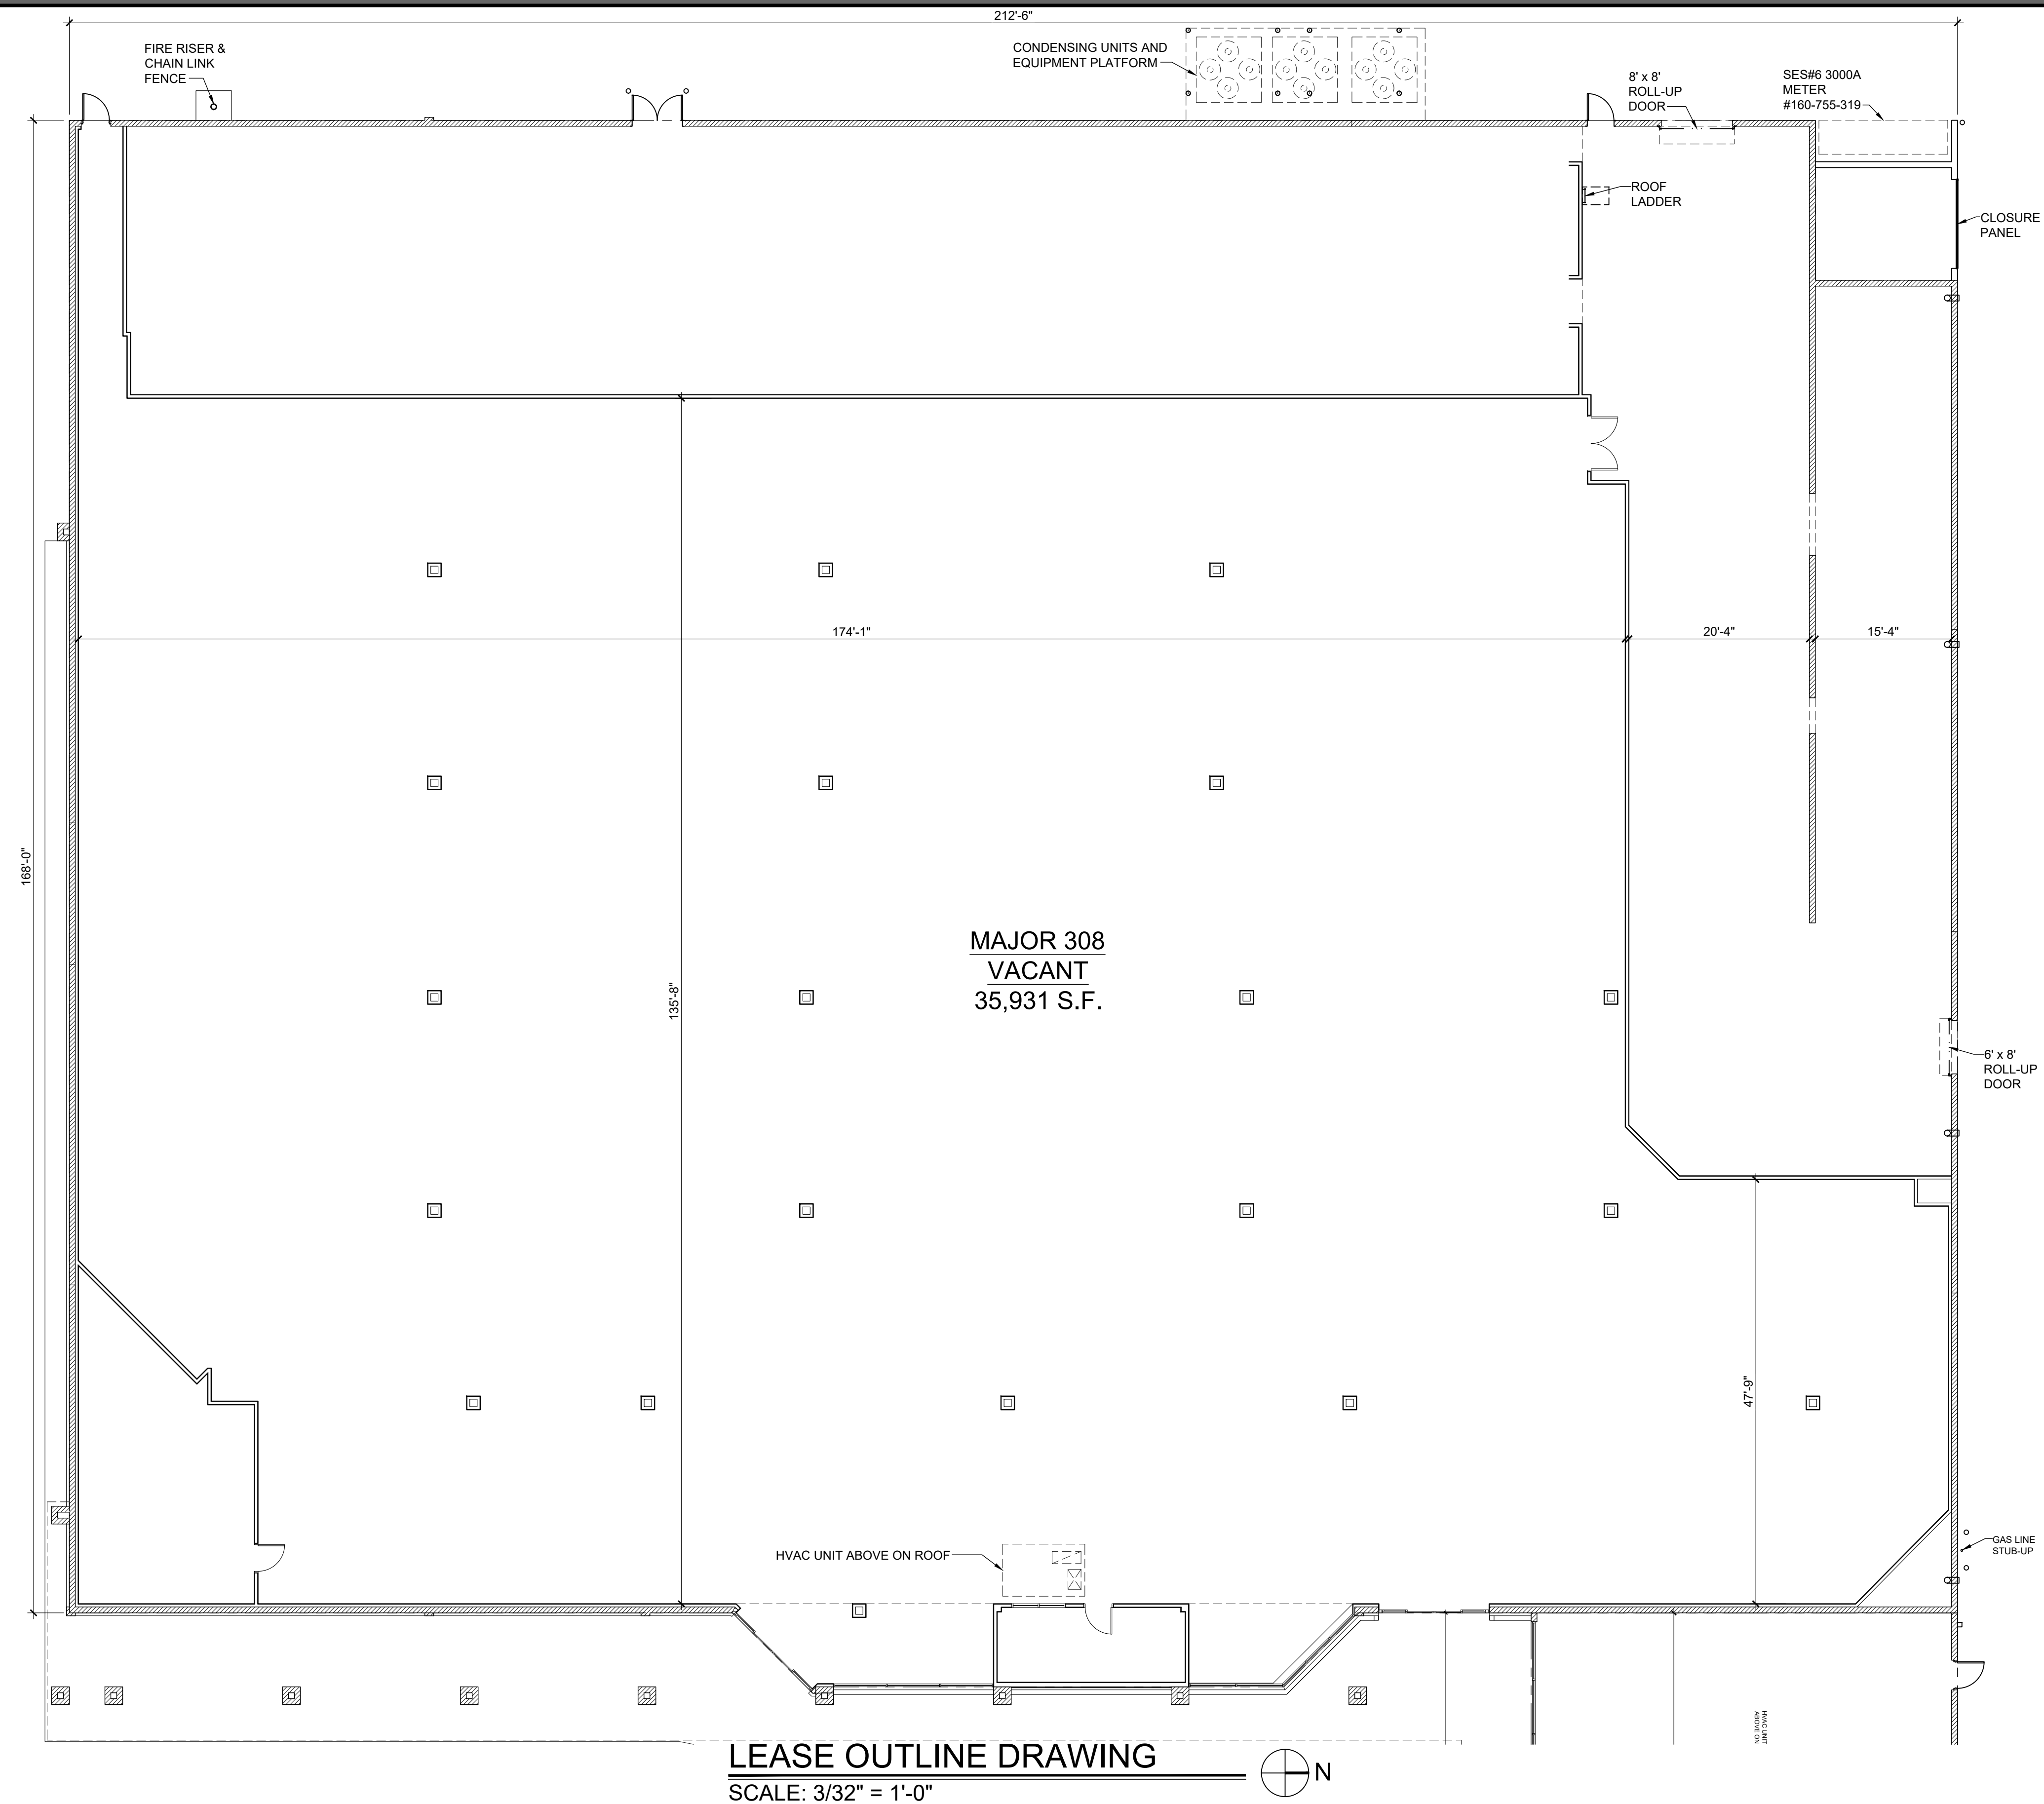

Existing Shopping Center

LOD - Major

308 East University Drive, Mesa, Arizona 85201

09.19.2022

PROJECT 22063.00

UPWARD
ARCHITECTS

1155 W. Rio Salado Parkway, Suite B-101, Tempe, AZ 85281
602.753.5222 www.upwardarchitects.com