


Randolph Business Park

1510 Randolph Street
 Suite 403
 Carrollton, Texas 75006

Sheet **A4**
 Of 9 Sheet(s)

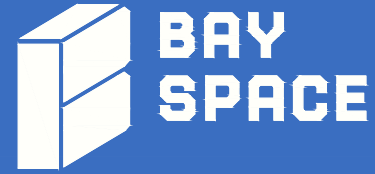

© 2025 HosScans, LLC.
 All right reserved.
 These drawings and any associated documents are protected under U.S. copyright law. No part of this work may be produced, distributed, or used in any form, by any method, for any purpose, without the prior written consent of HosScans, LLC. Unauthorized use is subject to legal action.


Scale: Not to Scale
 Sheet Size: 11" x 8.5"
 Not For Construction

Usable Square Foot Analysis

OFFICE AREA:	437	45%
WAREHOUSE AREA:	534	55%
TOTAL AREA:	971	

Building Information

Deck Height:	12'0"
Clear Height:	10'0"
Ceiling Height:	7'10"
Sprinklered:	No
Mechanical Area:	N/A

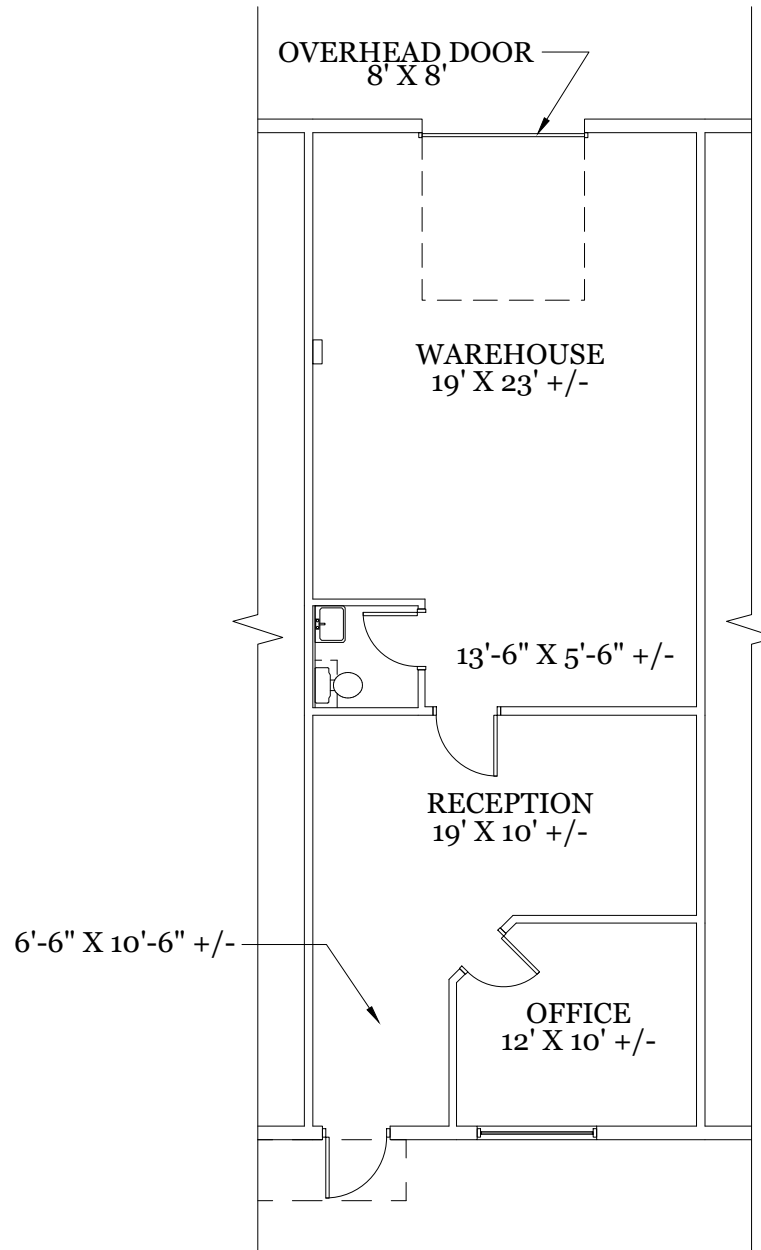

As Built Floor Plan for Marketing

