



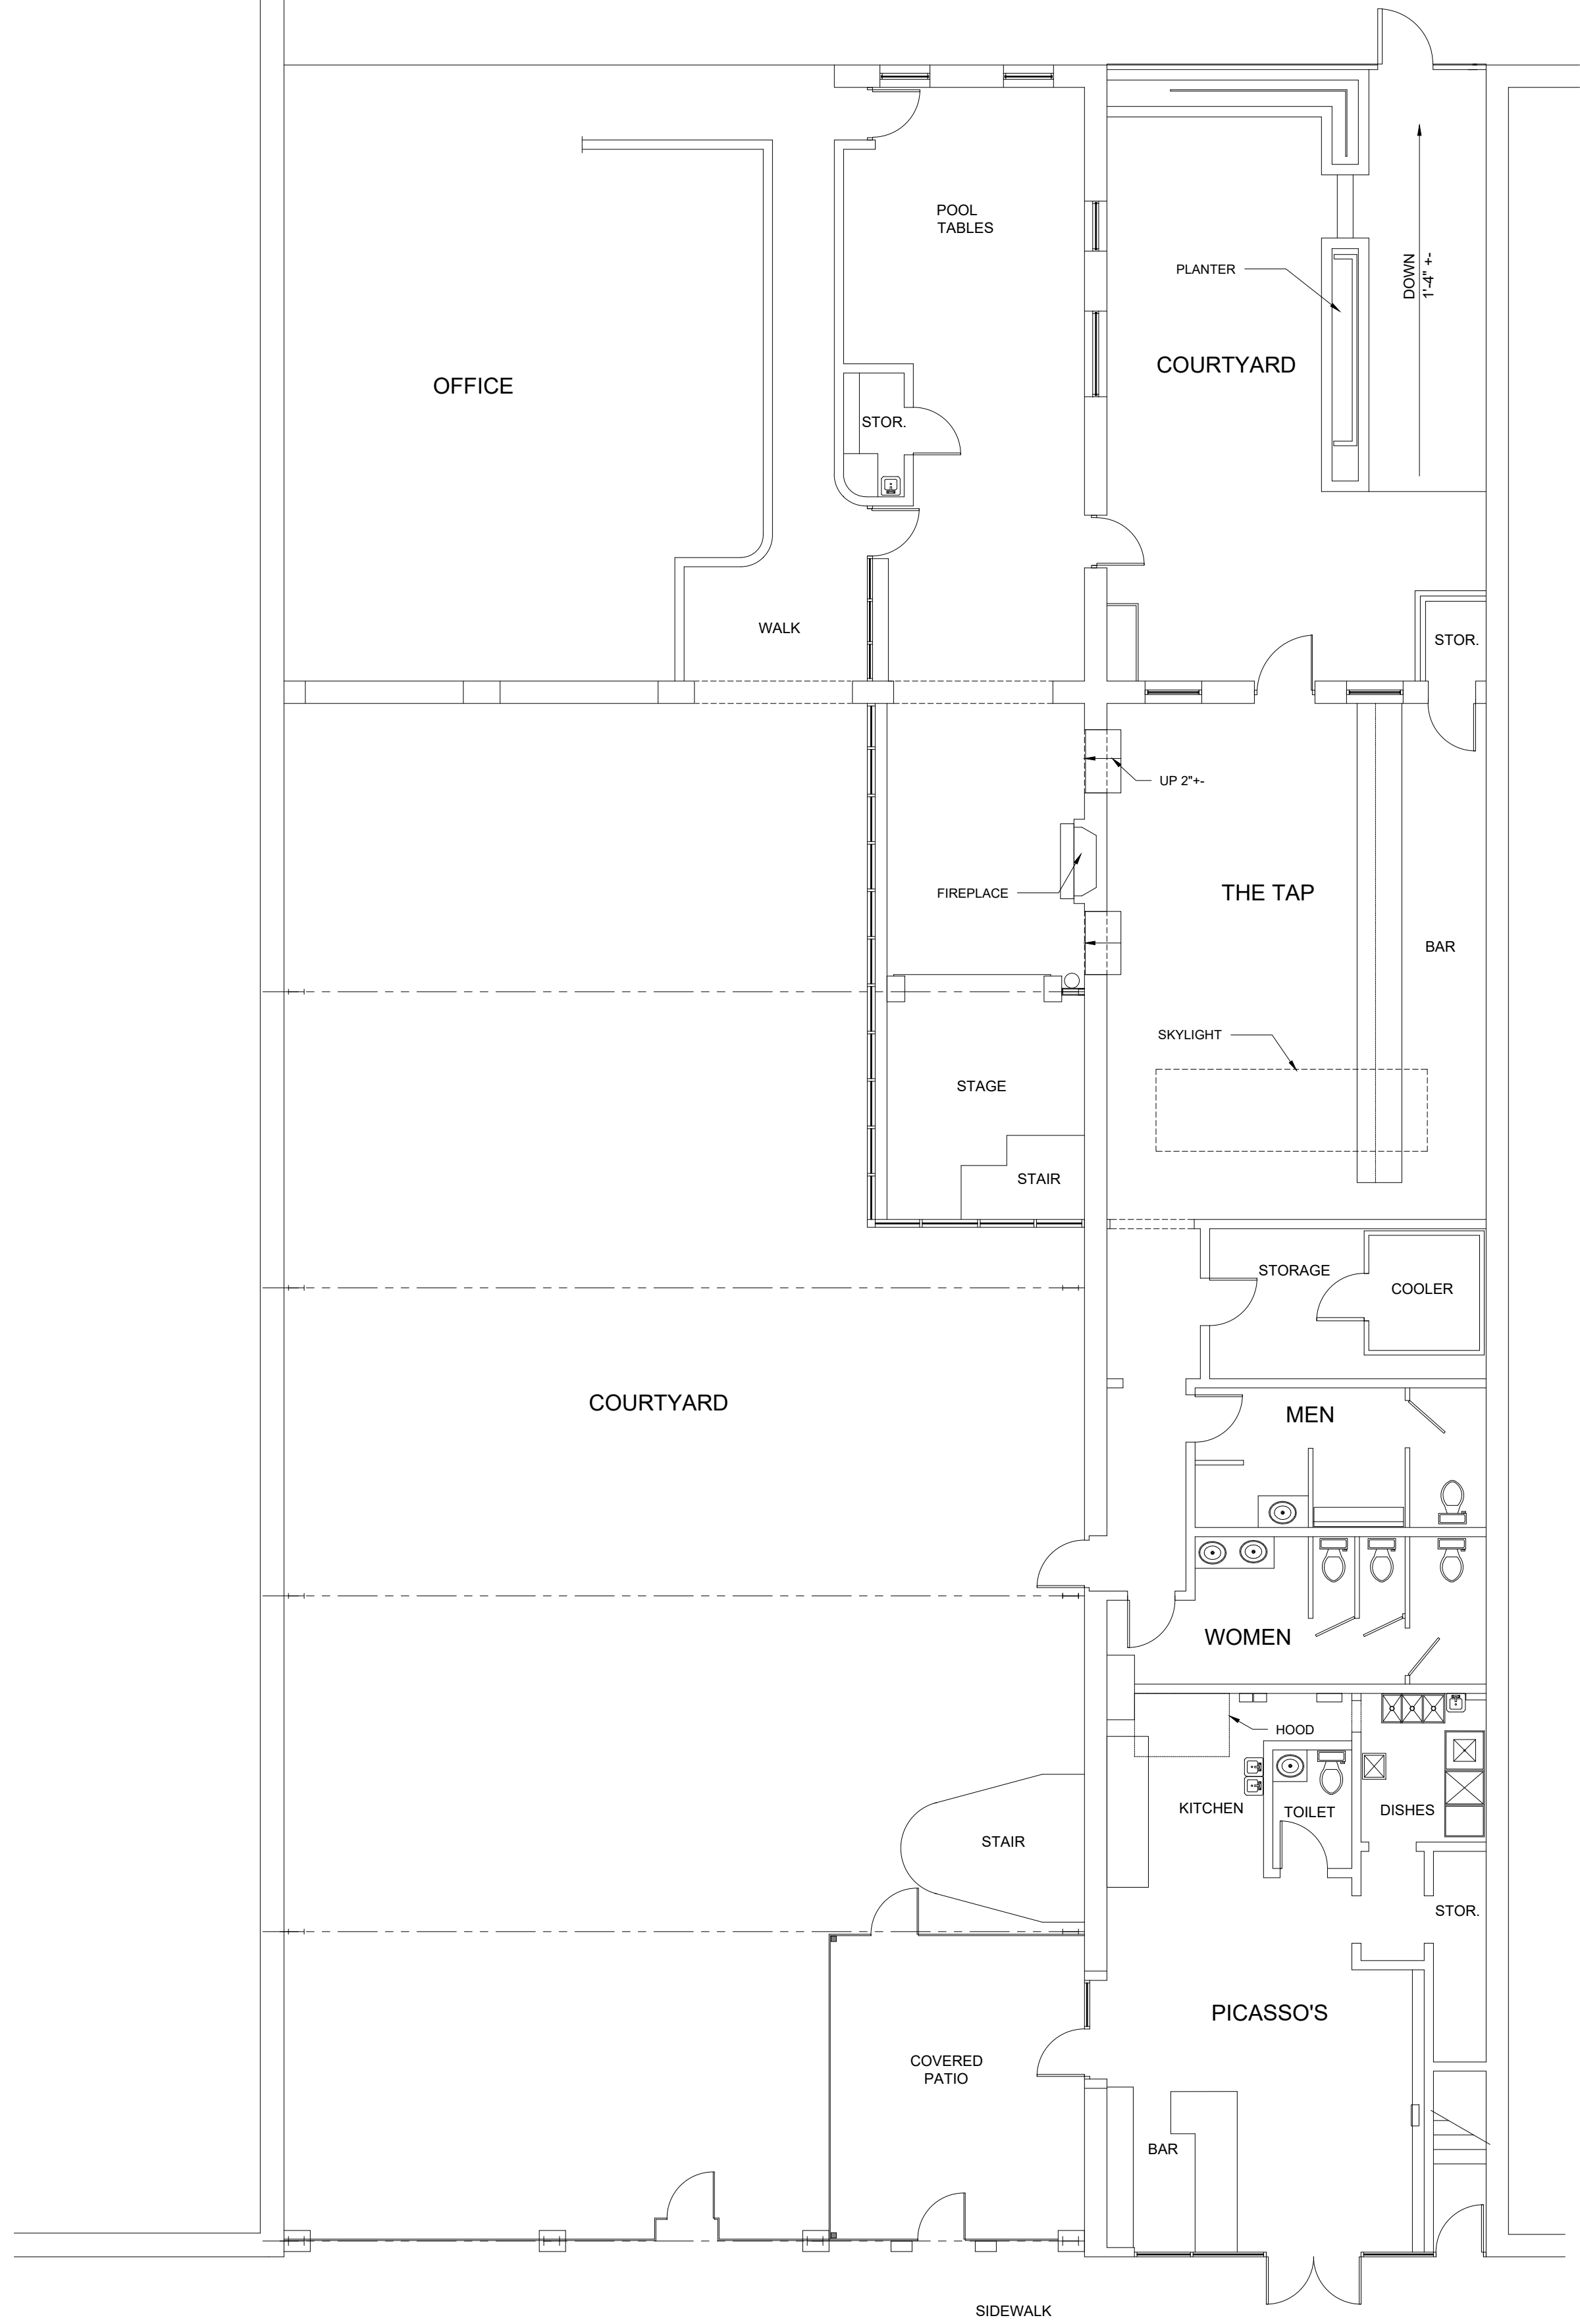

1 BUILDING PLAN
A-1 SCALE: 1/8"=1'-0"

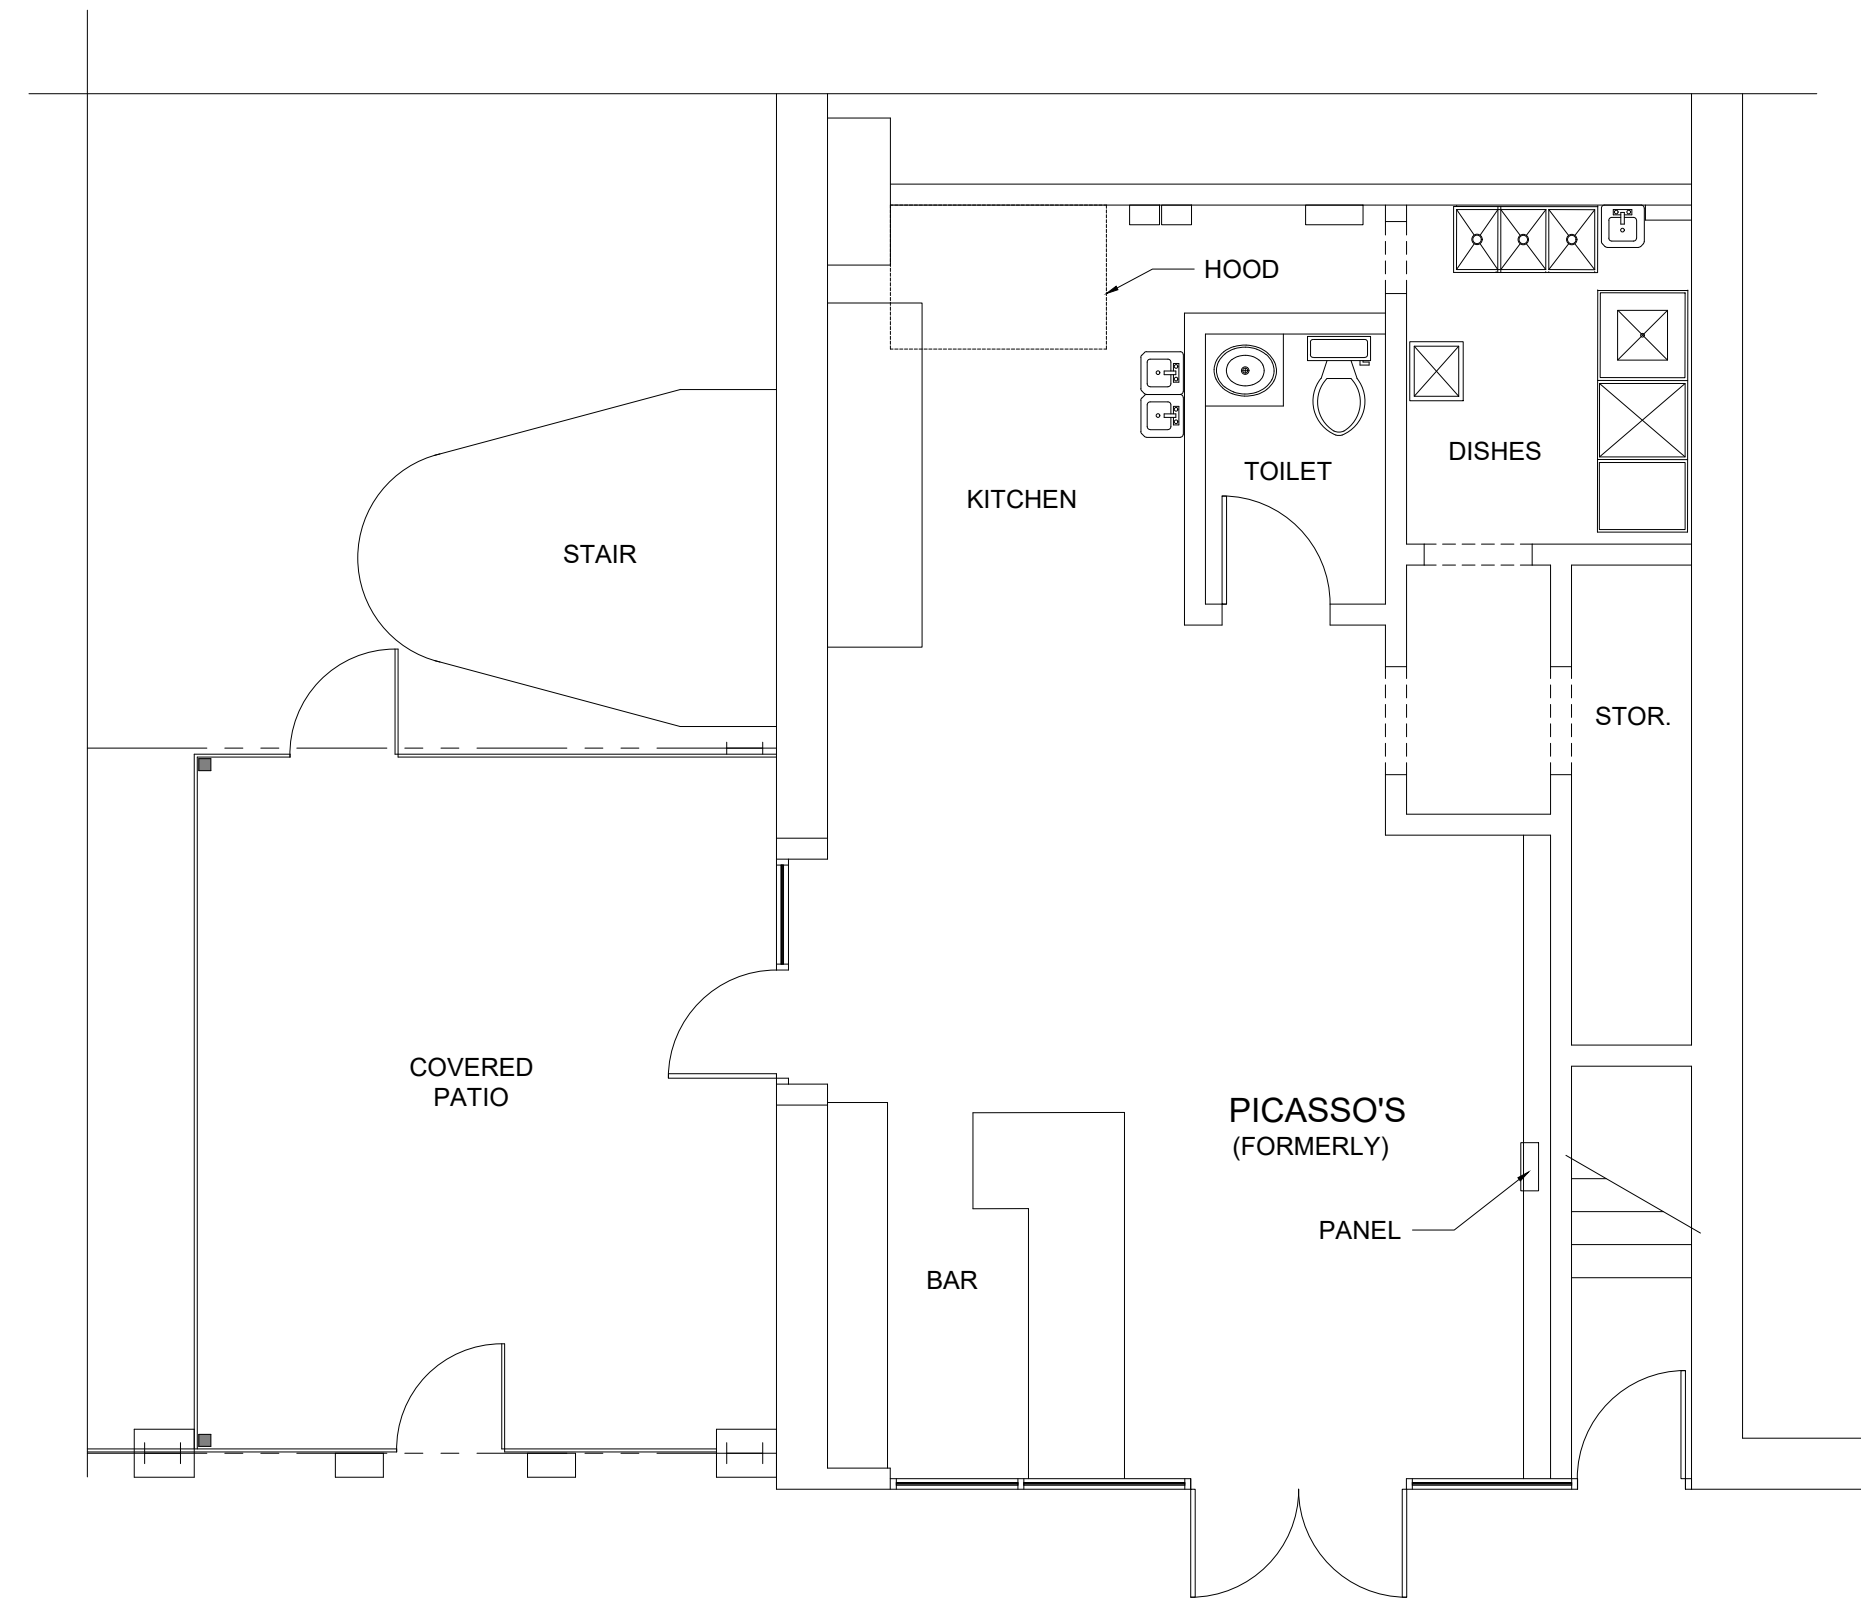

2 PISCASSO'S PLAN
A-2 SCALE: 3/16"=1'-0"

REVISIONS		NO.	DATE	DESCRIPTION

Ray Underwood
ARCHITECT
1041 Hunter Road
Cataula Georgia 31804
Phone 706-442-2363 ray@nuarchitect.com



AS-BUILT
1020/1024 BROADWAY
Columbus Ga. 31901

DRAWINGS ARE PROPERTY OF THE
ARCHITECT AND ARE NOT TO BE
REPRODUCED WITHOUT
PERMISSION

JOB # 22104

AUGUST 12, 2022

SHEET
A-1
1 OF 1