


Scottsdale City Center

7201 East Camelback Road . Scottsdale
Suite 100 - 5,498 RSF

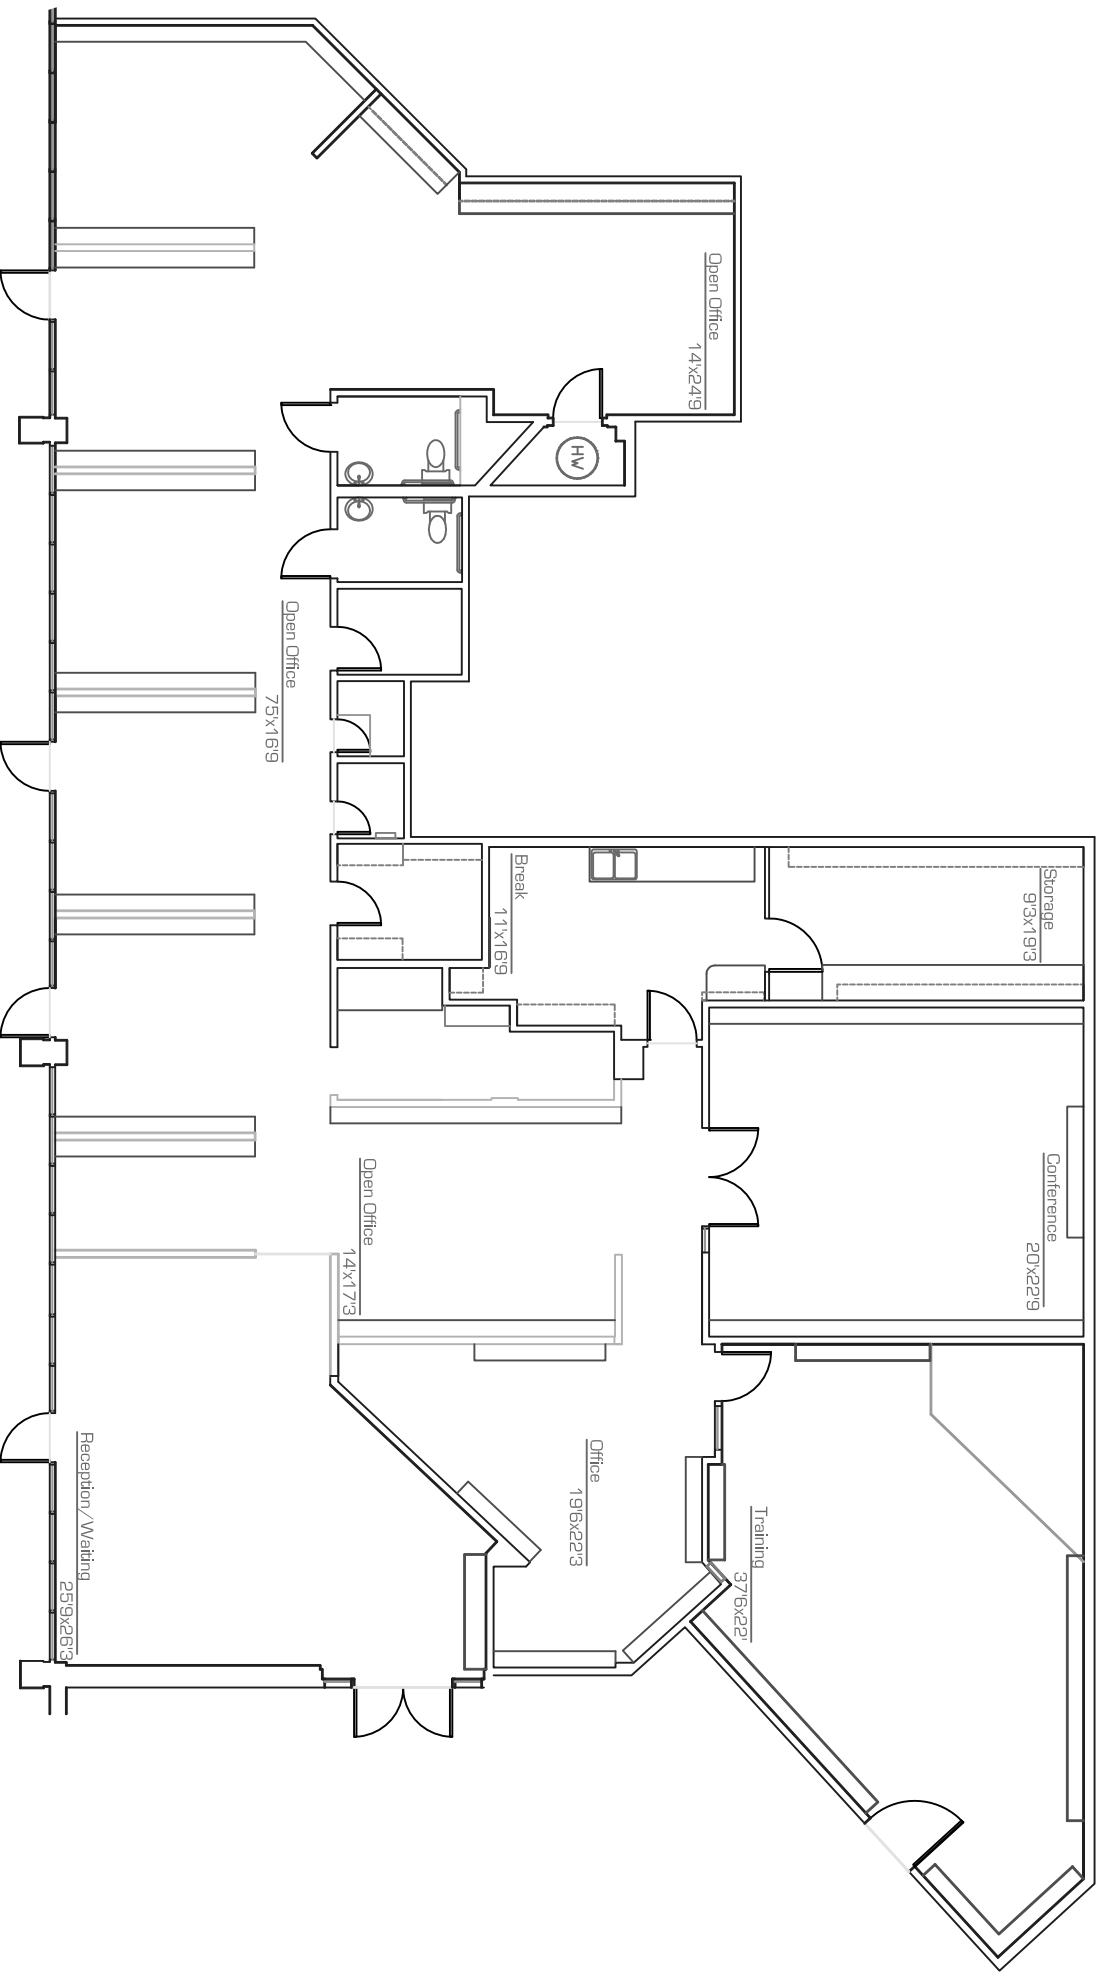


as-built

scale: nts

22.Oct.2010

*All dimensions are approximate and all information is of general nature.

precision **DIMENSIONS**

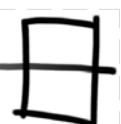

as-built . space plans
architectural design

6 0 2 . 7 9 0 . 6 4 1 2