


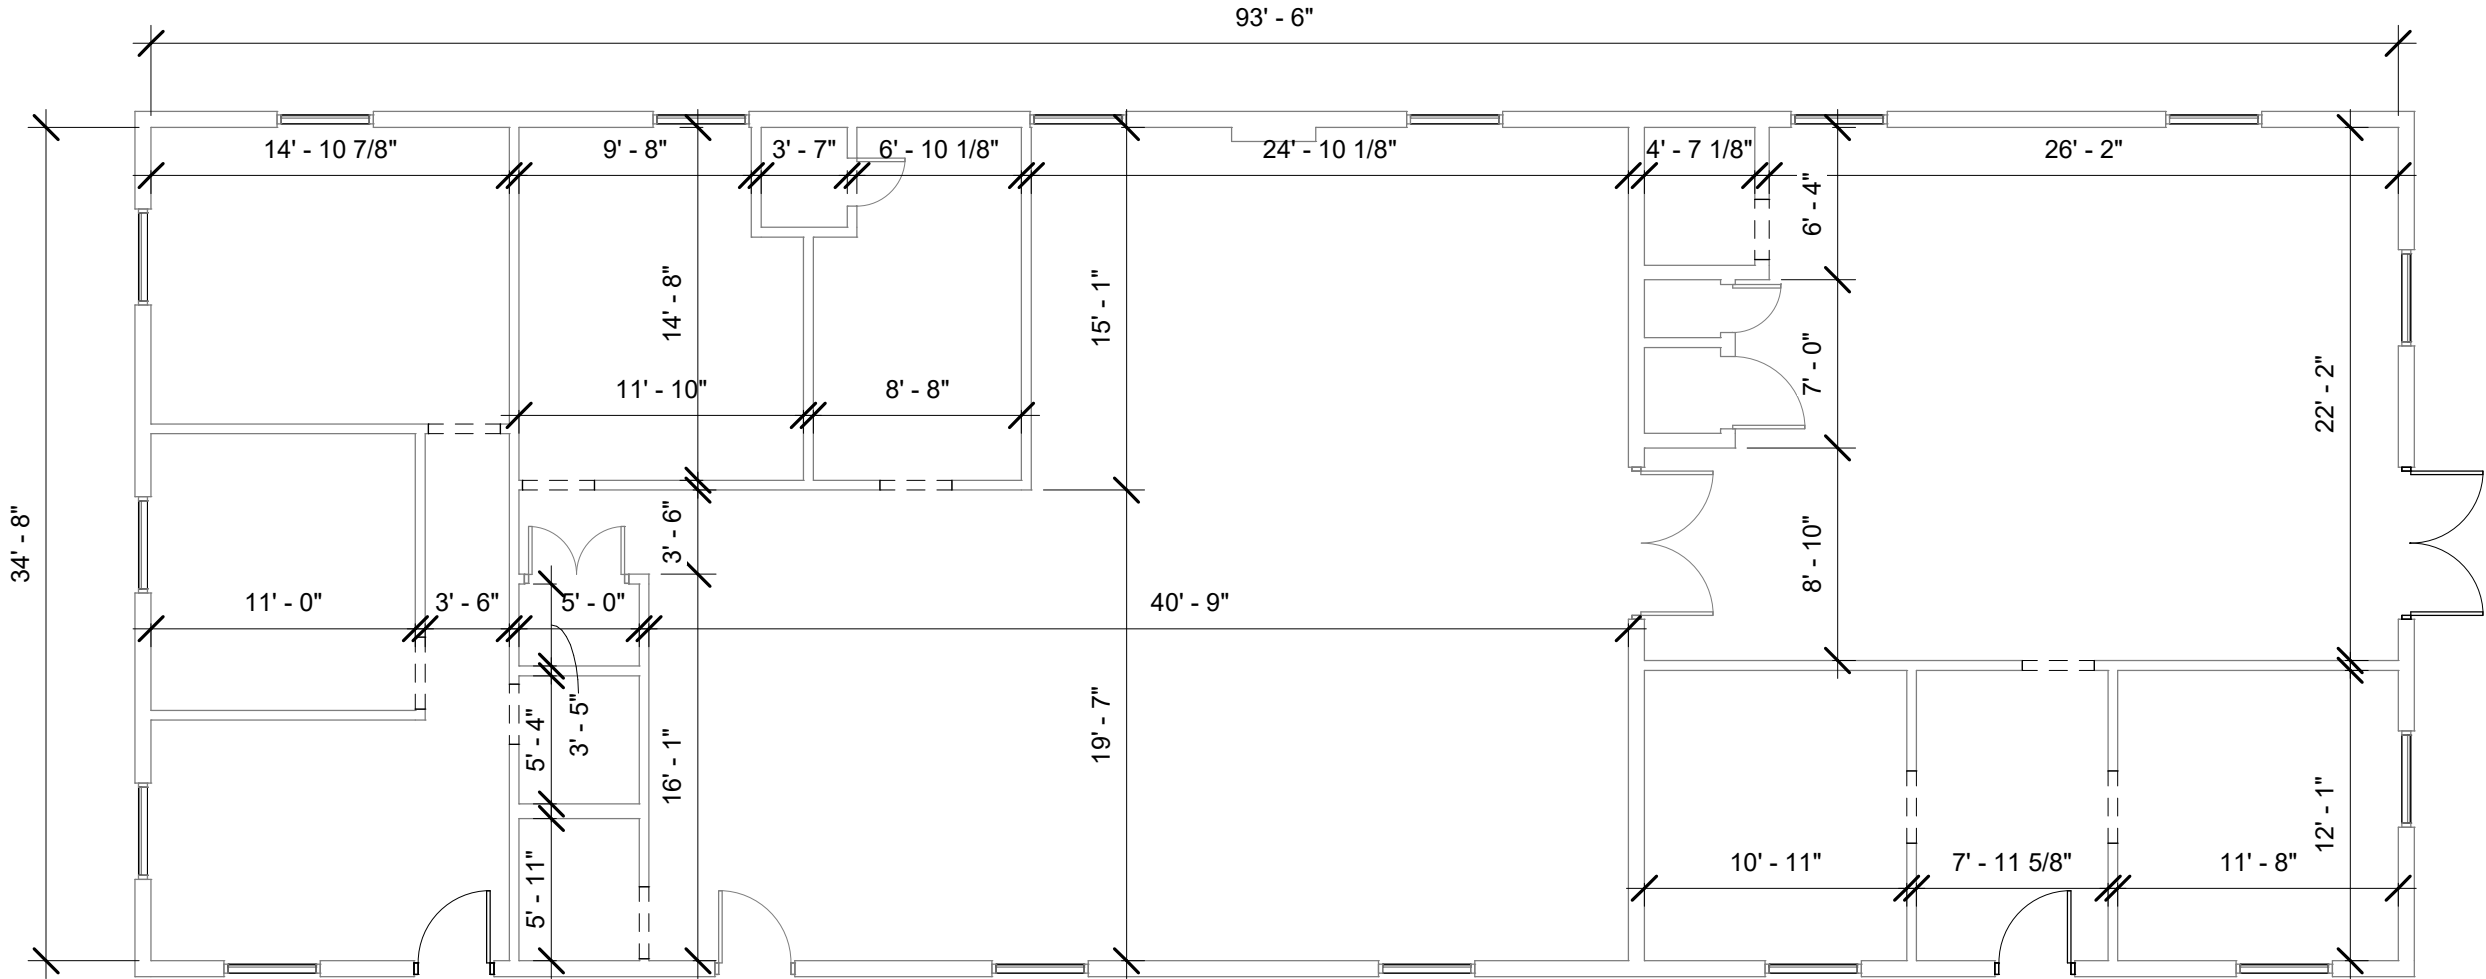

1 **FIRST FLOOR PLAN**

A1.0 | 1/8" = 1'-0"

GREY WOLF ARCHITECTURE

ARCHITECTURE PLANNING INTERIOR DESIGN

1543 CHAMPA ST SUITE 200
DENVER COLORADO 80202
303.292.9107 fax 303.292.4297

ALL DRAWN AND WRITTEN INFORMATION APPEARING HEREIN IS COPYRIGHTED INFORMATION AND SHALL NOT BE
DUPLICATED, DISCLOSED, OR OTHERWISE DUPLICATED WITHOUT THE WRITTEN CONSENT OF GREY WOLF ARCHITECTURE

AS BUILT

14335 W 44th

14335 W 44th

GOLDEN, CO

PROJECT NO.:

DATE:

DRAWN BY:

SHEET:

19-542

9/24/2019

9:47:39 AM

ACJ

A1.0