

ARCHITECTURE \ INTERIORS \ ENGINEERING

**KKT ARCHITECTS, INC.**  
2200 SOUTH UNICA PLACE, SUITE 200  
TULSA, OKLAHOMA 74114  
[P] 918.744.4270 \ [F] 918.744.7849  
WWW.KKTARCHITECTS.COM

# NEWPORT SQUARE SHOPPING CENTER

3323-B EAST  
31ST STREET


TULSA,  
OKLAHOMA

06/09/2020



AS-BUILT  
FLOOR PLAN

# AS.1

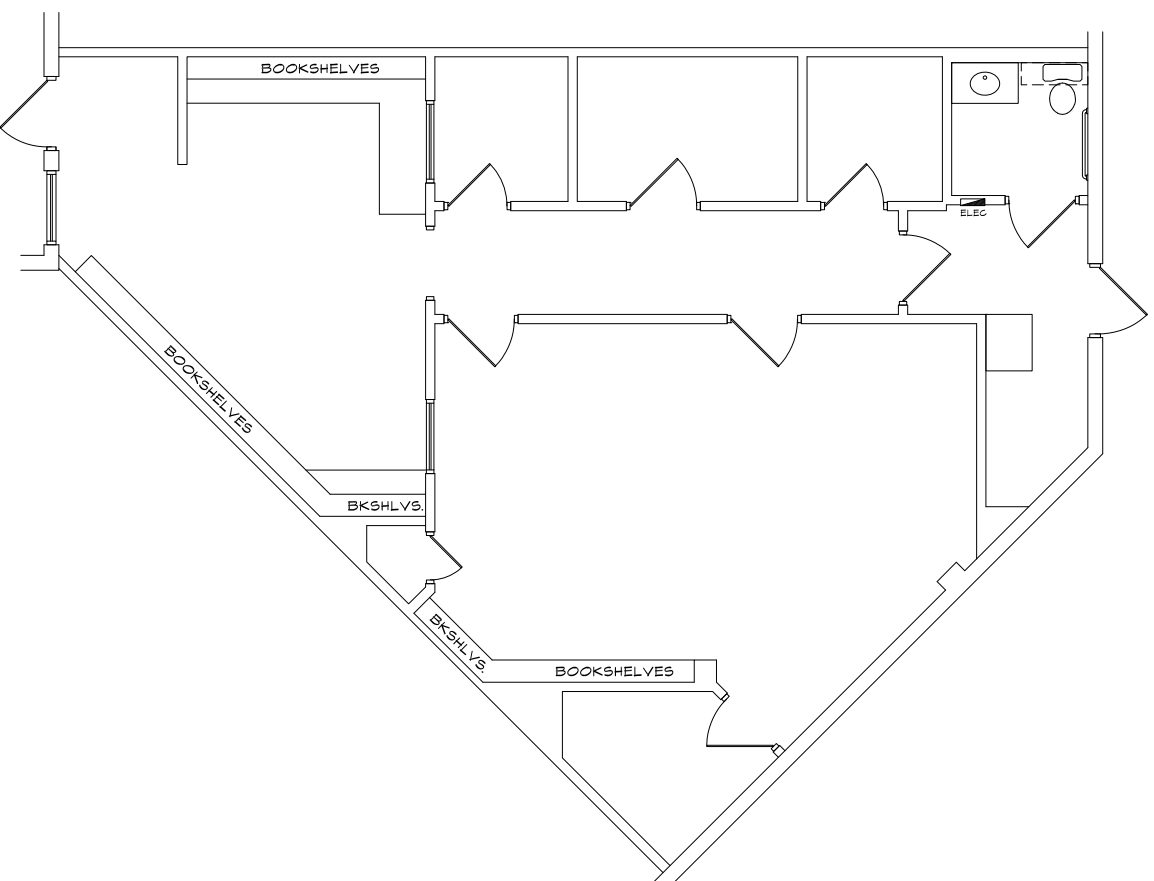

# A FLOOR PLAN

SCALE: N.T.S.



NORTH