


Grand Oak Center

977 Oaklawn Ave.
Emhurst, Illinois 60126

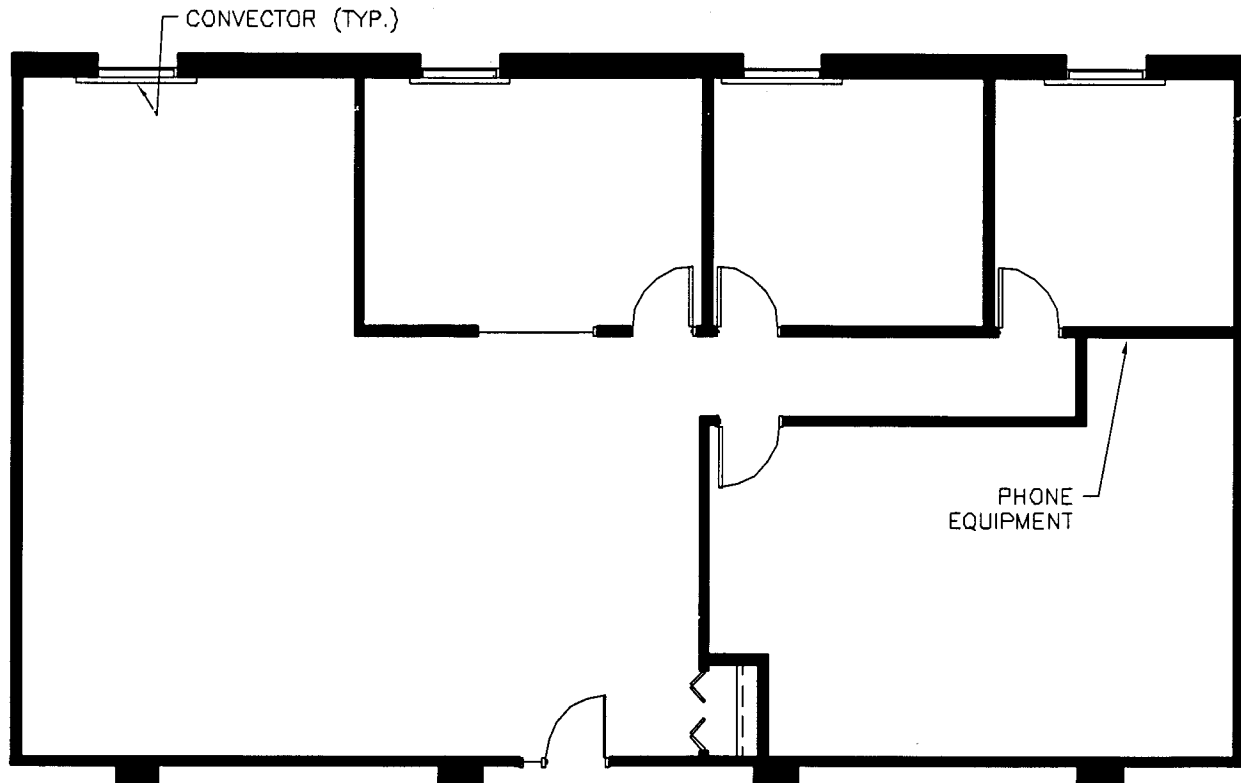

Suite #109 - "Wall/Door As-Built" Conditions

~~2,525~~ Rentable Square Feet
2,525

Scale: N.T.S.

**A. MOUREK
MANAGEMENT INC.**

December 7, 2005 (Field Verified)

