


I:\ACAD\WZO5\AS_BUILT\BB_00.DWG

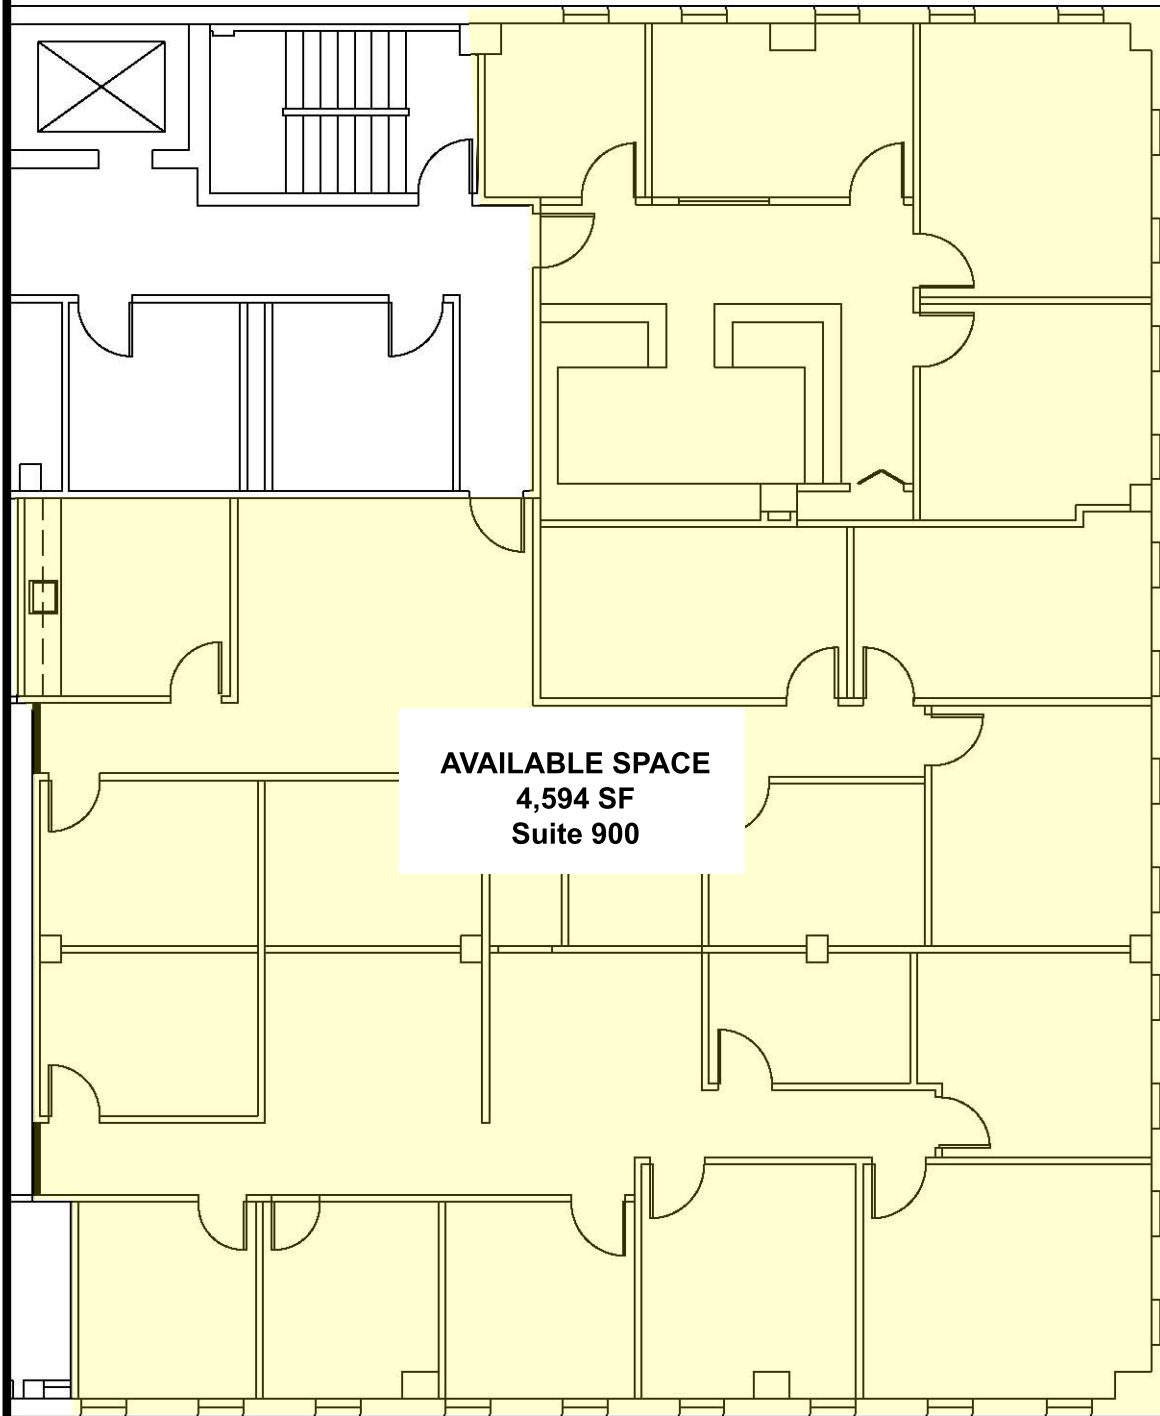

AVAILABLE SPACE
4,594 SF
Suite 900

NPD, INC. DOES NOT WARRANT THE ACCURACY OF ANY DIMENSIONS SET FORTH HEREIN. CONTRACTOR IS RESPONSIBLE FOR VERIFYING ALL SITE CONDITIONS TO INCLUDE FIELD DIMENSIONS WHERE APPLICABLE. SHOULD THERE BE ANY DISCREPANCIES WITH THIS CONSTRUCTION DRAWING PACKAGE, NOTING SHOULD BE NOTIFIED IMMEDIATELY FOR RESPONSE. IF THE CONTRACTOR elects to MAKE ANY CHANGES ON HIS OWN WITHOUT NOTIFYING NPD, HE IS RESPONSIBLE FOR SAME. NPD, INC. DOES NOT PROVIDE ARCHITECTURAL, STRUCTURAL, ENGINEERING OR MECHANICAL SERVICES. IF SUCH SERVICES ARE REQUIRED BY THIS DRAWING PACKAGE, A LICENSED PROFESSIONAL MUST BE RETAINED. NPD, INC. PREPARED THIS DRAWING PACKAGE AS A PRACTICAL SOLUTION TO INTERIOR DESIGN PROBLEMS. IT IS NOT INTENDED FOR ARCHITECTURAL, ENGINEERING OR CONSTRUCTION USE. ANY CEILING, ELECTRICAL, KITCHEN, BATHROOM OR LIKE PLAN OR SPECIFICATION IS PREPARED TO SHOW ONLY LOCATION OF OUTLETS, FIXTURES, VENTS, ETC. AND THE TYPE OF FIXTURE AND EQUIPMENT. THIS DRAWING PACKAGE IS THE PROPERTY OF NPD, INC. UNAUTHORIZED USE OF THESE DOCUMENTS IS PROHIBITED.

APPROVAL:

THESE DRAWINGS ARE PROTECTED UNDER THE COPYRIGHT ACT OF 1976 AND SHALL NOT BE REPRODUCED WITHOUT THE WRITTEN PERMISSION OF NPD, INC.

VACANT SPACE
401 WASHINGTON AVE
TOWSON, MARYLAND
9TH FLOOR
AS-BUILT PLAN

NPD Inc
INTERIOR DESIGN & PLANNING
16 GREENMEADOW DRIVE
TIMONIUM, MARYLAND 21093
TEL: 410.561.0561 FAX: 410.561.4809
E-MAIL: nfd@nfd.com

REVISIONS:

DATE:	04/20/05
SCALE:	3/32"=1'-0"
DRAWN BY:	EP
DESIGN BY:	EP
CHECKED BY:	EP
PROJECT #:	WZO52

ID. 1 / 1
OF