


FLOOR PLAN

190 HIGH STREET BOSTON, MA

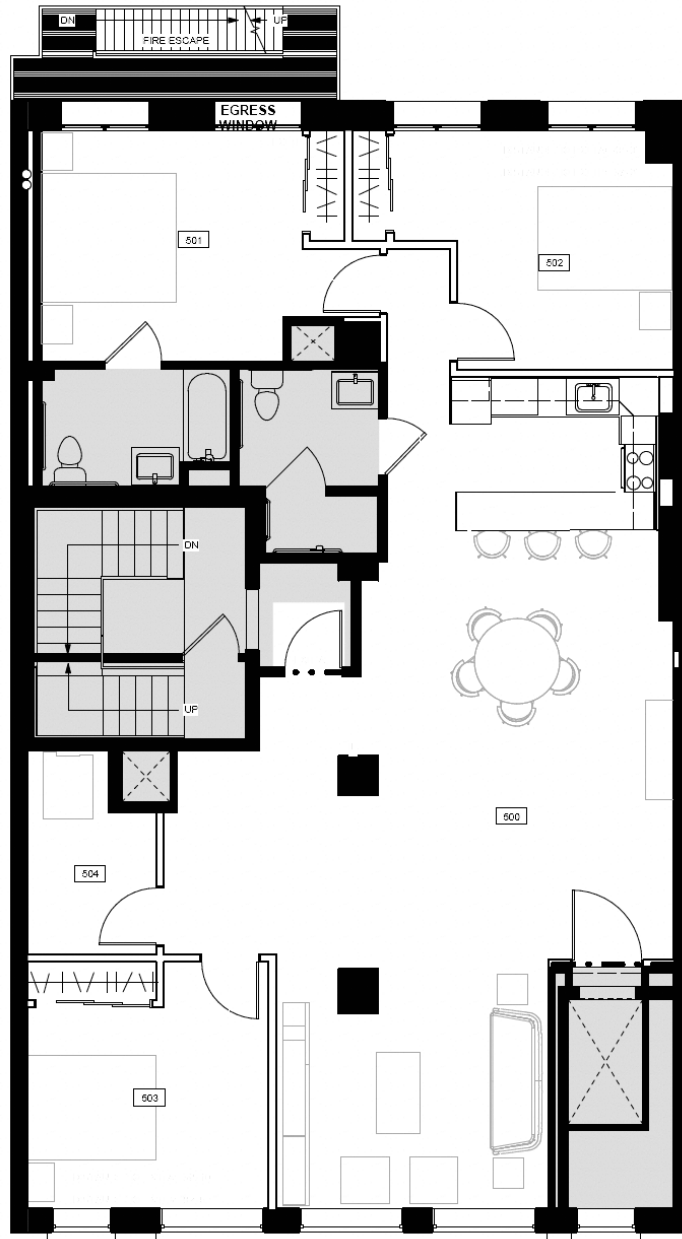

5TH FLOOR | 2,241 SF
AS-BUILT

BONNY L. DOORAKIAN
617.850.9655
bdoorakian@bradvisors.com

ALEKSIA BULKU
617.850.9665
abulku@bradvisors.com



136 Newbury Street | 4th Floor | Boston, MA 02116 | 617.375.7900 | BRAdvisors.com

© Copyright Boston Realty Advisors. All rights reserved. The information contained here has been obtained through sources deemed reliable but cannot be guaranteed as to its accuracy. Any information of special interest should be obtained through independent verification.