


Mechanical and Electrical Plan
Scale 1/8"=1'-0"

As Built 2022,01-21

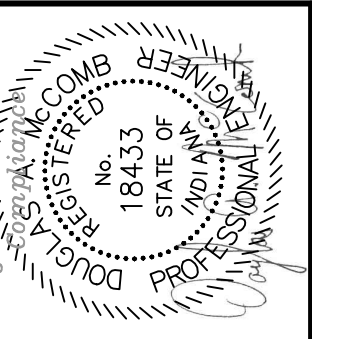

Douglas A. McComb, Inc.
PROFESSIONAL ENGINEER
15610 Lima Road, P.O. Box 503, Huntertown, IN, 46748
Fax: 260-637-5551 Phone: 260-637-5551
Email: doug@douglasmccomb.com

MEP Plan-As Built
All Occasion Warehouse
6024 Highway Dr. Building 8
Fort Wayne, Indiana 46818

DATE:	DRAWN BY:
2016.03-21	dcmc
SCALE:	CHECKED BY:
1/8"=1'-0"	dcmc
JOB NO.	1526

MEP1.1