


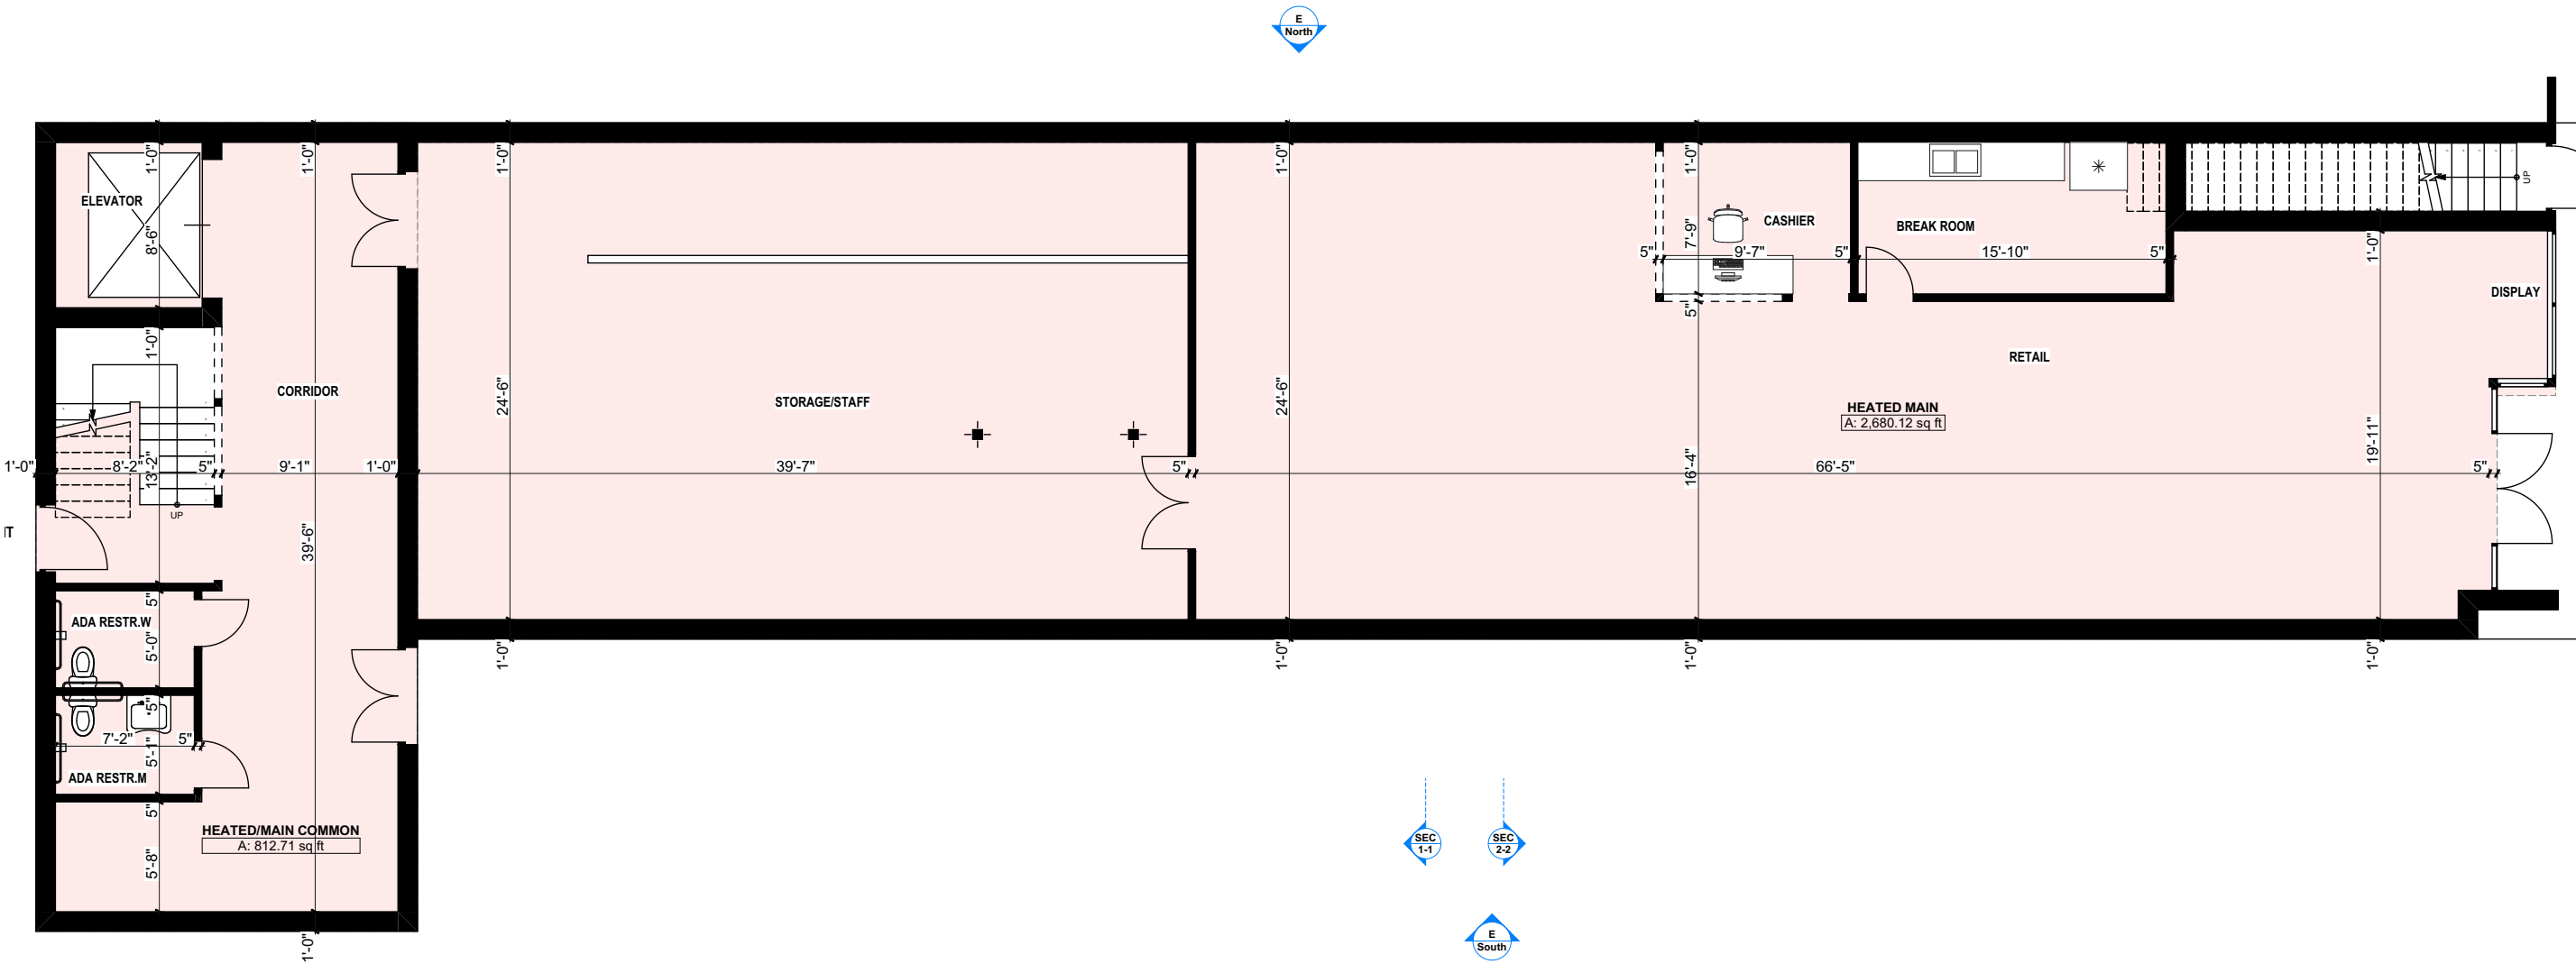

AS BUILT-1

Main Level

1:106.67

Building Area Schedule			
Home Story	Floor Area	Type	Area
Main Level			
	HEATED MAIN	Commercial Heated	2,680.13
	HEATED/MAIN COMMON	Commercial Heated	812.71
			3,492.84 ft²

Floor Area Schedule

PROJECT LOCATION MAP

GENERAL NOTES:

1. DO NOT USE AS A BLUEPRINTS WITHOUT MR LLC PERMISSION

2. PLEASE NOTE INTERIOR DIMENSIONS WERE NOT USED IN CALCULATING SQUARE FOOTAGE

3. SIZE OF HEATED AND NOT HEATED AREA AND OTHER INFORMATION WERE OBTAINED PER THE NC REAL ESTATE COMMISSION GUIDELINES (6" FOR EXTERNAL WALLS EXEPT CONDOMINIUMS)

4. FOR REMODELING QUESTIONS OR MORE DETAILED CAD DRAWINGS (INC SITE PLAN, SECTIONS, ELEVATIONS) ALSO 3D MODEL PLEASE CONTACT ALFRED ZALYS

MOB. 828 231 7305 E-MAIL: A.ZALYS@HOTMAIL.COM

Client:

LEGEND MAP:

HEATED FINISHED/RESIDENTIAL

HEATED FINISHED/COMMERCIAL

NOT HEATED/NOT FINISHED

COVERED PORCH

OPEN DECK

Revision History

Company Title

Measurements

Building Design

ID Drawing

Company

Measure Rite LLC

103 Poplar Spring Trl. Hendersonville

Henderson County 28739

Site Address

429 N Main St, Hendersonville,

NC 28792

Drawing Name

Floor Area Schedule, Main Level

Drawing Status

Contact Name

Alfred ZALYS

mob. 828 231 7305

Job Nr.

MR 1114

Date

8/22/2024

Drawing Scale


1:133, 1:106.67

Layout ID

AS BUILT-1

Revision

01 - WIP

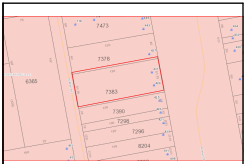

PROJECT LOCATION MAP

GENERAL NOTES:
1. DO NOT USE AS A BLUEPRINTS WITHOUT MR LLC PERMISSION.
2. PLEASE NOTE INTERIOR DIMENSIONS WERE NOT USED IN CALCULATING SQUARE FOOTAGE.
3. SIZE OF HEATED AND NOT HEATED AREA AND OTHER INFORMATION WERE OBTAINED PER THE NC REAL ESTATE COMMISSION GUIDELINES (8' FOR EXTERNAL WALLS EXCEPT CONDOMINIUMS).
4. FOR REMODELING QUESTIONS OR MORE DETAILED CAD DRAWINGS (INC SITE PLAN, SECTIONS, ELEVATIONS) ALSO 3D MODEL PLEASE CONTACT ALFRED ZALYS
MOB. 828 231 7305 E-MAIL: A.ZALYS@HOTMAIL.COM


Client:

LEGEND MAP:

	HEATED FINISHED/RESIDENTIAL
	HEATED FINISHED/COMMERCIAL
	NOT HEATED/NOT FINISHED
	COVERED PORCH
	OPEN DECK

Revision History

Company Title

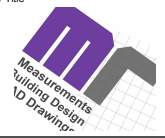

Company

Measure Rite LLC
103 Poplar Spring Trl. Hendersonville
Henderson County 28739

Site Address

**429 N Main St, Hendersonville,
NC 28792**


Drawing Name

**Generic Perspective (4), Generic
Perspective (2)**

Drawing Status

Contact Name	Job Nr.
Alfred ZALYS	MR 1114
mob. 828 231 7305	Date
	8/22/2024
Drawing Scale	Layouts Total
3/32" = 1'-0"	2
	Paper Size
	ANSI B


Layout ID	Revision
AS BUILT-2	

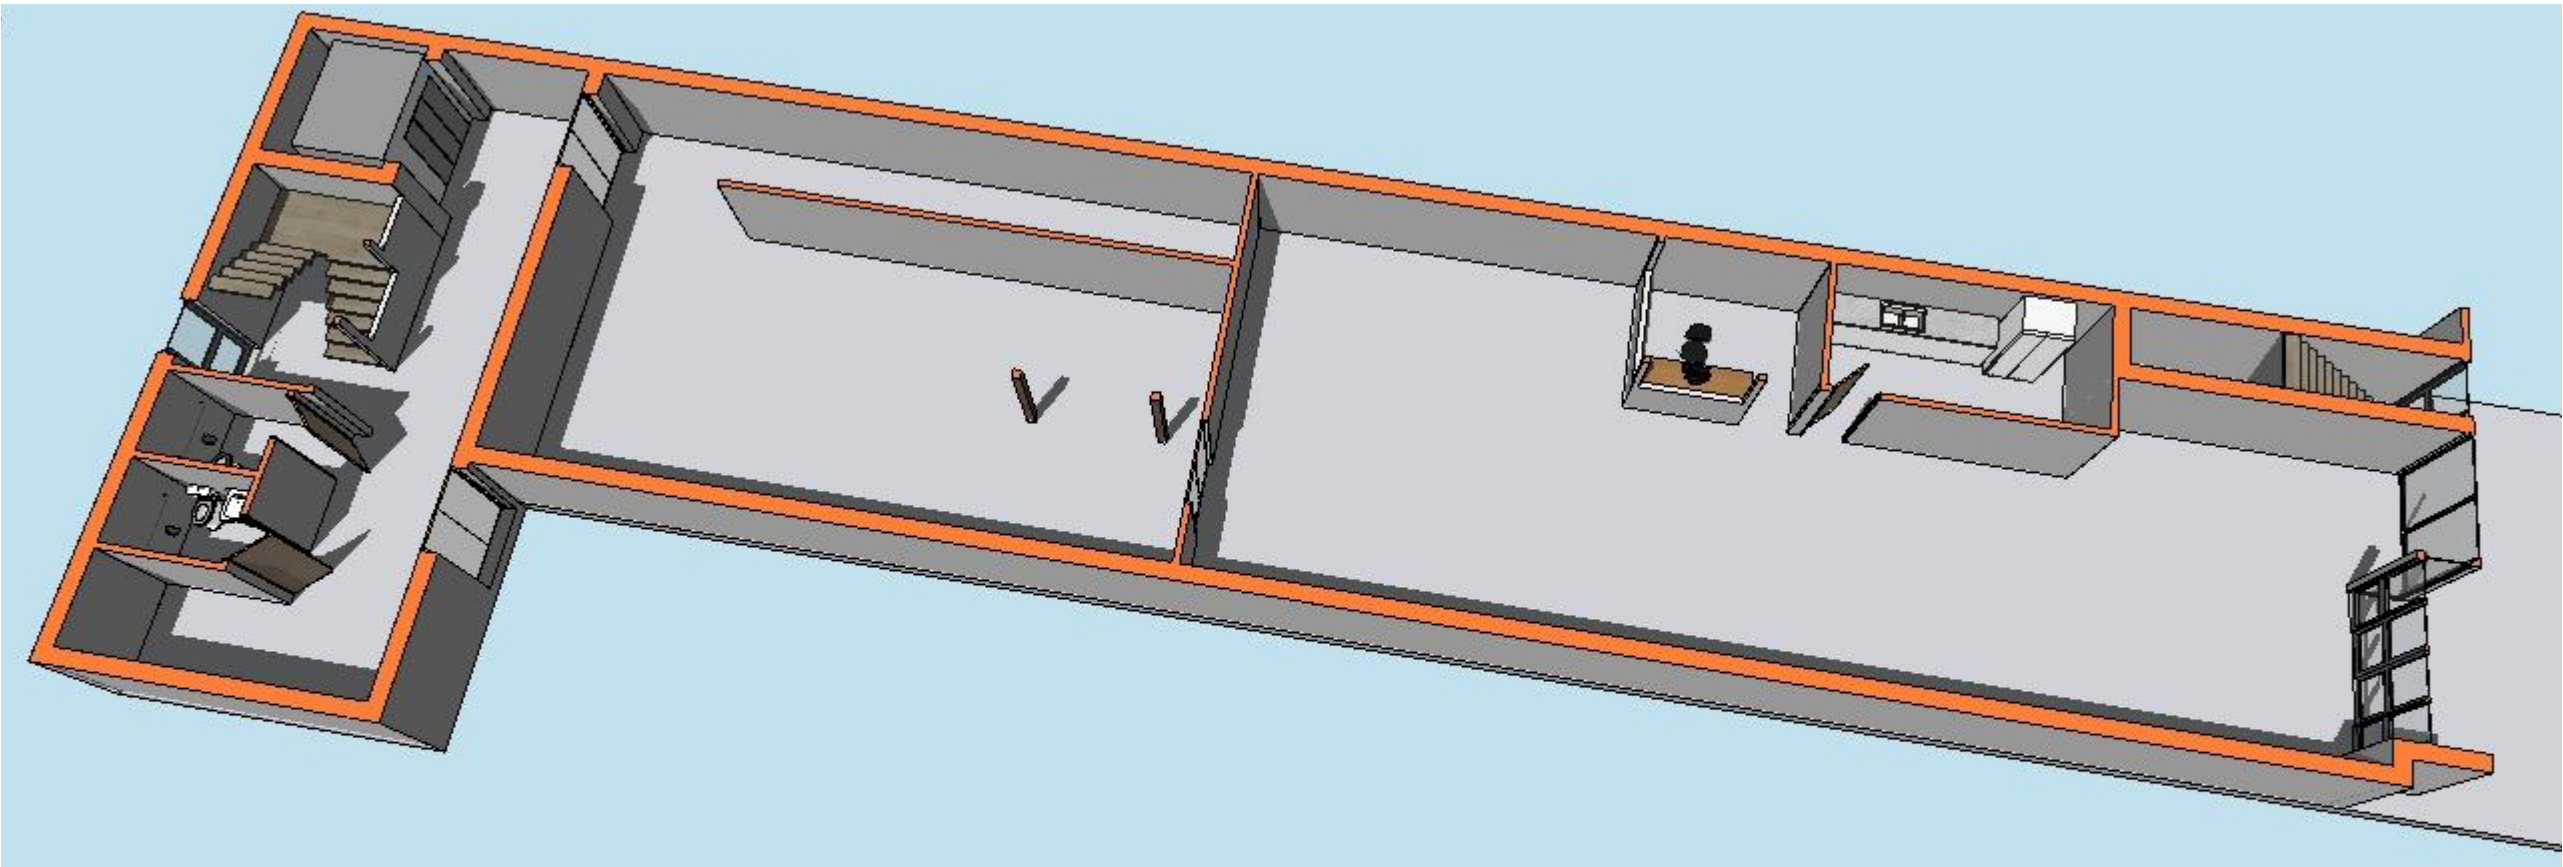

AS BUILT-2

Generic Perspective (4)

3/32" = 1'-0"

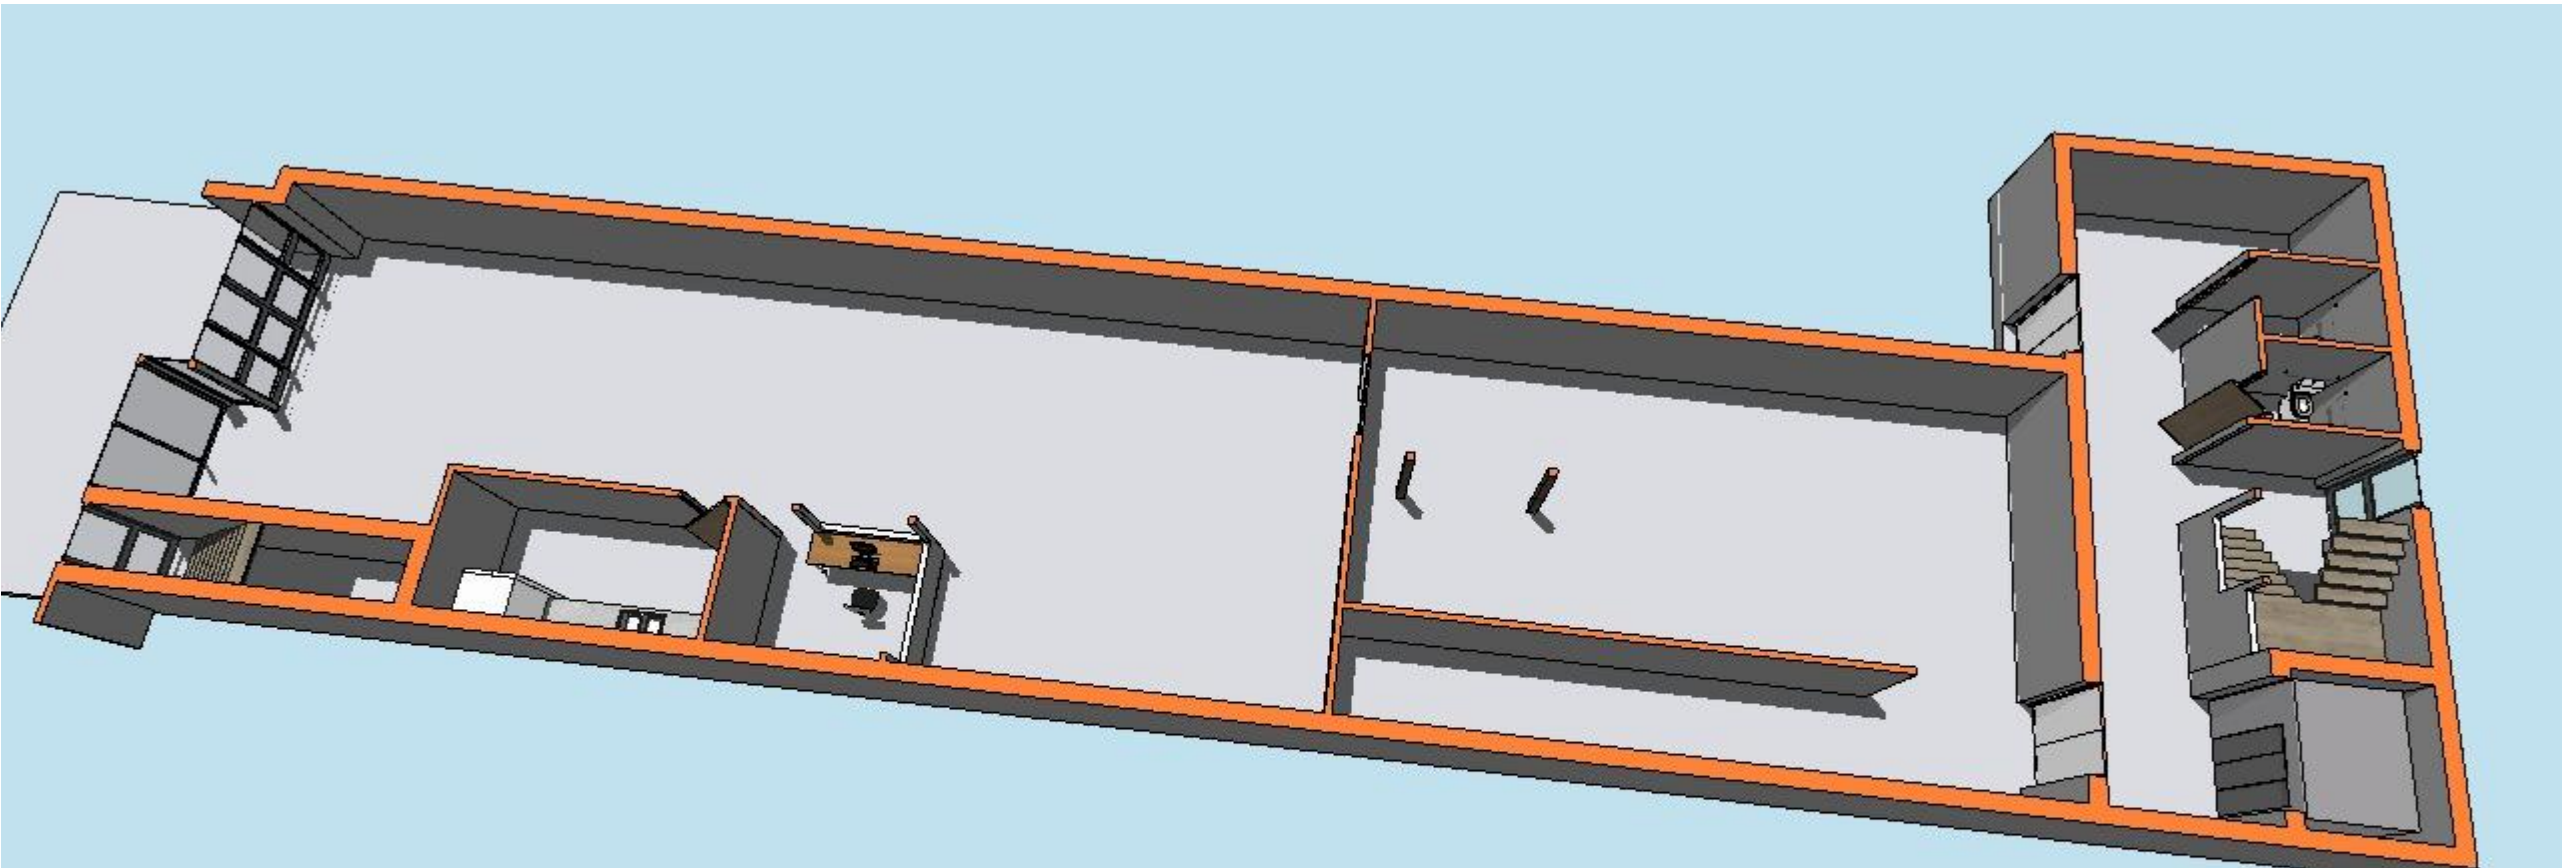

AS BUILT-2

Generic Perspective (2)

3/32" = 1'-0"