
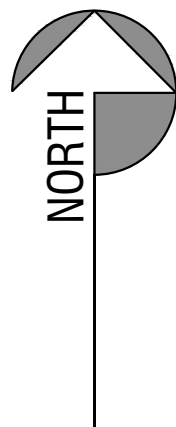


THE CONSTRUCTION DOCUMENT SET FOR THIS PROJECT SHALL INCLUDE THIS DRAWING SHEET, & ALL OTHER SHEETS & ASSOCIATED DOCUMENTS LISTED ON THE DRAWING INDEX ON COVER SHEET. & ANY OTHER DOCUMENTATION AS SUPPLIED BY THE ARCHITECT & CONSULTING ENGINEERS. ALL OF THE PROJECT DOCUMENTS REPRESENT AN ALL ENCOMPASSING WHOLE, & SHALL BE USED IN THEIR ENTIRETY FOR BIDDING & CONSTRUCTION PURPOSES.

10/2023 104-001 JMT/MTA P:\100112 Depot Market Place - General Support Project\100112 - 100112-104-001\104-001 Plot Plan.dwg

1

SITE PLAN
SCALE: 3/32" = 1'-0"

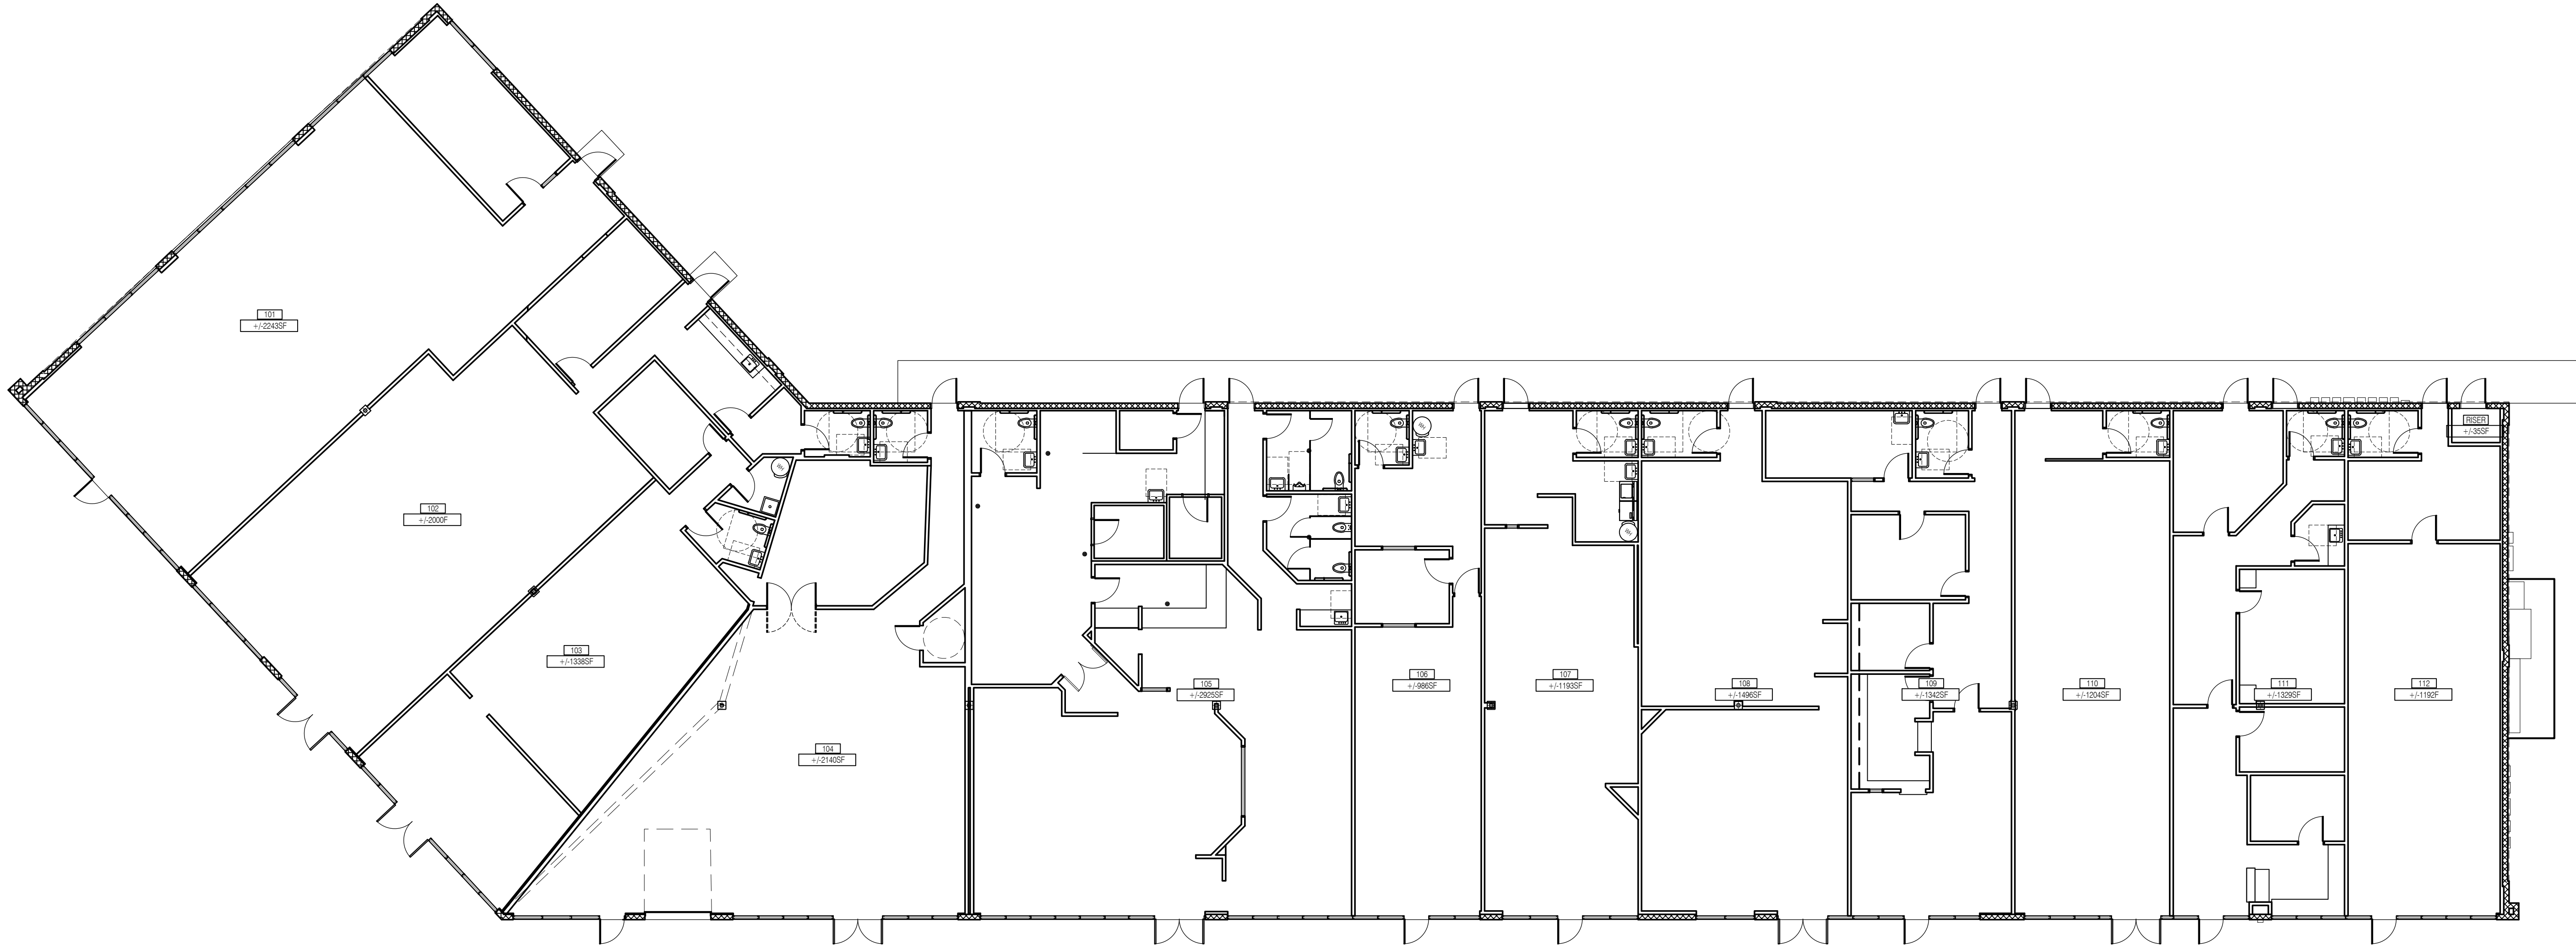

SITE PLAN

AS101

MTA PROJECT NUMBER: _____

DATE: _____

DESCRIPTION: _____

PLOT DATE: _____


AS BUILT PLAN FOR

DEPOT MARKET PLACE

186 E SHELTON ST

PRESOTT DEPOT MARKET PLACE
186 E SHELTON ST
SCOTTSDALE, AZ 85261
BR ZONING

PRESOTT, AZ 86001

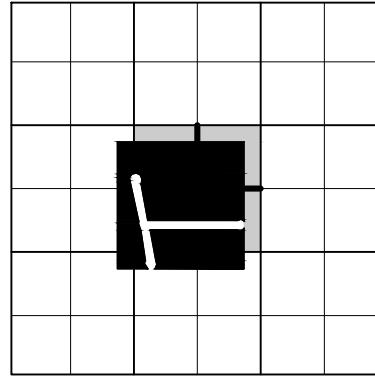

MICHAEL TAYLOR
ARCHITECTS, INC.

118 SOUTH PLEASANT STREET
PHOENIX, AZ 85004
WWW.MTAI.NET

COPYRIGHT 2020, MTAI. ALL RIGHTS RESERVED

