


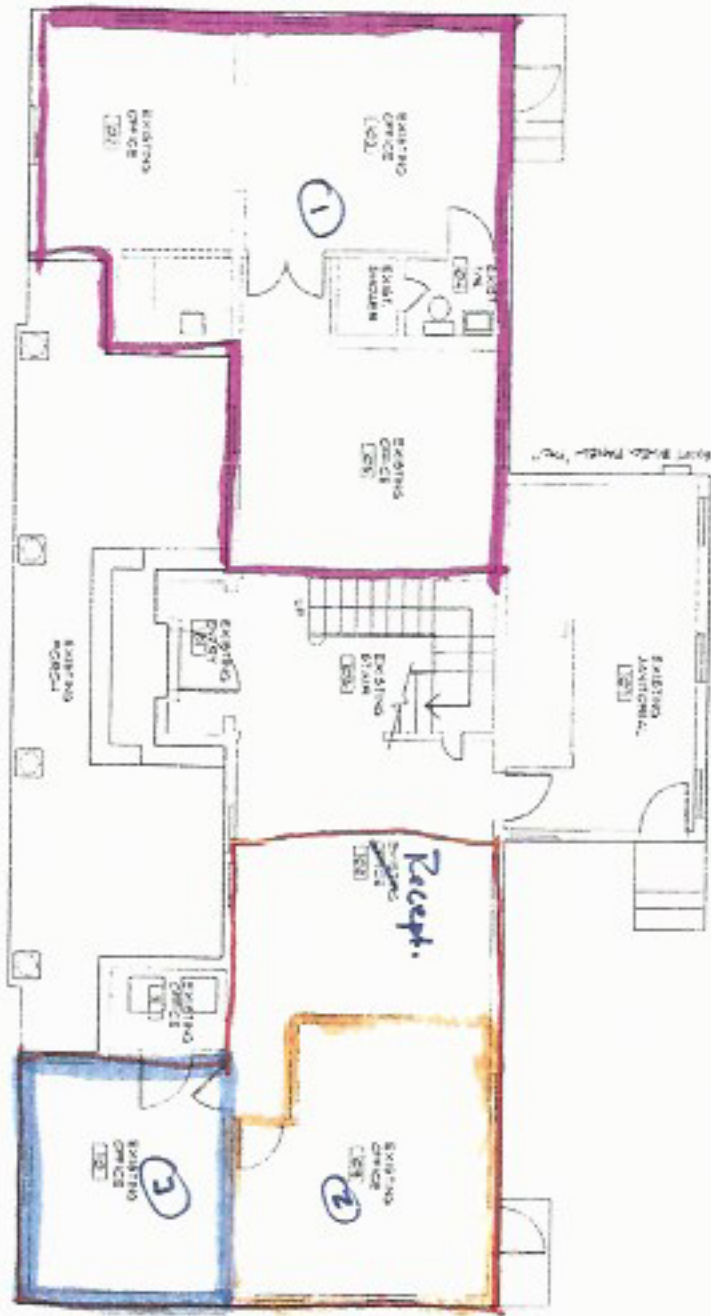

NOTES:
1. ALL EXISTING WALLS TO REMAIN AS SHOWN
2. FLOOR TO BE NEW W/OUT CONSTRUCTION


**AS-BUILT
1 FIRST FLOOR PLAN**
SCALE: 1/4" = 1'-0"

LHS architects designers planners	Project: 3407 Broadway SAN ANTONIO, TEXAS	Date: _____ Rev: _____ Description: _____	
	P. O. Box 1516, Cedarville, Texas 75009 Tel: (214) 342-9999	Project No.: _____ Drawing No.: _____	

Owner: _____
 Architect: _____
 Designer: _____
 Planner: _____
 Date: _____
 Scale: _____

ASB-1

This document is 2005 by Lee H. Smith Architect. Reproduction in whole or in part is prohibited without prior written authorization from Lee H. Smith Architect.

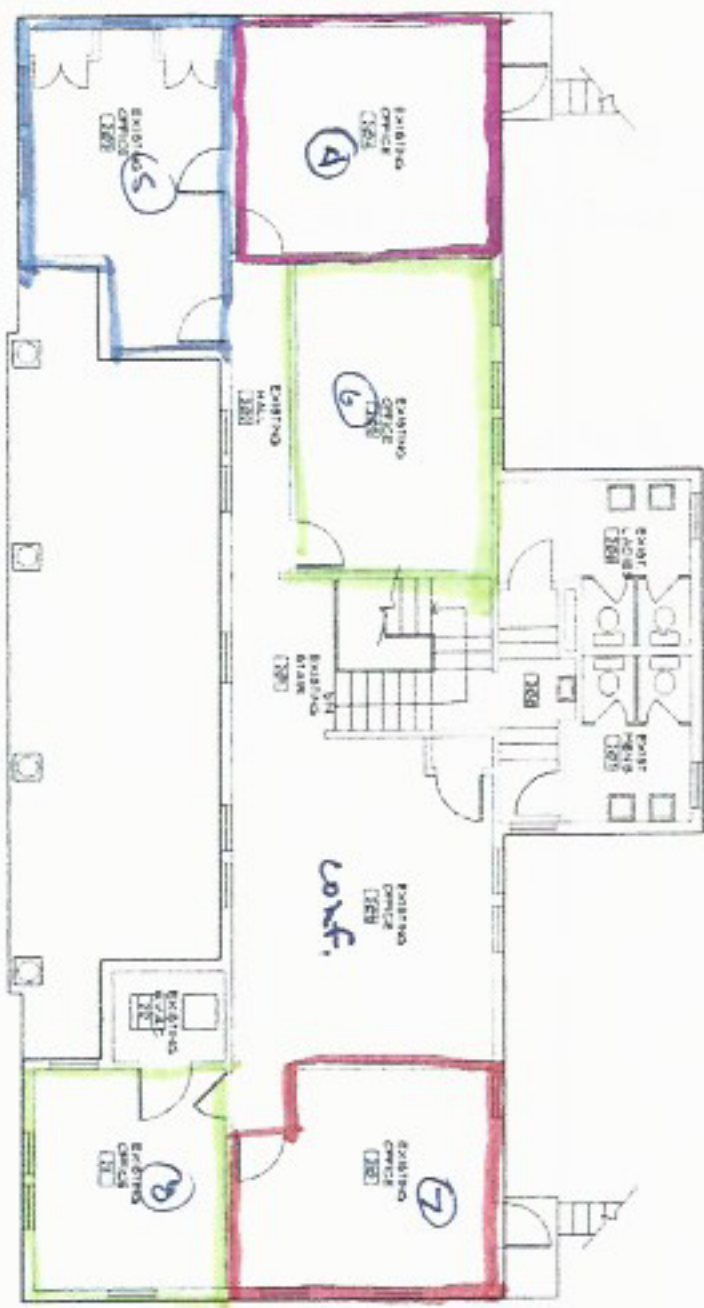

Notes:
1. ALL EXISTING WALLS TO REMAIN AS SHOWN.
2. ALL NEW WALLS TO BE CONSTRUCTION.

AS-BUILT
1 SECOND FLOOR PLAN



No.	Revisions	Date

3107 Broadway
SAN ANTONIO, TEXAS

L E E S M T P A R L O R S
P. O. Box 1516, Castroville, Texas 78009 Tel. (214) 342-6064



Owner	Project No.
LHS	2000-01
Contracted	Date
LHS	4.1.2000
Scale	

ASB-2
Sheet No. 01