


A = AIR
 CB = CLOSET
 C = CLOSET
 F = FLOOR
 H = HALL
 H/W = HALLWAY
 K = KITCHEN
 L = LIVING
 M = MASTER
 P = PORCH
 R = RESTROOM
 S = STAIRS
 T = TERRACE
 W = WALL
 Y = YARD

CONSTRUCTION
 FOUNDATION - STONE & CONCRETE
 STRUCTURE - WOOD FRAME
 ROOF - SHINGLES
 FLOOR - WOOD & CARPET
 WALLS - BRICK

FINISHES
 FLOOR - CARPET
 FLOOR - WOOD
 FLOOR - WOOD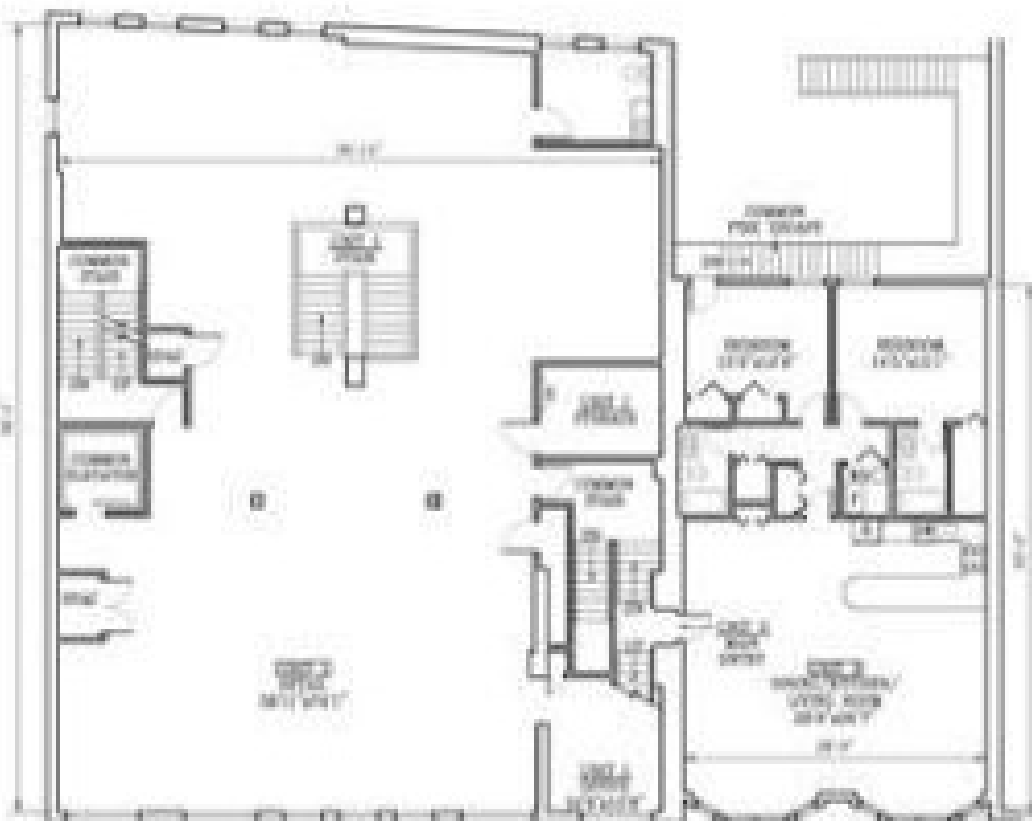
Second Floor

Approved for Signature Only

74-80 BOYLSTON STREET CONDOMINIUM

Location: Massachusetts/USA

First Floor - As Built

As constructed, Master Deck

UNIT 1	7147	Square Feet
UNIT 2	1423	Square Feet
UNIT 3	1423	Square Feet
UNIT 4	1423	Square Feet
UNIT 5	1241	Square Feet
UNIT 6	1423	Square Feet
UNIT 7	1423	Square Feet

* Measurements are in feet and inches.
 * Measurements are subject to change without notice.
 * Building is of mixed frame construction.

CERTIFICATION

I hereby certify that this plan was prepared
 in accordance with the rules and regulations
 of the Massachusetts Department of State.

I hereby certify that this plan fully and
 accurately depicts the layout, dimensions
 and location of the building, and other
 important information, as built, as of
 February 4, 2004 of the property at 74-80
 Boylston Street, Boston, Massachusetts.

I hereby certify that this plan fully and
 accurately depicts the layout, dimensions
 and location of the building, and other
 important information, as built, as of
 February 4, 2004.

Architect Name: [Redacted]
 Registered Architect: [Redacted] No. 1234