




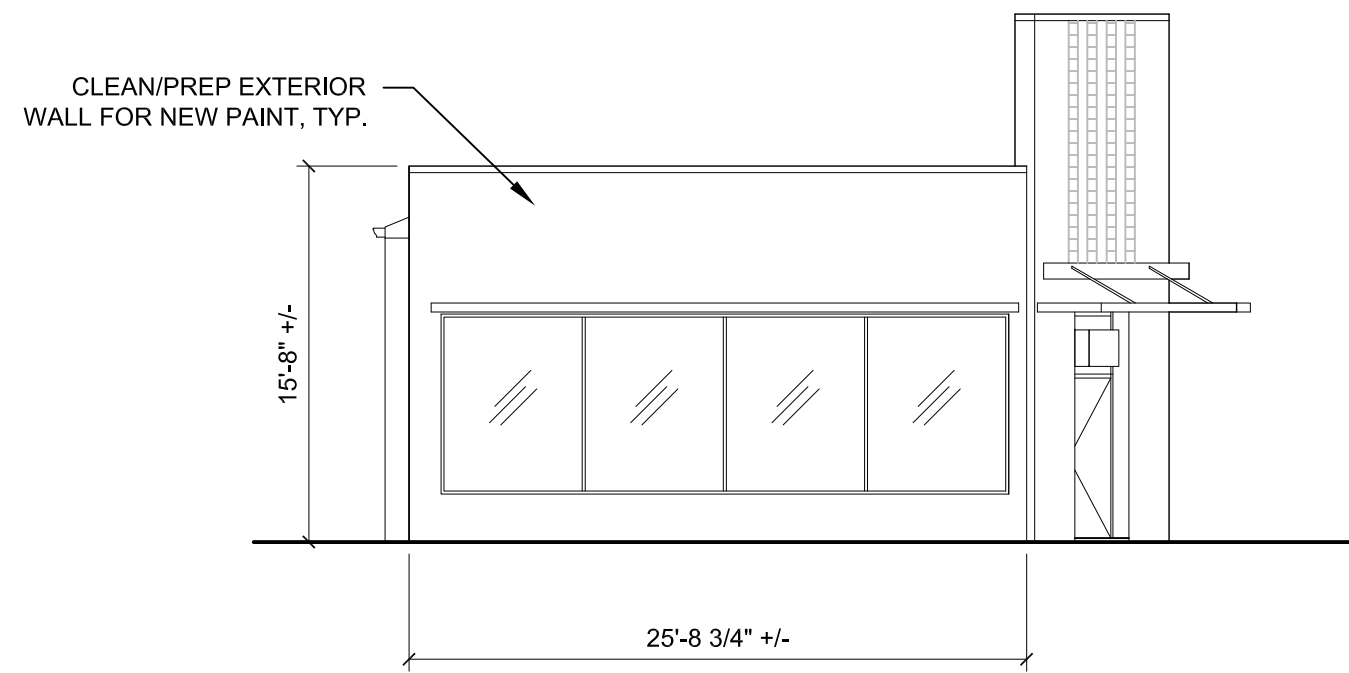


1 DEMOLITION ELEVATION - SOUTH (FRONT)
A3.0 SCALE: 1/8" = 1'-0"

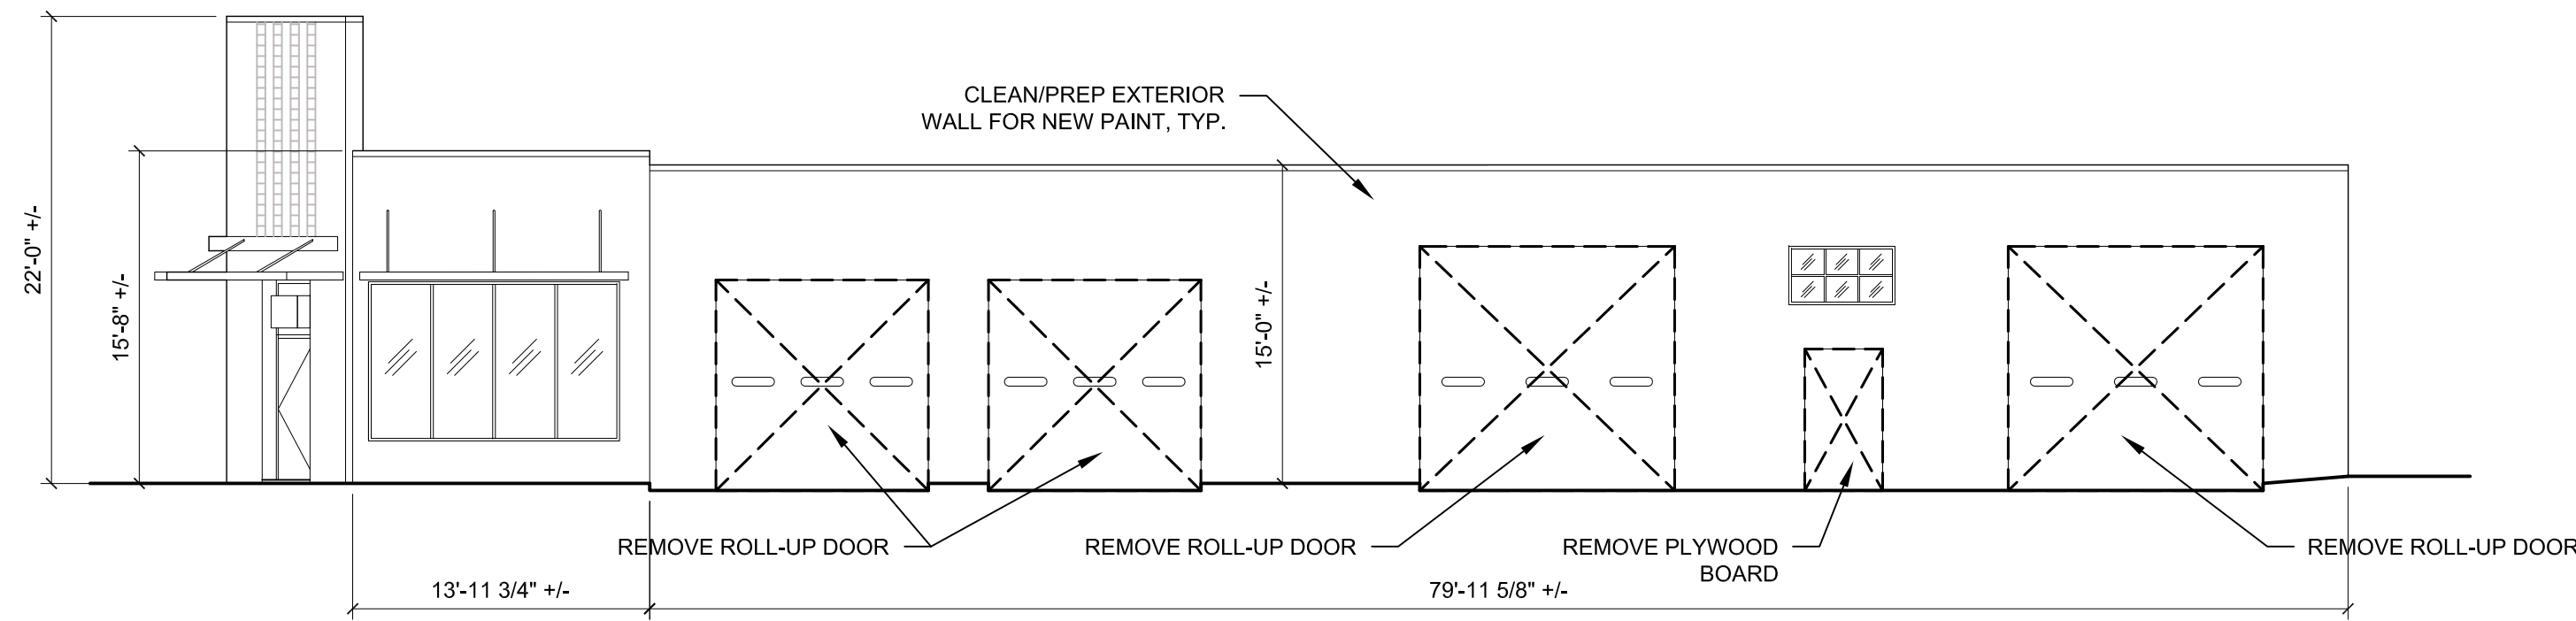

2 DEMOLITION ELEVATION - EAST
A3.0 SCALE: 1/8" = 1'-0"

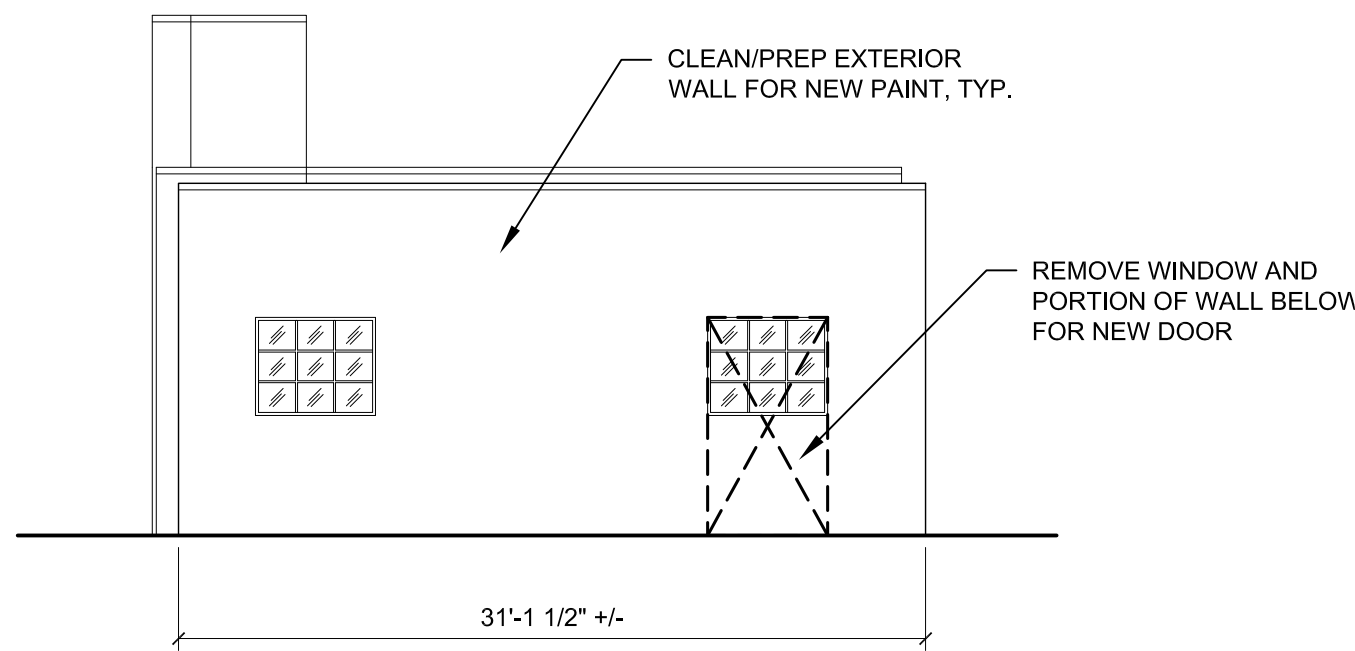

3 DEMOLITION ELEVATION - NORTH (REAR)
A3.0 SCALE: 1/8" = 1'-0"

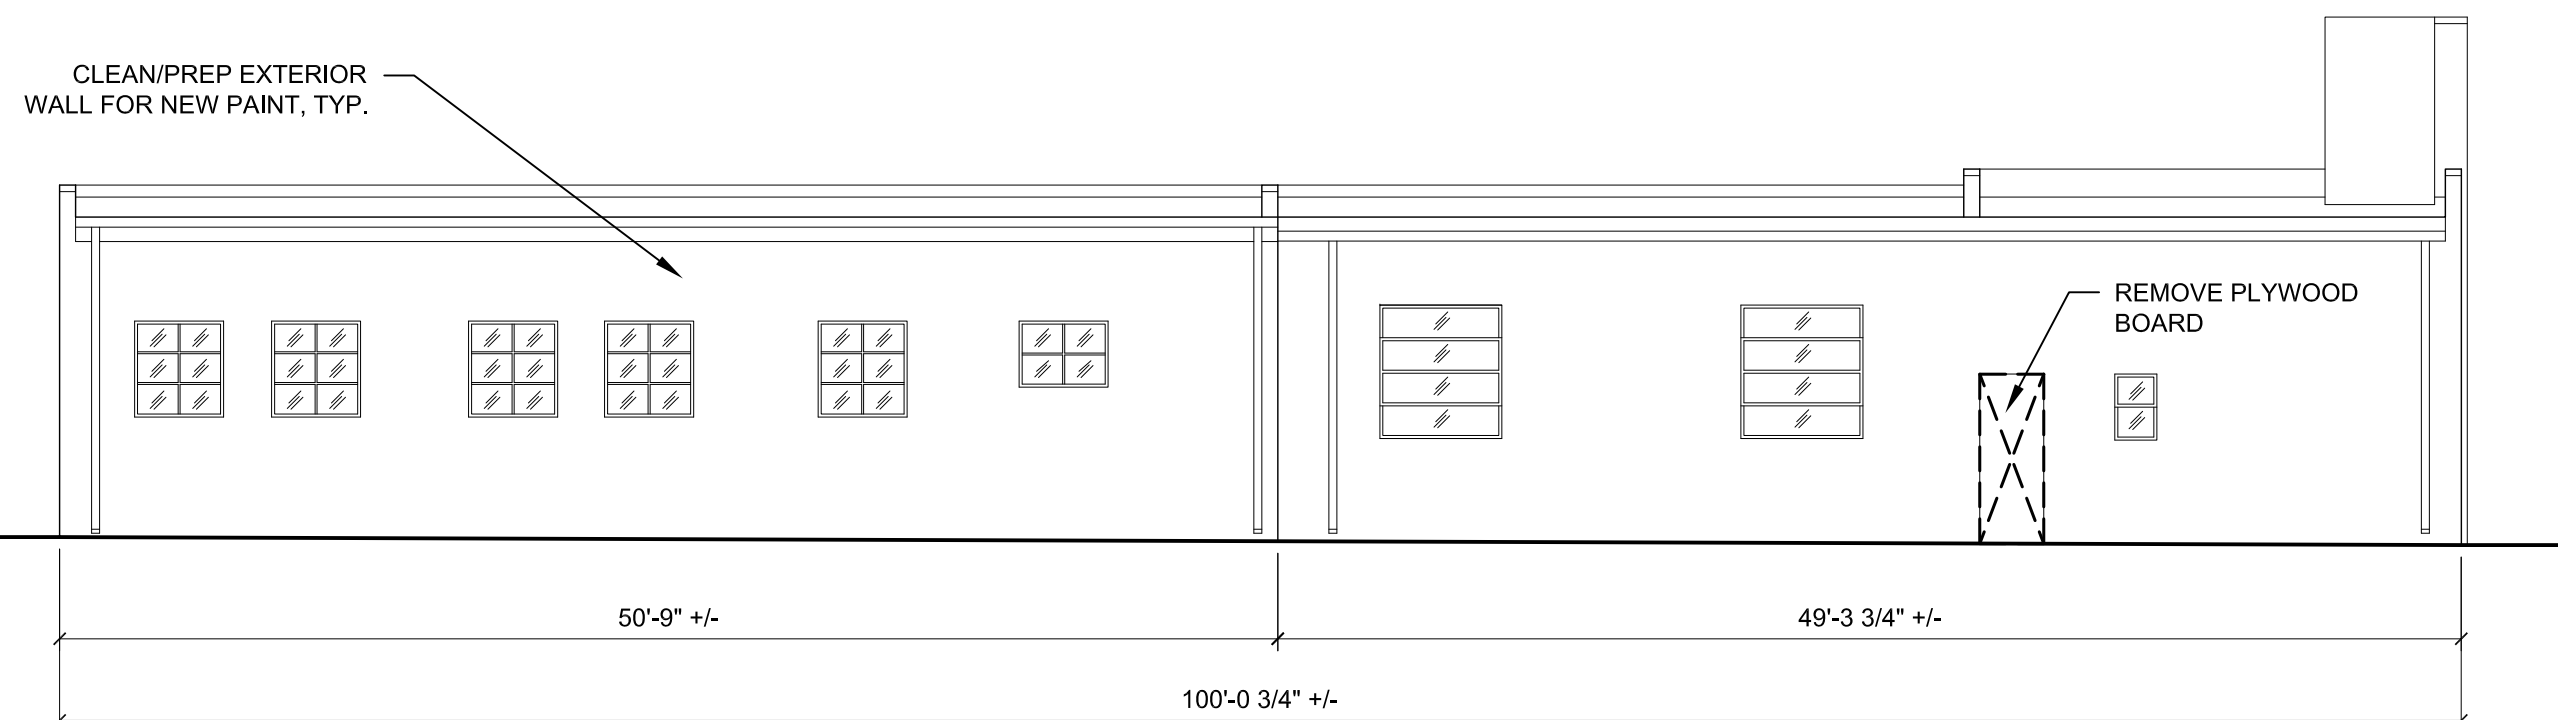

4 DEMOLITION ELEVATION - WEST
A3.0 SCALE: 1/8" = 1'-0"

ALL Architecture, LLC
2052 CHRYSLER DRIVE NE, ATLANTA, GA 30345
TELEPHONE: (404) 316-2896
E-MAIL: ARCHILA@GMAIL.COM


REVISIONS		DATE
NO.		

COPYRIGHT
THIS DRAWING AND ALL
REPRODUCTIONS ARE
COPYRIGHTED AND THE PROPERTY
OF ALL ARCHITECTURE, LLC AND
ALL RIGHTS ARE RESERVED. NO
PART MAY BE REPRODUCED OR
TRANSMITTED IN ANY FORM
WITHOUT THEIR PERMISSION.

PROJECT TITLE:

350 MEMORIAL DRIVE
REDEVELOPMENT
350 MEMORIAL DR SE
ATLANTA, GEORGIA 30312

SEAL:

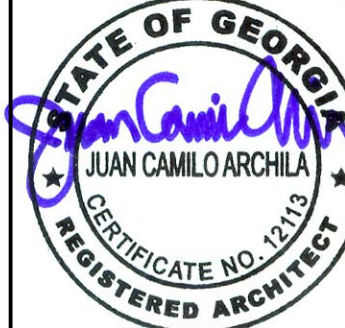

DRAWN: JCA	CHECKED: JCA
APPROVED: JCA	ISSUE DATE: 04/25/16

CAD FILE NAME:
201610.dwg

SHEET TITLE:
AS-BUILT /
DEMOLITION
ELEVATIONS

PROJECT NUMBER:
201610

SHEET NO:

A3.0

SHEET 2 OF 3