


Grand Oak Center

977 Oaklawn Ave.
Emhurst, Illinois 60126

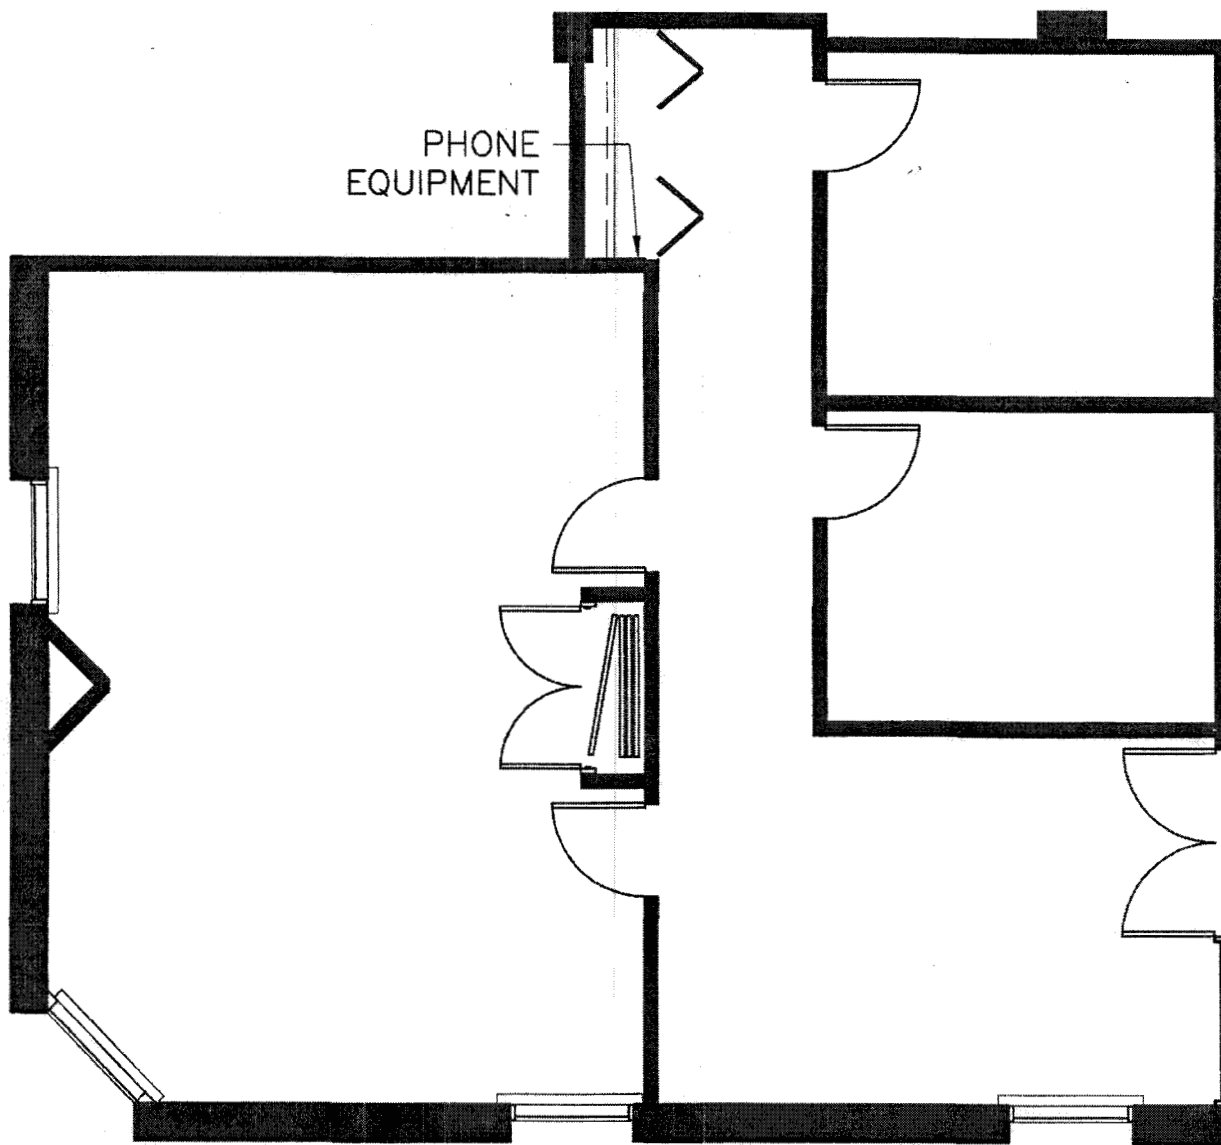

Suite #100 - "Wall/Door As-Built" Conditions

1,461 Rentable Square Feet

Scale: N.T.S.

**A. MOUREK
MANAGEMENT INC.**

October 28, 2004 (Field Verified)

