


Corporate

Interior

Design

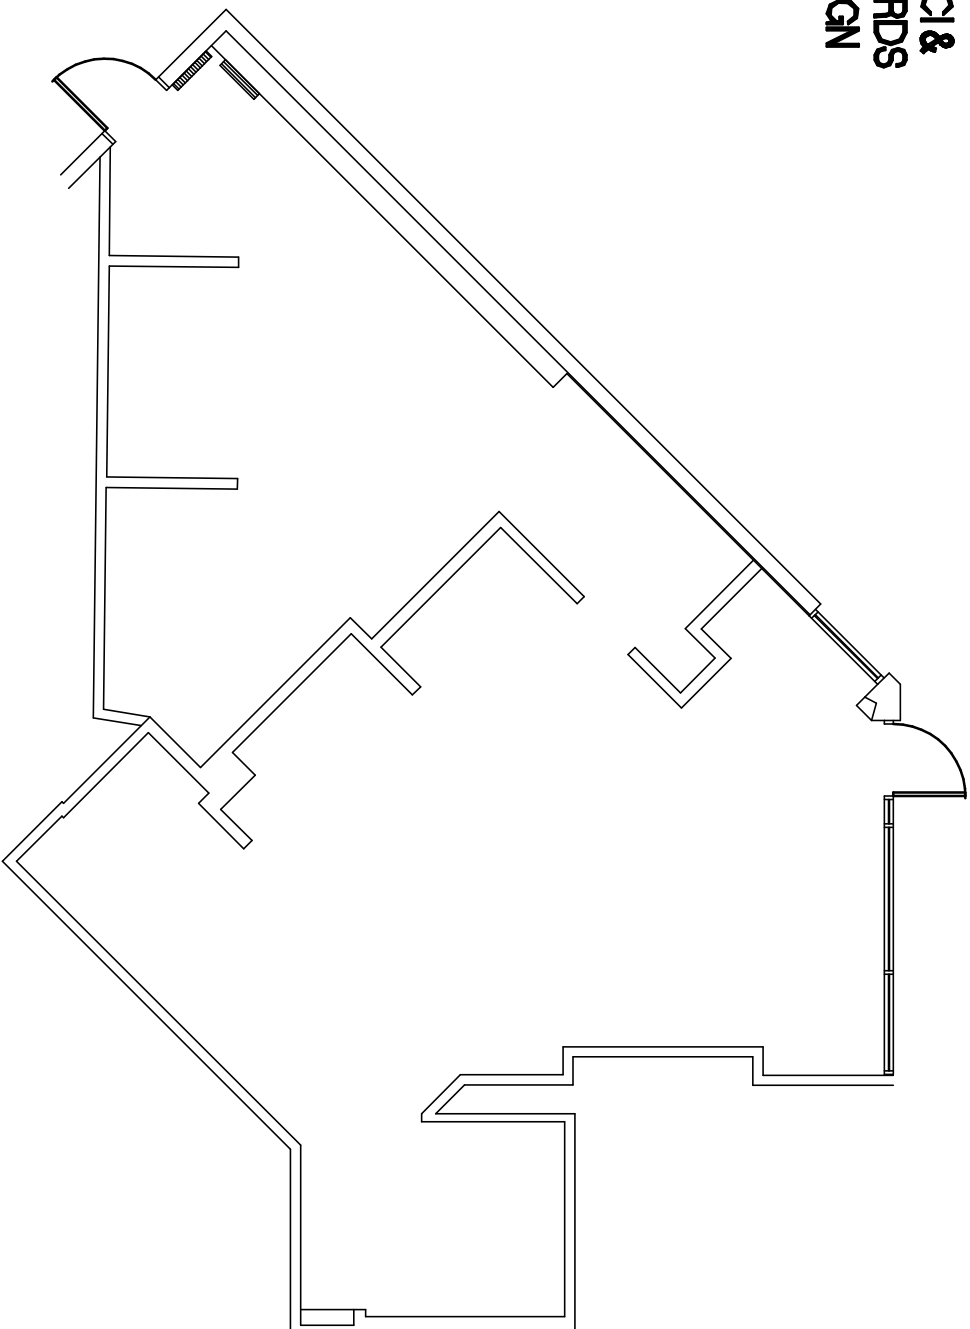

200 Tenth Avenue South
Suite 200
Nashville, Tennessee
37203-4104
PH: (615) 728-1441
FAX: (615) 728-1000

LAKEFRONT OFFICE PARK		FLOOR: 1ST FLOOR	DATE: 10/24/2007
METROCENTER BLVD.		SUITE: 221	
NASHVILLE, TN		AS-BUILT	JOB #: 10264-000
		SCALE: 1/8" = 1'-0"	