

SOUTHLAKE PARCELS D & E


St Johns County, Florida

FOR

LANDMARK HOMES, INC.

ST. JOHN'S COUNTY
DENOTES APPLICABLE COUNTY REQUIREMENTS AND APPLICABLE REGULATIONS.
• DOES NOT CONSTITUTE AN ENDORSEMENT OR NON-COMFORMING FEATURES UNLESS SPECIFICALLY NOTED ON ORIGINAL ALLOWED BY THE BOARD OF COUNTY COMMISSIONERS.
• DOES NOT CONSTITUTE AN ENDORSEMENT OF ALL PERFORMANCE, ASPECTS, QUALITY, OR DURABILITY OF THE CONSTRUCTION.
• DOES NOT CONSTITUTE AN ENGINEERING CERTIFICATION BY THIS ENGINEER OR ANY OTHER PERSON RESPONSIBLE FOR THE SURVEY OF THE CONSTRUCTION.
• GOVERNMENT OF CORRECT CONSTRUCTION IS THE RESPONSIBILITY OF THE OWNER/BUILDER BASED ON A PROPER SURVEY OF THE CONSTRUCTION.

LEGEND	
—12"W—	EXISTING WATER MAIN
—8" SAN —	EXISTING SANITARY SEWER
—12" FM —	EXISTING FORCE MAIN
—	WATER MAIN
—	SANITARY SEWER SYSTEM
—	FORCE MAIN
—	DRAINAGE PIPE
—	DRAINAGE DIVIDE LINE
—	RIGHT-OF-WAY LINE
x	SILT FENCE
10	EXISTING CONTOUR
—	PROPOSED ROADWAY
—	EXISTING ROADWAY
20	SEWER MANHOLE LABEL
+	PROPOSED FIRE HYDRANT
+	EXISTING FIRE HYDRANT
x	GATE VALVE
△	REDUCER
◇	DRAINAGE AREA LABEL
□	HAY BALES
■	CATCH BASIN/CURB INLET
⊙	DRAINAGE MANHOLE
▭	MITERED END SECTION
P-1	DRAINAGE PIPE LABEL
S-1	DRAINAGE STRUCTURE LABEL

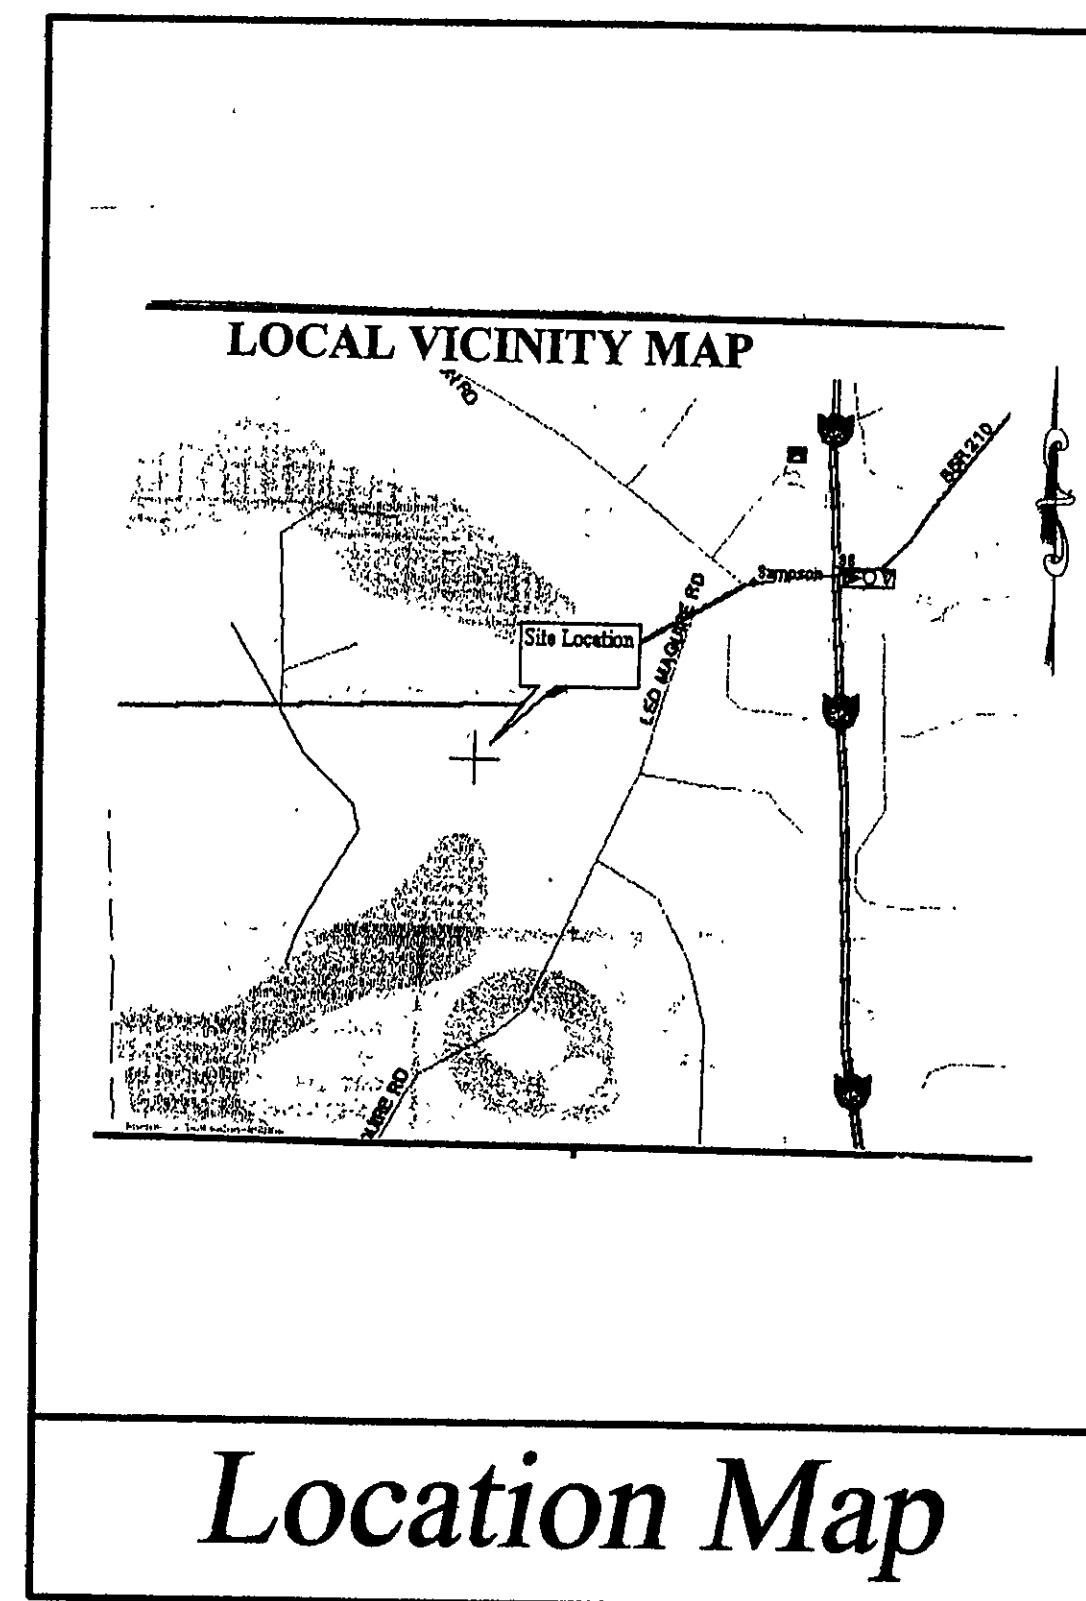

LIST OF SHEETS

- 1/9 Cover Sheet
- 2/9 Geometry Plan
- 3/9 Paving and Drainage Plan
- 4/9 Water and Sewer Plan
- 5/9 Roadway and Utility Profiles
- 6/9 Paving and Drainage Detail Sheet
- 7/9 Water and Sewer Details Sheet
- 8/9 Water and Sewer Details Sheet
- 9/9 Stormwater Pollution Prevention Plan

REVIEWED FOR CONSTRUCTION

St. Johns County Development Review
Paving and Drainage Plans
Site Plan
MODCP
Date: 3/15/04 By: XH

Prepared By:

J. Lucas & Associates, Inc.

DESIGN AND CONSULTING ENGINEERS
CERTIFICATE OF AUTHORIZATION NO. 3981

JLA

1305 CEDAR STREET - JACKSONVILLE, FL 32207

PHONE: (904) 396-3060 - FAX: (904) 396-3456

E-MAIL: lucascad@bellsouth.net

AUGUST 2003



PROJECT NUMBER: 0314





COUNTY ROAD NO. 210

(FORMERLY STATE ROAD NO. 5-210)

(a 100' Public Road Right of Way, as per State of Florida, State Road Dept. R/W Map, Section No. 7851-250, dated 2/14/51)

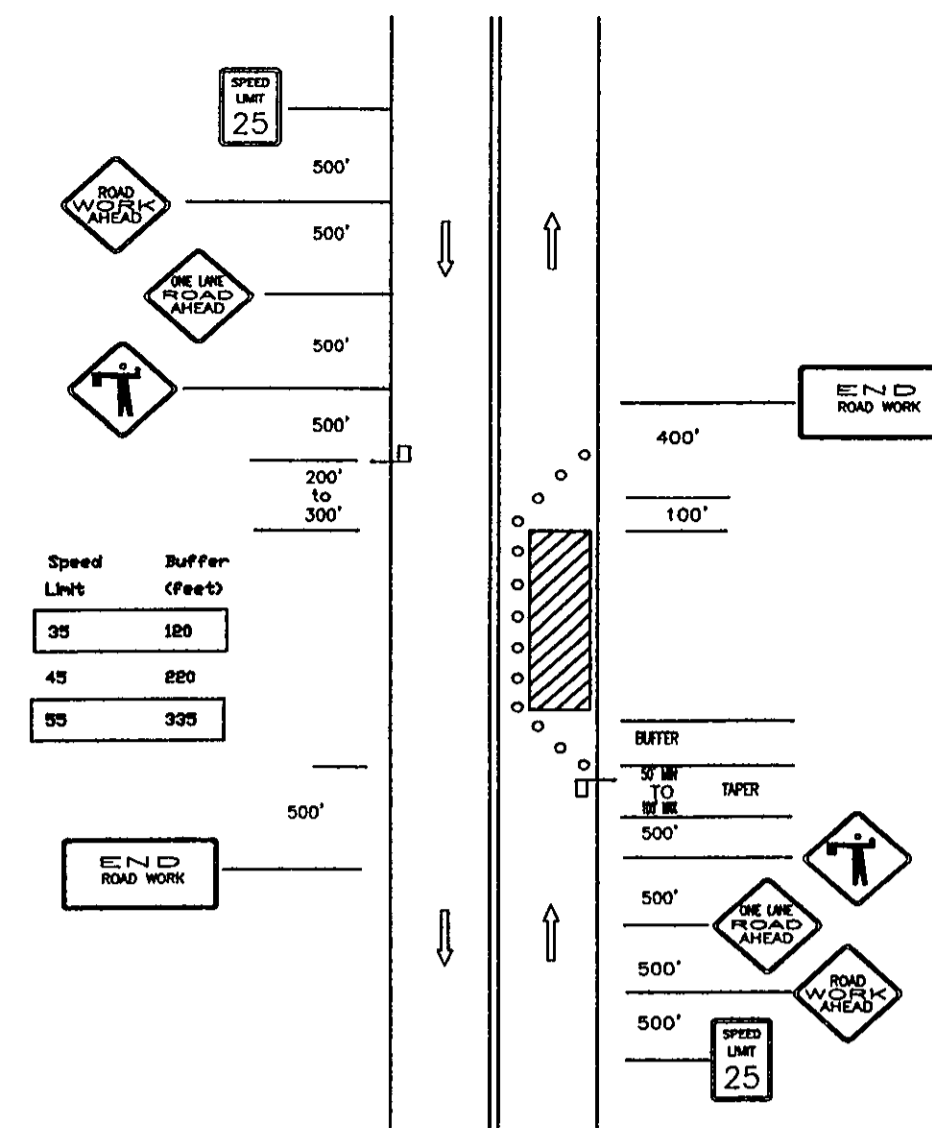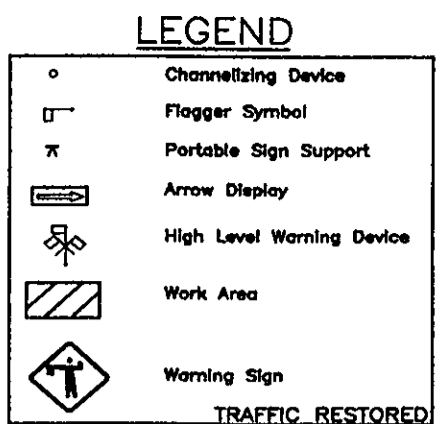


SOUTHLAKE UNIT ONE

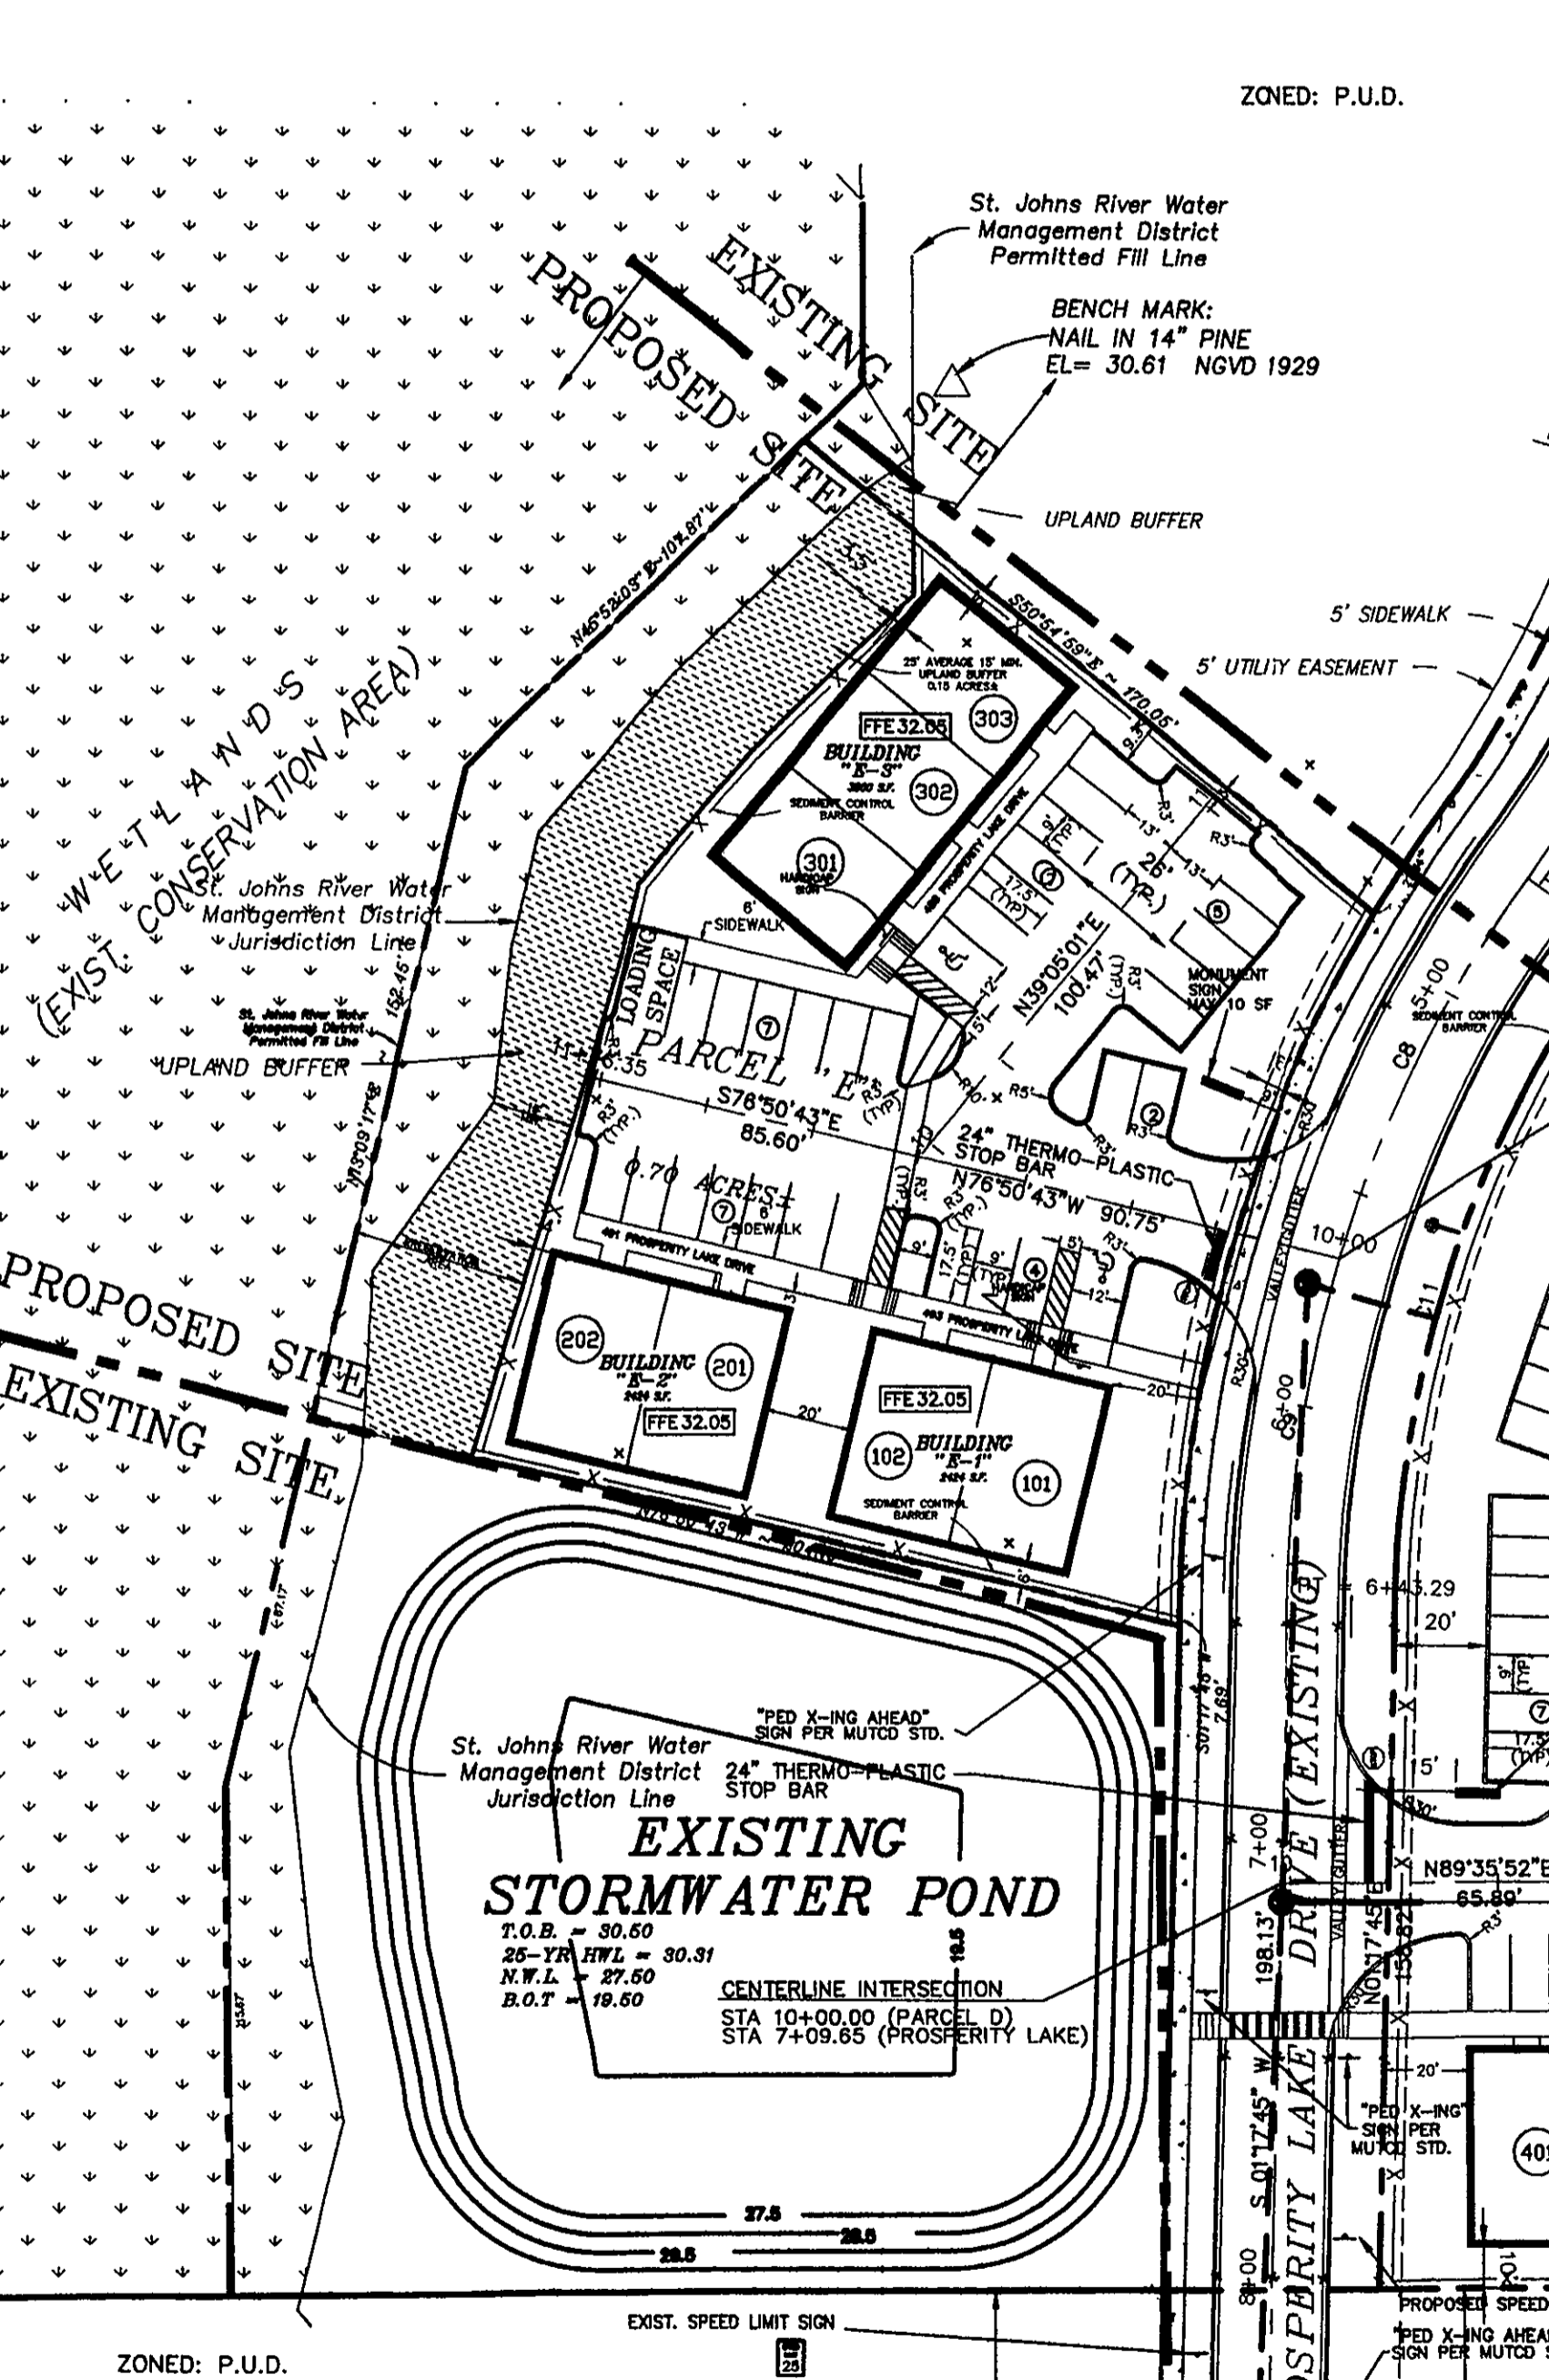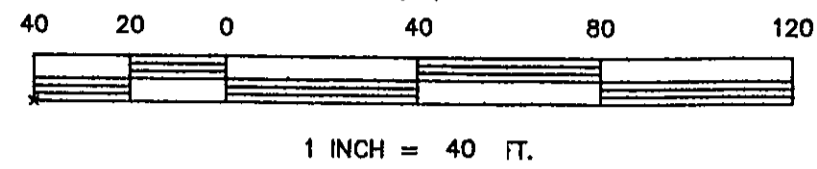

CURVE TABLE

CURVE	LENGTH	RADIUS	TANGENT	BEARING	CHORD	DELTA
C1	36.13	23.00	23.00	S44°35'52"W	32.53	90°00'00"
C2	17.67	23.00	9.29	N68°23'56"W	17.23	44°00'25"
C3	35.01	162.00	17.57	N05°47'21"E	34.94	12°22'59"
C4	56.94	100.00	29.26	N28°17'33"E	56.17	32°37'25"
C5	78.44	100.00	41.36	N67°04'33"E	76.45	44°56'36"
C6	93.84	300.00	47.20	N08°32'22"E	93.26	17°53'00"
C7	97.98	300.00	49.23	N26°47'58"E	97.15	18°38'13"
C8	97.79	288.83	49.37	S28°23'07"W	97.32	19°23'56"
C9	77.75	288.83	39.11	S09°00'27"W	77.52	15°25'24"


LEGEND

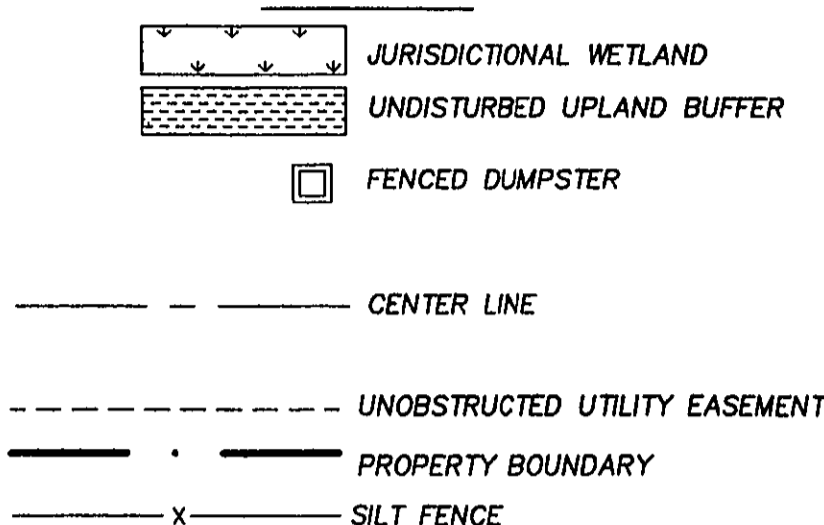

DATA SUMMARY

PIN: 026440-0030	35'	SOUTHLAKE PARCELS 3"D" & "E"
MAX. STRUCTURE HT:	1	MEDICAL/DENTAL OFFICE USE
# OF STORIES:	1	R-PUD 97-006; ORDINANCE 97-20
TOTAL SITE:	3.98 AC.	28 UNITS IN 9 BLDGS
TOT. DRAIN.BASIN AREA:	2.95 AC.	28 DOCTORS, 56 EMPLOYEES
IMPERV. AREA:	2.14 AC. (54%)	& 56 EXAM ROOMS
DCIA:	54%	1 SPACE/DOCTOR = 28 SPACES
TOT. BLDG AREA:	33648 S.F.(19%)	0.5 SPACE/EMPLOYEE = 28
TOT. BLDG COVERAGE:	6,676 S.F./ACRE	1.5 SPACES/EXAM ROOM = 84
TOT. PVIOUS AREA:	1.84 AC.	140 SPACES REQUIRED
WEIGHTED CN:	93	150 SPACES PROVIDED
		SOIL TYPE: 12 (Ona Fine Sand) ENTIRE SITE

EXIST. PARCEL "C"

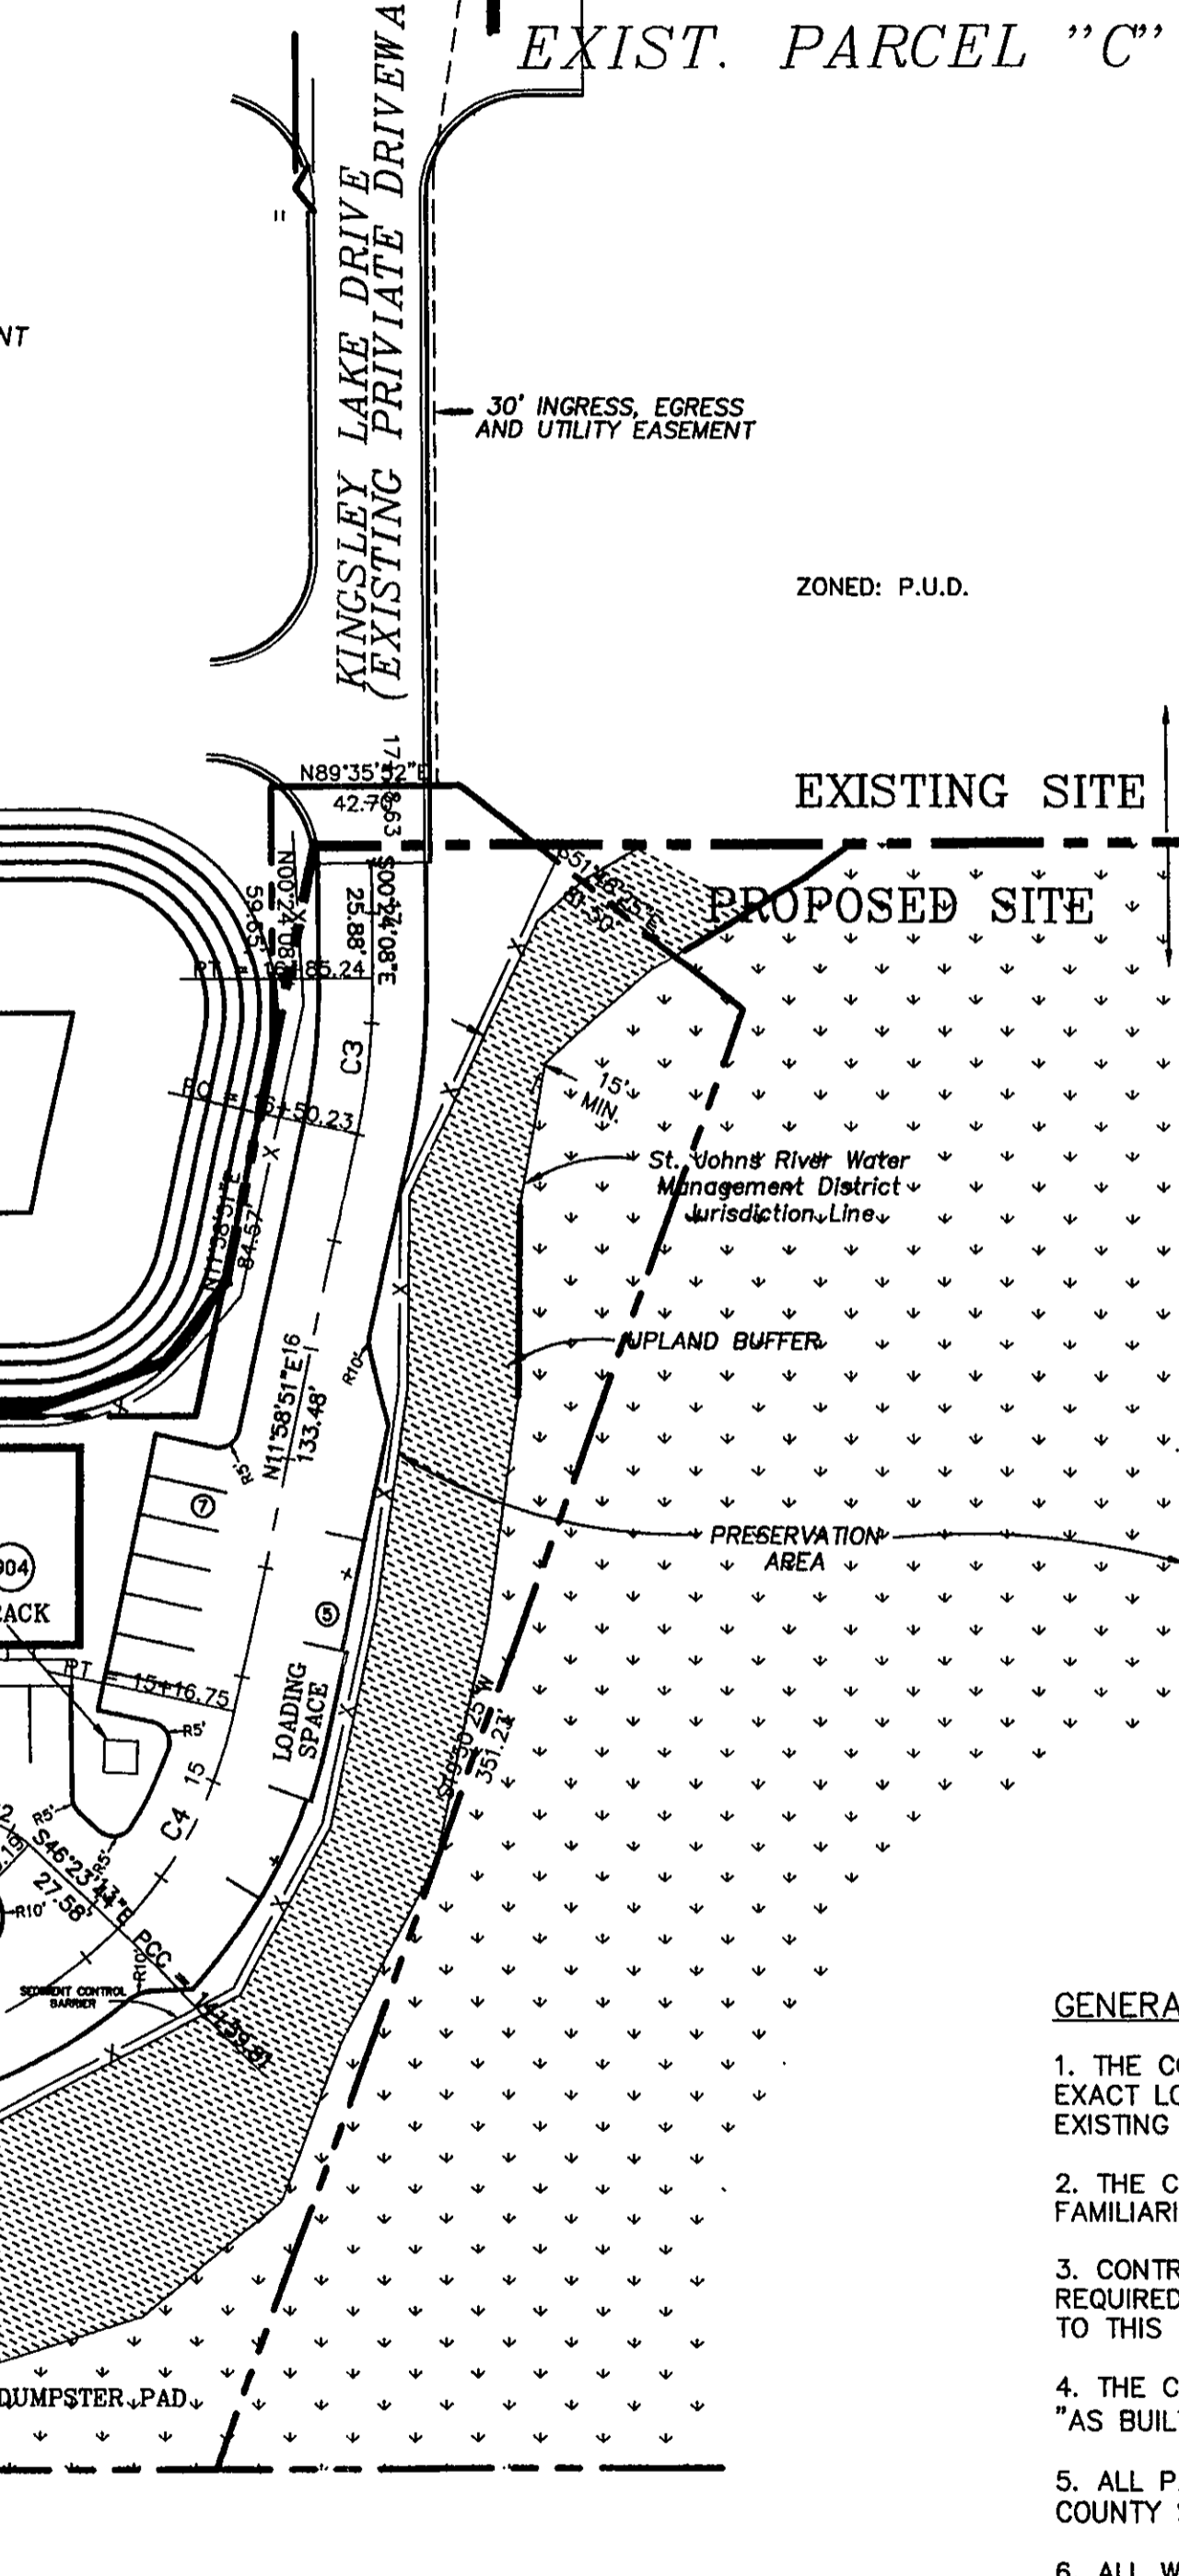

GENERAL NOTES

1. THE CONTRACTOR SHALL BE RESPONSIBLE FOR DETERMINING THE EXACT LOCATION OF ALL EXISTING UTILITIES AND FOR DAMAGE TO EXISTING UTILITIES CAUSED BY HIS OPERATION.
2. THE CONTRACTOR SHALL VISIT THE JOB SITE PRIOR TO BIDDING TO FAMILIARIZE HIMSELF WITH JOB SITE CONDITIONS.
3. CONTRACTOR SHALL ARRANGE FOR AND PAY FOR ALL TESTING AS REQUIRED IN THE ST JOHNS COUNTY UTILITY DEPT. SPECIFICATIONS PERTAINING TO THIS JOB.
4. THE CONTRACTOR SHALL FILE WITH THE COUNTY A SET OF REPRODUCIBLE MYLAR "AS BUILT" DWGS. FOR REVIEW AND APPROVAL.
5. ALL PAVING AND DRAINAGE WORK SHALL BE AS PER ST JOHNS COUNTY STANDARDS / SPEC. UNLESS SHOWN OTHERWISE.
6. ALL WATER AND SEWER WORK SHALL BE AS PER ST JOHNS COUNTY UTILITY DEPT. STANDARDS / SPEC. UNLESS SHOWN OTHERWISE.
7. CONTRACTOR SHALL CONTACT THE COUNTY 24 HOURS IN ADVANCE PRIOR TO WORKING ON THE THEIR SYSTEM.
8. ALL INTERSECTION RADI ARE 30 FEET AND ALL CUL-DE-SAC RETURNS ARE 25 FEET AS REQUIRED BY THE COUNTY AS MEASURED FROM THE RADIUS POINT TO THE EDGE OF PAVEMENT.
9. TOPOGRAPHIC INFORMATION SHOWN PROVIDED BY THE OWNER.
10. ALL PAVEMENT WIDTHS ARE 24 FEET FROM EDGE OF ASPHALT TO EDGE OF ASPHALT OR AS SHOWN ON THE PLANS.

J. LUCAS & ASSOCIATES, INC.
 CONSULTING AND DESIGN ENGINEERS
 CERTIFICATE OF AUTHORIZATION NO. 3981
 1305 CEDAR STREET - JACKSONVILLE, FL 32207
 PH (904) 396-3060 FAX (904) 396-3456

VERSION: ACAD14
 DRAWN BY: DAD
 DESIGNED BY: JKL
 APPROVED BY: JML
 DATE: 19 JUN 03

NO.	REVISION	BY	DATE
3	REVISED PER ST. JOHNS COUNTY COMMENTS	BP	12/19/03
2	REVISED PER ST. JOHNS COUNTY COMMENTS	BP	10/28/03
1	REVISED PER ST. JOHNS COUNTY COMMENTS	BP	10/24/03

GEOMETRY PLAN OF
 SOUTHLAKE PARCELS D & E
 FOR
 LANDMARK HOMES, INC

DRAWING NO. 0314
 JOB NO. 0314
 FILE: 0314

SEAL & SIGNATURE:

SOUTHLAKE UNIT TWO

THIS DRAWING IS THE PROPERTY OF ROBERT ALLEN CONNER ARCHITECTS, INC. AND IS TO BE USED ONLY FOR THE PROJECT AND SITE SPECIFICALLY IDENTIFIED HEREON. IT IS NOT TO BE REPRODUCED, COPIED, REPRODUCED, OR TRANSMITTED IN ANY FORM OR BY ANY MEANS, ELECTRONIC OR MECHANICAL, INCLUDING PHOTOCOPYING, RECORDING, OR BY ANY INFORMATION STORAGE AND RETRIEVAL SYSTEM, WITHOUT THE WRITTEN PERMISSION OF ROBERT ALLEN CONNER ARCHITECTS, INC. ANY VIOLATION OF THESE CONDITIONS SHALL BE CONSIDERED A BREACH OF CONTRACT AND SHALL BE SUBJECT TO LEGAL ACTION.

FRONT ELEVATION - COVER SHEET
OFFICES AT EASTPARK - BUILDING 800
 JACKSONVILLE, FLORIDA

11940
 NCARB
 FLORIDA
 ARCHITECTS
ROBERT ALLEN CONNER
 NCARB - ARCHITECTS
 11644 SAILBOAT ROAD
 JACKSONVILLE, FLORIDA 32223
 904 - 266 - 7822

Fire Marshal Review & Approval
 Page Signed Off
J. Kelly

DATE 4-4-04
 DRAWN R A C
 REVISED 1-12-04

SHEET
1
 OF 7

SOUTHLAKE OFFICE CENTER

JACKSONVILLE, FLORIDA

BUILDING 800



SUITE 803 SUITE 802 SUITE 801

FRONT ELEVATION - BUILDING 800

REVIEWED FOR CODE COMPLIANCE
 Review of these plans, and any Permits issued, under
 the Applicant's "Clearance Guarantee" information are
 VOID if or when erroneous information from the
 Applicant is discovered. The Issuance of a permit
 conveys no right to violate any governing Codes,
 Zoning or Engineering regulations.
 BY *J. Kelly*
 St. Johns Co. Building Dept.


CODE SUMMARY

APPLICABLE CODES
 2001 FLORIDA BUILDING CODE
 2000 LIFE SAFETY CODE
 2001 PLUMBING CODE
PROGRAMMED USE
 OFFICE BUILDING
OCCUPANCY CLASSIFICATION
 2001 BLDG. CODE - OFFICE OCCUPANCY - GROUP B
BUILDING AREA
 3378 SQUARE FEET
CONSTRUCTION CLASSIFICATION
 TYPE VI - UNPROTECTED, UNSPRINKLED
OCCUPANCY LOAD
 11 PER UNIT (BASED ON 1126 SF)
FIRE ALARM SYSTEM
 AS PER CODE
FIRE RESISTANCE REQUIREMENTS
 (SBC TABLE 608)
 INTERIOR BEARING WALL 0 HRS.
 INTERIOR NON-BEARING WALL 0 HRS.
 BEAMS, TRUSSES 0 HRS.
 ROOF/CEILING 0 HRS.
 DEMISING WALLS 1 HR.
 6" DOUBLE UNITS - 45' SINGLE UNITS
 AS PER CODE
MAX. TRAVEL DIST. TO AN EXIT
 EXIT DOORS

2001 FLORIDA BUILDING CODE
 2000 LIFE SAFETY CODE
 2001 PLUMBING CODE
 OFFICE BUILDING
 2001 BLDG. CODE - OFFICE OCCUPANCY - GROUP B
 3378 SQUARE FEET
 TYPE VI - UNPROTECTED, UNSPRINKLED
 11 PER UNIT (BASED ON 1126 SF)
 AS PER CODE
 INTERIOR BEARING WALL 0 HRS.
 INTERIOR NON-BEARING WALL 0 HRS.
 BEAMS, TRUSSES 0 HRS.
 ROOF/CEILING 0 HRS.
 DEMISING WALLS 1 HR.
 6" DOUBLE UNITS - 45' SINGLE UNITS
 AS PER CODE

GENERAL NOTES

- SEE DRAWINGS BY THE STRUCTURAL ENGINEER FOR ADDITIONAL INFORMATION RELATING TO ALL STRUCTURAL DETAILS, FOUNDATION PLAN, SHEARWALL ENGINEERING, WALL SECTIONS, ETC.
- ALL ELECTRICAL IS SHOWN FOR INFORMATION ONLY AND SHALL BE REVIEWED WITH THE ELECTRICAL CONTRACTOR PRIOR TO INSTALLATION.
- ALL MECHANICAL IS SHOWN FOR INFORMATION ONLY AND SHALL BE REVIEWED WITH THE MECHANICAL CONTRACTOR PRIOR TO INSTALLATION.
- SEE ADDITIONAL INFORMATION SUPPLIED ALONG WITH THE ORIGINAL CONTRACT AGREEMENTS PREPARED BY THE PROJECT OWNER.
- ALL DIMENSIONS SHOWN ON THE PLAN ARE BASED ON THE FOLLOWING:

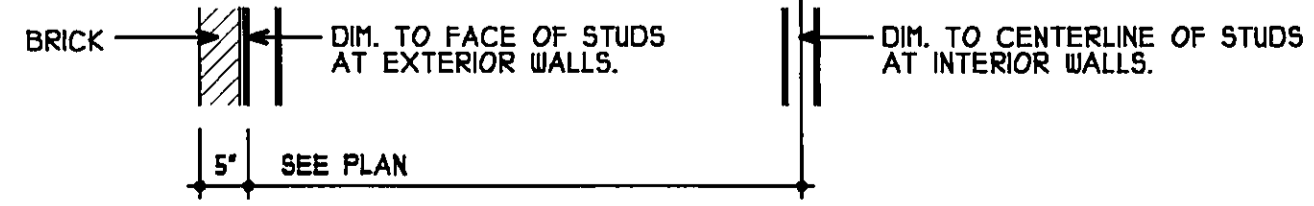

AREA CALCULATIONS

UNIT	SQ. FT.
801	1126
802 - 803	2252
TOTAL BUILDING	3378


ALL AREAS ARE CALCULATED FROM THE
 OUTSIDE FACE OF THE EXTERIOR FRAME WALL
 TO THE CENTERLINE OF AN INTERIOR WALL.
 BRICK VENEER EXTERIOR FINISH IS NOT
 INCLUDED IN THE ABOVE AREA CALCULATIONS.

INDEX TO DRAWINGS



- FRONT ELEVATION - COVER SHEET
- FLOOR PLAN - DETAILS
- ATTIC FLOOR PLAN
- FRONT, SIDE AND REAR ELEVATIONS
- MISC. DETAILS - WALL SECTIONS
- MECHANICAL PLAN
- ELECTRICAL PLAN
- SEE DRAWINGS BY STRUCTURAL ENGINEER

NOTE: UNITS SHOWN ARE TYPICAL AND MAY BE MODIFIED AS PER TENANTS REQUIREMENTS FOR USE.

NOTE: THESE TYPICAL ROUGH OPENING DIMENSIONS ARE SHOWN FOR INFORMATION ONLY. IT IS THE CONTRACTOR'S RESPONSIBILITY TO CHECK AND VERIFY THESE SIZES WITH THE WINDOWS AND DOORS THAT ARE PURCHASED AS DIFFERENT MANUFACTURERS CAN AND DO HAVE DIFFERENT REQUIREMENTS.

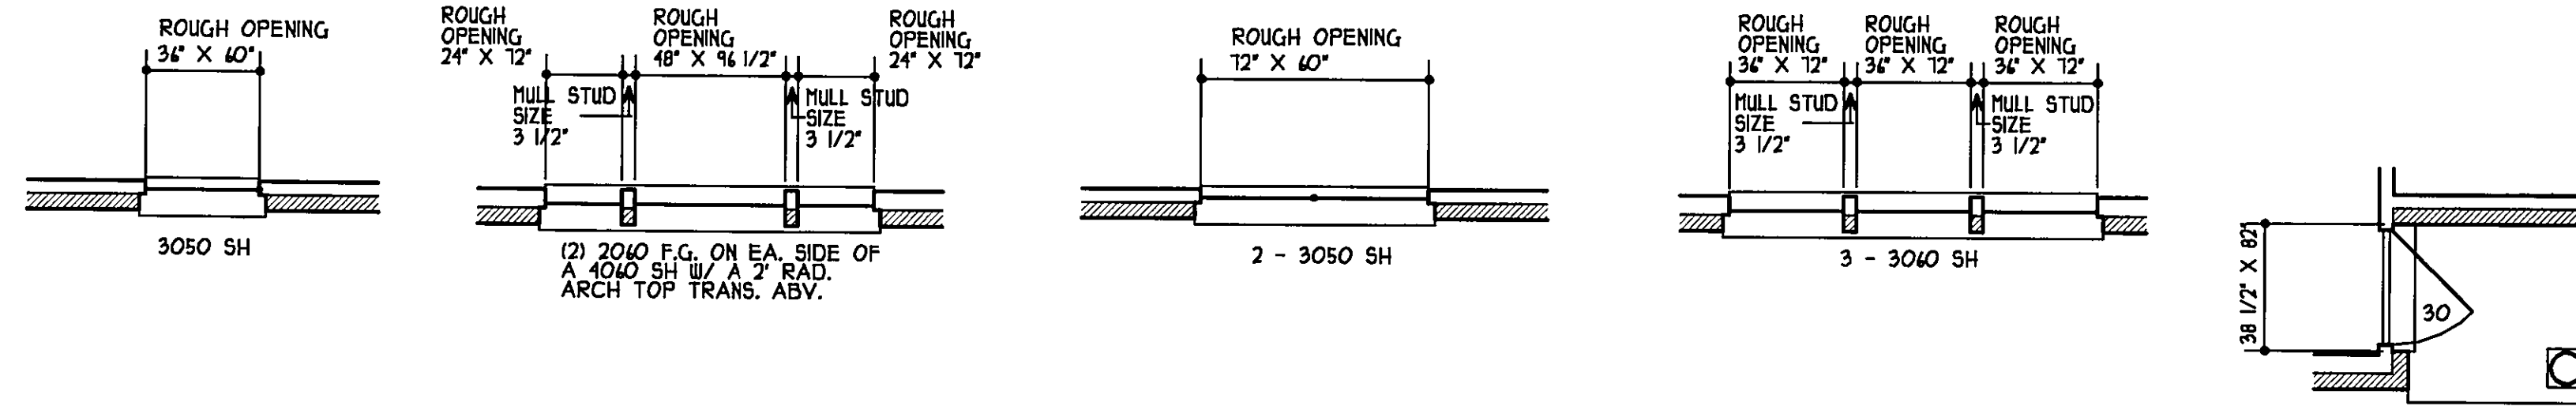

TYPICAL ROUGH OPENING DIMENSIONS

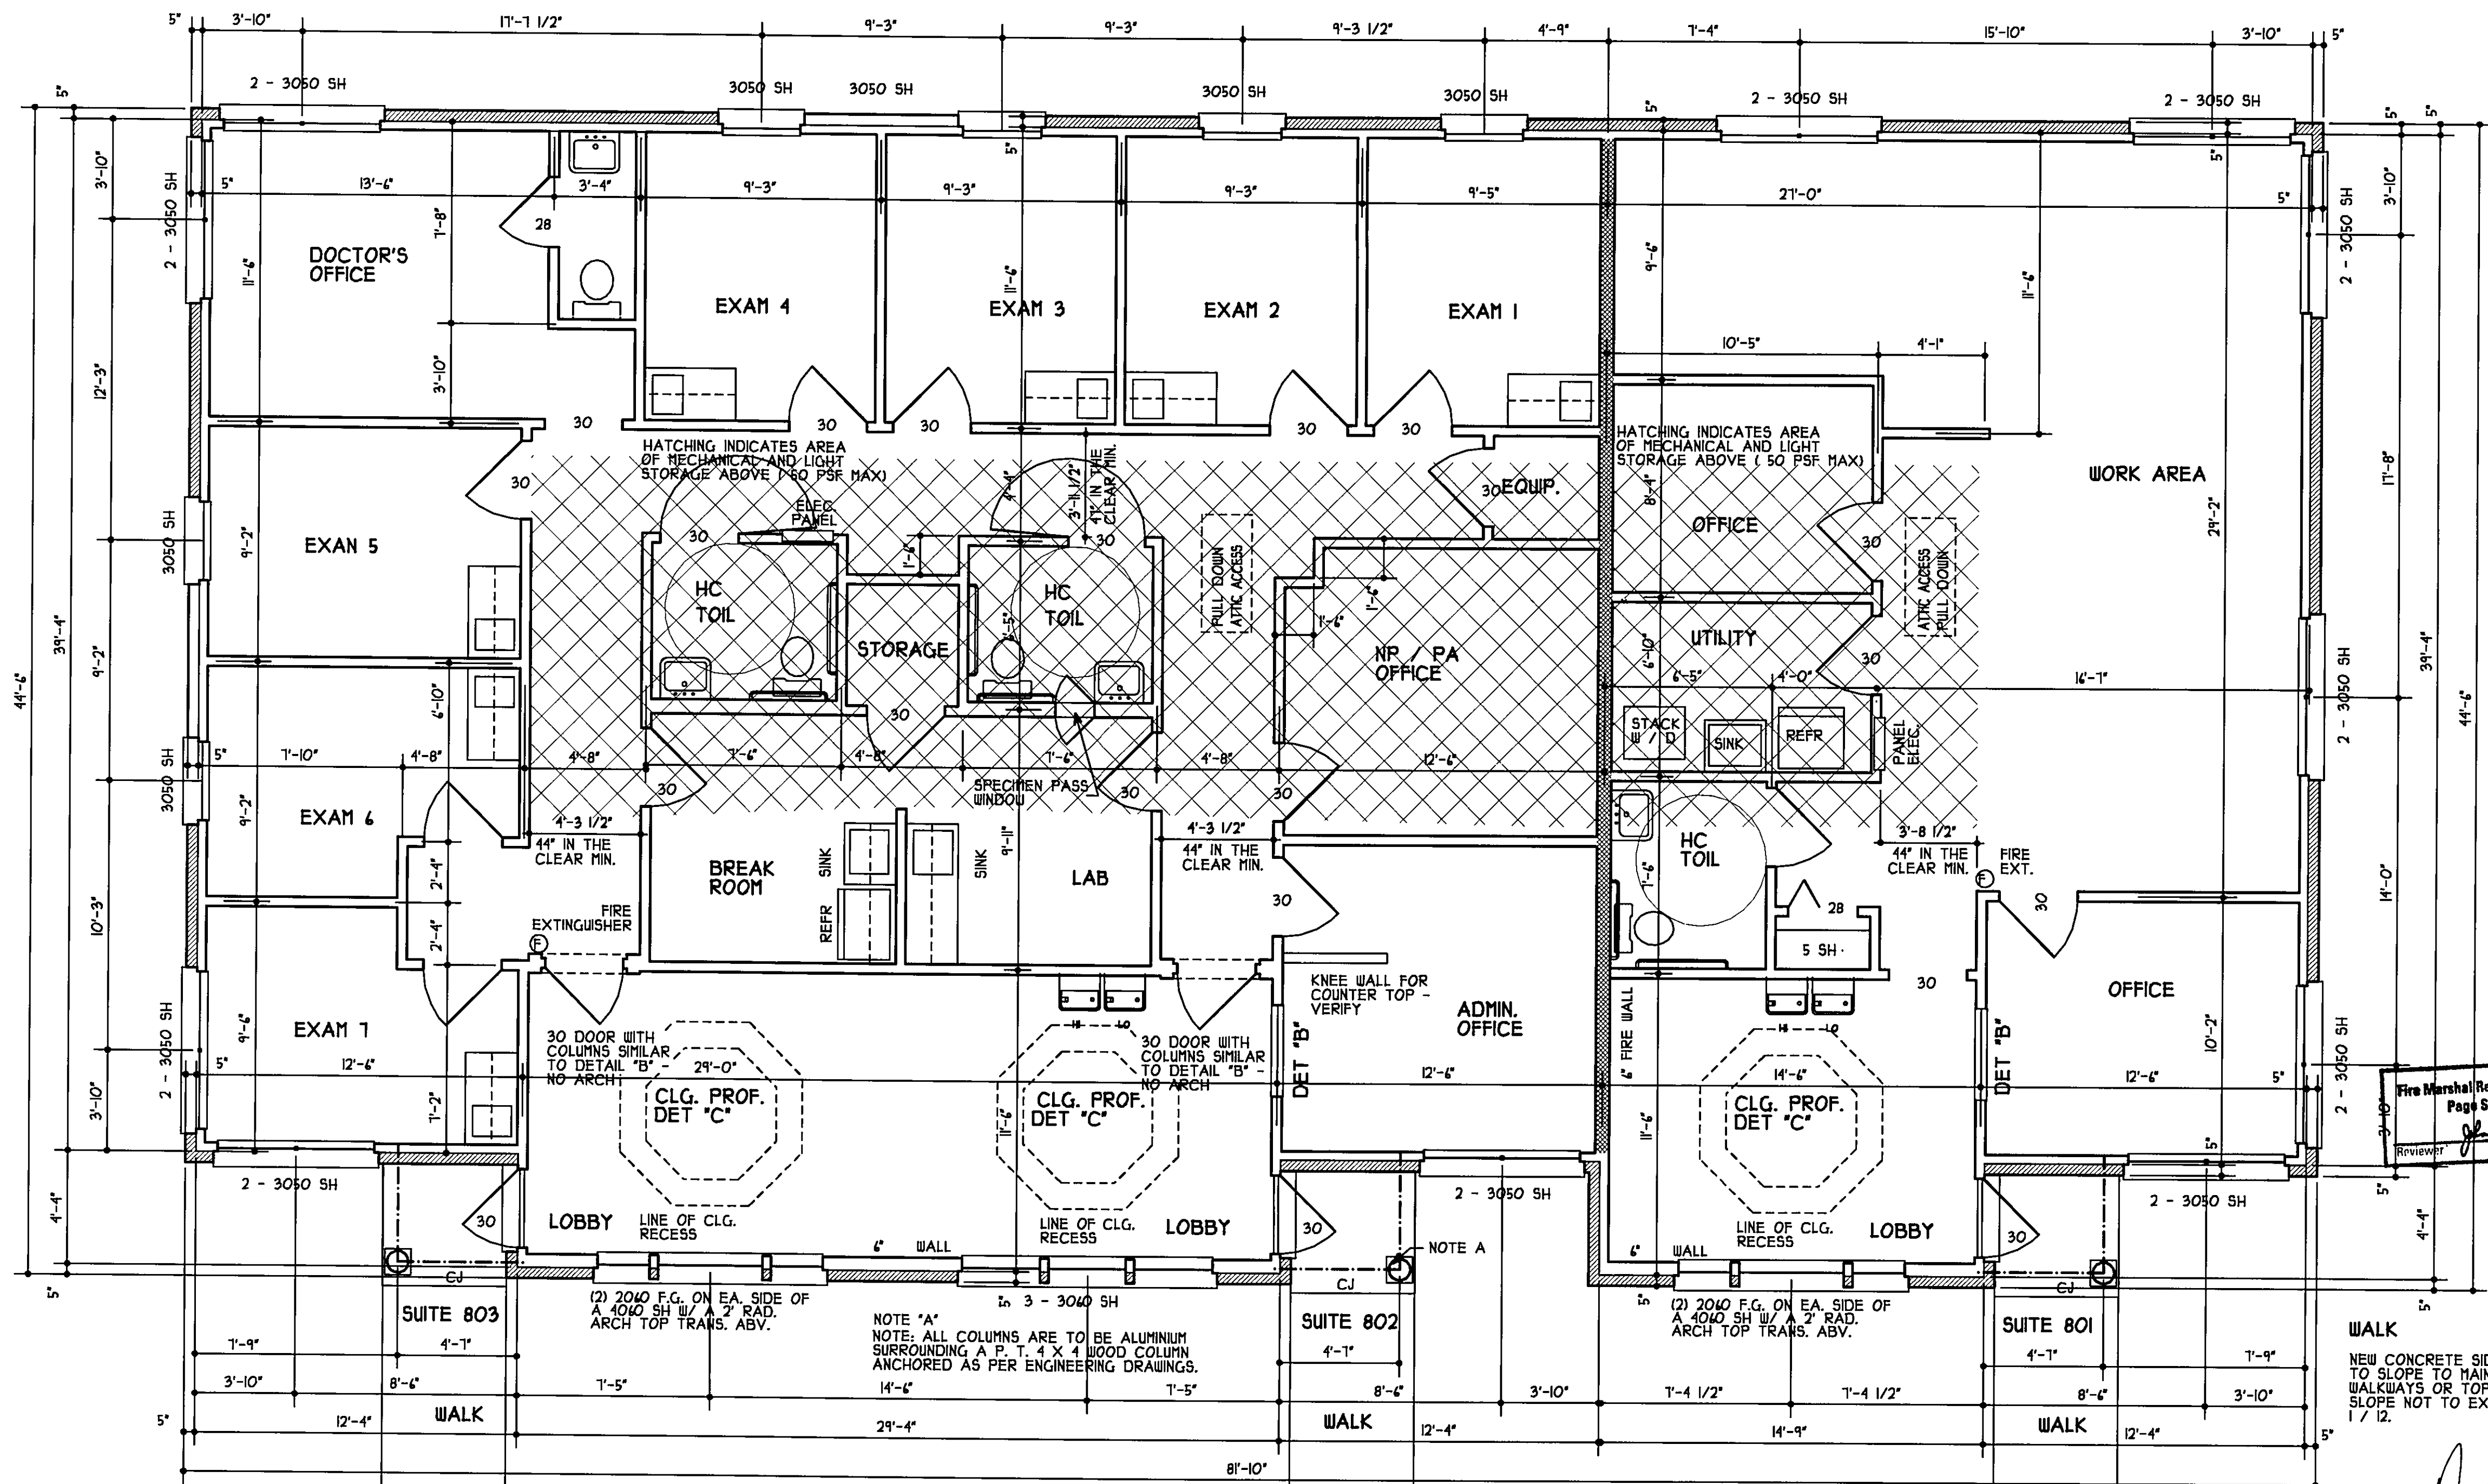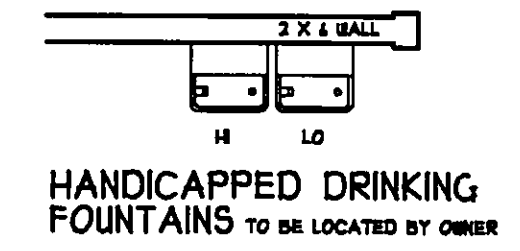

REVISED

NOTATION: ALL DIMENSIONS ARE TO FACE UNLESS OTHERWISE NOTED. ALL WALLS ARE TO BE CONSTRUCTED PER THE 2000 INTERNATIONAL BUILDING CODE. ALL DOORS ARE TO BE 28\"/>

1990
NCARB
REGISTERED ARCHITECT
ROBERT ALLEN CONNER
1166 SAINT ARCHBISHOP ROAD
JACKSONVILLE, FLORIDA 32223
904 - 288 - 7822



GENERAL NOTES:

- ALL PULL DOWN ATTIC STAIR UNITS ARE TO BE 25 1/2 X 54 1/2 AND RATED FOR 300 POUNDS, CENTER IN HALL.
- DISTANCE FROM ALL WALLS TO FACE OF DOOR JAMB TO BE 4" (IF POSSIBLE).
- WHERE HATCHED ATTIC SPACE AREA IS SHOWN THE CEILING HEIGHT IS TO BE AS CLOSE AS POSSIBLE TO 8'-0" IN THAT SPACE.
- THE STORAGE AREA ABOVE IS TO BE LABELED * MAX WEIGHT 60 POUNDS PER SQUARE FOOT

DIMENSION NOTES
ALL DIMENSIONS USED ON THIS PLAN ARE BASED ON THE FOLLOWING:
ALL DIMENSIONS ARE BASED ON THE OUTSIDE FACE OF WALL THE EXTERIOR WALL TO THE CENTERLINE OF AN INTERIOR WALL. SEE SHEET 1 FOR ADDITIONAL INFORMATION.

EXTERIOR BRICK VENEER WALLS
STUD 4" - BRICK 5" 9"
STUD 4" - BRICK 5" (AT FRONTS) 11"
INTERIOR WALLS 4"
INTERIOR PLUMBING WALLS 6"


GENERAL NOTE:
GENERAL CONTRACTOR SHALL COORDINATE THIS PLAN WITH ALL OTHER SHEETS. THE INFORMATION SHOWN ON THIS SHEET GOVERNS.

FLOOR PLAN

WALK
NEW CONCRETE SIDEWALK TO SLOPE TO MAIN WALKWAYS OR TOP OF CURB. SLOPE NOT TO EXCEED 1/12.

THIS DOCUMENT IS THE PROPERTY OF THE ARCHITECT AND IS TO BE USED ONLY FOR THE PROJECT AND SITE SPECIFICALLY IDENTIFIED HEREON. IT IS NOT TO BE REPRODUCED, COPIED, REPRODUCED, TRANSMITTED, OR IN ANY MANNER DISSEMINATED TO ANY OTHER PARTY WITHOUT THE WRITTEN CONSENT OF THE ARCHITECT. THE ARCHITECT ASSUMES NO LIABILITY FOR ANY DAMAGE TO PERSONS OR PROPERTY ARISING FROM THE USE OF THIS DOCUMENT FOR ANY OTHER PROJECT OR FOR ANY OTHER PURPOSE. THE ARCHITECT'S LIABILITY IS LIMITED TO THE PROFESSIONAL SERVICES PROVIDED BY HIMSELF OR HIS FIRM. THE ARCHITECT DOES NOT WARRANT OR GUARANTEE THE ACCURACY OR COMPLETENESS OF THE INFORMATION PROVIDED HEREON. THE ARCHITECT'S LIABILITY IS LIMITED TO THE PROFESSIONAL SERVICES PROVIDED BY HIMSELF OR HIS FIRM. THE ARCHITECT DOES NOT WARRANT OR GUARANTEE THE ACCURACY OR COMPLETENESS OF THE INFORMATION PROVIDED HEREON.

ATTIC FLOOR PLAN
OFFICES AT EASTPARK - BUILDING 800
JACKSONVILLE, FLORIDA

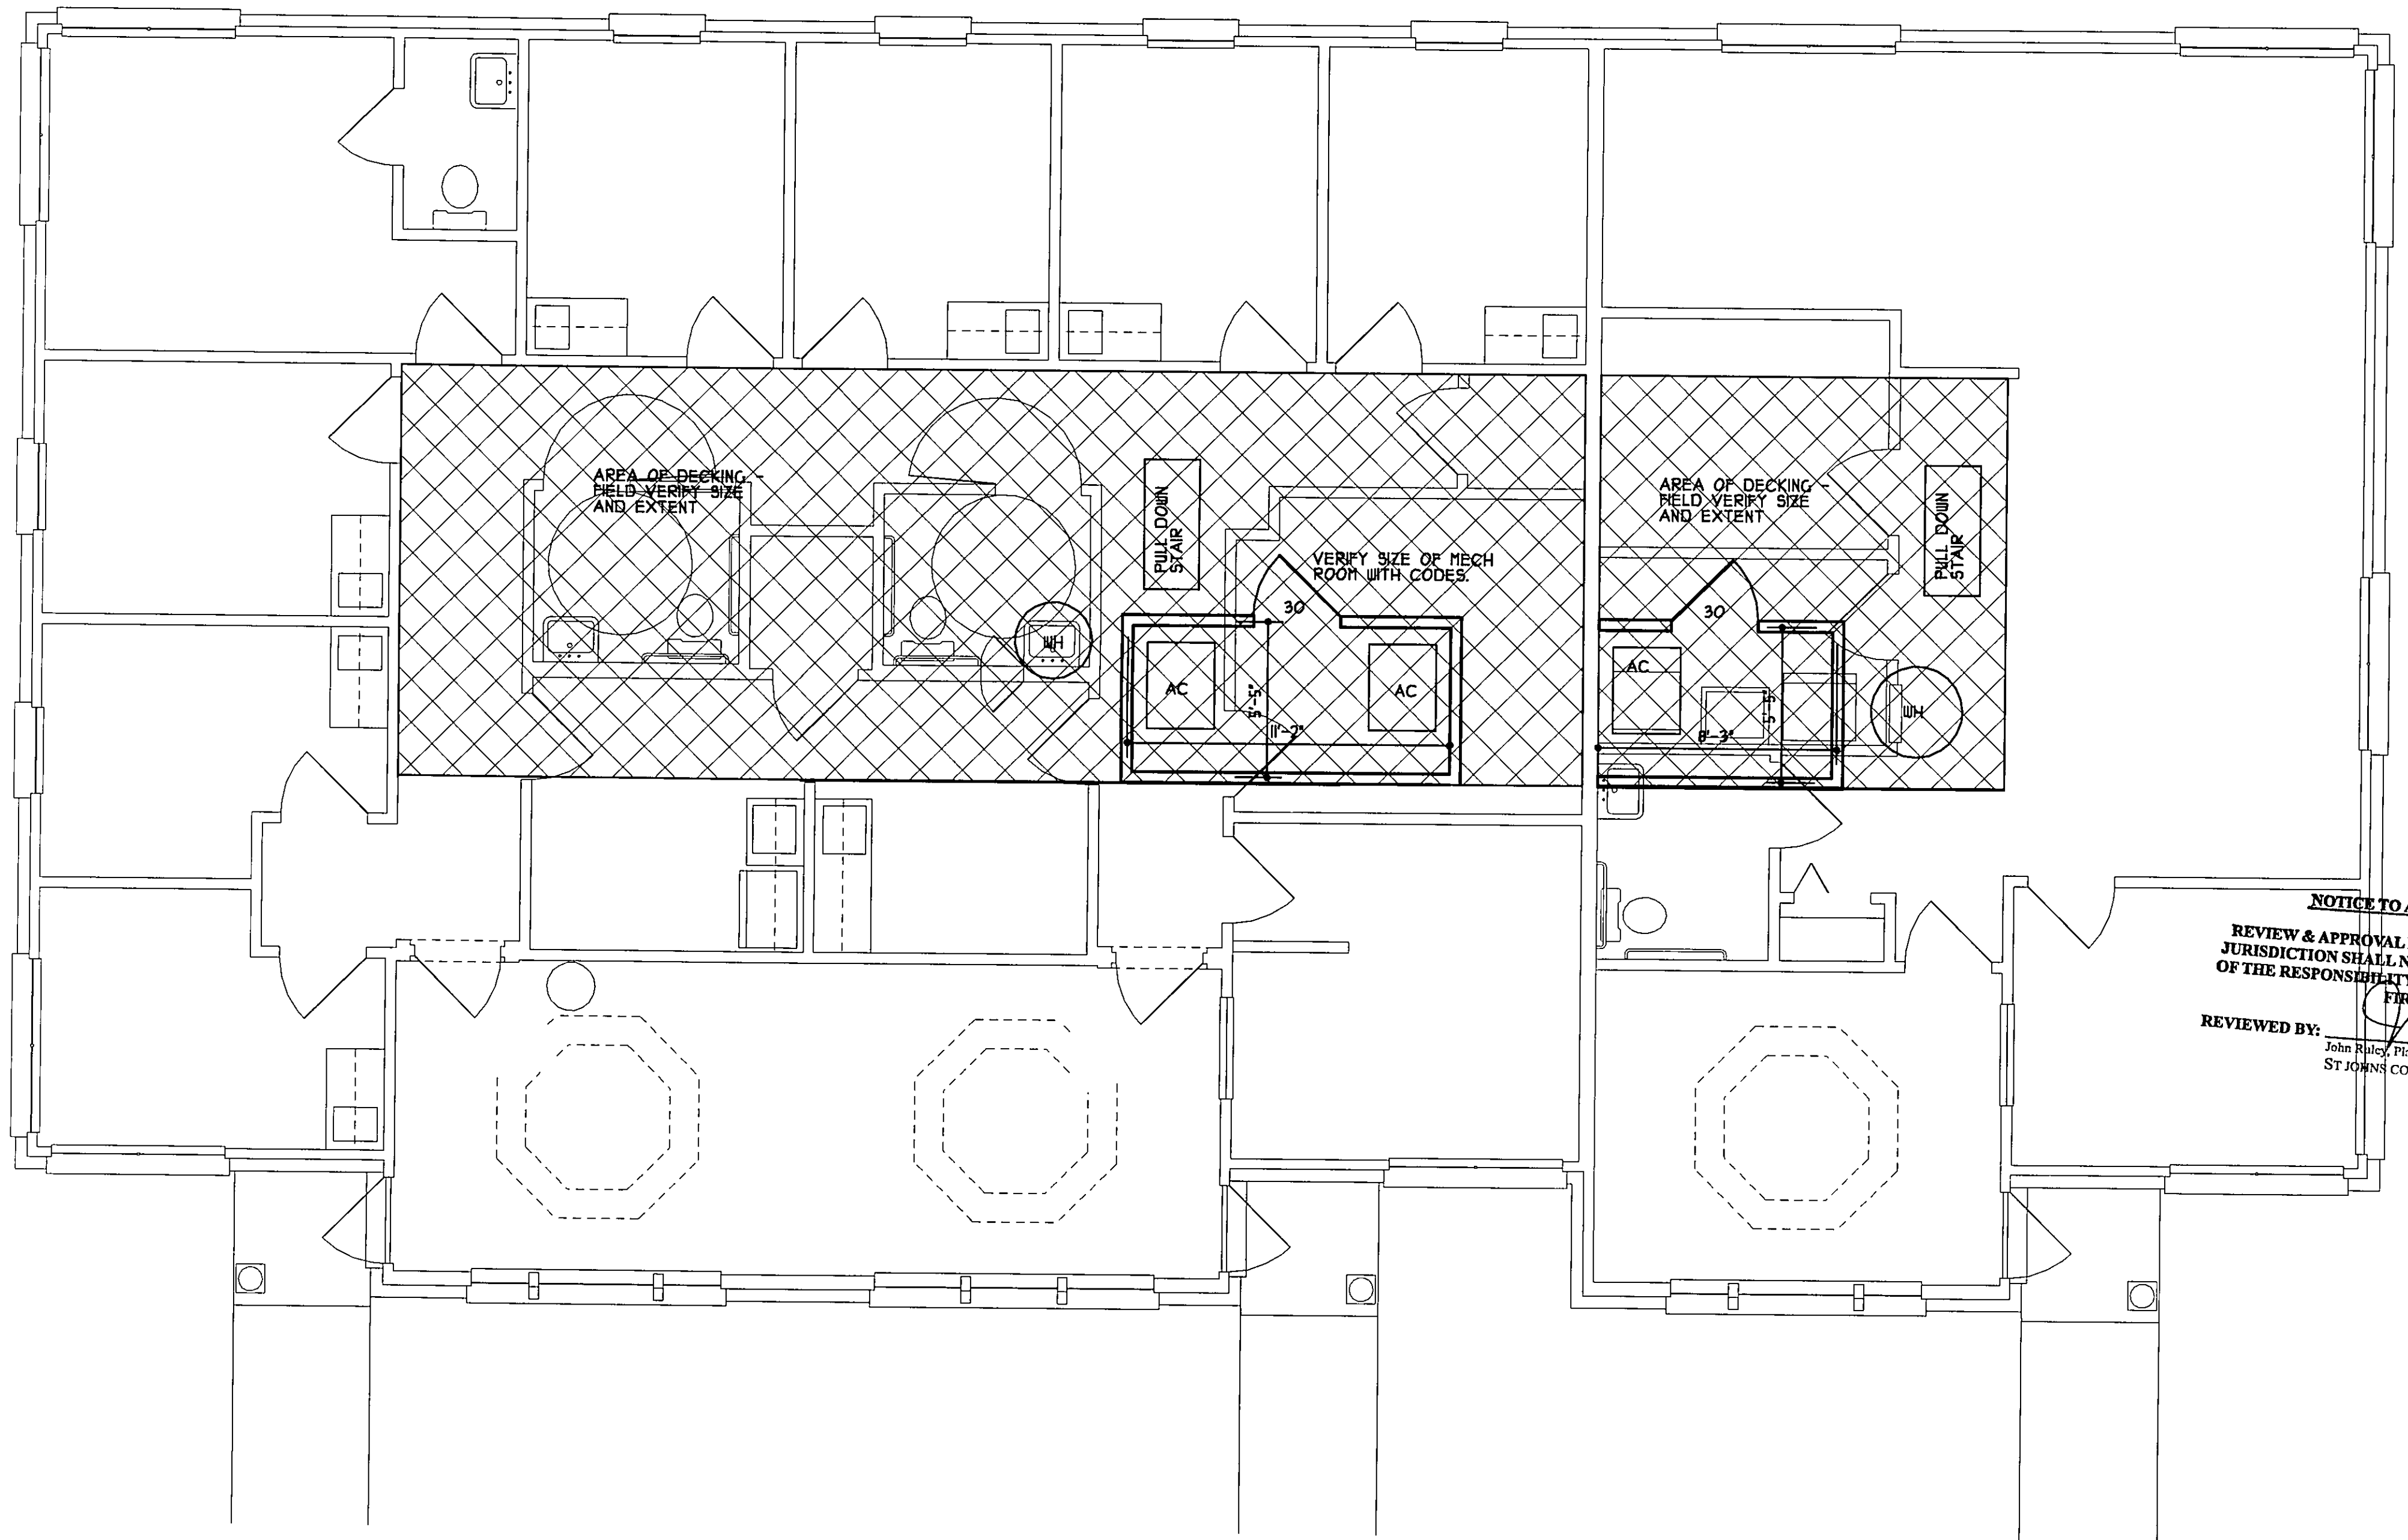


NOTICE TO ALL CONTRACTORS
REVIEW & APPROVAL BY THE AUTHORITY HAVING JURISDICTION SHALL NOT RELIEVE THE APPLICANT OF THE RESPONSIBILITY OF COMPLIANCE WITH THE FIRE CODE.
REVIEWED BY: John Riley, Plans Examiner, 30883 ST JOHN'S COUNTY FIRE RESCUE
DATE: _____

ATTIC FLOOR PLAN

11840
FLORIDA ARCHITECT
ROBERT ALLEN CONNER
NCARB - ARCHITECT
11644 SAINT JOSEPH'S ROAD
JACKSONVILLE, FLORIDA 32223
904 - 286 - 7822


DATE 4-4-04
DRAWN R A C
REVISED X-XX-XX

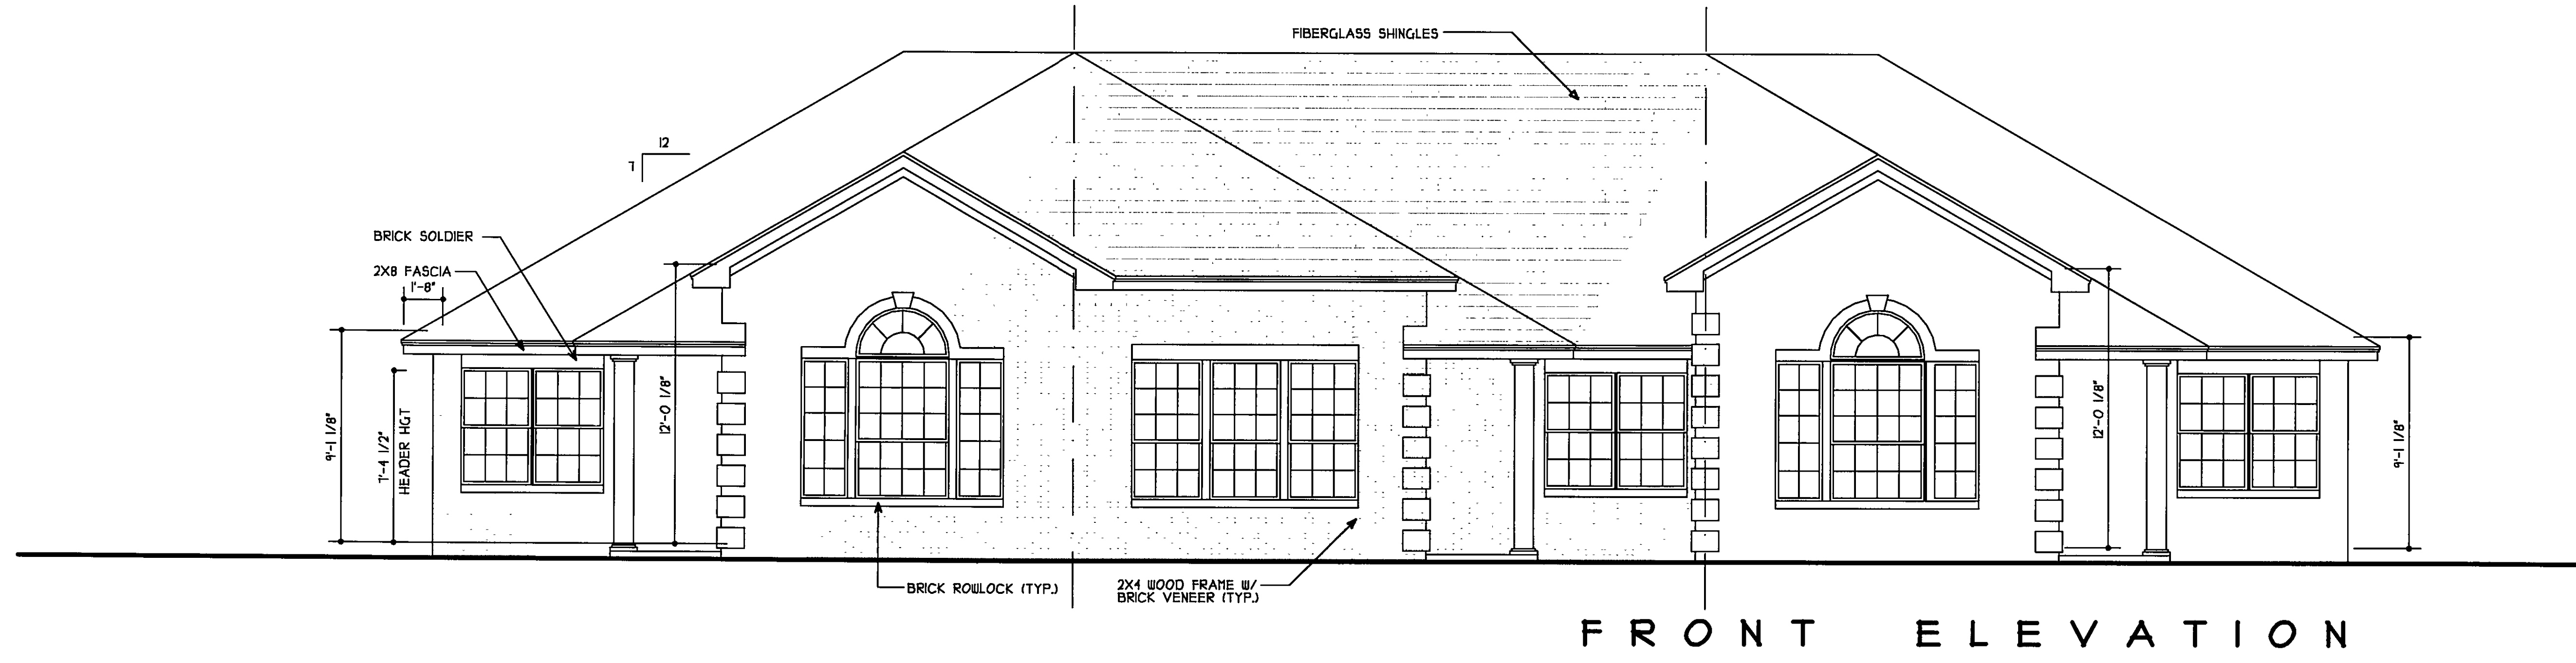


FRONT ELEVATION

GENERAL NOTES


1. ALL ROOF SLOPES TO BE 12/12
2. ALL ROOFING TO BE SHINGLES
3. ALL METAL TO BE PAINTED
4. ALL ROOF OVERHANGS - UNO
AT HIPS ----- 1'-4"
AT GABLES ----- 1'-0"
5. PROVIDE CRICKETS AT ALL POINTS WHERE VALLEYS RUN LEVEL
6. ALL SOFFITS AND FASCIAS TO BE COVERED WITH ALUMINUM OR VINYL AS APPLICABLE.
7. ALL WINDOWS AND DOORS ARE TO HAVE MUNTINS AS DETERMINED BY OWNER
8. ALL WOOD FRAMING TO BE SPF GRADE UNLESS IN CONTACT WITH CONCRETE OR AS NOTED AND THERE TO PT # 2 SYP. PLATES TO BE PT # 2 SYP IF REQUIRED BY LOCAL CODES.

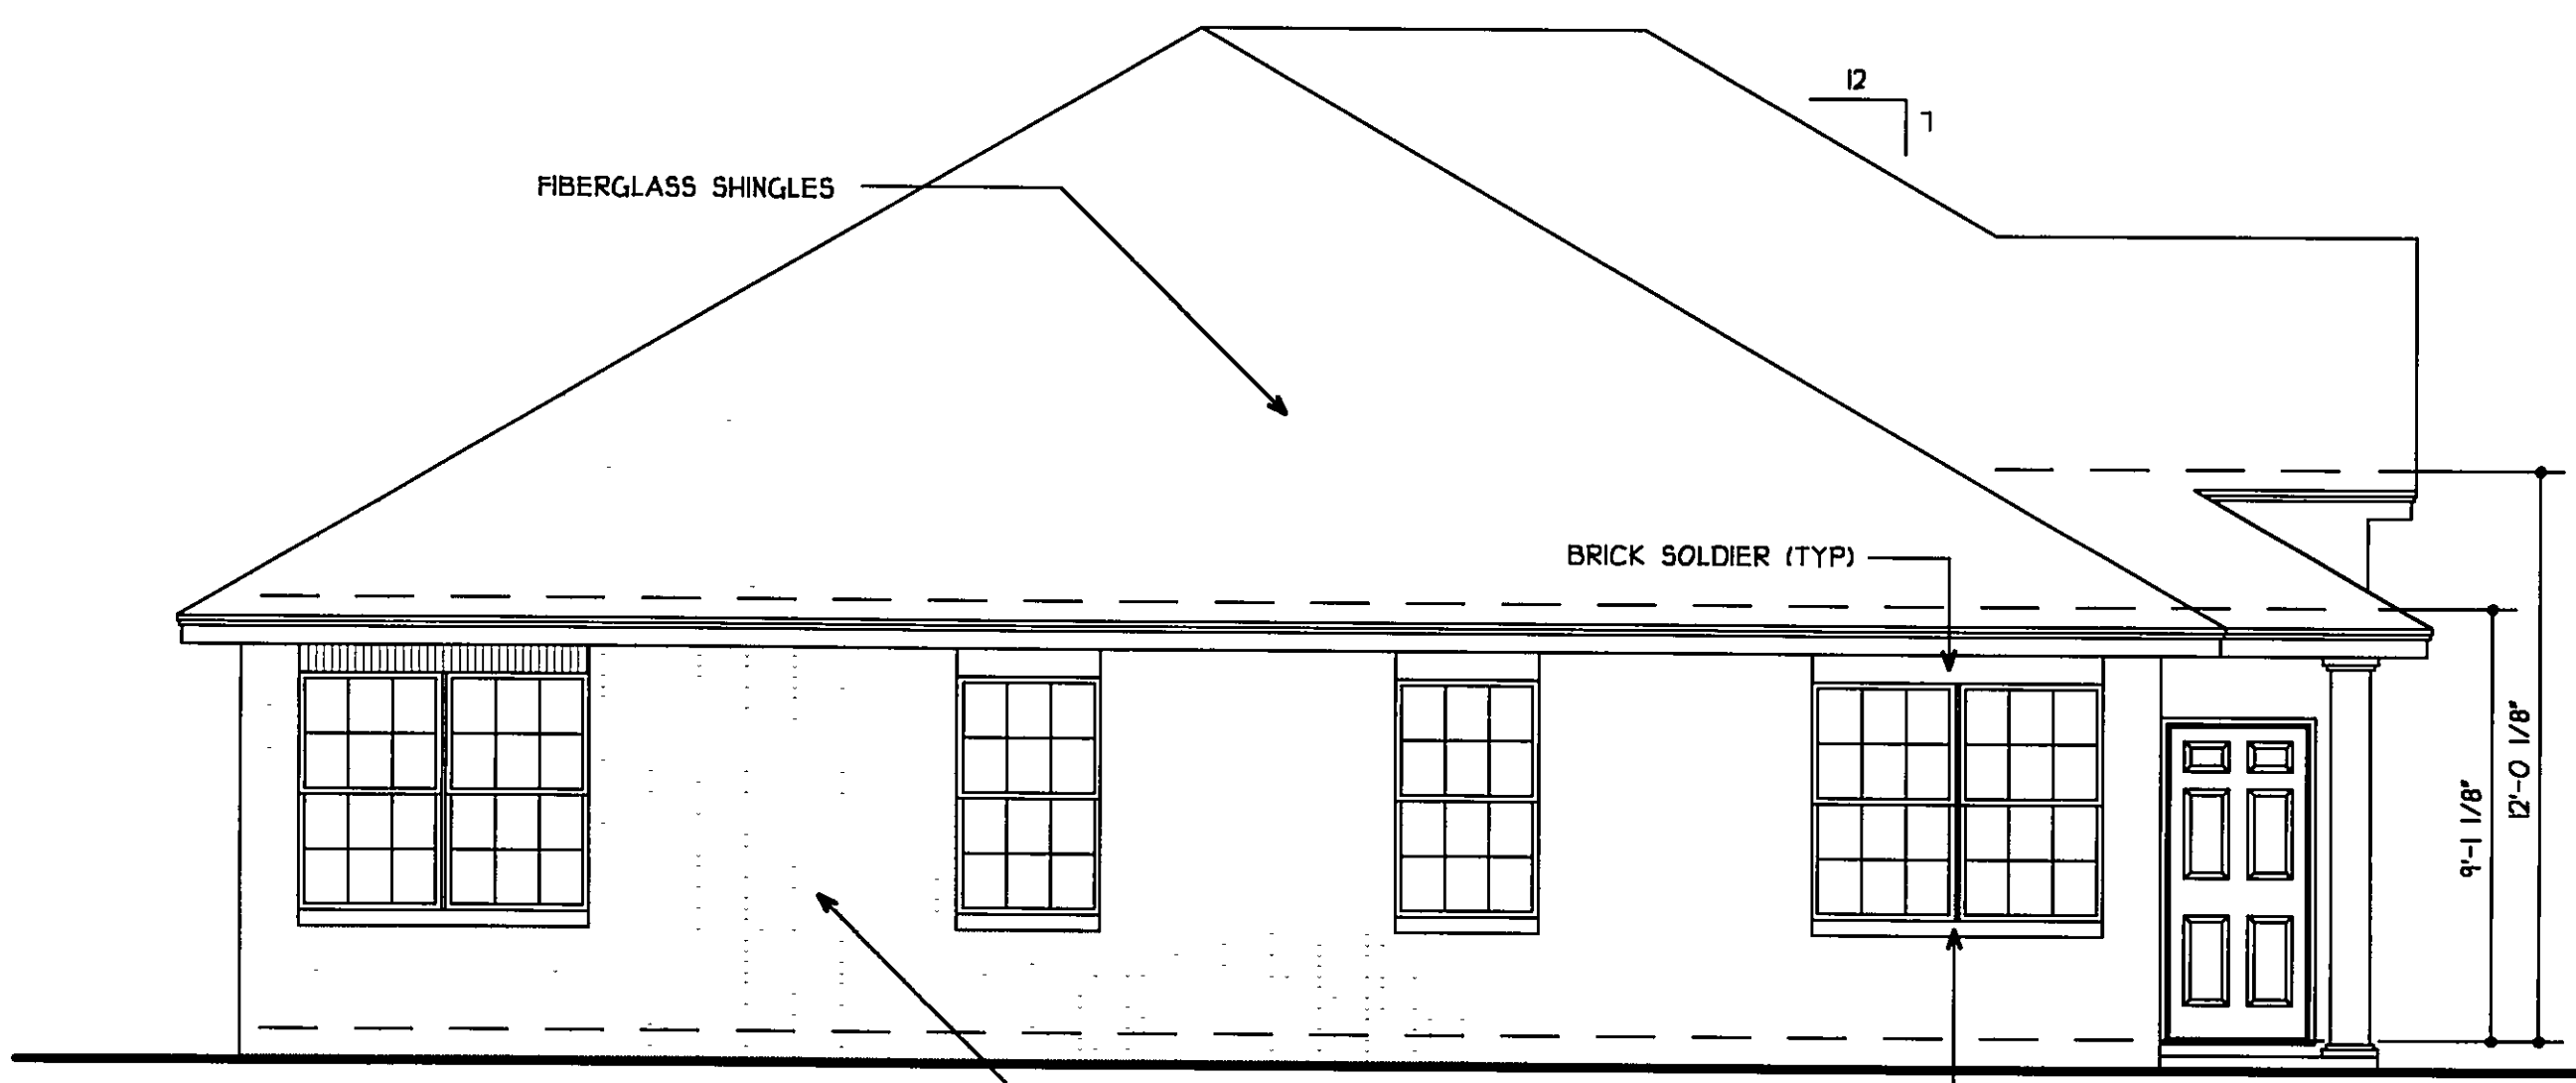

LEFT ELEVATION

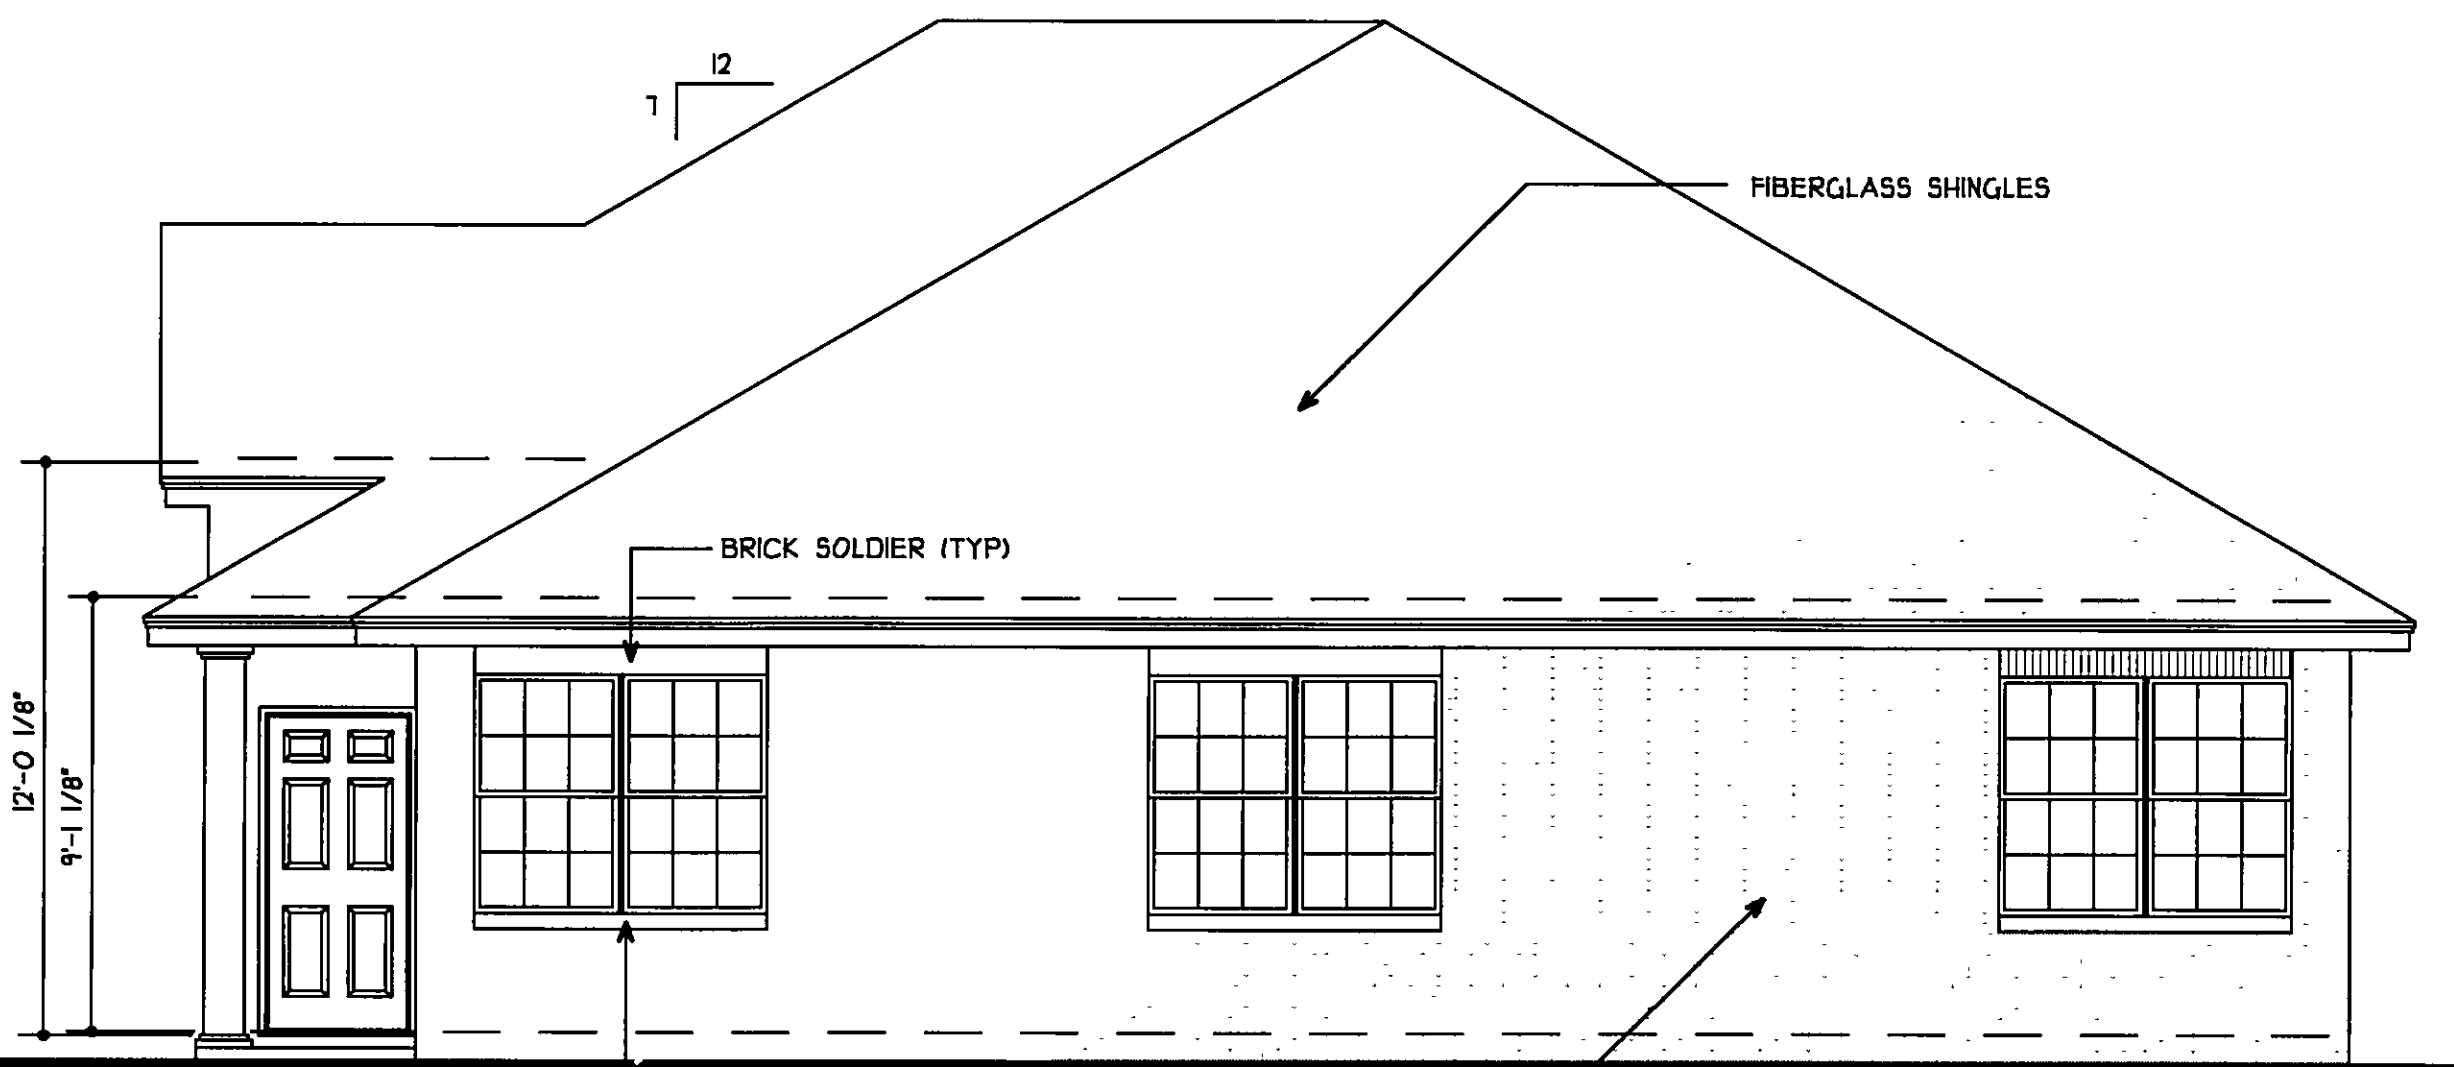

RIGHT ELEVATION

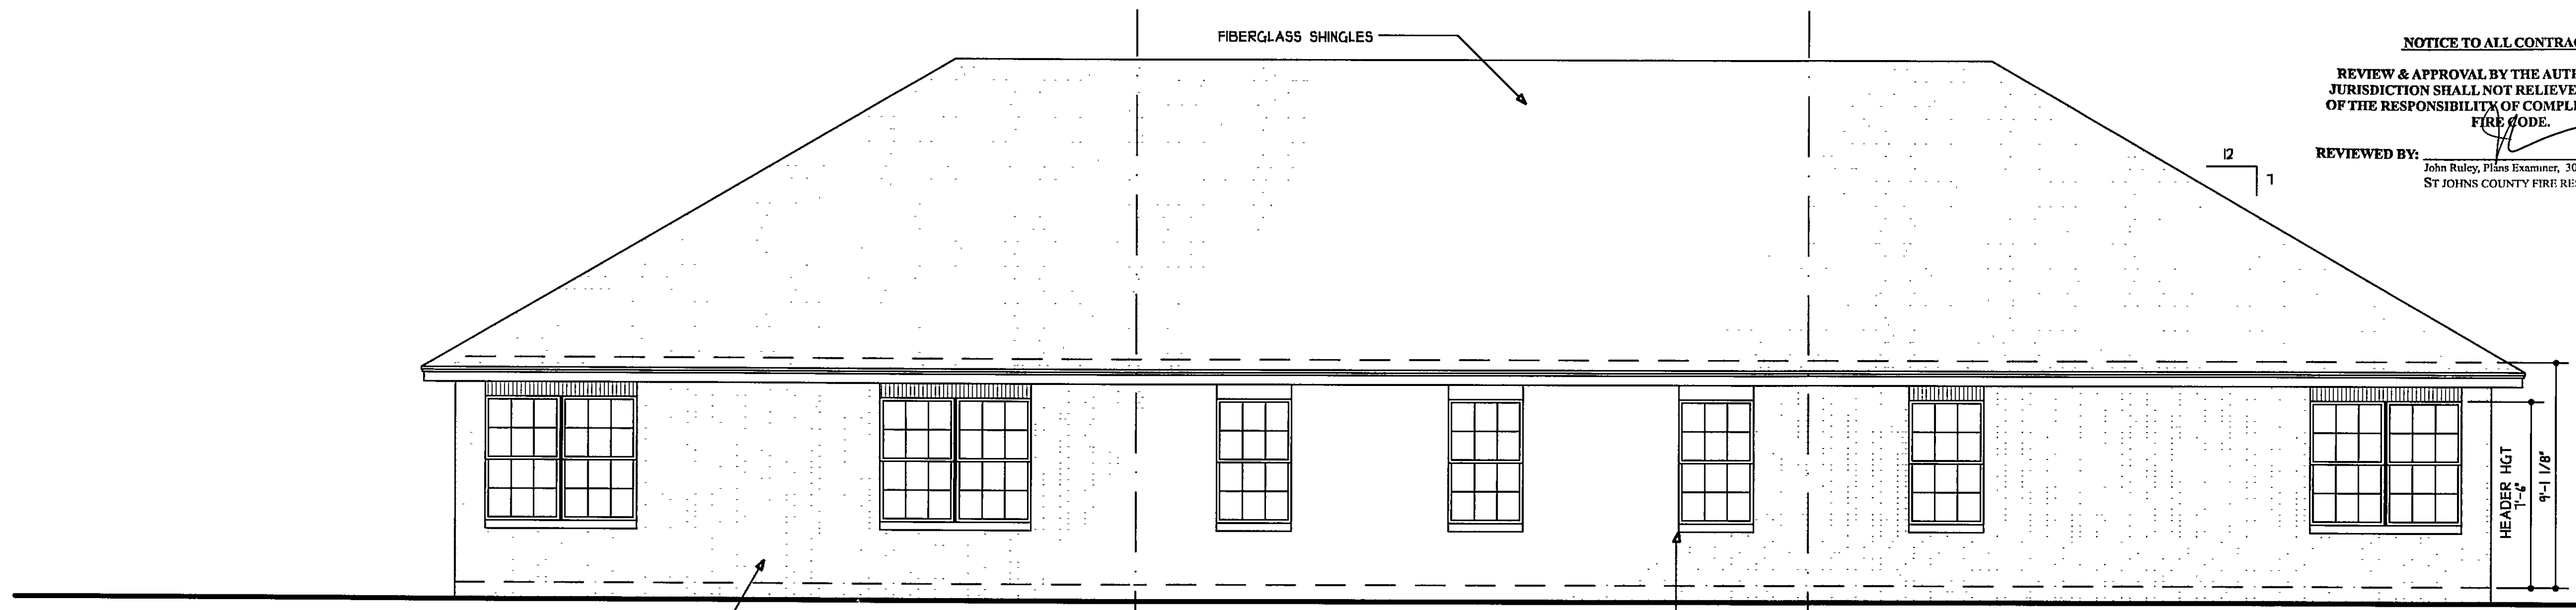

REAR ELEVATION


NOTICE TO ALL CONTRACTORS
REVIEW & APPROVAL BY THE AUTHORITY HAVING JURISDICTION SHALL NOT RELIEVE THE APPLICANT OF THE RESPONSIBILITY OF COMPLIANCE WITH THE FIRE CODE.
REVIEWED BY: *[Signature]* DATE _____
John Ruley, Plans Examiner, 30883
ST JOHNS COUNTY FIRE RESCUE

THIS PLAN IS THE PROPERTY OF THE ARCHITECT AND IS TO BE USED ONLY FOR THE PROJECT AND SITE SPECIFICALLY IDENTIFIED HEREON. IT IS NOT TO BE REPRODUCED, COPIED, REPRODUCED, OR TRANSMITTED IN ANY FORM OR BY ANY MEANS, ELECTRONIC OR MECHANICAL, INCLUDING PHOTOCOPYING, RECORDING, OR BY ANY INFORMATION STORAGE AND RETRIEVAL SYSTEM, WITHOUT THE WRITTEN PERMISSION OF THE ARCHITECT. THE ARCHITECT ASSUMES NO LIABILITY FOR ANY DAMAGE TO PERSONS OR PROPERTY ARISING FROM THE USE OF THIS PLAN, WHETHER SUCH DAMAGE BE CAUSED BY NEGLIGENCE OR OTHERWISE, AND THE ARCHITECT SHALL NOT BE RESPONSIBLE FOR ANY CONSTRUCTION DEFECTS OR OMISSIONS, WHETHER SUCH DEFECTS OR OMISSIONS BE CAUSED BY NEGLIGENCE OR OTHERWISE, AND THE ARCHITECT SHALL NOT BE RESPONSIBLE FOR ANY CONSTRUCTION DEFECTS OR OMISSIONS, WHETHER SUCH DEFECTS OR OMISSIONS BE CAUSED BY NEGLIGENCE OR OTHERWISE.

FRONT, SIDE AND REAR ELEVATIONS
OFFICES AT EASTPARK - BUILDING 800
JACKSONVILLE, FLORIDA

ROBERT ALLEN CONNER
ARCHITECT
11644 SAINT JOSEPH ROAD
JACKSONVILLE, FLORIDA 32223
904 - 268 - 7822


DATE 4-4-04
DRAWN R A C
REVISED X-XX-XX

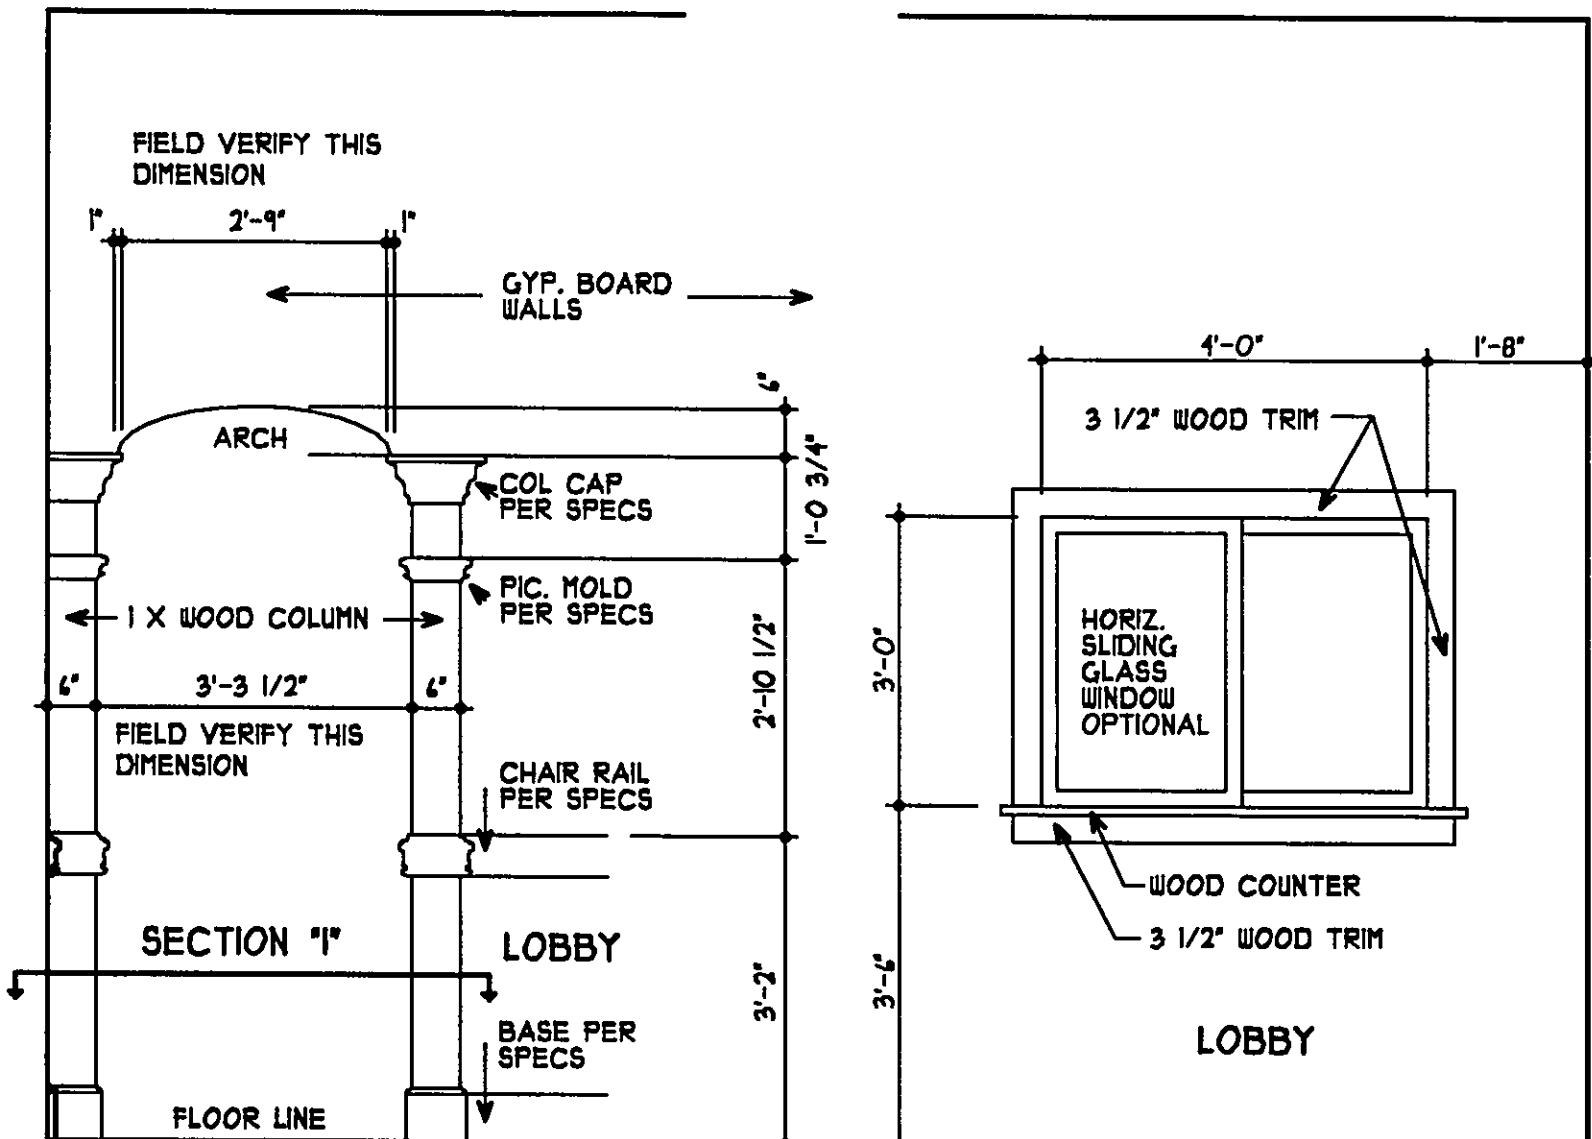


DETAIL "A"
SCALE 1/2" = 1'-0"

DETAIL "B"
SCALE 1/2" = 1'-0"


TYP. DOOR LOCATIONS

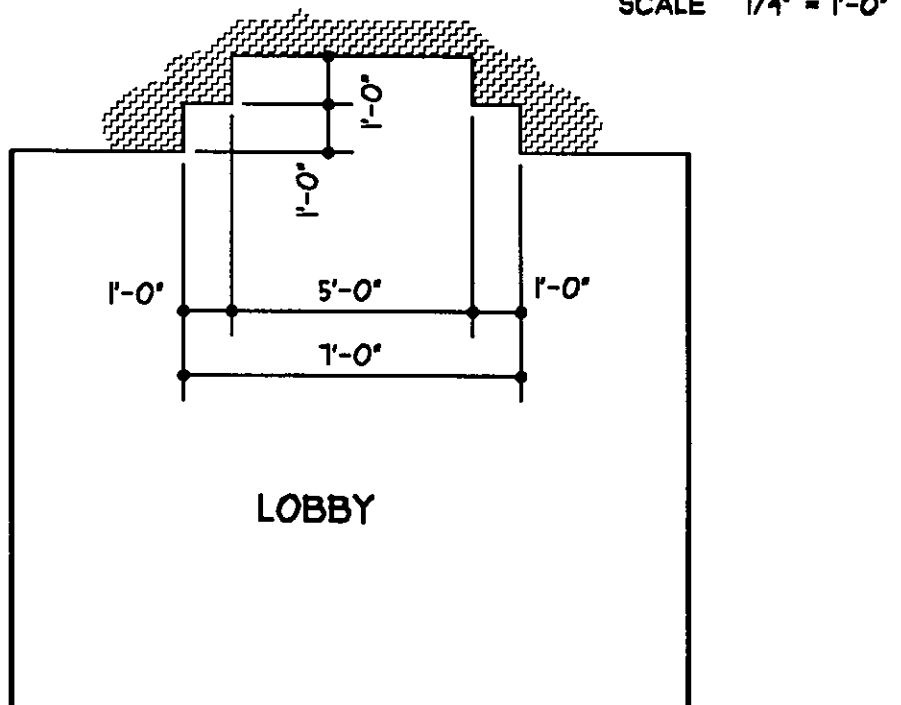


DETAIL "C"
SCALE 1/4" = 1'-0"

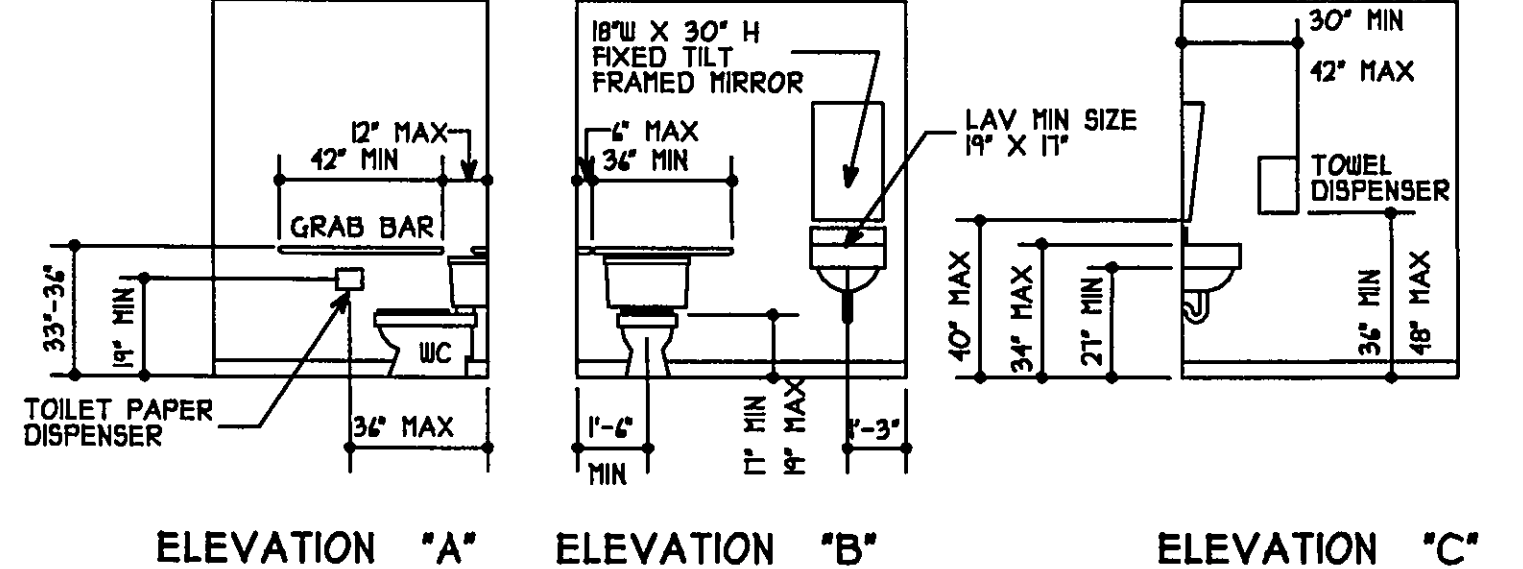

ALL HANDICAPPED DOOR HARDWARE
ALL DOOR HARDWARE, HANDLES, PULLS, LATCHES, LOCKS AND OTHER OPERATING DEVICES ON ACCESSIBLE DOORS SHALL HAVE A SHAPE THAT IS EASY TO GRASP WITH ONE HAND AND DOES NOT REQUIRE TIGHT GRASPING, TIGHT PINCHING OR TWISTING OF THE WRIST TO OPERATE. LEVER-OPERATED MECHANISMS, PUSH-TYPE MECHANISMS AND U-SHAPED HANDLES ARE ACCEPTABLE DESIGNS.

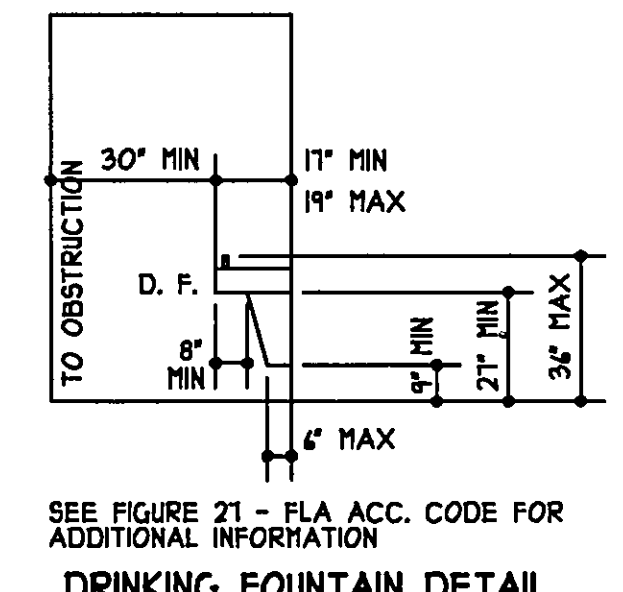

SEE FIGURE 21 - FLA ACC. CODE FOR ADDITIONAL INFORMATION
DRINKING FOUNTAIN DETAIL

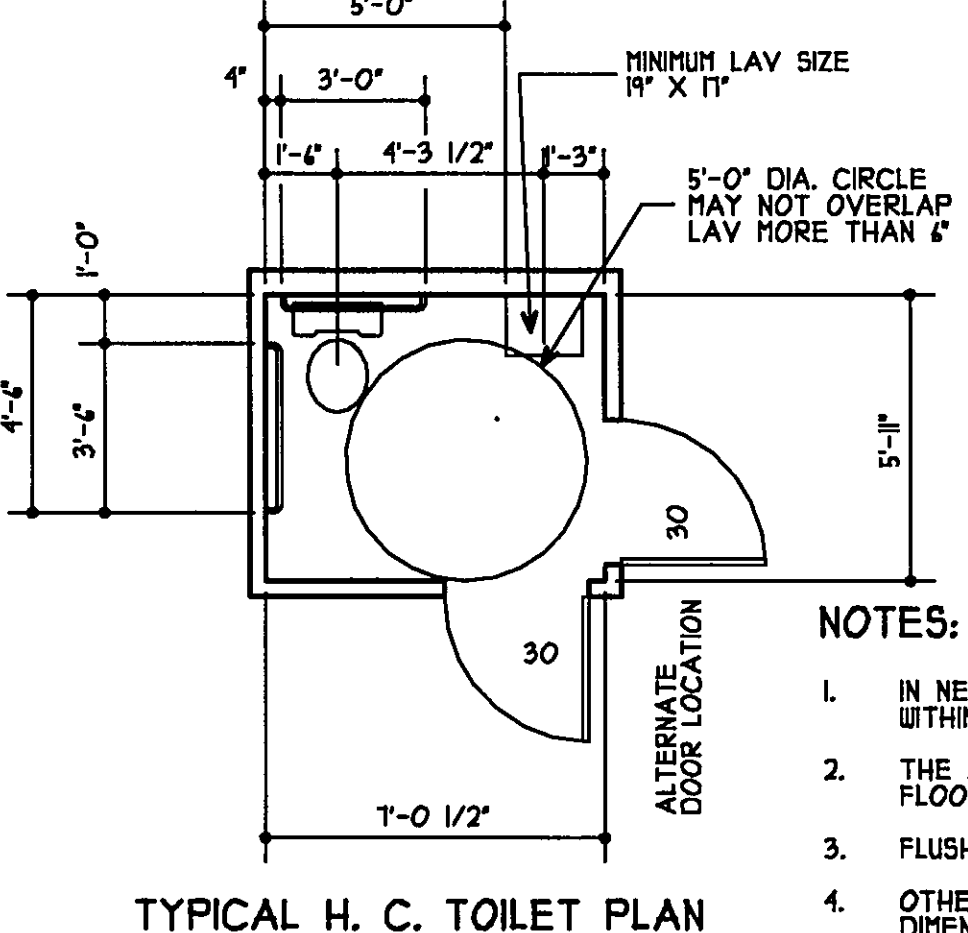


TYPICAL H. C. TOILET PLAN


GENERAL NOTES:
PLAN AND ELEVATIONS AS SHOWN ABOVE ARE TYPICAL FOR NEW CONSTRUCTION AND ARE INTENDED TO BE DIAGRAMMATIC ONLY. REFER TO THE CONSTRUCTION PLAN FOR ACTUAL ROOM SIZE AND CONFIGURATION.
SOURCE: ALL OF THE INFORMATION SHOWN ON THIS TYPICAL DETAIL IS TAKEN FROM THE FLORIDA ACCESSIBILITY CODE FOR BUILDING (FACBC) OCTOBER 1991 EDITION SECOND PRINTING, FIGURES 28 THRU 32E
ALL TOILET ROOM FIXTURES AND CONSTRUCTION MUST COMPLY WITH ALL LOCAL AND STATE BUILDING CODES, LOCAL STATE LAWS, FLORIDA ACCESSIBILITY CODES AND THE AMERICANS WITH DISABILITIES ACT. LATEST EDITIONS WHETHER SHOWN OR NOT. IF A CONFLICT OCCURS BETWEEN THE DRAWINGS AND THE REFERENCED CODES, THE REFERENCED CODES AND LAWS GOVERN.

- NOTES:**
1. IN NEW CONSTRUCTION, A LAVATORY SHALL BE PROVIDED WITHIN THE ACCESSIBLE TOILET STALL.
 2. THE LAVATORY SHALL NOT ENCRUCH INTO THE REQUIRED FLOOR SPACE FOR THE WATER CLOSET. (LAV. MIN. 19" W X 11" D)
 3. FLUSH CONTROLS SHALL COMPLY WITH SECTION 416.5 (ADA CODES)
 4. OTHER CONFIGURATIONS ARE POSSIBLE, HOWEVER ALL CLEARANCE DIMENSIONS MUST BE MAINTAINED.
 5. ALL DIMENSIONS ARE CLEAR TO FACE OF WALL FINISH. G. C. TO FIELD ADJUST WALL DIMENSIONS AS REQUIRED.
 6. ANY EXPOSED WATER PIPES (HUI OR DRAIN) ARE TO BE INSULATED AND SHALL HAVE NO SHARP EDGES OR CORNERS.
 7. FLUSH HANDLE SHALL BE ON THE APPROACH SIDE OF THE W. C.
 8. INSTALL PT 2 X 4 SOLID WOOD BLOCKING FOR ALL WALL MOUNTED FIXTURES OR AS SHOWN IN DETAILS.

TYPICAL HANDICAPPED TOILET DETAILS STANDARD DETAIL HC-1

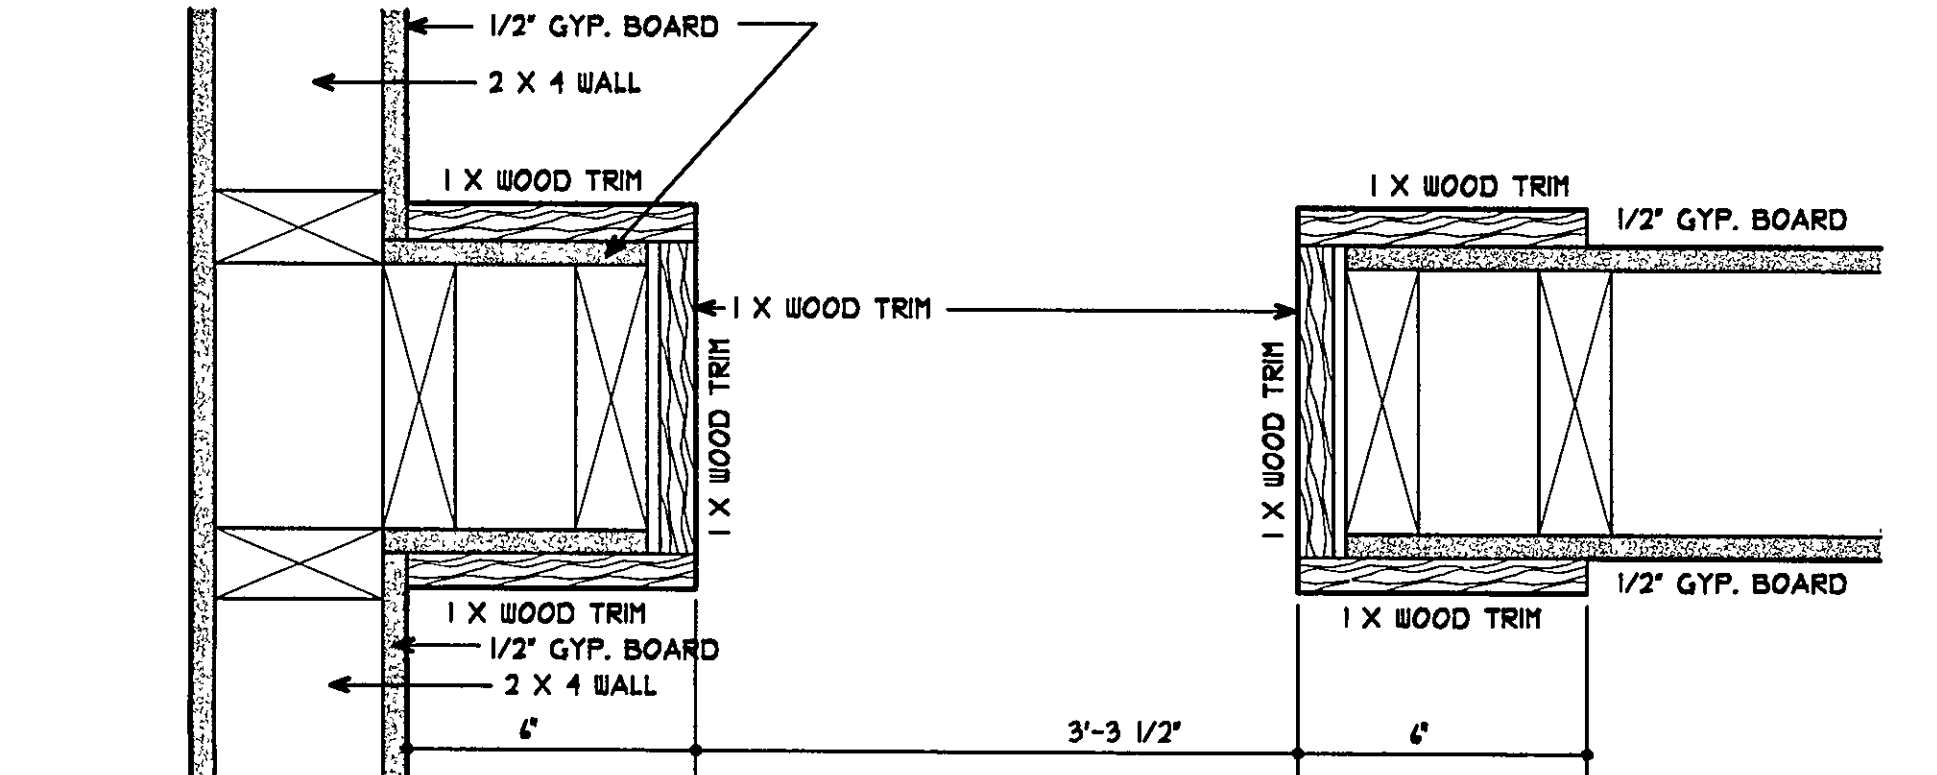


SECTION "I" SCALE 3/8" = 1'-0"

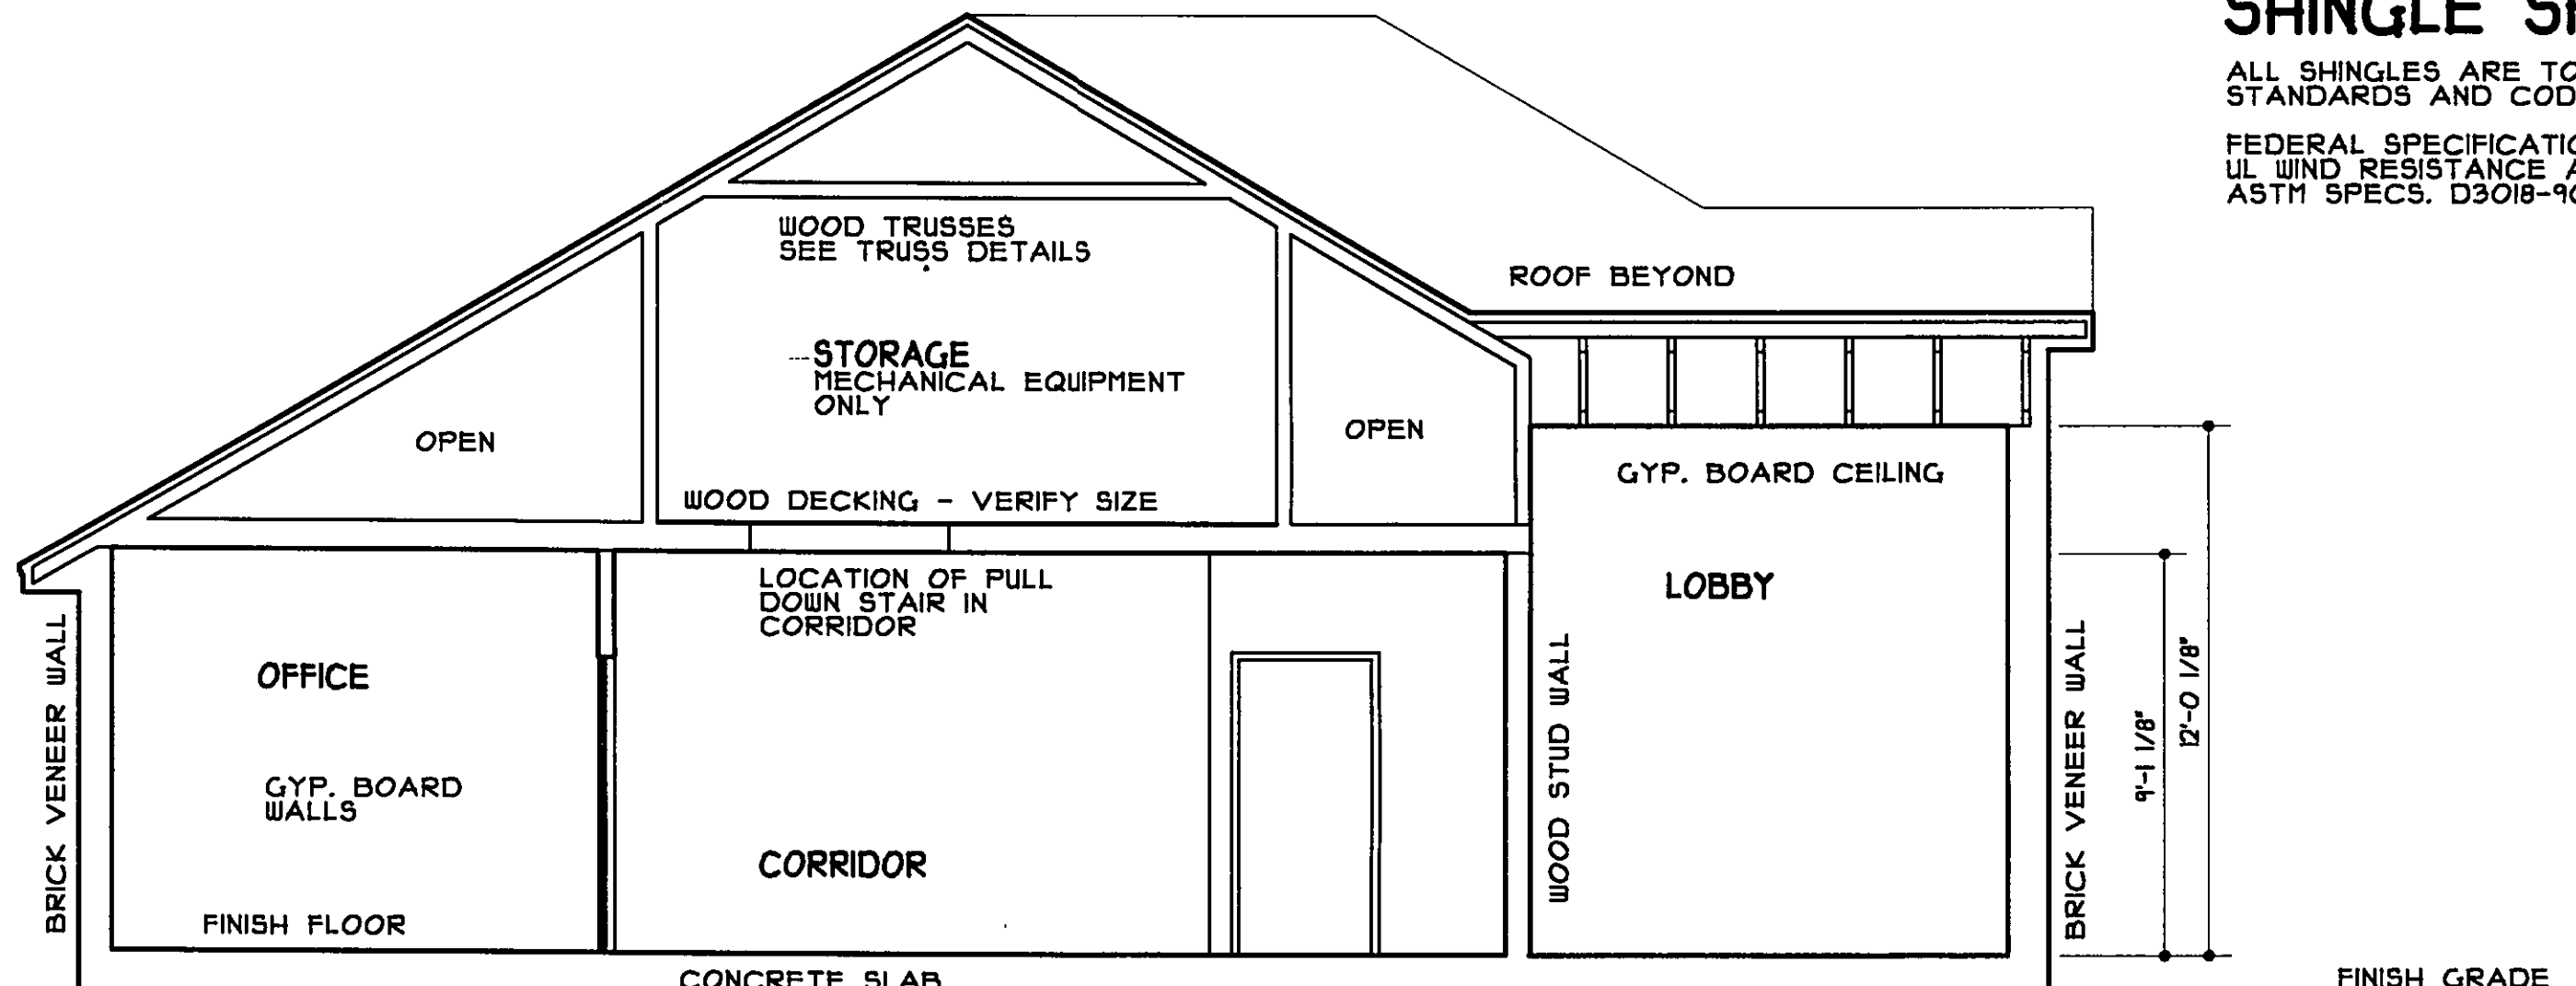

CROSS SECTION "A"


SHINGLE SPECS:

ALL SHINGLES ARE TO MEET THE FOLLOWING STANDARDS AND CODES:
FEDERAL SPECIFICATIONS 55-9-00534 (GSA FSS), UL WIND RESISTANCE AND CLASS "A" FIRE RATINGS, ASTM SPECS. D3018-90, TYPE I, AND E-108-90

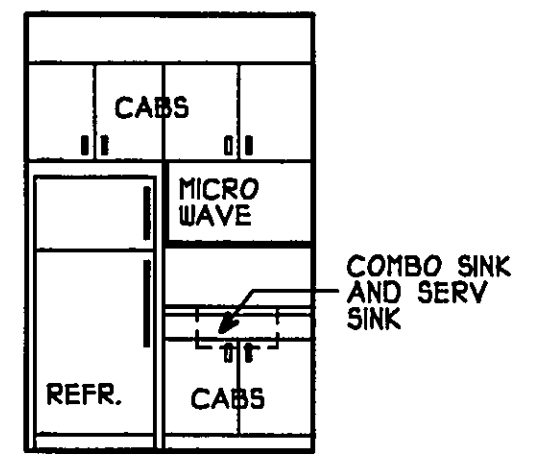

TYPICAL BREAK ROOM CAB'S


- GENERAL NOTES:**
1. ALL UNITS TO BE SEPERATED BY A 1 HOUR FIRE WALL. SEE U/L STANDARDS.
 2. ALL ELECTRICAL, MECHANICAL, PLUMBING OR OTHER PERETRATIONS OF THE FIRE WALL ARE TO BE 1 HOUR FIRE RATED AS REQUIRED.

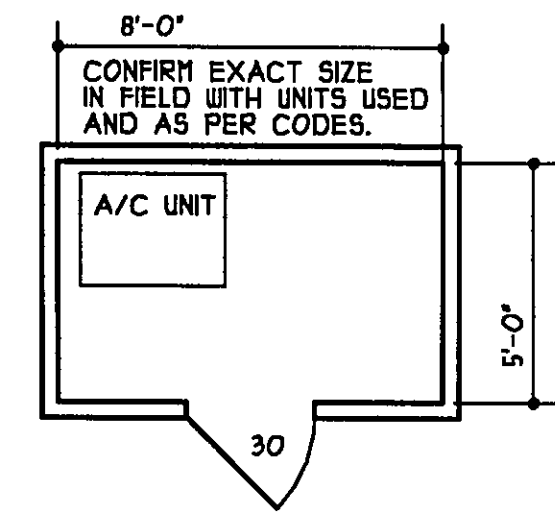

PLAN SCALE 1/4" = 1'-0"

GENERAL NOTES:


1. GENERAL CONTRACTOR TO COORDINATE EXACT SIZE, SHAPE AND LOCATION AS REQUIRED IN FIELD WITH UNITS CHOSEN.
2. DOORS PROVIDED ARE TO BE SEALED WITH WEATHER STRIPPING AS REQUIRED.
3. SINGLE DOORS OR DOUBLE DOORS MAY BE USED.
4. ALL DUCTWORK AND PIPING PENETRATIONS THRU THE WALLS ARE TO BE SEALED WITH CAULKING OR EQUAL.
5. DUCTWORK FROM AC UNIT IS NOT TO BE LAID ACROSS THE ATTIC FLOOR.

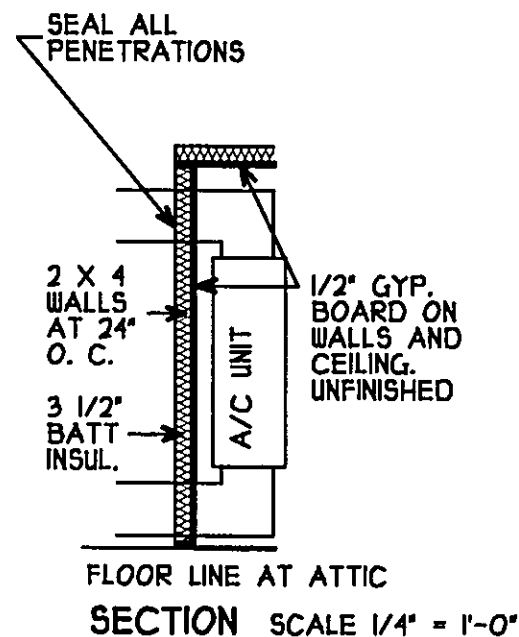

SECTION SCALE 1/4" = 1'-0"


R-19 INSULATION WALLS AND CEILING
DRYWALL SEAMS TAPED
R-30 UNDER FLOOR OF A/C CLOSET

NOTE
TOP PLATE HEIGHTS SEE ELEVS
ALL ROOF SLOPES (UNO) ARE 1/2"
SEE WIND ENGINEERING FOR ALL TIE DOWN INFORMATION

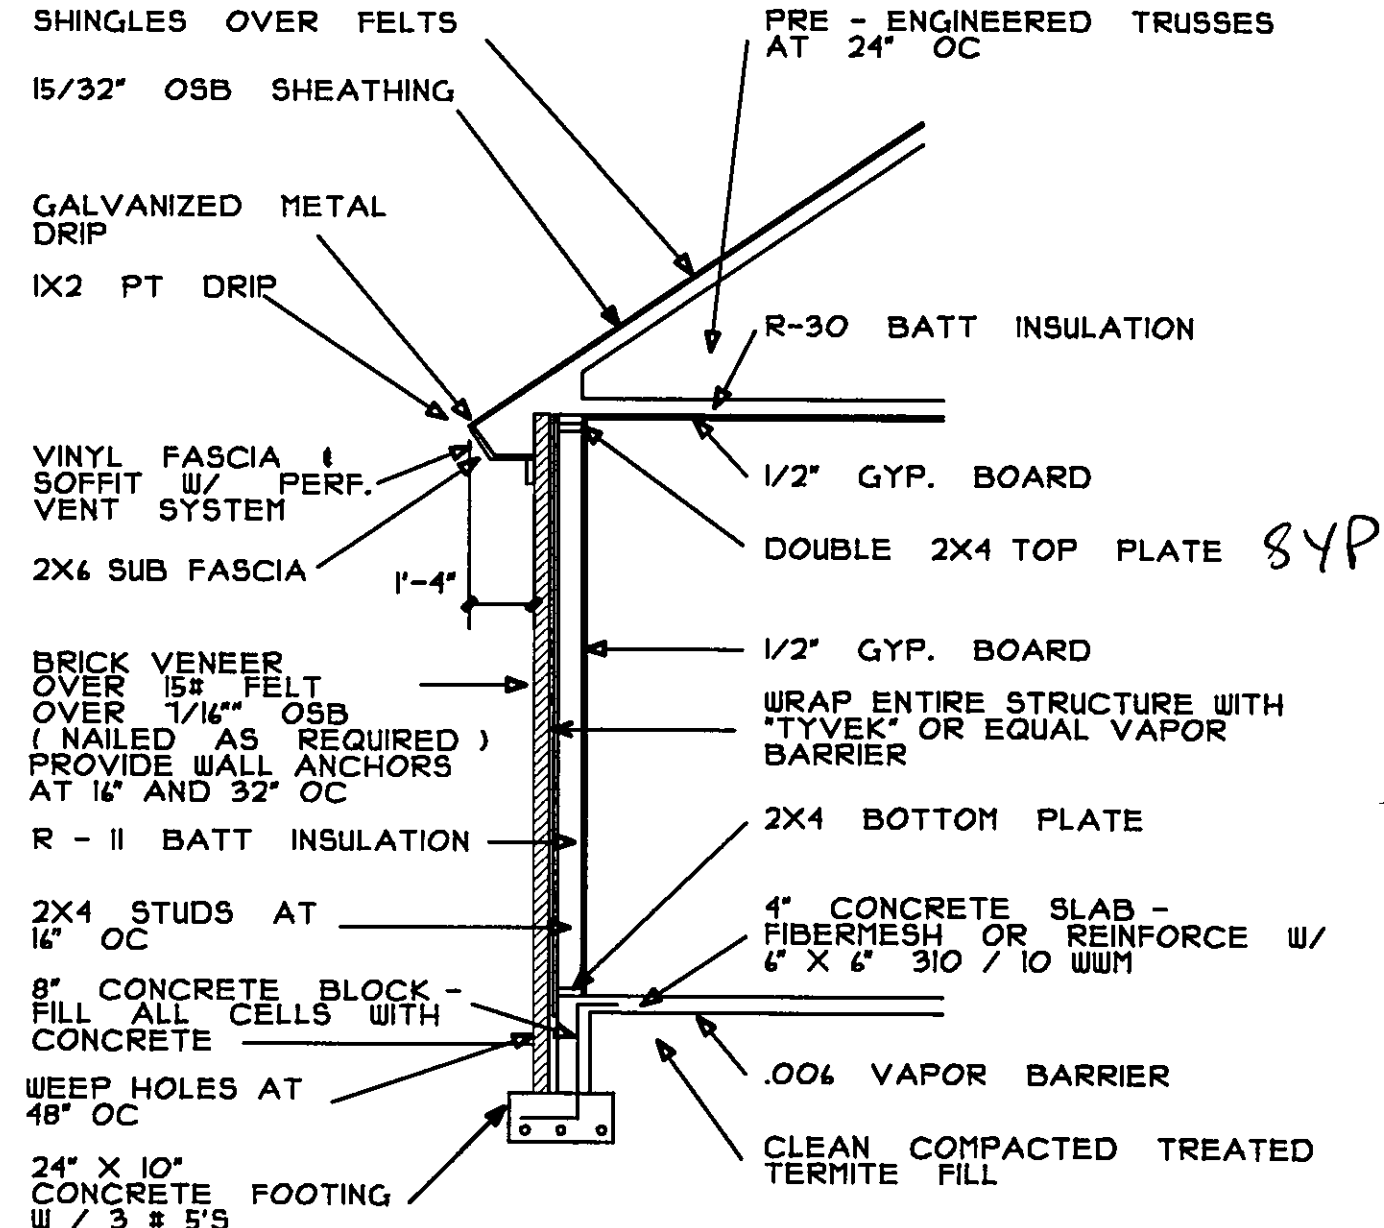


TYPICAL WALL SECTION

SEE STRUCTURAL PLANS FOR EXACT FOOTING INFORMATION, SIZES AND REINFORCING

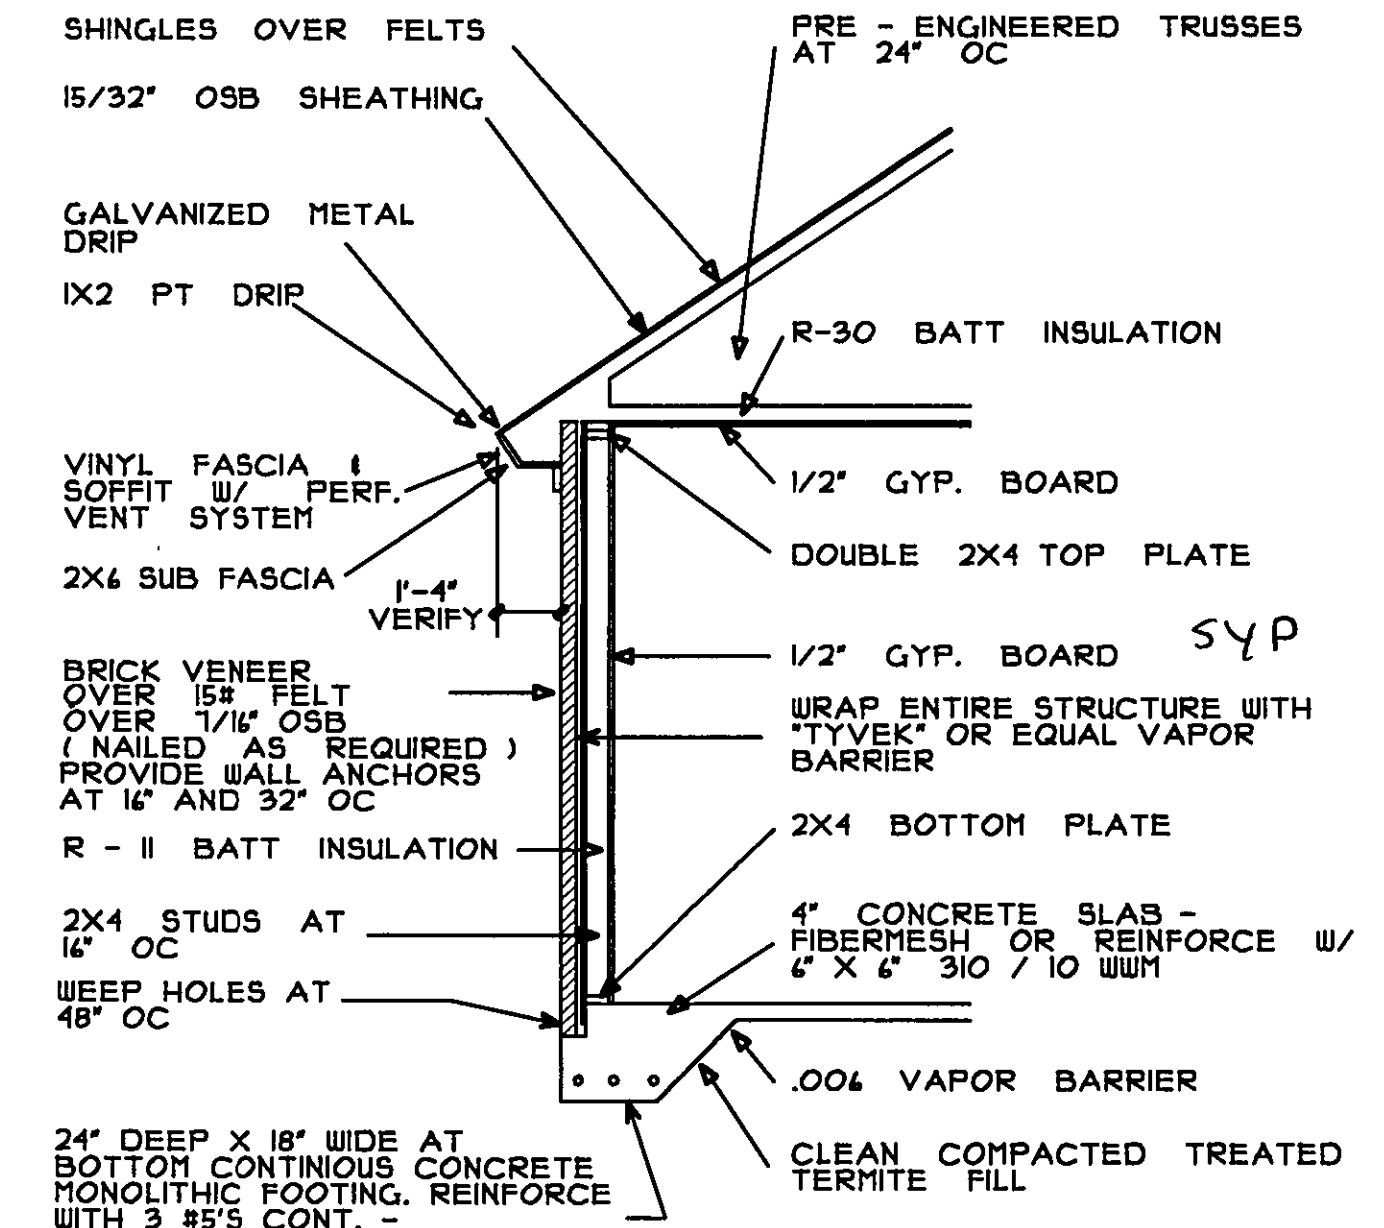

TYPICAL WALL SECTION

SEE STRUCTURAL PLANS FOR EXACT FOOTING INFORMATION, SIZES AND REINFORCING

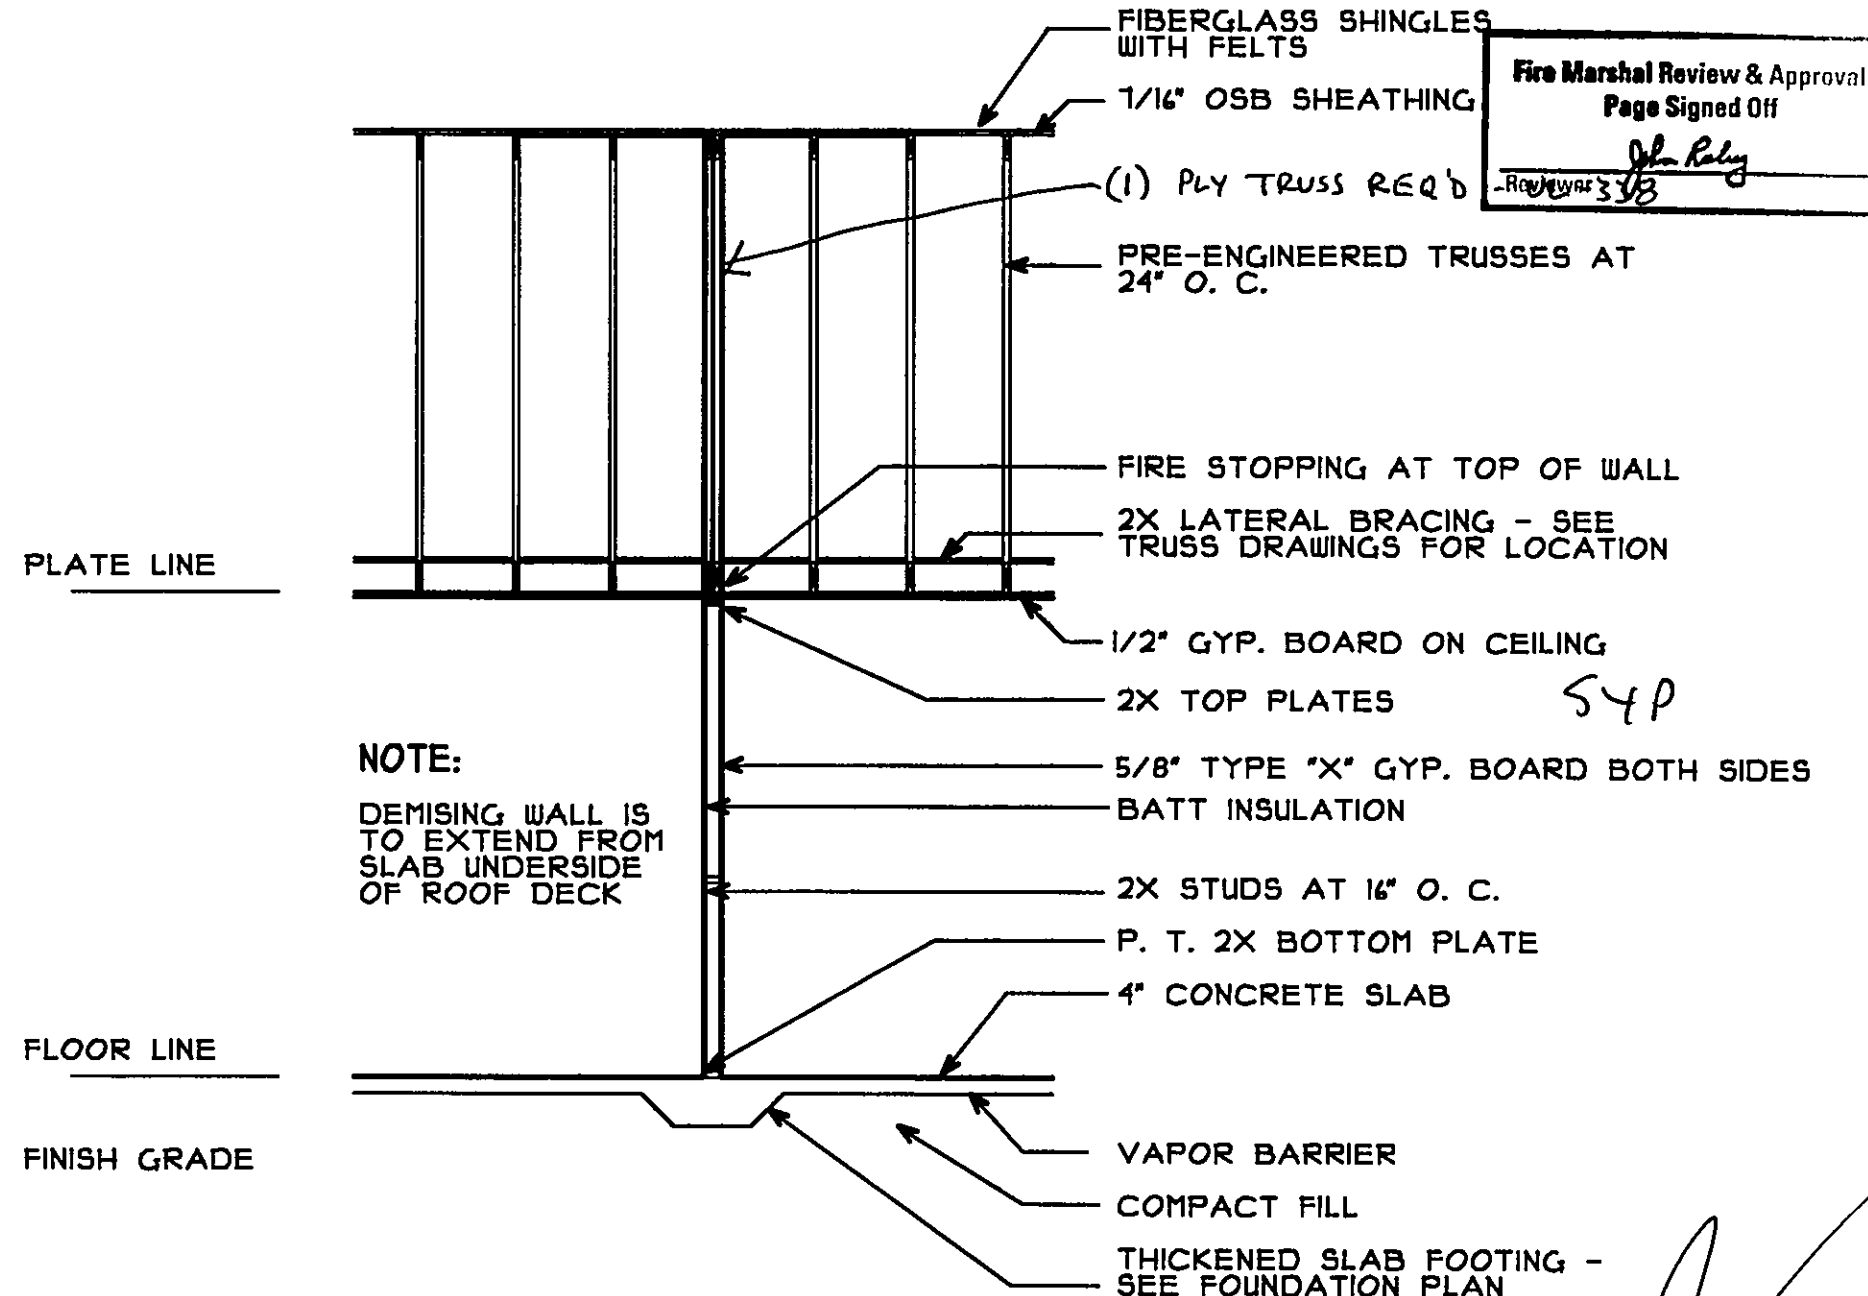

TYPICAL PARTY WALL SECTION

SEE STRUCTURAL PLANS FOR EXACT FOOTING INFORMATION, SIZES AND REINFORCING

TYPICAL MECHANICAL ENCLOSURE DETAIL

PROJECT NO. **04 06**
COPYRIGHT 2004
SCALE 1/4" = 1'-0" UNLESS NOTED OTHERWISE


SECTIONS AND DETAILS
OFFICES AT EASTPARK - BUILDING 800
JACKSONVILLE, FLORIDA

11044
NCARB
FLORIDA
ARCHITECT
ROBERT ALLEN CONNER
NCARB - ARCHITECT
11844 SAINT JOSEPHS ROAD
JACKSONVILLE, FLORIDA 32223
904 - 268 - 7822


DATE 4-4-04
DRAWN R A C
REVISED 1-12-04

SHEET **5**
OF 7


REVISED

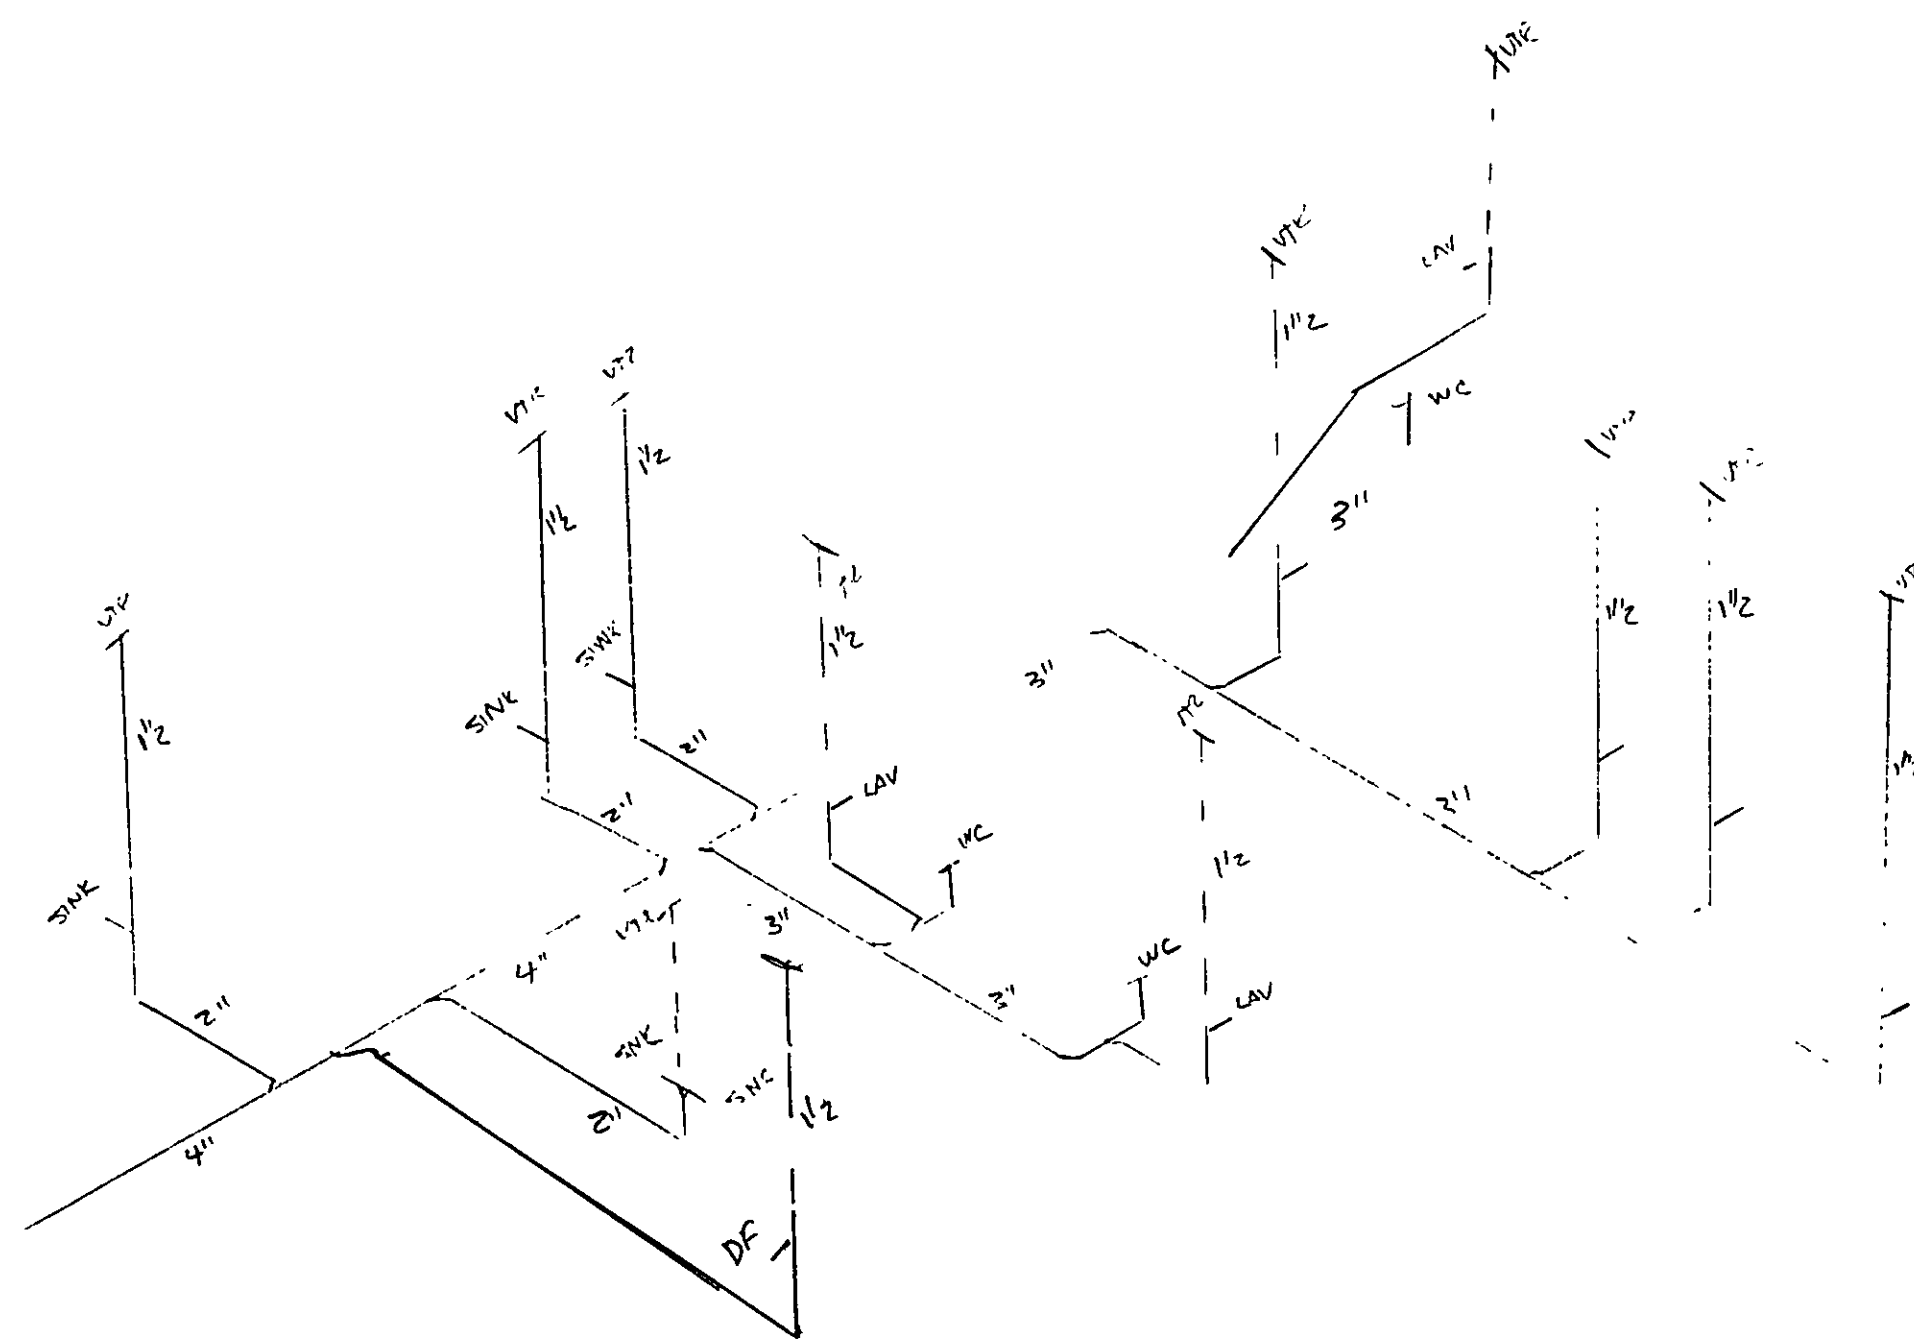

SANITARY RISER DIAGRAM 801

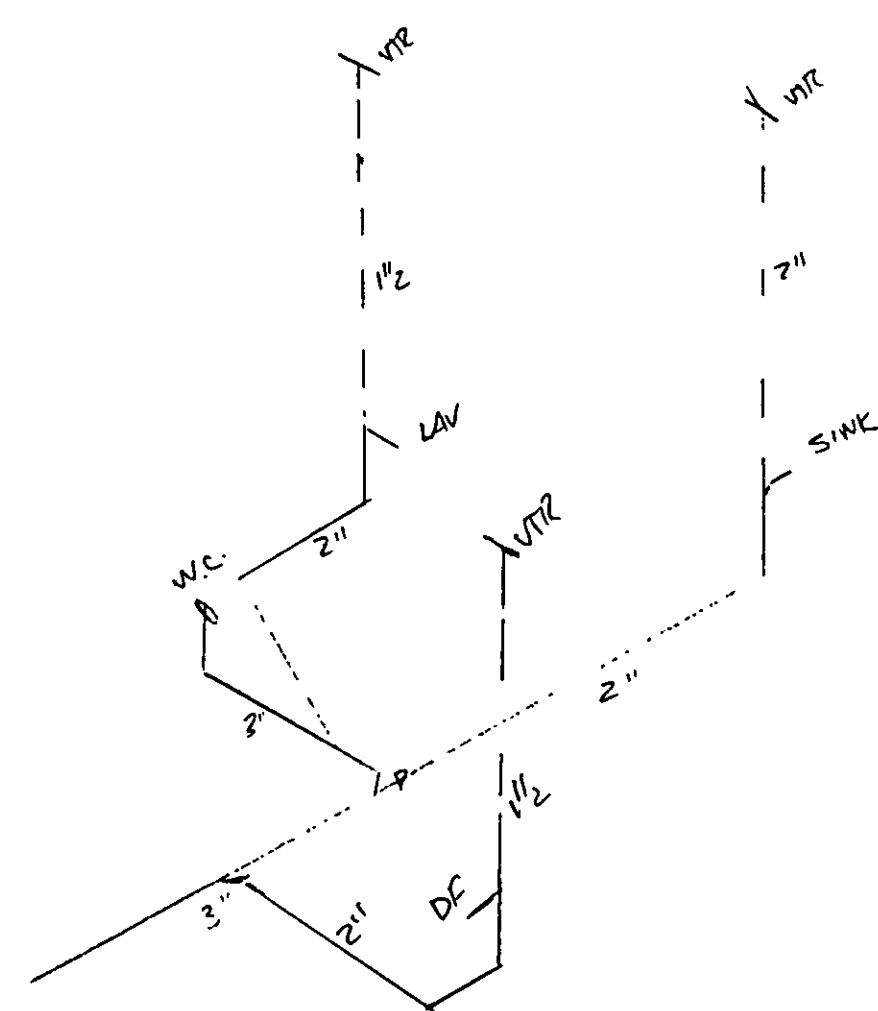


SANITARY RISER DIAGRAM 803

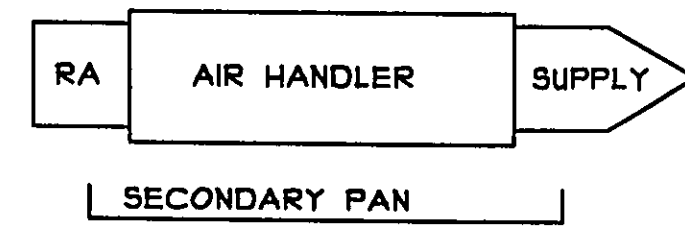

A / H DETAIL

GENERAL HVAC NOTES

1. AIR HANDLER WILL HAVE A FLOAT SWITCH IN THE DRAIN LINE.
2. SECONDARY PAN WILL HAVE A DRAIN LINE TERMINATING OUTSIDE.
3. ALL BATHROOM EXHAUST FANS WILL TERMINATE TO THE EXTERIOR OF THE BUILDING.
4. ALL OFFICES WILL HAVE INDIVIDUAL R / A TERMINATING AT MAIN R / A.
5. ALL TOILET EXHAUST FANS TO HAVE AT LEAST 50 CFM AIR MOVEMENT. EACH TOILET SHALL HAVE 1 EACH.

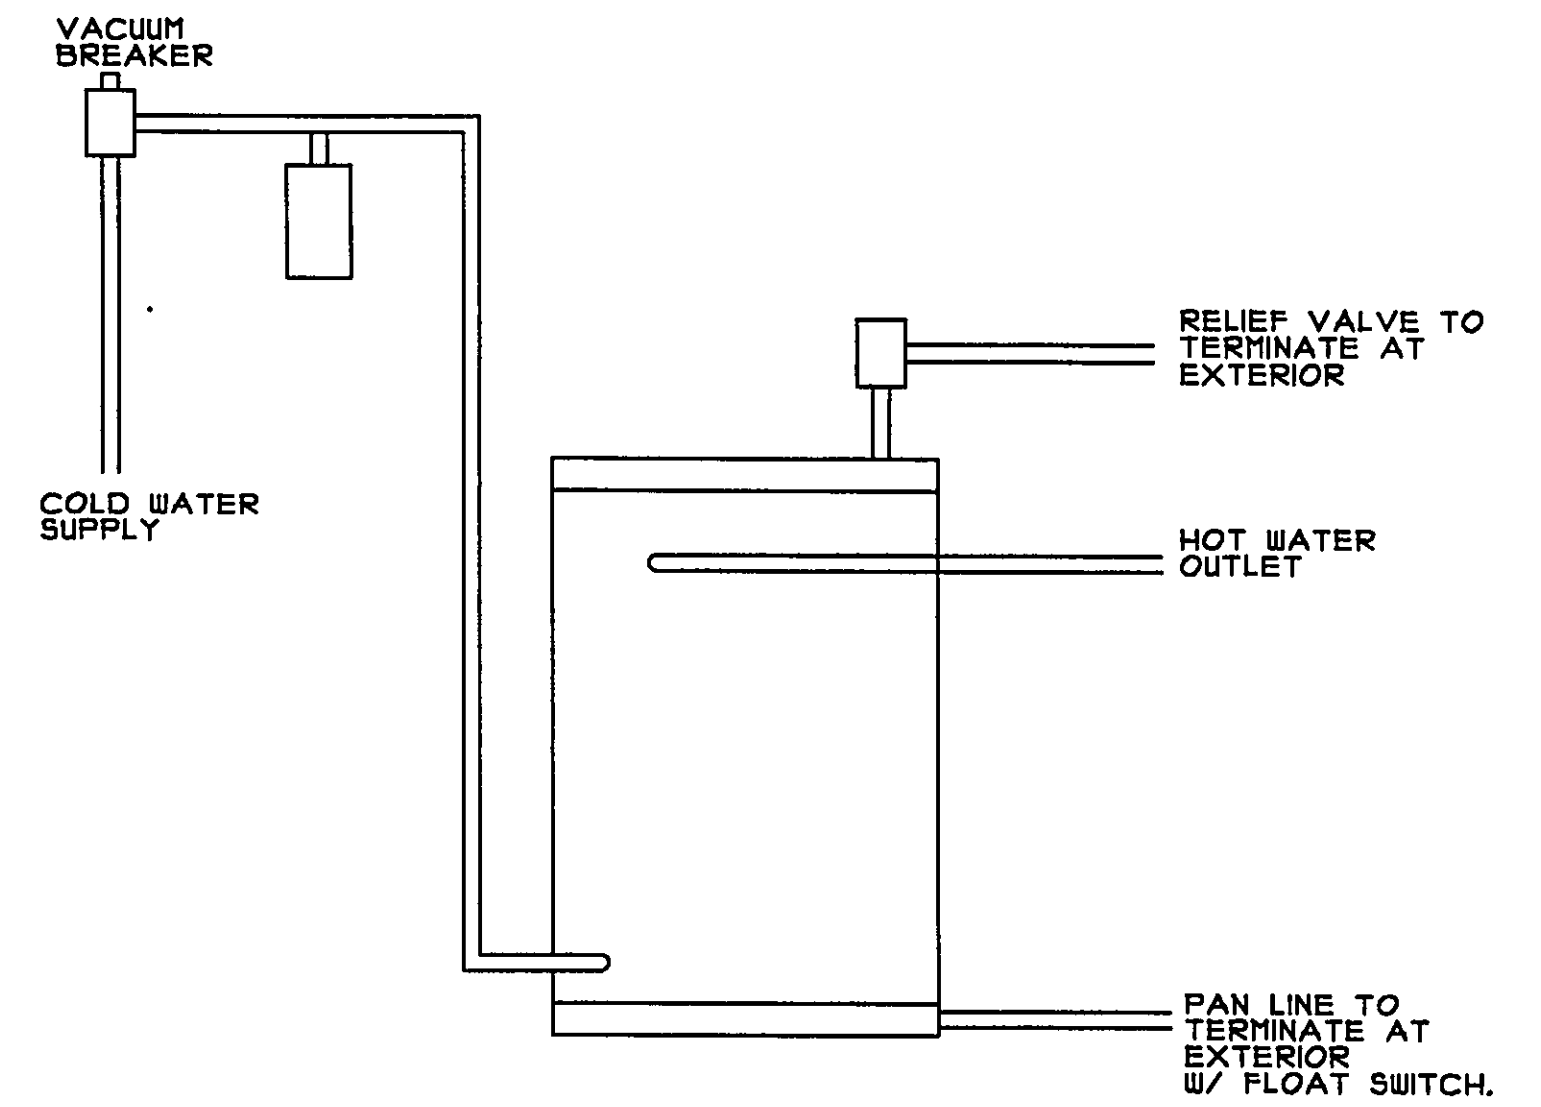


TYPICAL WATER HEATER DETAIL

NOTE: RA DUCT AND GRILL SIZES

ALL ROOM RETURN AIR DUCTS ARE 8"
VENT GRILLS ARE 10" X 10"

HALLWAY RETURN AIR DUCT IS 12"

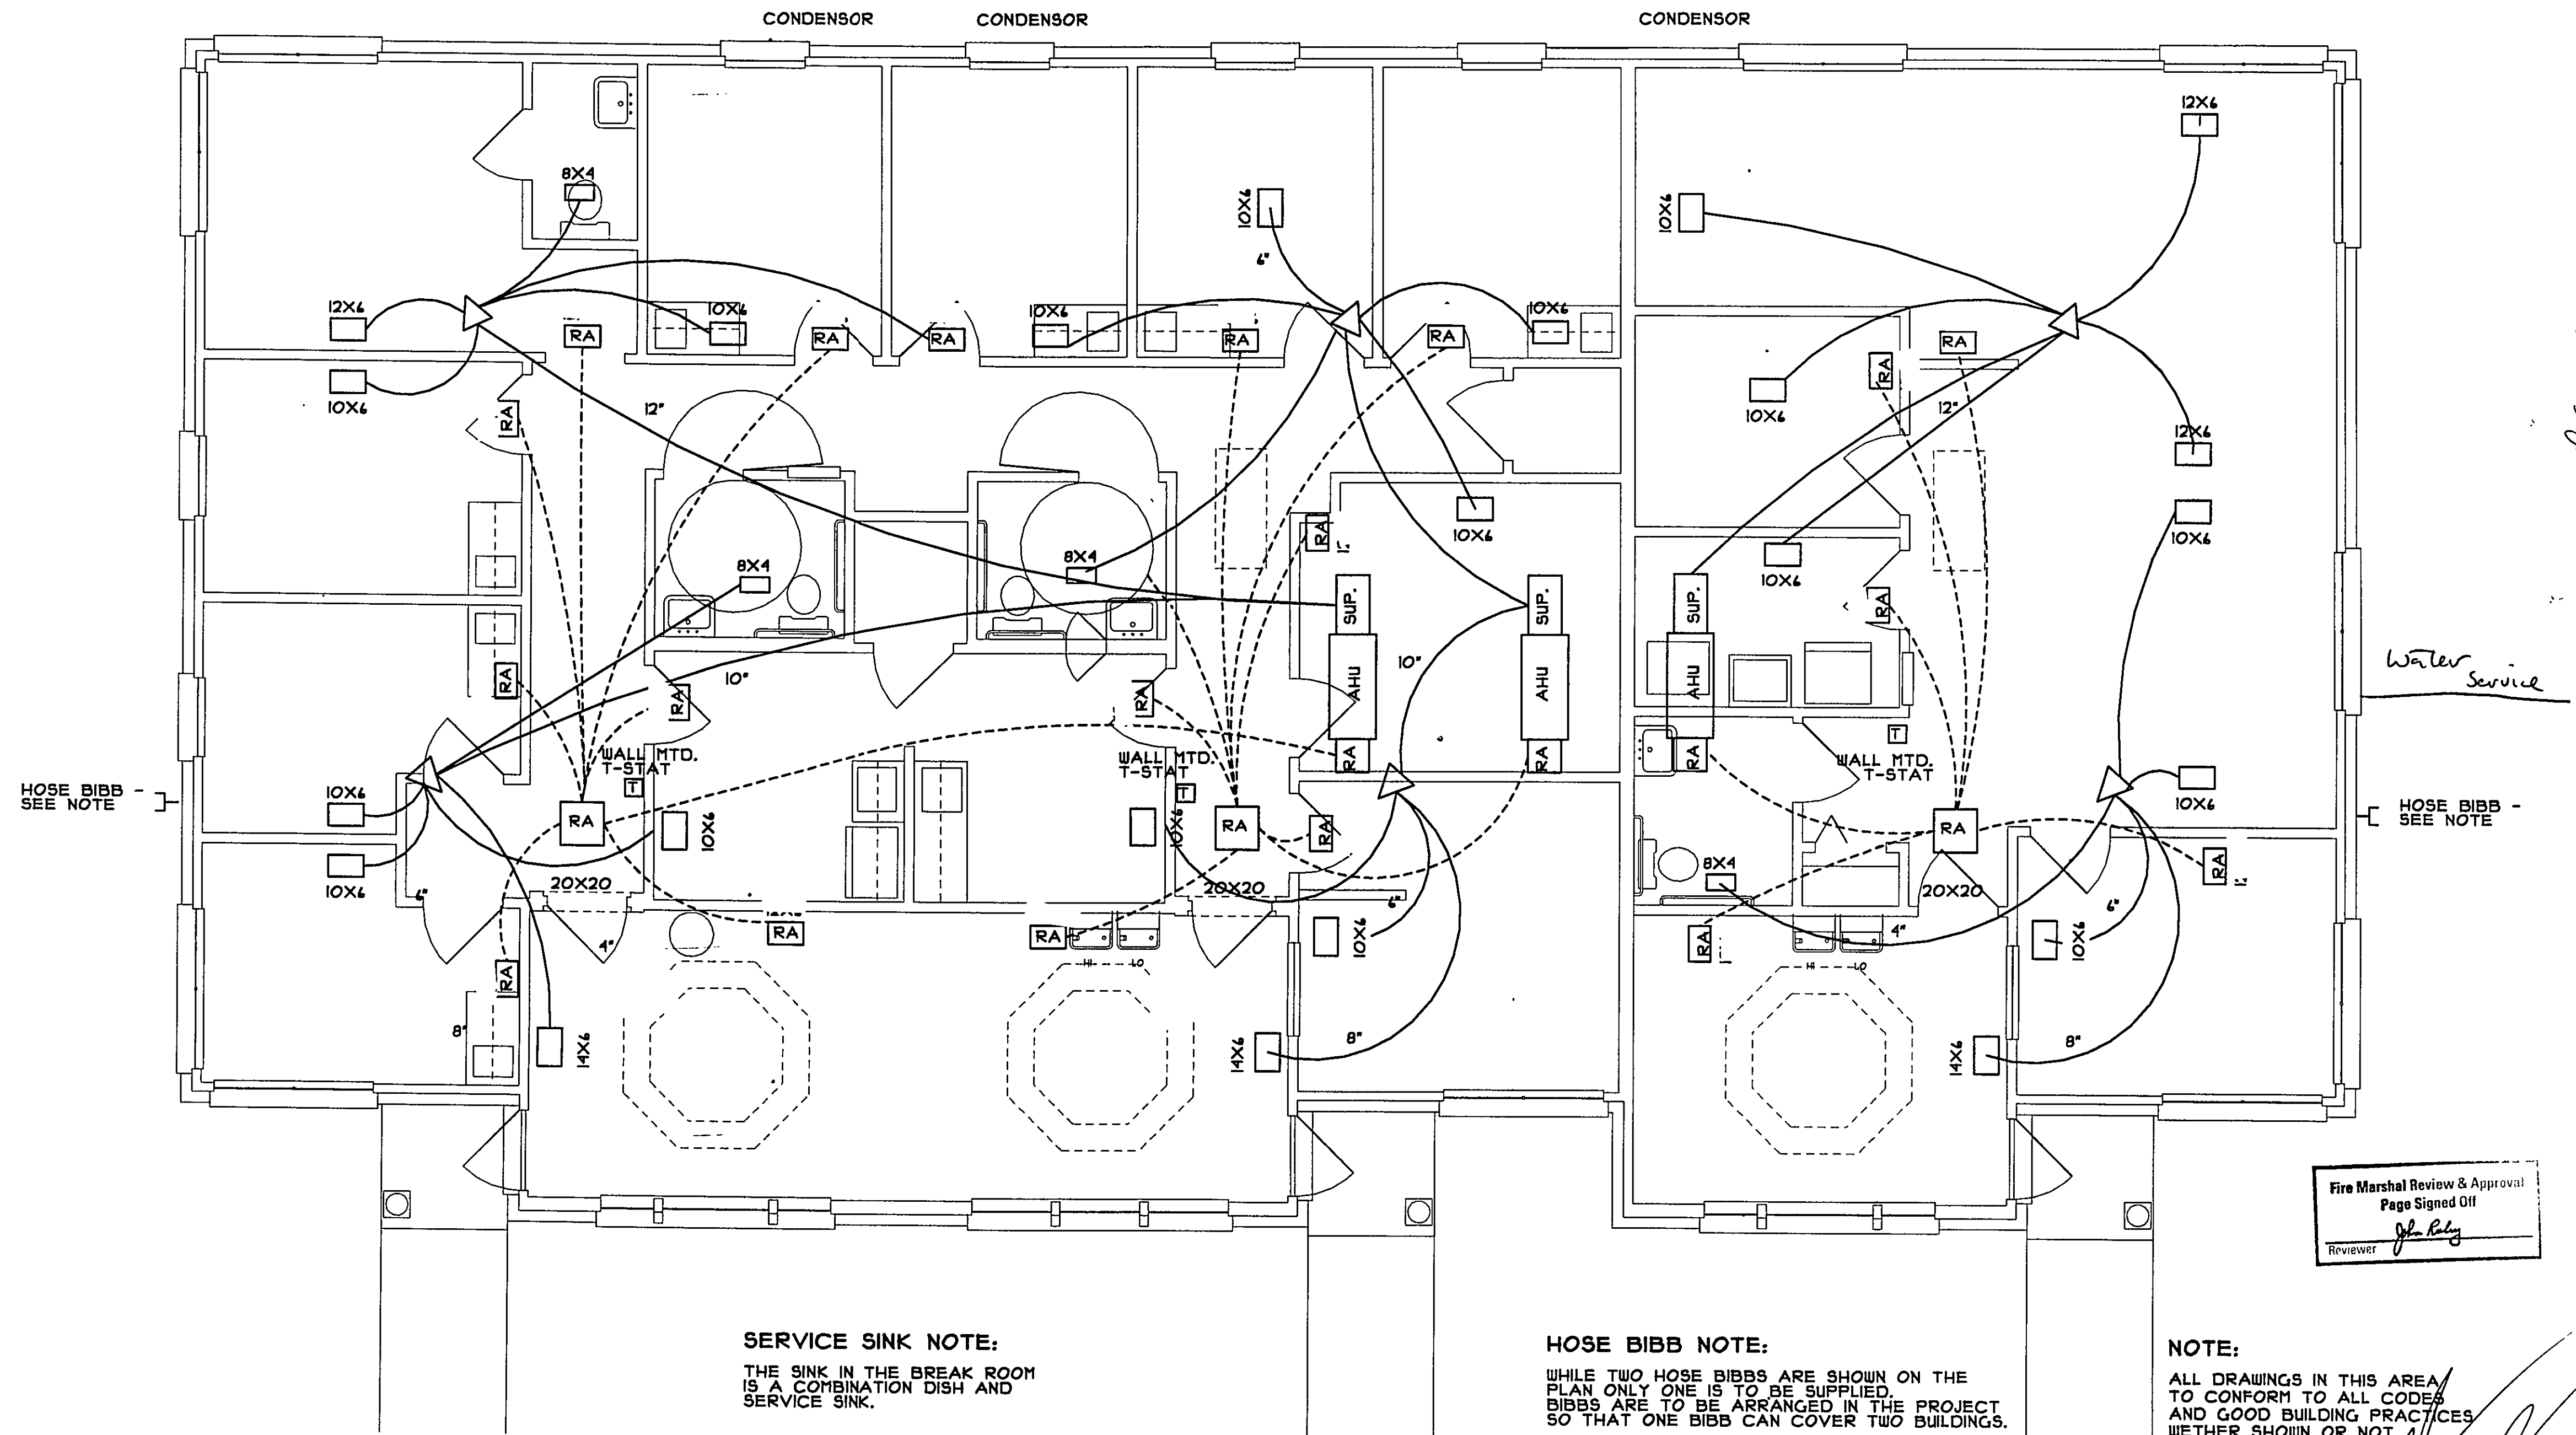

SERVICE SINK NOTE:
THE SINK IN THE BREAK ROOM IS A COMBINATION DISH AND SERVICE SINK.

HOSE BIBB NOTE:
WHILE TWO HOSE BIBBS ARE SHOWN ON THE PLAN ONLY ONE IS TO BE SUPPLIED. BIBBS ARE TO BE ARRANGED IN THE PROJECT SO THAT ONE BIBB CAN COVER TWO BUILDINGS.

NOTE:
ALL DRAWINGS IN THIS AREA TO CONFORM TO ALL CODES AND GOOD BUILDING PRACTICES WHETHER SHOWN OR NOT.

Fire Marshal Review & Approval
Page Signed Off
Reviewer *[Signature]*

MECHANICAL FLOOR PLAN

THIS MECHANICAL PLAN IS THE PROPERTY OF ROBERT ALLEN CONNER ARCHITECTS. IT IS TO BE USED ONLY FOR THE PROJECT AND SITE SPECIFICALLY IDENTIFIED HEREON. IT IS NOT TO BE REPRODUCED, COPIED, REPRODUCED, OR TRANSMITTED IN ANY FORM OR BY ANY MEANS, ELECTRONIC OR MECHANICAL, INCLUDING PHOTOCOPYING, RECORDING, OR BY ANY INFORMATION STORAGE AND RETRIEVAL SYSTEM, WITHOUT THE WRITTEN PERMISSION OF ROBERT ALLEN CONNER ARCHITECTS. ANY UNAUTHORIZED USE OF THIS MECHANICAL PLAN IS PROHIBITED AND WILL BE CONSIDERED A VIOLATION OF THE PROFESSIONAL ETHICS OF THE ARCHITECT. THE USER OF THIS MECHANICAL PLAN SHALL BE RESPONSIBLE FOR OBTAINING ALL NECESSARY PERMITS AND APPROVALS FROM THE APPROPRIATE AGENCIES. THE ARCHITECT ASSUMES NO LIABILITY FOR ANY DAMAGE, LOSS, OR INJURY, INCLUDING CONSEQUENTIAL DAMAGES, ARISING FROM THE USE OF THIS MECHANICAL PLAN. THE ARCHITECT'S LIABILITY IS LIMITED TO THE PROFESSIONAL FEES PAID TO THE ARCHITECT. THE ARCHITECT'S LIABILITY DOES NOT EXTEND TO ANY OTHER PARTY. THE ARCHITECT'S LIABILITY IS LIMITED TO THE PROFESSIONAL FEES PAID TO THE ARCHITECT. THE ARCHITECT'S LIABILITY DOES NOT EXTEND TO ANY OTHER PARTY.

11940
NORFOLK
FLORIDA
ADDRESS
ROBERT ALLEN CONNER
ARCHITECTS - ARCHITECT
116 EASTPARK ROAD
JACKSONVILLE, FLORIDA 32223
904 - 258 - 7822

DATE 4-4-04
DRAWN R A C
REVISED 7-12-04

LOAD CALCULATIONS

LOAD CALCULATION FOR 1 UNMETERED MAIN


USE OF BUILDING	OFFICE BUILDING 2 - BAYS	OFFICE BUILDING 3 - BAYS	OFFICE BUILDING 4 - BAYS
SERVICE BUILDING SQ. FT.	UNDERGROUND 2252 S. F.	UNDERGROUND 3578 S. F.	UNDERGROUND 4504 S. F.
LIGHTING LOAD	X 2252 = 1882	X 3378 = 723	X 4504 = 1514
OTHER OUTLETS	X 40 = 1600	X 90 = 1620	X 120 = 2400
WATER HEATERS	X 2 = 3000	X 3 = 4500	X 4 = 4000
SIGN CIRCUITS	X 2 = 2400	X 3 = 3600	X 4 = 4800
HEAT - 5KW - 1 PH.	X 2 = 10000	X 3 = 15000	X 4 = 20000
A/C - 2 HP - 1 PH.	X 2 = 9400	X 3 = 14100	X 4 = 19200
TOTAL VA	43482	65233	81344
VOLTAGE 240, 1 PH. - TOTAL AMPS	182	273	341
WIRE SIZE			

LOAD CALCULATION FOR 1 TENANT SPACE SEE SHEET 1 FOR UNIT S. F. TO BE FOLLOWED

USE OF BUILDING	OFFICE BUILDING UNDERGROUND 124 S. F.	OFFICE BUILDING UNDERGROUND 2252 S. F.	OFFICE BUILDING UNDERGROUND 3378 S. F.
LIGHTING LOAD - 3.5 VA	X 124 = 394	X 2252 = 7882	X 3378 = 723
OTHER OUTLETS - 180 VA	X 30 = 5400	X 90 = 1620	X 120 = 1400
WATER HEATERS - 100%	X 1 = 1500	X 3 = 3000	X 3 = 4500
SIGN CIRCUITS - 1220 VA	X 1 = 1220	X 3 = 2400	X 3 = 3600
HEAT - 5KW - 1 PH.	X 1 = 5000	X 2 = 10000	X 3 = 15000
A/C - 2 HP - 1 PH.	X 1 = 4800	X 2 = 9400	X 3 = 14100
TOTAL VA	21841	43482	65233
VOLTAGE 240, 1 PH. - TOTAL AMPS	91	182	273
WIRE SIZE			

WATER HEATER

THE ELECTRIC WATER HEATER SHALL HAVE A CODE APPROVED DISCONNECT SWITCH.

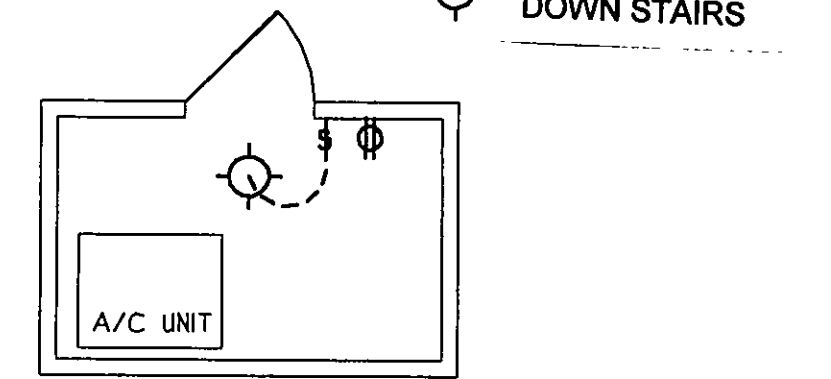

TYPICAL MECH. CLOSET ELECTRICAL PLAN

ALL UNITS SIMILAR - SITE VERIFY LOCATION


ELECTRICAL SYMBOLS

NOT ALL SYMBOLS MAY BE USED


	INCANDESCENT LIGHT FIXTURE		CONVENIENCE OUTLET - 110 VOLT
	CEILING FAN WITH LIGHT		CONVENIENCE OUTLET - 110 VOLT - 4 PLEX
	EXTERIOR SPOT LIGHT		CONVENIENCE OUTLET - WEATHER PROOF
	RECESSED CAN LIGHT - FIELD VERIFY ALL CONDITIONS AND APPLICABLE LOCATIONS.		CONVENIENCE OUTLET - 220 VOLT
	FLUORESCENT LIGHT FIXTURE - SURFACE		CONVENIENCE OUTLET - MICRO WAVE - 6" HT.
	EXIT LIGHT FIXTURE - WITH ARROWS AS REQUIRED		WALL SWITCH
	EMERGENCY LIGHT - WALL MOUNTED		WALL SWITCH - 3 WAY
	SMOKE DETECTOR - WALL OR CEILING MOUNTED		ELECTRIC SWITCH WIRE
	EXHAUST FAN		SPECIAL ELECTRICAL CONNECTION
	A/C CONDENSER WITH DISCONNECT		TELEVISION OR CABLE OUTLET
	A/C HANDLER WITH DISCONNECT		TELEPHONE OUTLET
	DOOR BELL		COMPUTER DEDICATED OUTLET
	DOOR BELL BUTTON		JUNCTION BOX FOR ELECTRICAL CONNECTION
	TEL. AND CABLE CONDUIT STUB UP		CONDUIT STUB UP

ELECTRICAL NOTE:

SEE ATTACHED CIRCUITING PLAN AND CALCULATIONS SUPPLIED BY A LICENSED ELECTRICAL CONTRACTOR FOR ADDITIONAL INFORMATION.

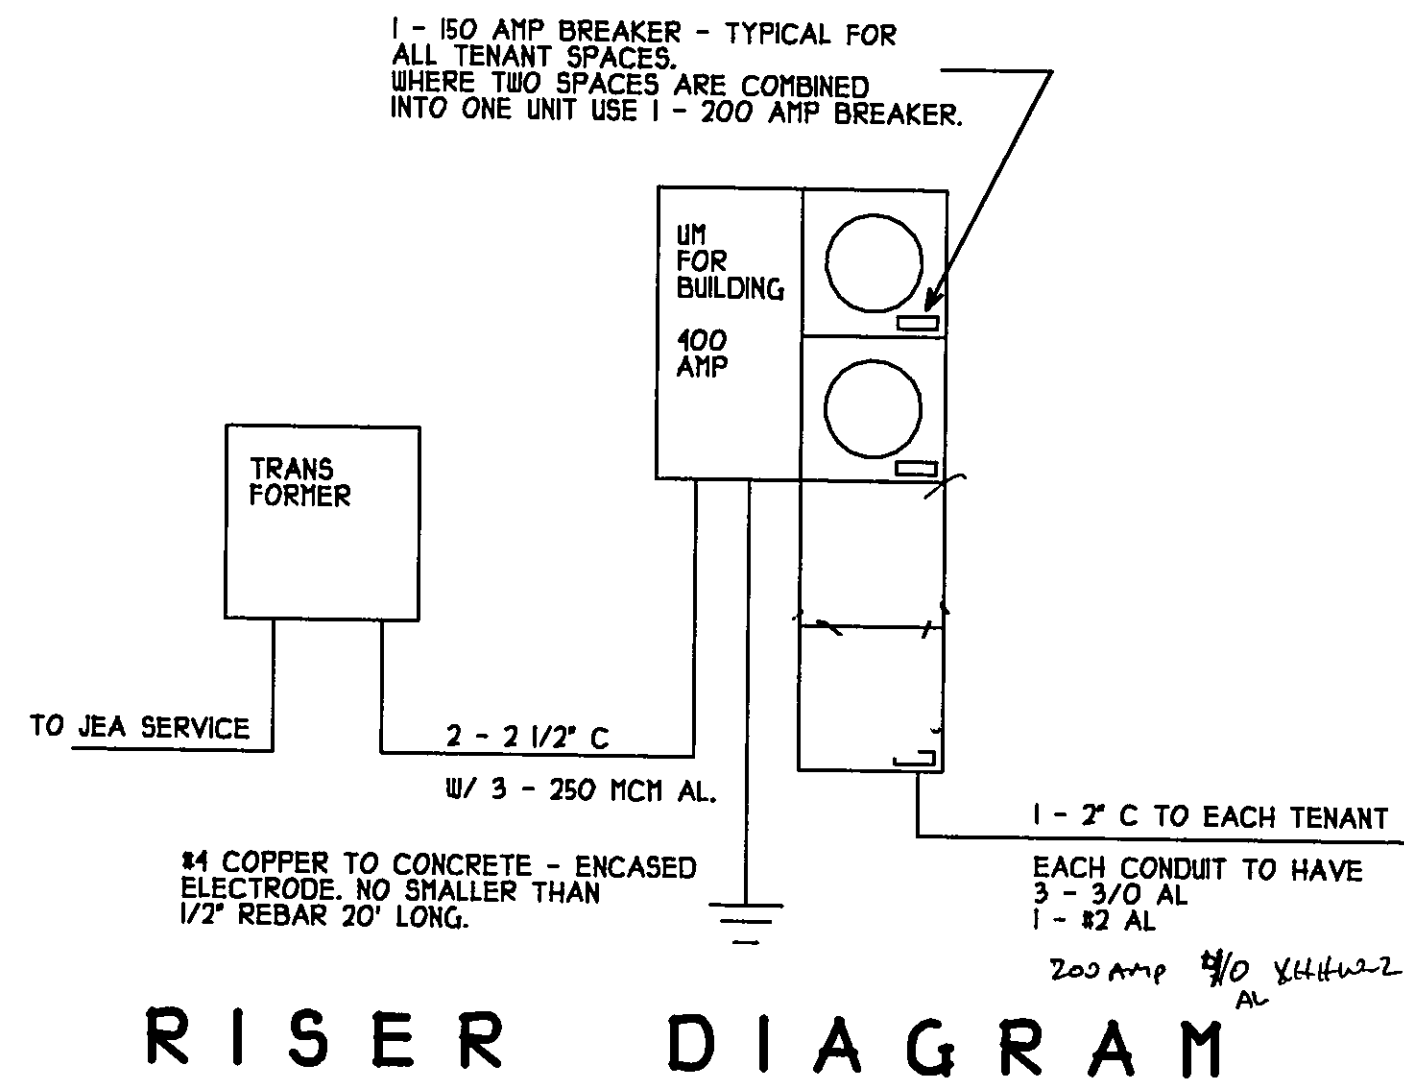

RISER DIAGRAM

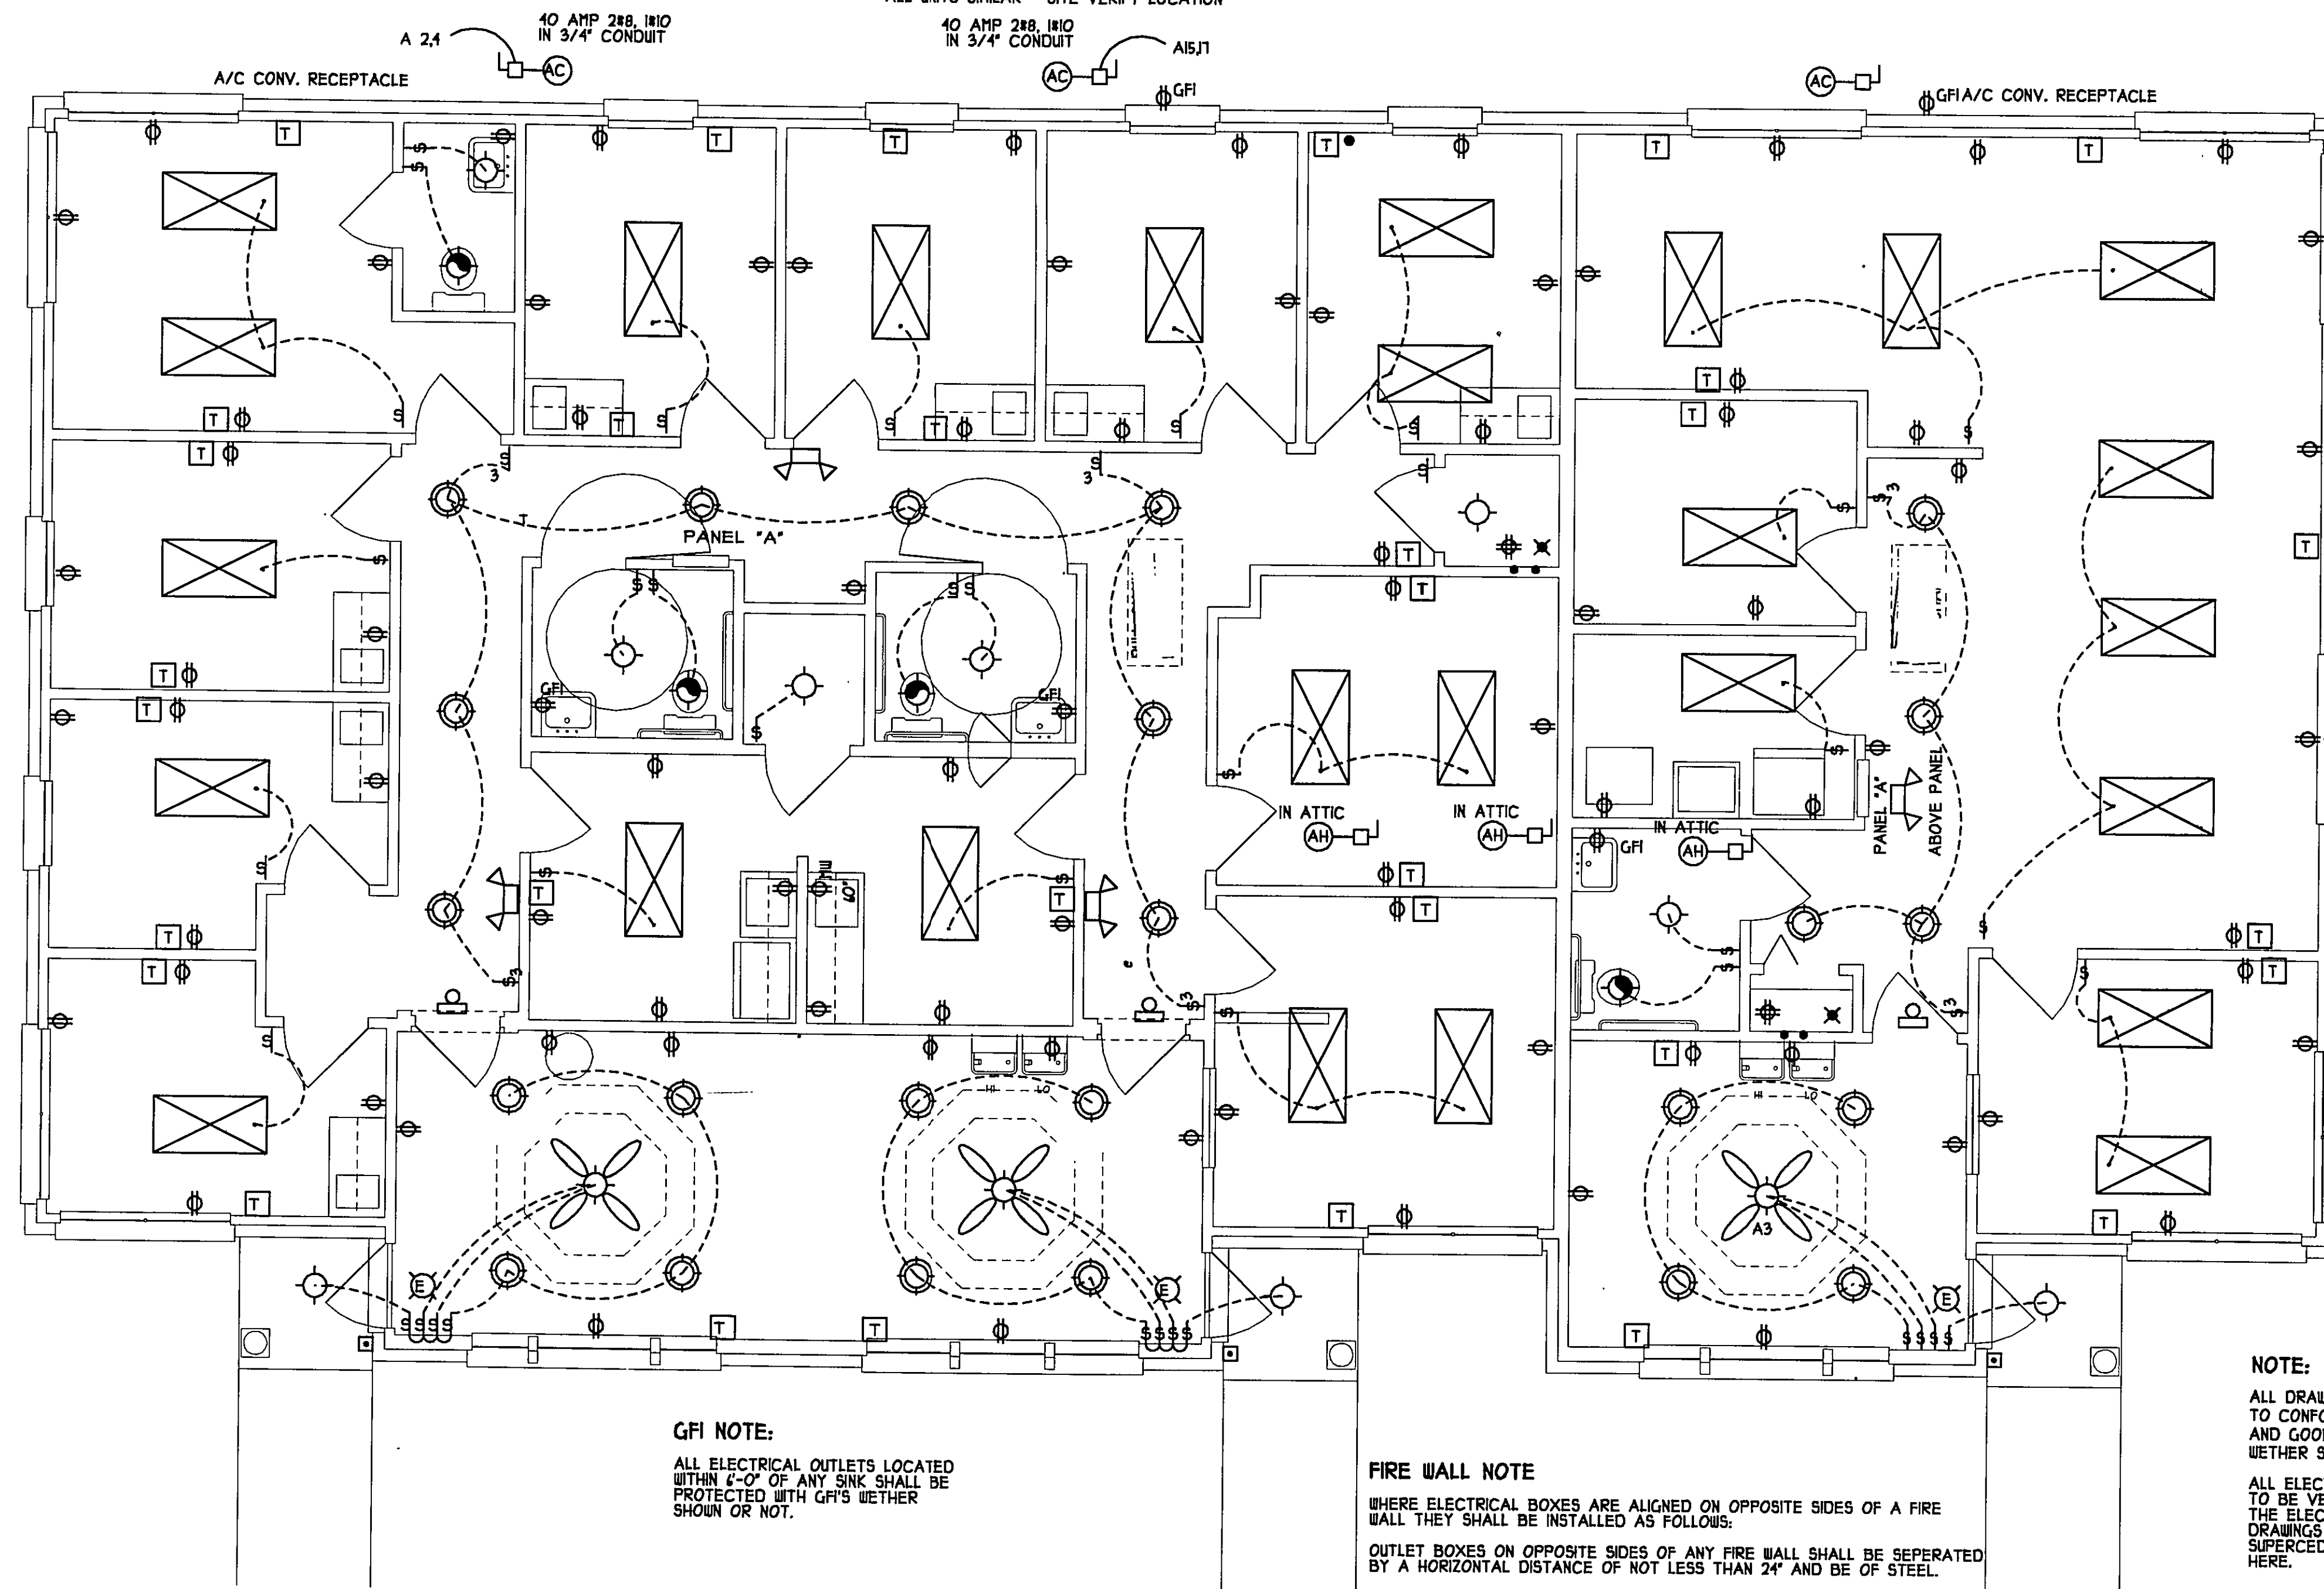

GFI NOTE:
ALL ELECTRICAL OUTLETS LOCATED WITHIN 6'-0" OF ANY SINK SHALL BE PROTECTED WITH GFIS WHETHER SHOWN OR NOT.

FIRE WALL NOTE
WHERE ELECTRICAL BOXES ARE ALIGNED ON OPPOSITE SIDES OF A FIRE WALL THEY SHALL BE INSTALLED AS FOLLOWS:
OUTLET BOXES ON OPPOSITE SIDES OF ANY FIRE WALL SHALL BE SEPARATED BY A HORIZONTAL DISTANCE OF NOT LESS THAN 24" AND BE OF STEEL.

NOTE:
ALL DRAWINGS IN THIS AREA TO CONFORM TO ALL CODES AND GOOD BUILDING PRACTICES WHETHER SHOWN OR NOT.

ALL ELECTRICAL WORK IS TO BE VERIFIED WITH THE ELECTRICAL ENGINEERS DRAWINGS AND THEY SHALL SUPERCEDE ANYTHING SHOWN HERE.

PROJECT NO.
04 06
COPYRIGHT
2004

SCALE
1/4" = 1' - 0"
UNLESS NOTED OTHERWISE


ALSO SEE EVERY SYMBOL IN THE ELECTRICAL SYMBOLS LIST FOR THE MECHANICAL AND ELECTRICAL SYMBOLS LIST. THE MECHANICAL SYMBOLS LIST IS LOCATED ON SHEET 1 OF THIS DRAWING. THE ELECTRICAL SYMBOLS LIST IS LOCATED ON SHEET 2 OF THIS DRAWING. THE ELECTRICAL SYMBOLS LIST IS LOCATED ON SHEET 3 OF THIS DRAWING. THE ELECTRICAL SYMBOLS LIST IS LOCATED ON SHEET 4 OF THIS DRAWING. THE ELECTRICAL SYMBOLS LIST IS LOCATED ON SHEET 5 OF THIS DRAWING. THE ELECTRICAL SYMBOLS LIST IS LOCATED ON SHEET 6 OF THIS DRAWING. THE ELECTRICAL SYMBOLS LIST IS LOCATED ON SHEET 7 OF THIS DRAWING. THE ELECTRICAL SYMBOLS LIST IS LOCATED ON SHEET 8 OF THIS DRAWING. THE ELECTRICAL SYMBOLS LIST IS LOCATED ON SHEET 9 OF THIS DRAWING. THE ELECTRICAL SYMBOLS LIST IS LOCATED ON SHEET 10 OF THIS DRAWING.

ELECTRICAL PLAN
OFFICES AT EASTPARK - BUILDING 800
JACKSONVILLE, FLORIDA

11840
FLORIDA ARCHITECT
ROBERT ALLEN CONNER
ARCHITECT
11844 SAINT JOSEPHS ROAD
JACKSONVILLE, FLORIDA 32223
904 - 268 - 7822

DATE 4-4-04
DRAWN R A C
REVISED 7-12-04

SHEET
7
OF 7

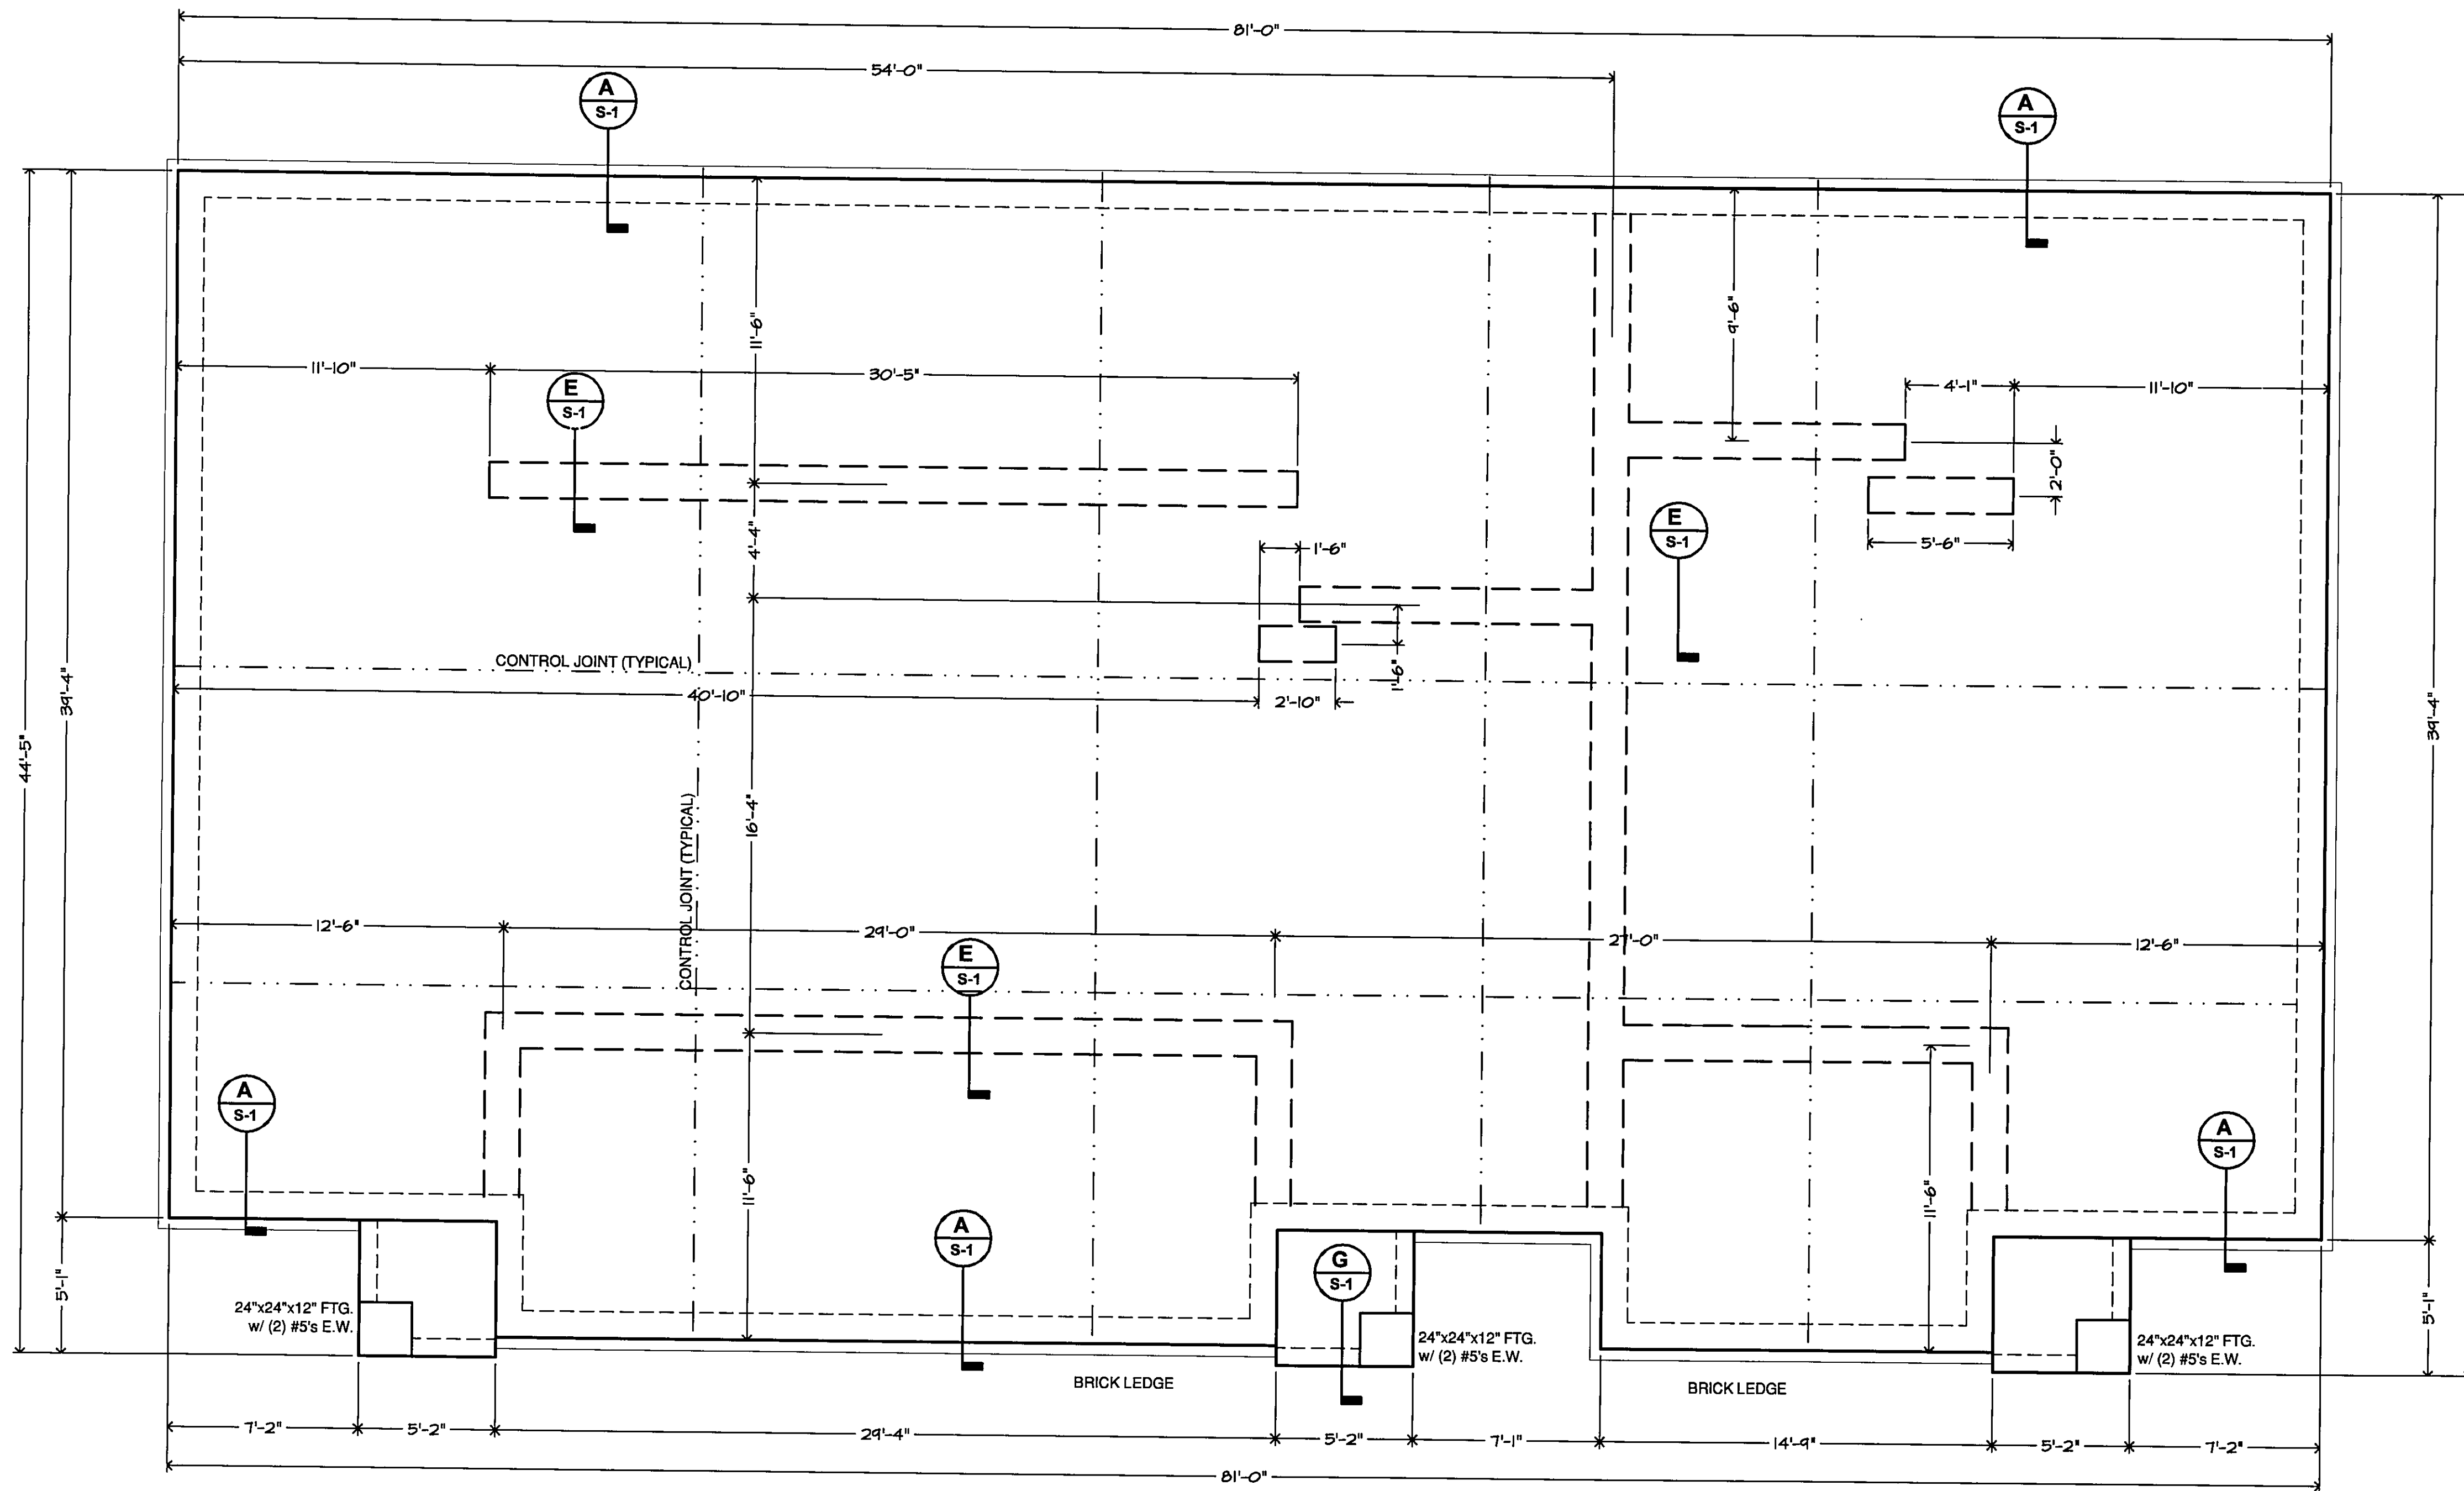

NOTE: FOUNDATION DIMENSIONS ARE TO OUTER FACE OF FRAMED WALLS. (NOT BRICK FACE)

NOTICE TO ALL CONTRACTORS
 REVIEW & APPROVAL BY THE AUTHORITY HAVING JURISDICTION SHALL NOT RELIEVE THE APPLICANT OF THE RESPONSIBILITY OF COMPLIANCE WITH THE FIRE CODE.
 REVIEWED BY: John Raley, Plans Examiner, 30883 ST. JOHNS COUNTY FIRE RESCUE

SCALE:
 1/4" = 1'-0"
 • U.O.N.
 • DO NOT SCALE THIS DRAWING

RELEASE DATE:

04-19-04

REVISION DATE:

00-00-00

DRAWN BY:

DJM II

CHECKED BY:

JKH

SHEET:

Fdn.1

HULSBURG ENGINEERING, INC.

(FL. CERT. #: 25846)
 2955 HARTLEY RD., SUITE 202
 JACKSONVILLE, FL 32257
 Ph. (904) 886-2401 Fax (904) 260-4367
 FLOYD S. SIMPSON, P.E.
 (FL. P.E. No. 50791)

DESCRIPTION:
FOUNDATION PLAN

JOB:
**LANDMARK HOMES (THREE UNIT - TWO TENANTS)
 BUILDING 800 (SOUTH LAKE OFFICE CENTER)**

GENERAL DESIGN CRITERIA:

Codes:

2001 Florida Building Code, ASCE 7-98, ACI, ATIC, NDS, AWP, APA, (Latest addition U.O.N).

GENERAL NOTES:

1. It is the intent of the Engineer of Record that this work be in conformance with all requirements of the authorities having jurisdiction over this type of construction and occupancy. All contractors are responsible for the means and methods of constructing and shall do their work in conformance with all applicable codes and regulations.
2. The contractor shall verify all conditions and dimensions at the job site prior to commencing work.
3. Contractor shall supply, locate and build into the work all inserts, anchors, angles, plates, openings, sleeves, hangers, slab depressions, and pitches as may be required to attach and accommodate other work.
4. These documents, as instruments of service are the property of the Engineer of Record and may not be used or reproduced without expressed written consent of the Engineer of Record.
5. All details and sections shown on the drawings are intended to be typical and shall be construed to apply to any similar situation elsewhere in the work except where a different detail is shown.
6. The owner will provide contractor with a soil's investigation report and analysis. All requirements for site preparation and soil compacting specified in the soil report shall be followed unless additional more stringent requirements are specified. Notify Engineer of Record if foundation conditions encountered differ from soil exploration information made available to the contractor.
7. It is the contractor's sole responsibility to determine erection procedure and sequence to insure the safety of the building and its component parts during erection.
8. Temporary bracing:
Contractors shall be responsible for all temporary bracing that is required during construction to keep structure safe and plumb until the entire structure is in place. Bracing shown on structural drawings is for the completed structure only.
9. Where subsurface soil condition information is not available, foundations have been designed for a 2000 psf soil bearing capacity. Contractor shall report any differing conditions to the Engineer of Record prior to commencing work.

CONSTRUCTION NOTES:

CONCRETE:

1. All concrete shall have the following minimum compressive strength at 28 days:
slab on grade, _____ f_c=2500psi
footings and remaining concrete
2. All concrete slabs on grade shall be the thickness as indicated on the drawings over minimum 6 mil. polyethylene (visqueen) vapor barrier. Such slabs shall be reinforced with 6x6 W1.4 x 1.4 WWM lapped 8" at edges and ends in conformance with ASTM-A 185, or Fiber mesh Reinforcement shall be used with minimum 2" fiber length at 1LB/CY complying with ASTM C 1116.
3. Fill under concrete slabs shall be clean sand free of debris and other deleterious material. Fill shall be compacted to a density of at least 95% of Modified Proctor Maximum Dry Density (ASTM D1557). Fill shall be treated with termite poison before slab is placed.
4. Footings shall bear upon undisturbed soil or upon soil compacted to a density of at 95 % of Modified Proctor Maximum Dry Density (ASTM D1557) for a depth of at least two feet. (2') below the bottom of the footing.
5. Where shown, cores of block masonry shall be filled with coarse grout or pea gravel concrete with minimum compressive strength of 2500 psi at 28 days.
6. Reinforcing steel shall be ASTM A615 Grade 40 deformed new billet steel conforming to ACI301, ACI315, ACI318 and CRSI Manual of Standard Practice, (latest editions).
7. All continuous vertical and horizontal reinforcing steel in footings, beams and columns shall be lap spliced a minimum of 36 bar diameters or 24", whichever is greater.
8. The following minimum concrete cover shall be provided for reinforcement:
3"-----Concrete cast against and permanently exposed to earth.
2"-----Concrete exposed to earth or weather, #6 Bar and larger.
1 1/2"-----Concrete exposed to earth or weather, #5 Bar and smaller.
1 1/2"-----Concrete not exposed to weather or in contact with earth for the primary reinforcement, ties, stirrups, and spirals in beams and columns.
9. Horizontal beam and footing bars shall be bent 25" around corners or corner bars with a minimum 25" lap. (U.O.N.)
10. Contractor shall provide spacers, chains, bolster, etc., necessary to support reinforcing steel. Support items which bear on exposed concrete surfaces shall have ends which are plastic tipped or stainless steel.
11. All reinforcing details shall conform to Manual of Standard Practice for detailing reinforced concrete structures ACI 315 (latest edition), unless detailed otherwise on the structural drawings.
12. All concrete work shall be in accordance with "The Building Code Requirements for Structural Concrete", ACI 318 (latest edition), and "Specifications for Structural Concrete for Buildings" ACI 301 (latest edition).

ROOFING:

1. Roofing shall comply with 2001 FBC Chapter 15.
2. Asphalt shingles shall be designed for the applicable wind zone of the structure.
3. Follow the manufacturer's attachment schedule for the wind zone of the structure.
4. Asphalt shingles shall comply with ASTM D 3161.

MASONRY:

1. All masonry work shall be in accordance with ACI 530 / ASCE 5/ TMS 402 Masonry Building Code.
2. Concrete masonry units shall be ASTM C90-75, Hollow Load-Bearing Concrete Masonry Units, Type 1, Grade N-1, normal weight, with a minimum compressive strength of 2000 psi (f_m=1500psi).
3. Mortar shall conform to ASTM C270 and be of Type S.
4. Grout when specified. shall conform to ASTM C 476 with minimum 28 day compressive strength of 2000psi. Grout shall be mixed to provide a slump between 8" to 11".
5. Provide pre cast concrete lintels over all openings unless noted otherwise on drawings. Lintels shall be of sufficient size and reinforcement for the given span loading conditions.

FRAMING:

1. Chapter 23 of the 2001 FBC building code shall be used for all wood framing, except as modified by the plans and specifications.
2. All wood framing shall be fabricated and installed per ALTC, TPI, and National Design Specifications for Wood Construction.
3. All framing anchors and connectors noted on drawings shall be manufactured by Simpson or equal.
4. All wood members exposed to weather or in contact with masonry, concrete or soil shall be pressure-treated.
5. Contractor shall provide all fastening devices necessary and suited for each application. Fastening subject to moisture shall be hot-dip galvanized to ASTM 153-80.
6. All metal connections and fabrications shall comply with A.I.S.C. specifications.
7. Prefabricated structural trusses shall comply with NFPA National Design Specifications for Wood Construction, IPI Design Specifications for Metal Plate Connected Wood Trusses, and AITC 100.
8. All trusses shall be designed and certified by Truss Manufacturer's registered Engineer.
9. Contractor shall coordinate with truss manufacturer to ensure adequate bearing is provided at end reactions of all girder trusses.
10. Truss manufacturer shall submit shop drawings and design notes with an engineer's seal for approval. Design notes to include the rated load capacity of the truss to truss connectors, and manufacturer's license to fabricate trusses utilizing the connector system proposed. The contractor shall approve fabrication and installation drawings showing size, shape and layout.
11. Bracing of trusses during erection installation shall comply with TPI HIB 91.
12. All prefabricated wood trusses shall be securely fastened to their supporting walls or beams with hurricane clips or anchors as noted in the Truss Connector Schedule.
13. At volume ceiling conditions, align trusses to provide a smooth, unbroken interior wall surface from floor to ceiling.

STEEL:

1. Structural steel shall conform to AISC Specifications for Design and Fabrication and Erection of Structural Steel for Buildings, (latest editions).
 - a. Welded connections-----AWS D1.1
 - b. Anchor bolts & threaded rods-----ASTM-A-307
 - c. Structural steel shapes, plates, etc. shall conform -----ASTM A-36

NOTICE TO ALL CONTRACTORS
 REVIEW & APPROVAL BY THE AUTHORITY HAVING JURISDICTION SHALL NOT RELIEVE THE APPLICANT OF THE RESPONSIBILITY OF COMPLIANCE WITH THE FIRE CODE

REVIEWED BY: John Ruley, Plans Examiner, 30883 DATE: _____
 ST. JOHNS COUNTY FIRE RESCUE

DESCRIPTION: GENERAL NOTES FOR CONSTRUCTION
 JOB: . . .

HULSBURG ENGINEERING, INC.
 (FL. CERT. #: 25846)
 2955 HARTLEY RD., SUITE 202
 JACKSONVILLE, FL 32257
 Ph. (904) 886-2401 Fax (904) 260-4367
 FLOYD S. SIMPSON, PE. (FL. PE. No. 50751)
 JEFFREY K. HULSBURG, PE. (FL. PE. No. 33152)

SCALE: N/A
 • U.O.N.
 • DO NOT SCALE THIS DRAWING


RELEASE DATE: 03-25-03

REVISION DATE: 08-21-03


DRAWN BY: CF/DJM II

CHECKED BY: JKH


SHEET: GN

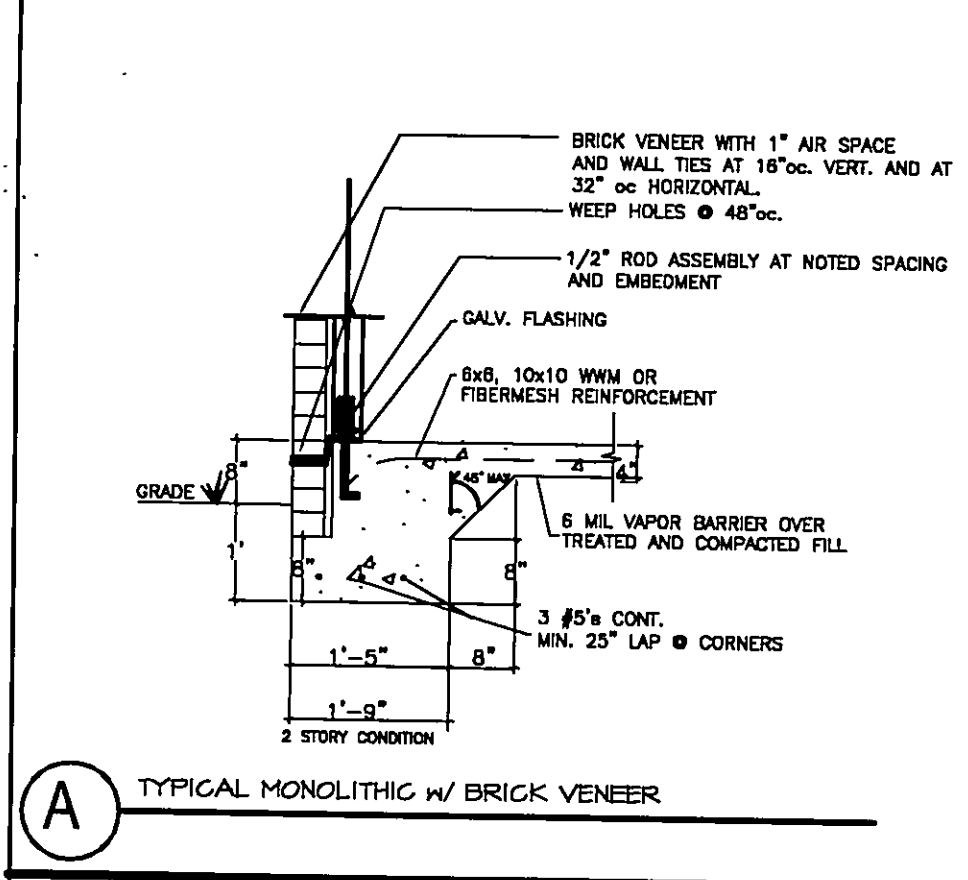


A TYPICAL MONOLITHIC W/ BRICK VENEER

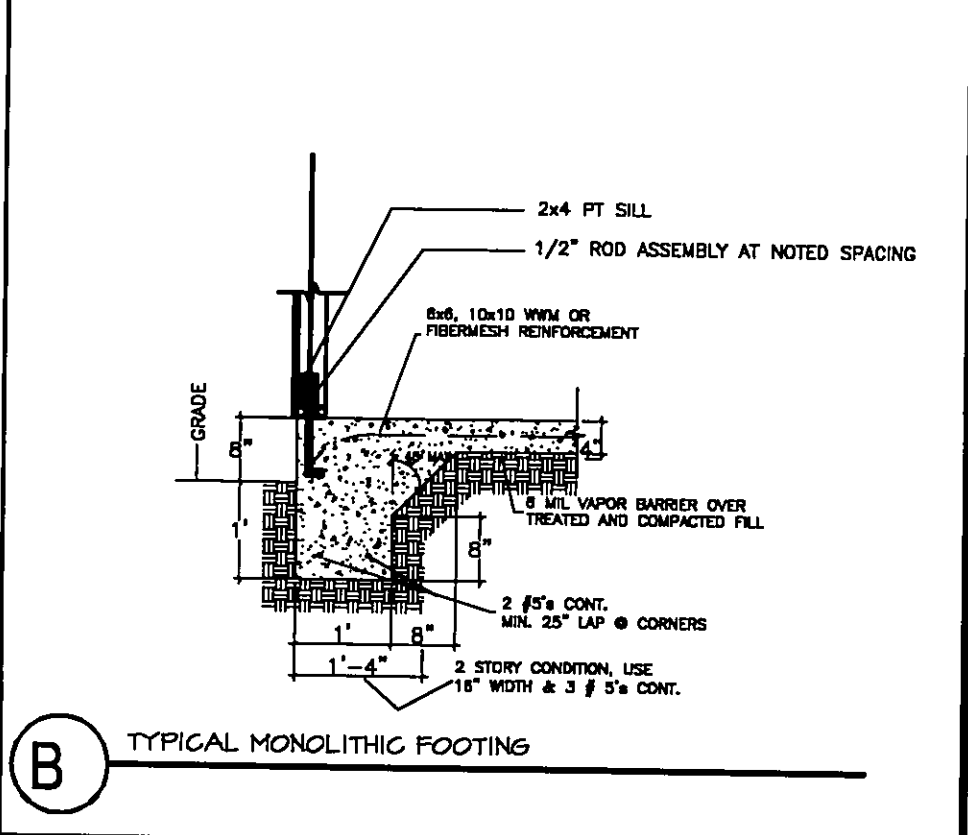


B TYPICAL MONOLITHIC FOOTING

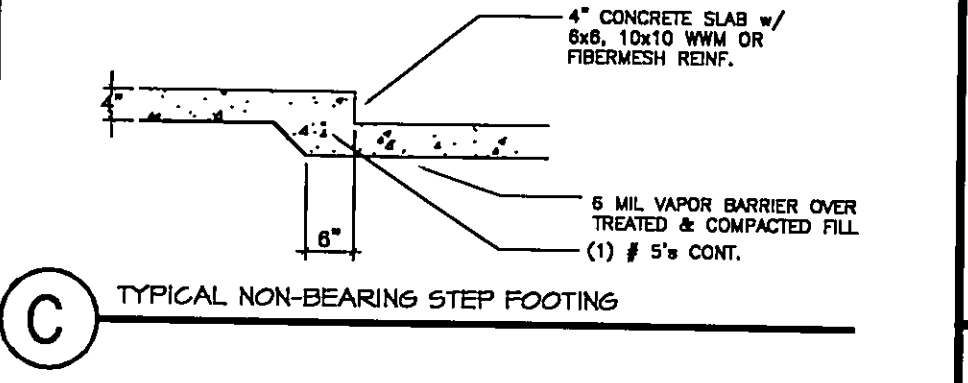


C TYPICAL NON-BEARING STEP FOOTING

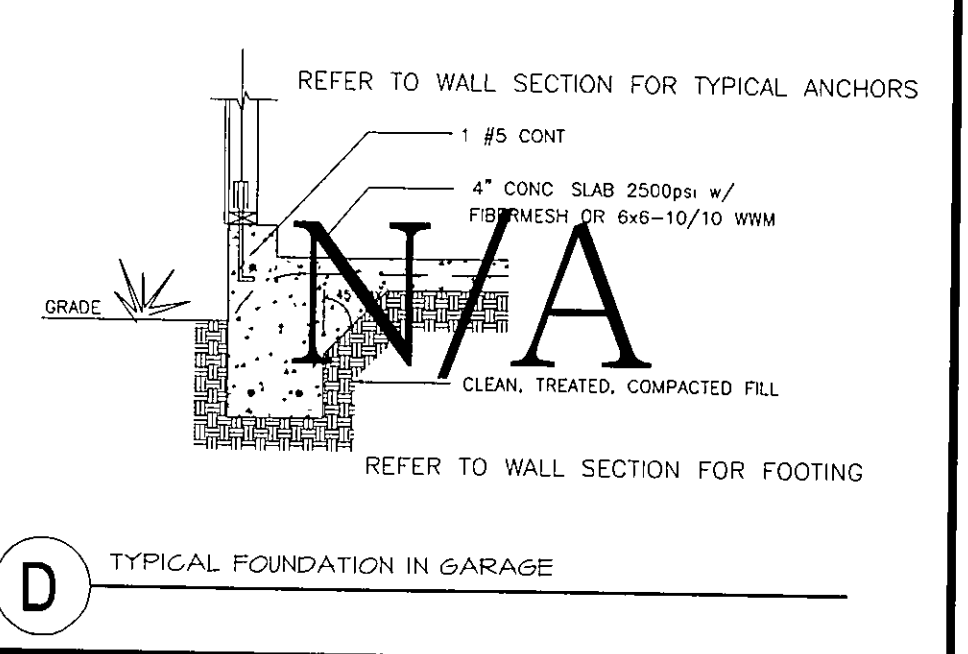


D TYPICAL FOUNDATION IN GARAGE

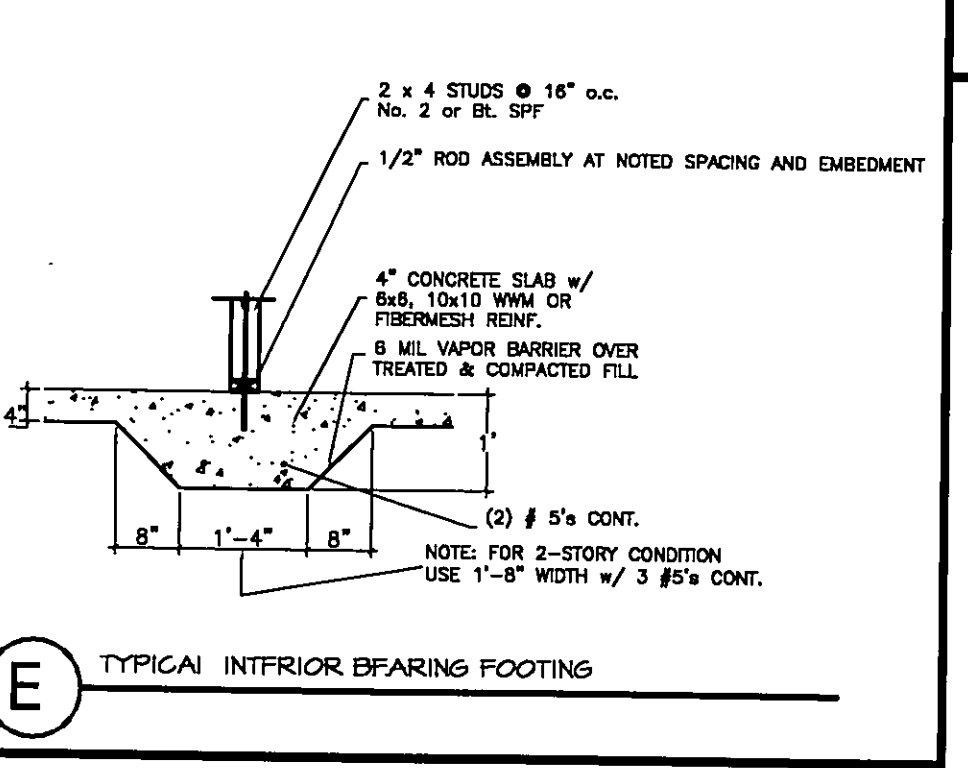


E TYPICAL INTERIOR BEARING FOOTING

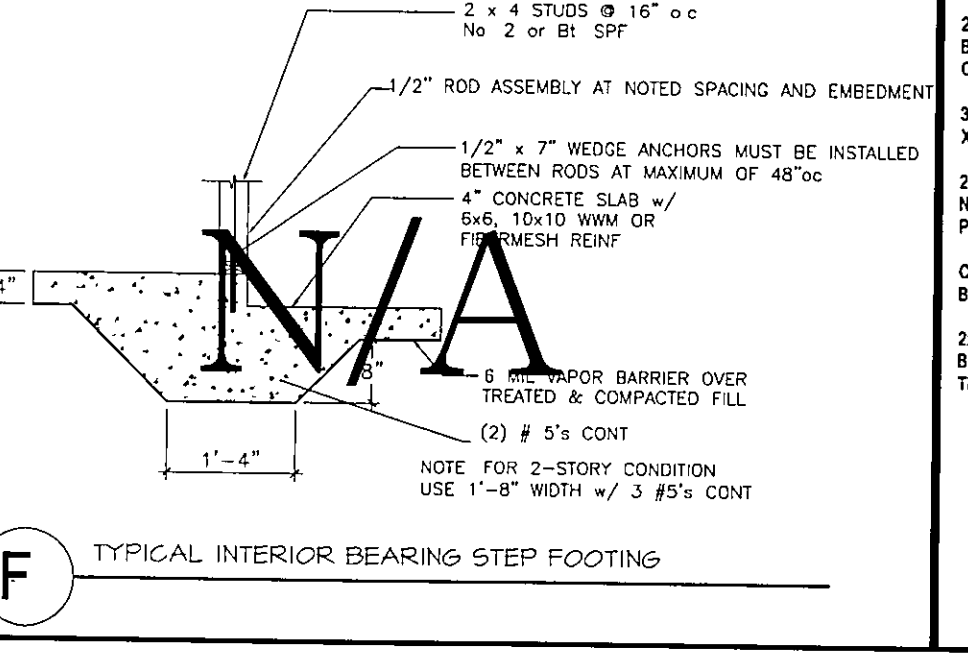


F TYPICAL INTERIOR BEARING STEP FOOTING

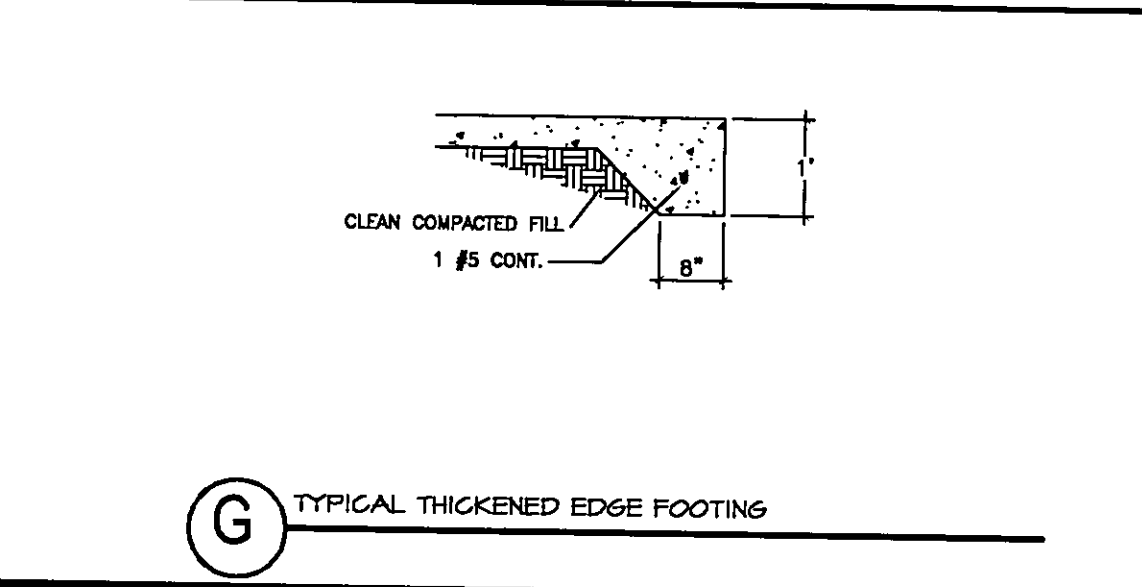


G TYPICAL THICKENED EDGE FOOTING

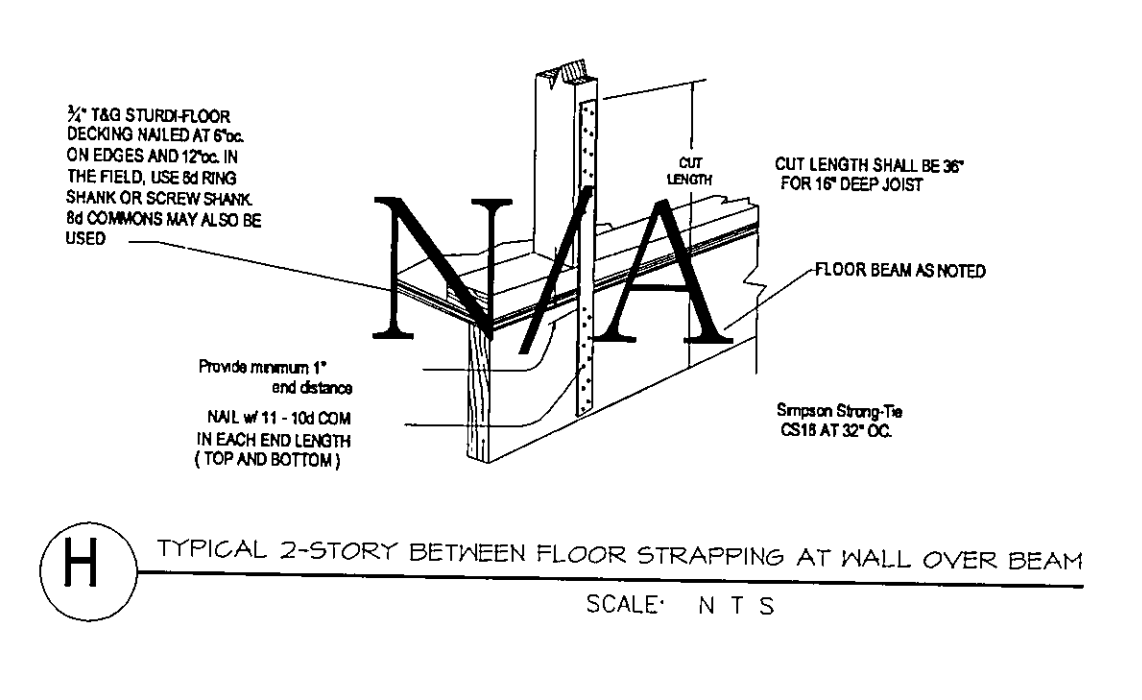


H TYPICAL 2-STORY BETWEEN FLOOR STRAPPING AT WALL OVER BEAM

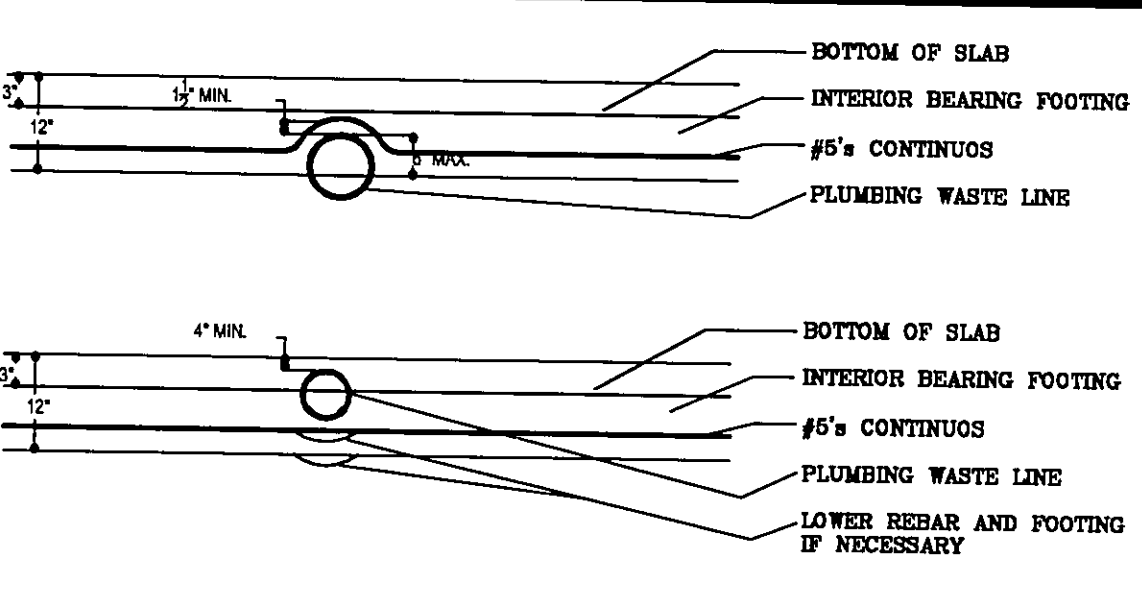


I PLUMBING PENETRATING INTERIOR BEARING FOOTING

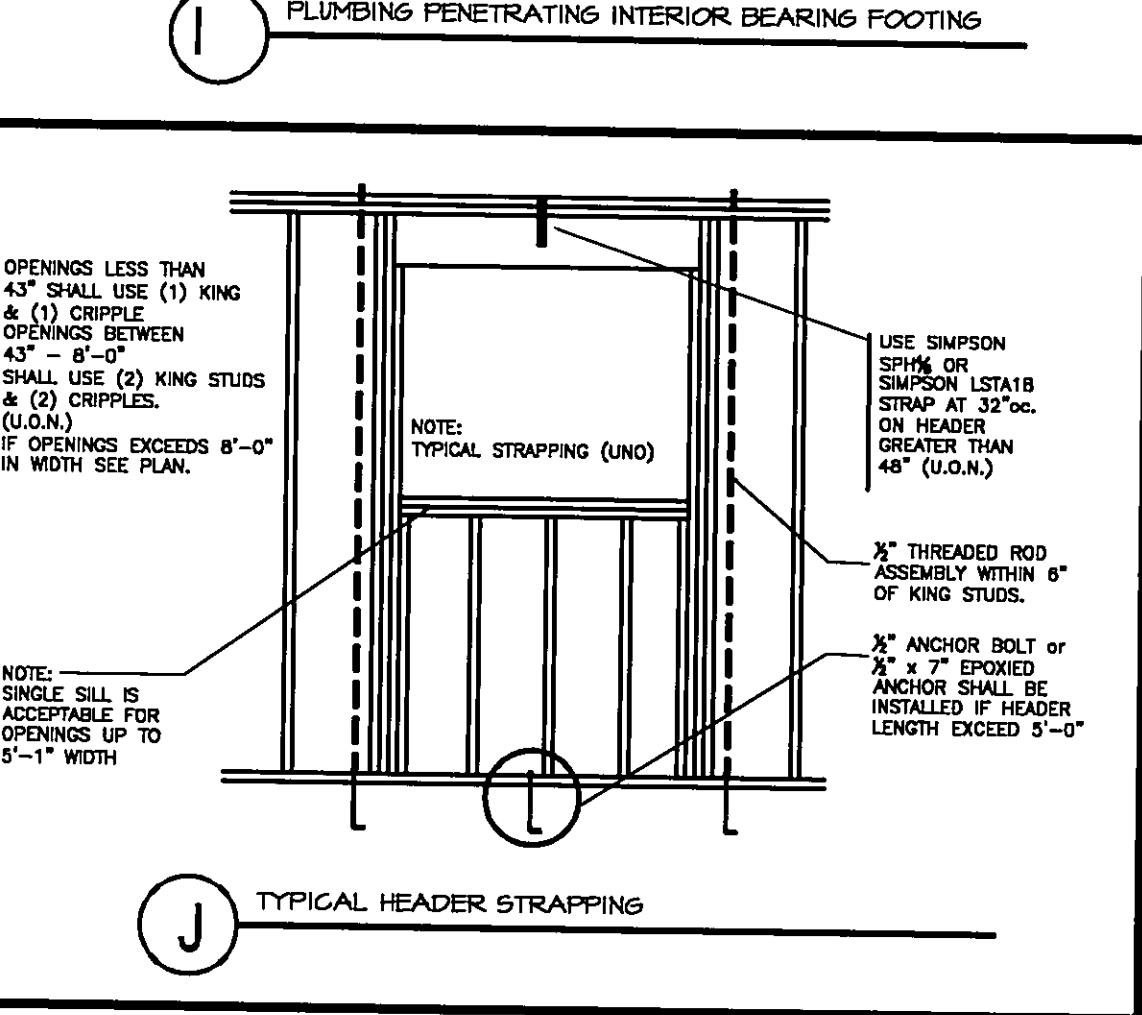


J TYPICAL HEADER STRAPPING

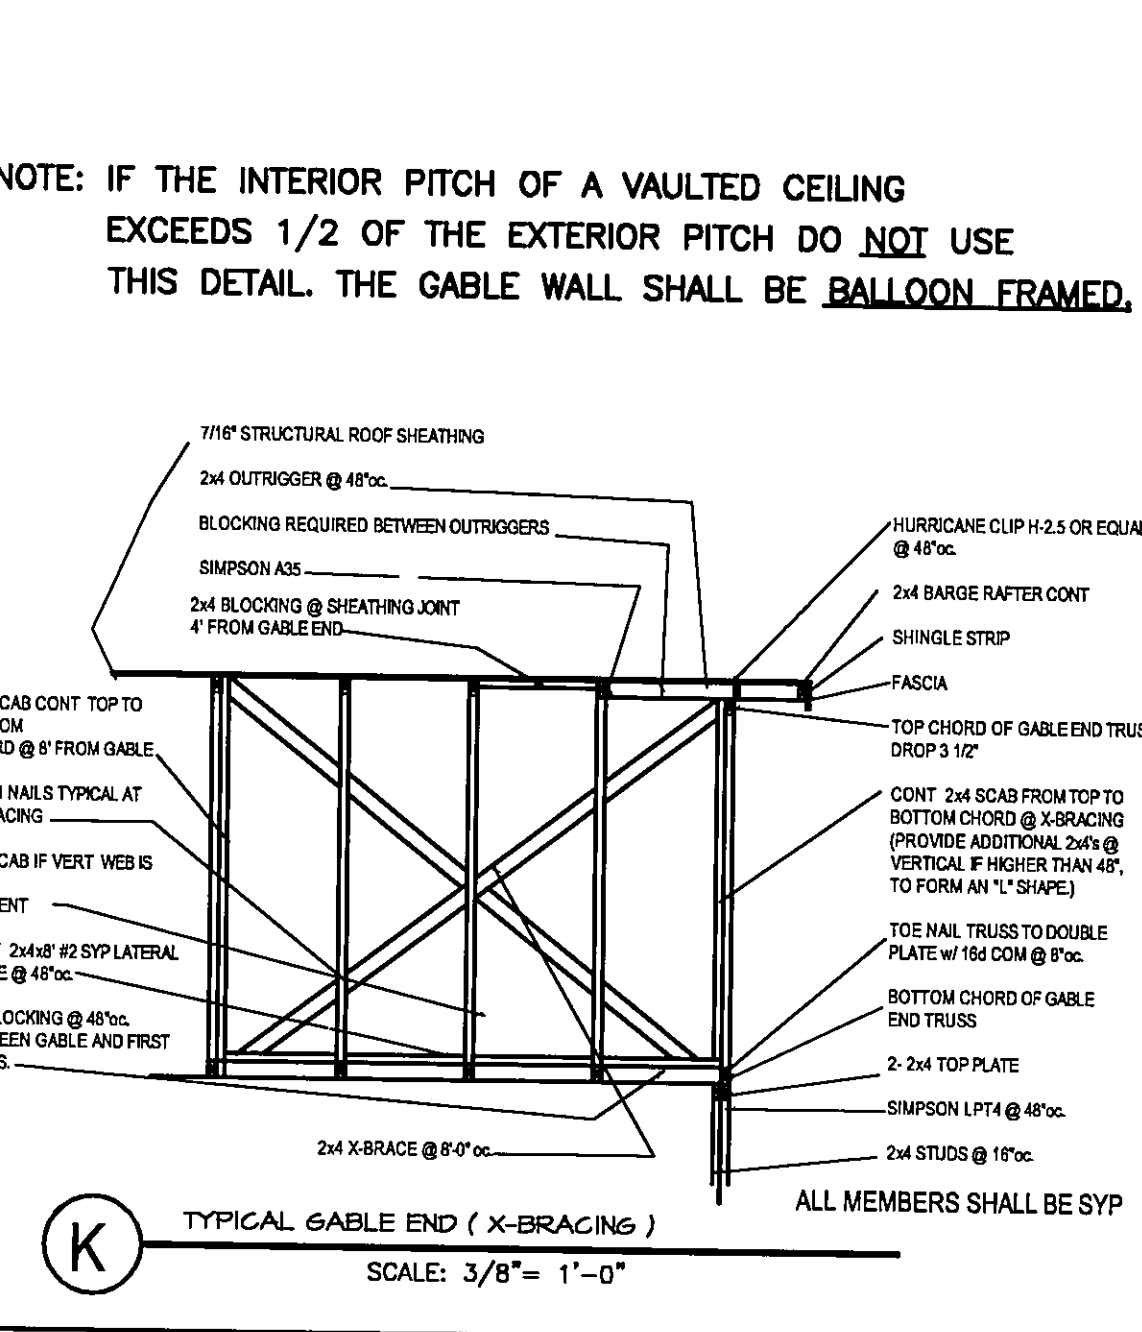


K TYPICAL GABLE END (X-BRACING)

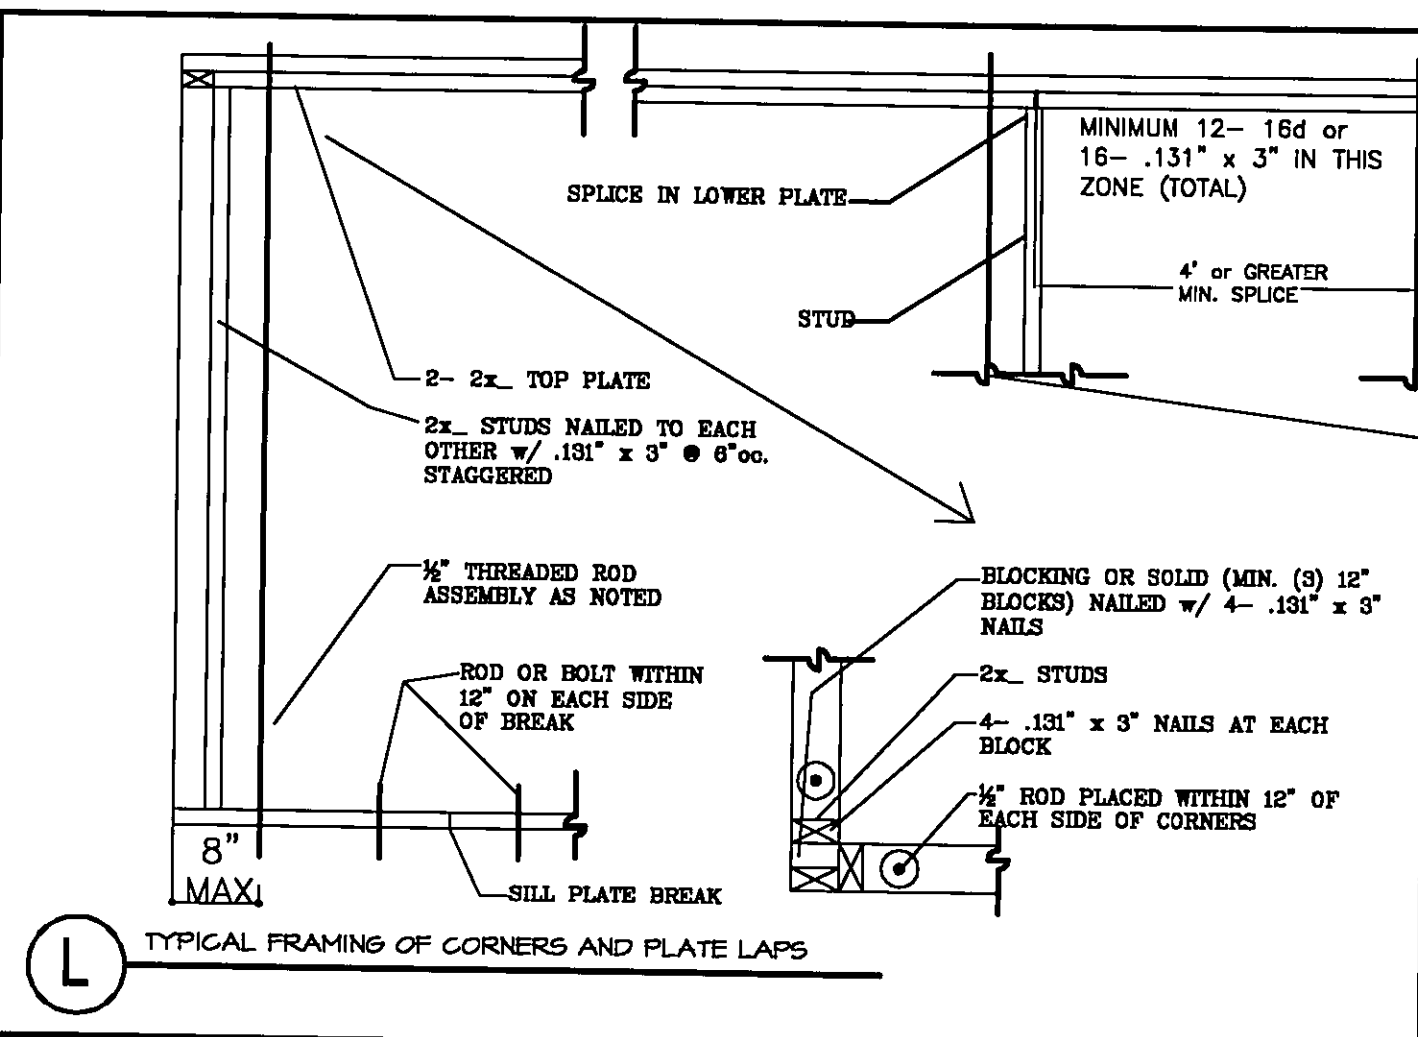


L TYPICAL FRAMING OF CORNERS AND PLATE LAPS

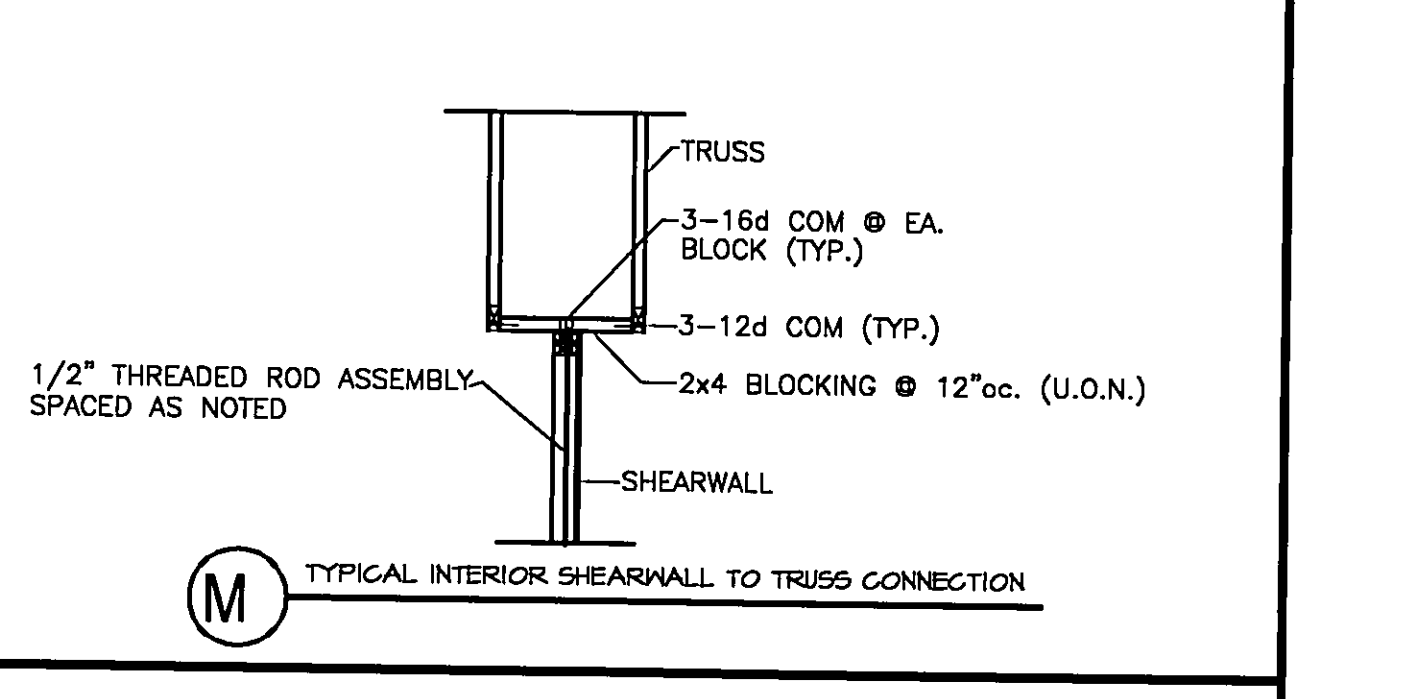


M TYPICAL INTERIOR SHEARWALL TO TRUSS CONNECTION

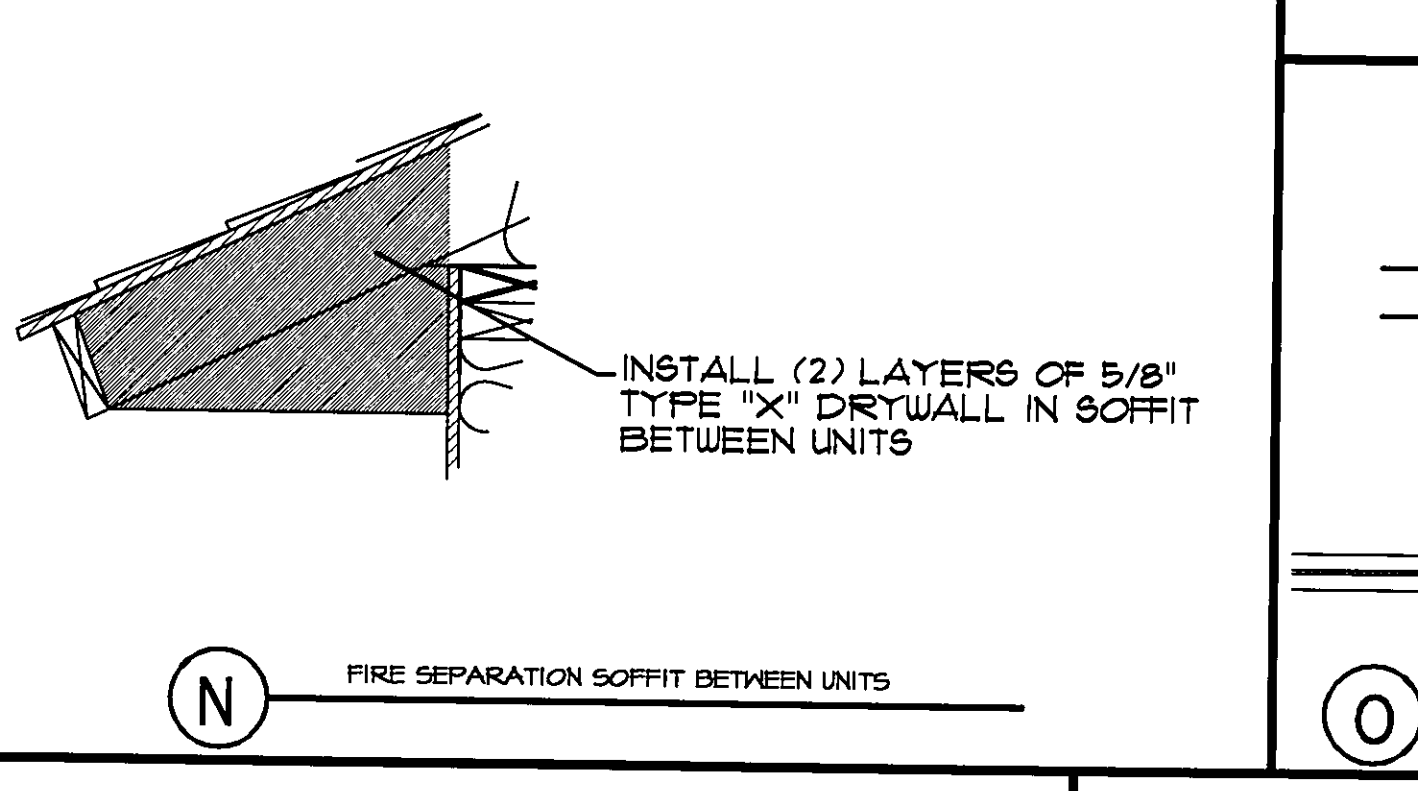

N FIRE SEPARATION SOFFIT BETWEEN UNITS

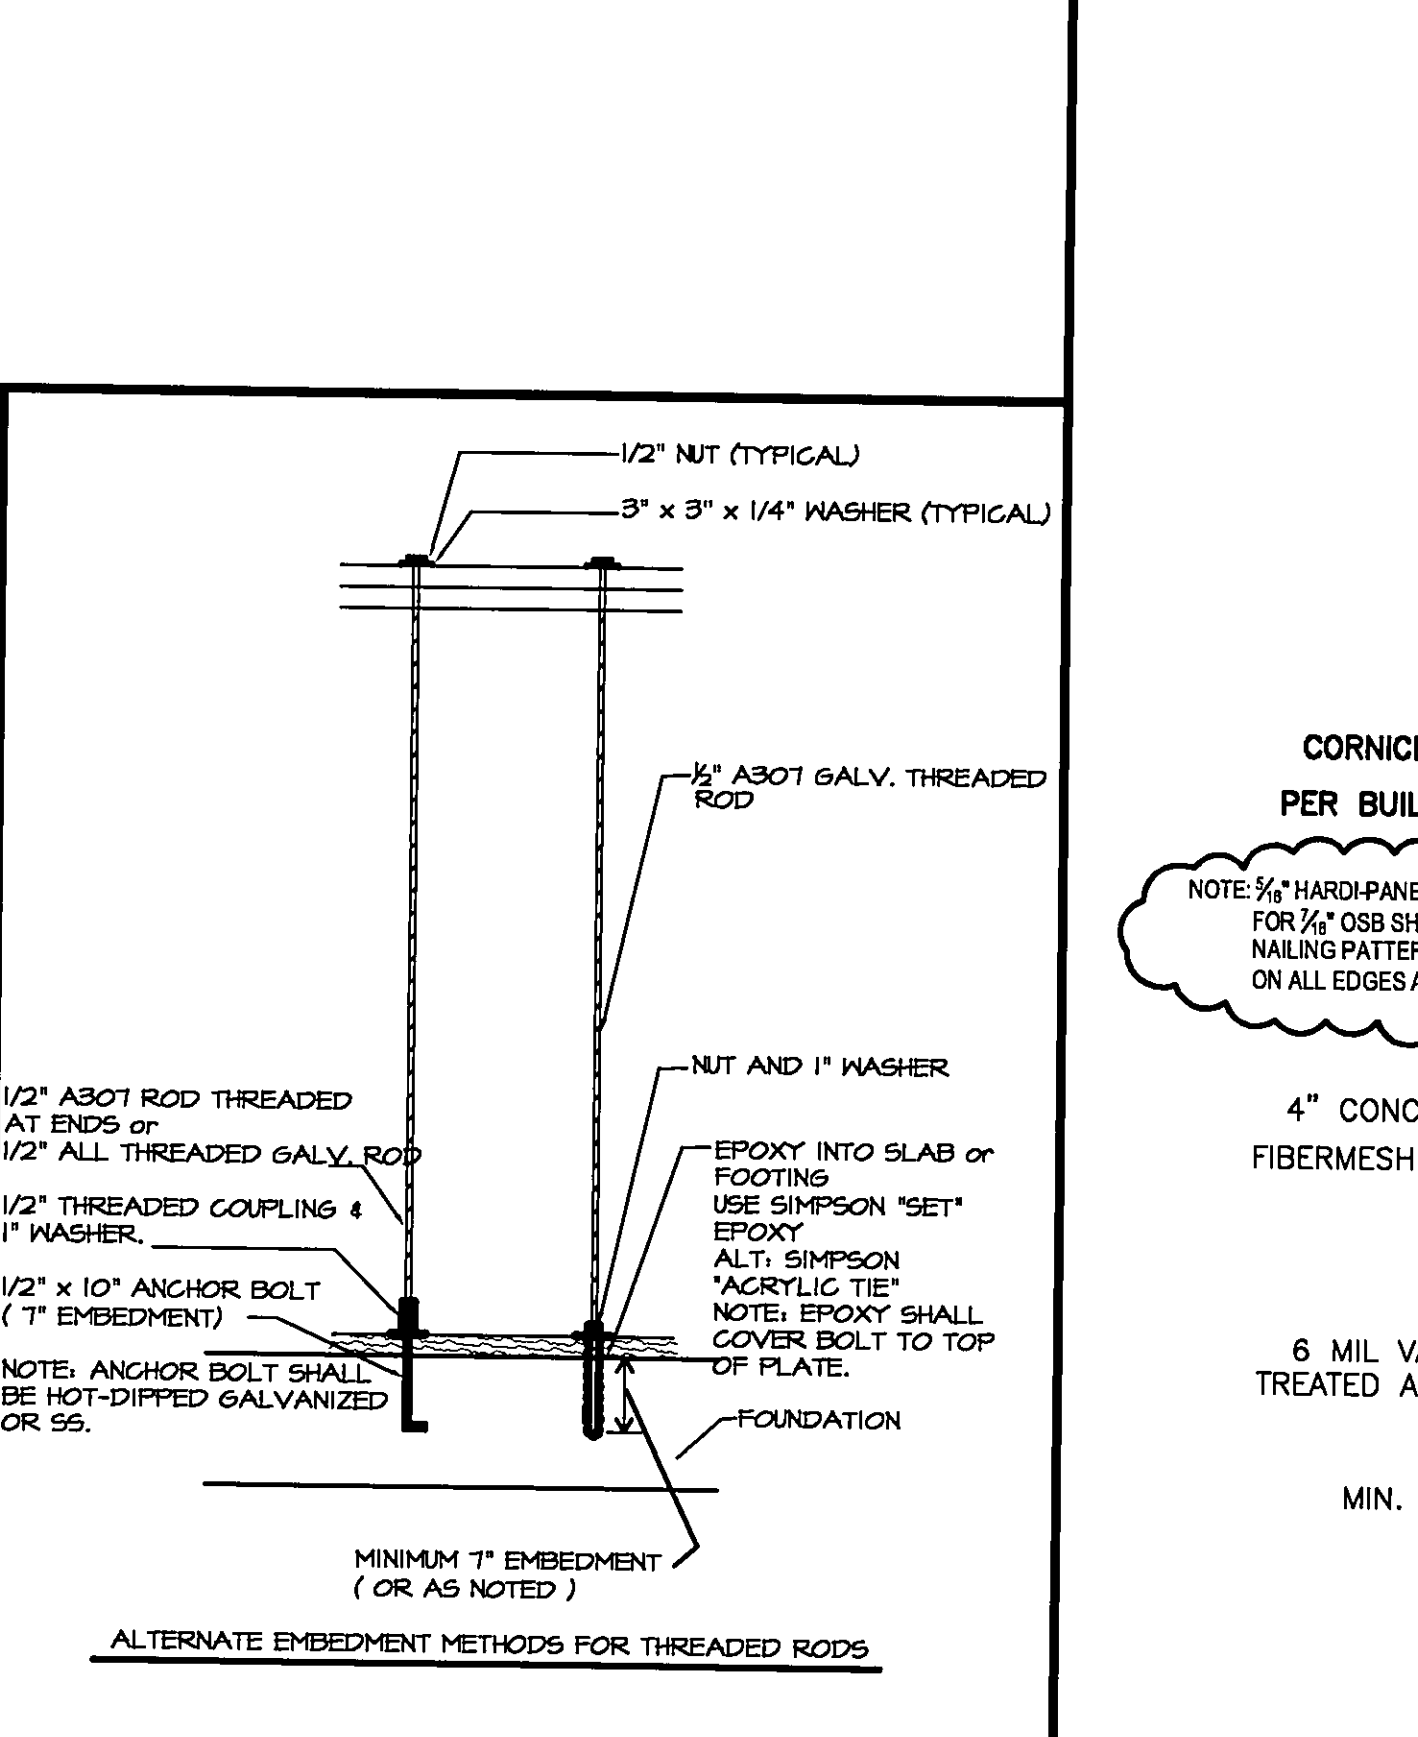


O CORNICE DETAIL AS PER BUILDER'S SPECS

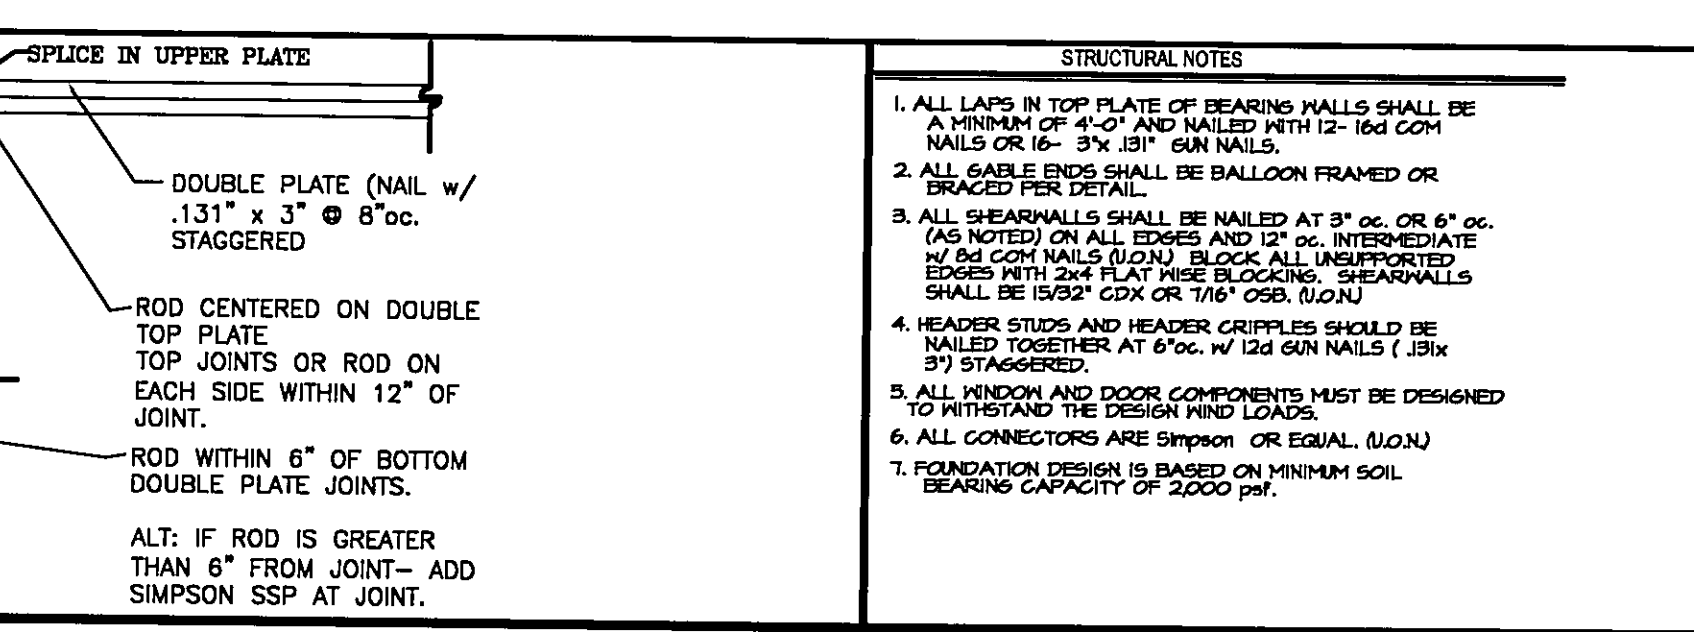


P GABLE END FRAMING FOR PLATFORM FRAMING

NAILING SCHEDULE			
CONNECTION	TYPICAL NAILING	REVISED 11/25/02	
		ALTERNATE NAILING 1	ALTERNATE NAILING 2
Lap in double plate	12-16d common	16-0 131" x 3 1/4" galv nails	20-12d sinkers
SW - shearwall	6" o.c. on edges and 12" o.c. in the field with 8d common, box, screw shank or ring shank	6" o.c. on edges and 12" o.c. in the field with 0.131" x 2 1/2" galv nails	4" o.c. on edges and 8" o.c. in the field with 0.099" x 2" galv nails
SWM(3) - shearwall	3" o.c. on edges and 12" o.c. in the field with 8d common, box, screw shank or ring shank	3" o.c. on edges and 12" o.c. in the field with 0.131" x 2 1/2" galv nails	
ENC. & PART. ENC. 1/2" of 7/16" Roof Sheathing, 120 MPH	6" o.c. on all supports with 8d common, ring shank or screw shank, 4" o.c. edge nailing within 4" of roof edge and ridges	6" o.c. on all supports with 0.131" x 2 1/2" smooth, ring or annular shank galv nails, 4" o.c. edge nailing within 4" of roof edge	
Simpson LSTA30	11-10d commons in each end (22 total)		
Simpson LSTA24	9-10d commons in each end (18 total)		
Simpson HTS30	10-10d commons in each end (20 total)		
Simpson MSTA36	13-10d commons in each end (26 total)		
Simpson SPH4	12-10d x 1 1/2" nails		
Simpson HZ.5A	10-8d commons (Total)		
Simpson H16	(2) 10-10d x 1 1/2" in rafter, 10-10d x 1 1/2" in plate		
Simpson LTS12	5-10d commons in rafter & plates	5-10d x 1 1/2" nails in rafter & plates	
Simpson MTS12	7-10d commons in rafter & plates	7-0 148" x 1 1/2" nails in rafter & plates	
Simpson LTA1	12-10d x 1 1/2"		
Simpson PHD8	24-1/4" x 3" SDS screws		
Simpson MGT	22-10d commons		
Simpson HTT16	18-16d commons		
Simpson HTT22	32-16d sinkers		

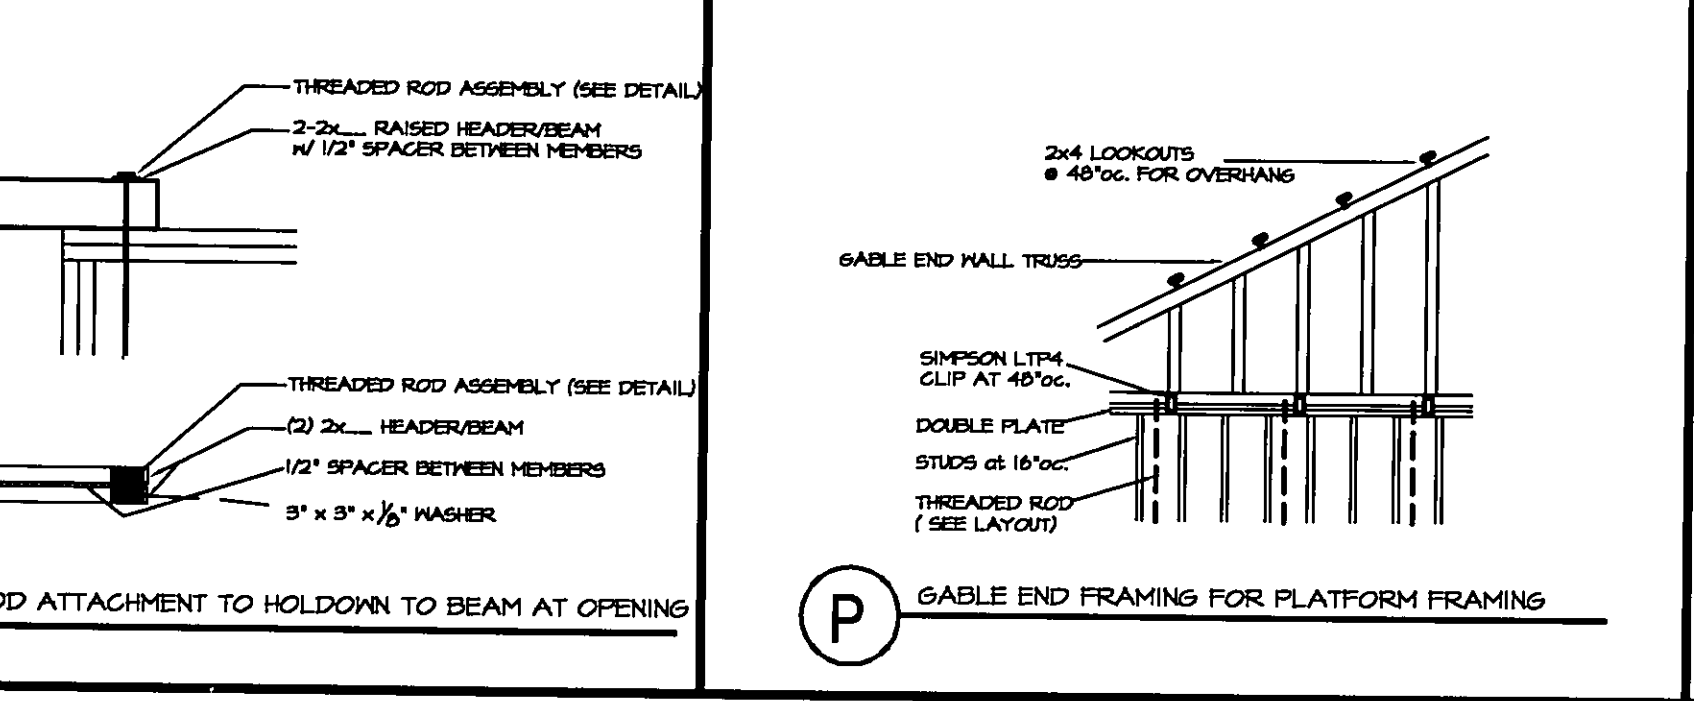


Q GABLE END FRAMING FOR BALLOON FRAMING

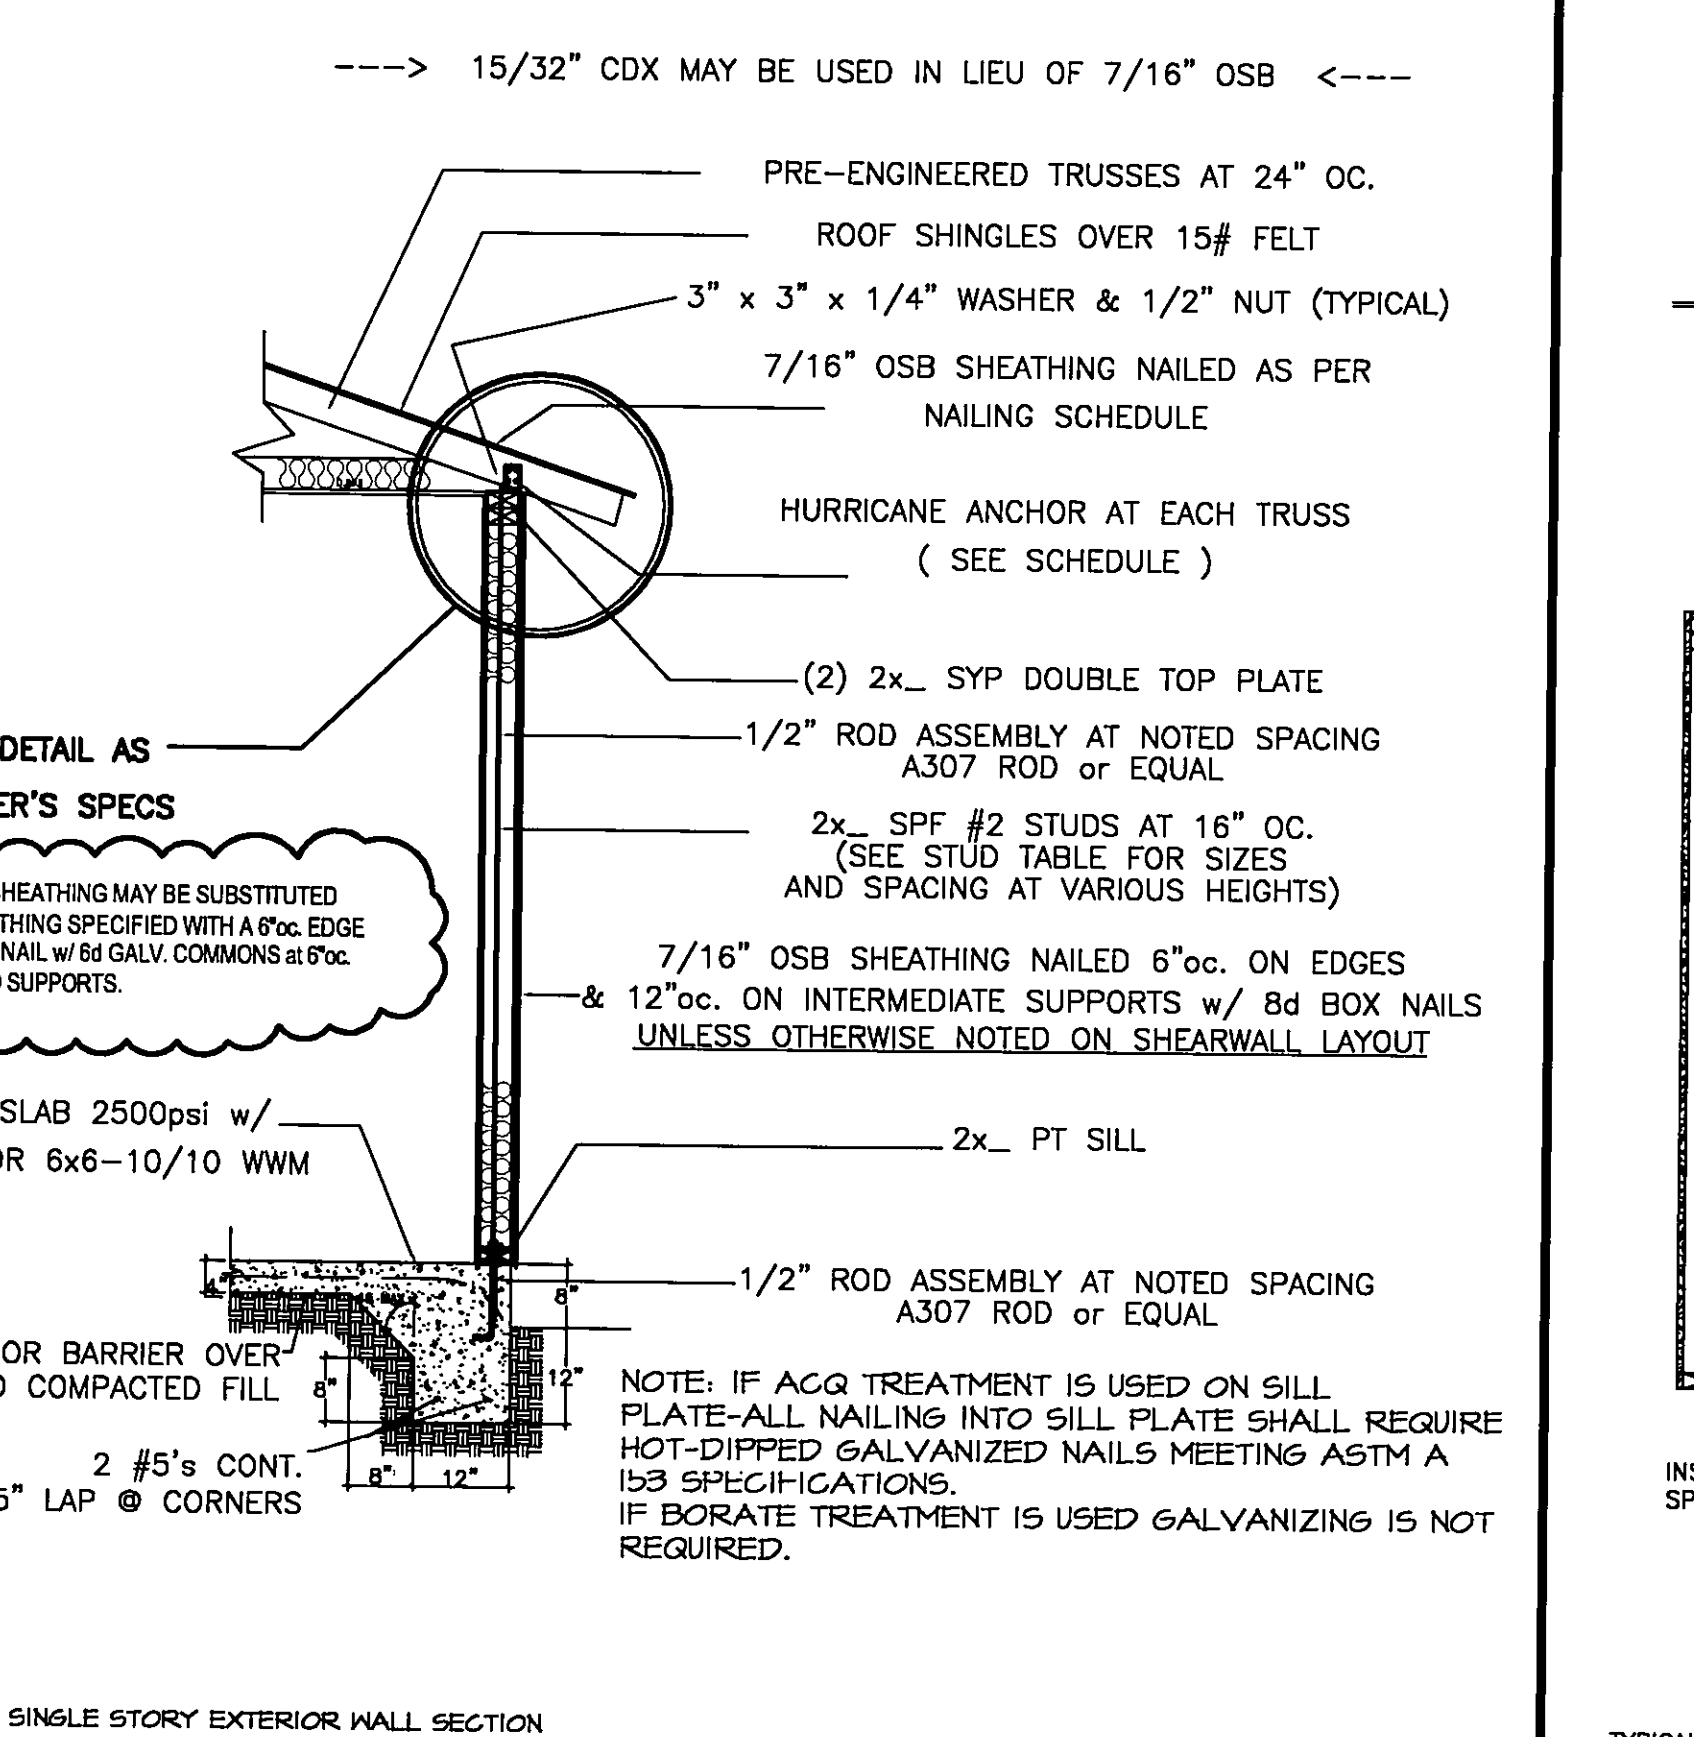


R ROD ATTACHMENT TO HOLDDOWN AT TRUSS/BEAM

CEILING HEIGHT	STUD SPACING FOR EXTERIOR LOAD BEARING WALLS					
	No. 2 SYP		No. 2 SYP		No. 1 SYP	
8 ft.	16"oc.	24"oc.	16"oc.	24"oc.	16"oc.	24"oc.
9 ft.	16"oc.	24"oc.	16"oc.	24"oc.	16"oc.	24"oc.
10 ft.	16"oc.	24"oc.	16"oc.	24"oc.	16"oc.	24"oc.
11 ft.	N/A	24"oc.	N/A	24"oc.	N/A	24"oc.
12 ft.	N/A	24"oc.	N/A	24"oc.	N/A	24"oc.
13 ft.	N/A	24"oc.	N/A	24"oc.	N/A	24"oc.
14 ft.	N/A	16"oc.	N/A	24"oc.	N/A	24"oc.
15 ft.	N/A	16"oc.	N/A	16"oc.	N/A	24"oc.
16 ft.	N/A	16"oc.	N/A	12"oc.	N/A	16"oc.


NOTES ON TREADED ROD INSTALLATION:
 1) RODS REQUIRE A MINIMUM LENGTH OF (1) BAR DIAMETER TREADED INTO COUPLING.
 2) MULTIPLE RODS MAY BE CONNECTED WITH COUPLING TO FORM ONE ROD.
 3) THE NUT AT THE TOP SHALL BE SNUGGED WITH THE ROD STRAIT AND THEN ONE ADDITIONAL FULL TURN OF THE NUT SHALL BE APPLIED TO ACHIEVE PROPER TENSION.
 4) THE MAXIMUM SPACING OF ANCHOR BOLTS ON EXTERIOR WALLS, ON THE SILL PLATE IS 60" o.c. THEREFORE IF RODS ARE SPACED GREATER THAN 5'-0" THEN ADDITIONAL ANCHOR BOLTS NEED TO BE INSTALLED. 1/2" EPOXY ANCHORS (5" EMBEDMENT) W/ 1" WASHER MAY BE USED FOR 1/2" x 10" ANCHOR BOLTS IN THIS APPLICATION.
 5) THE TOLERANCE ON ROD PLACEMENT SHALL BE +/- 6".
 6) MINIMUM EMBEDMENT FOR ANCHOR BOLTS OR TREADED RODS INTO FOUNDATION SHALL BE 1" MINIMUM.
 7) SHOULD A HEADER LENGTH EXCEED 40', INSTALL 56T-59T1/2 OR 56T-LSTA18 STRAP FROM HEADER TO TOP PLATE AT 32" o.c.

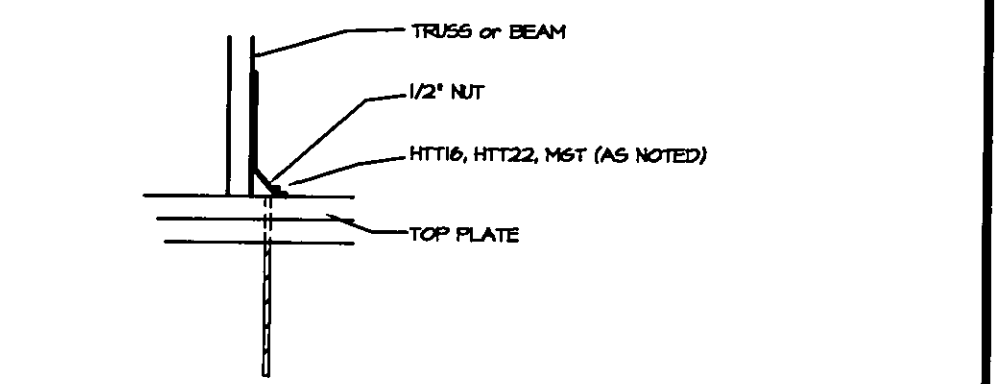

S TYPICAL FOUNDATION IN GARAGE

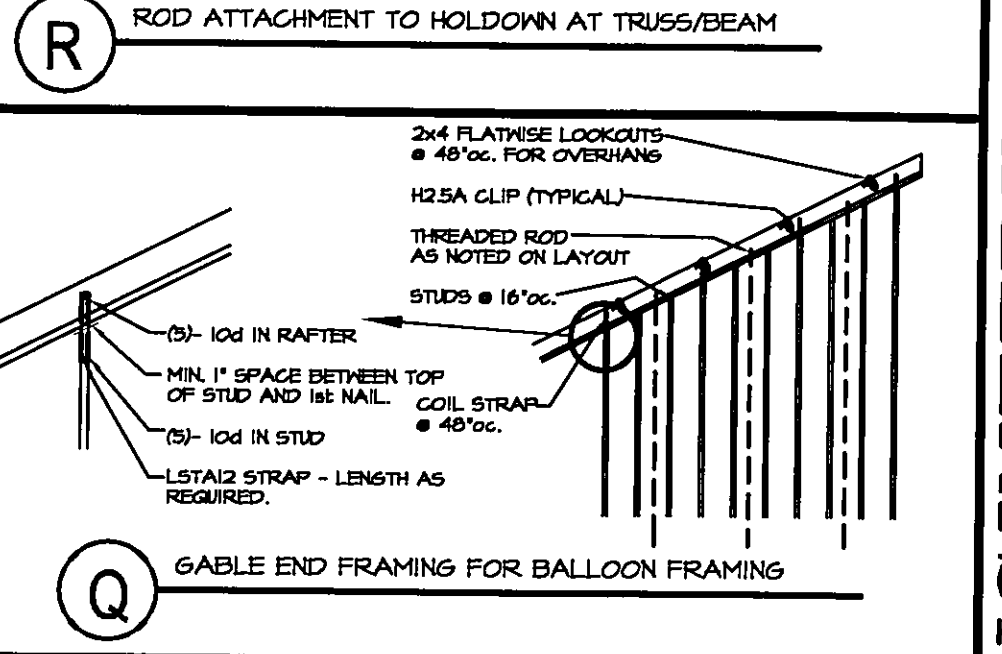

T TYPICAL HEADER STRAPPING


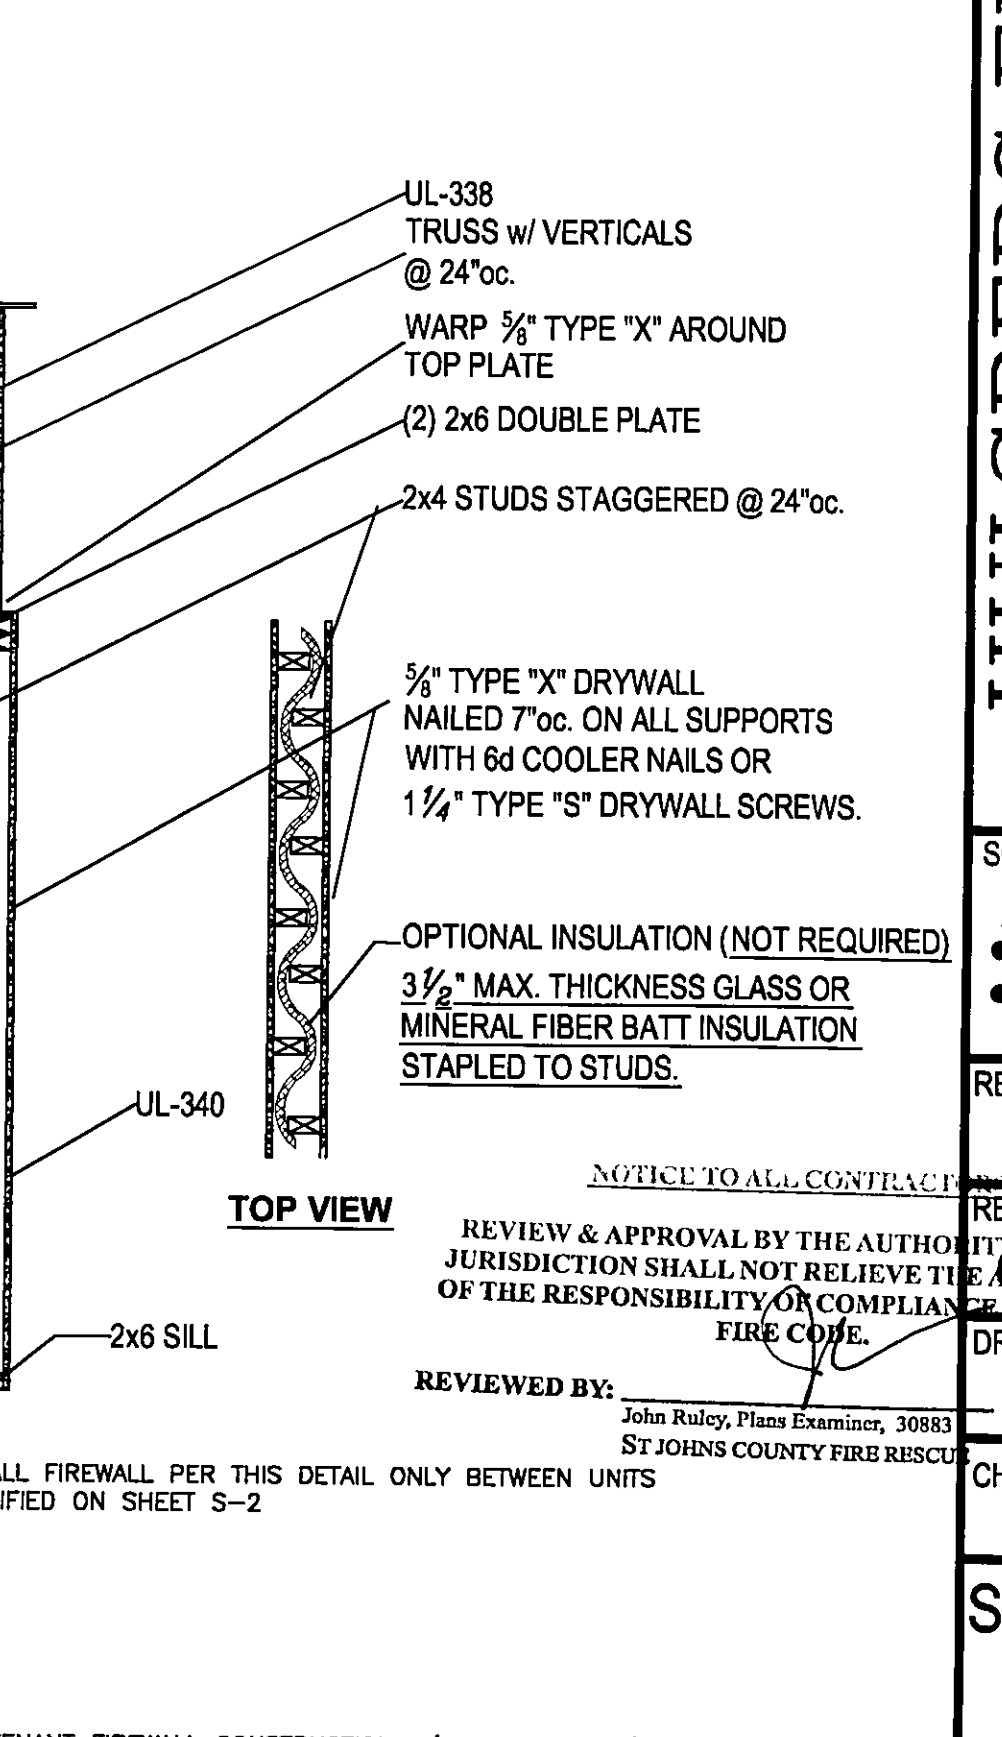


U TYPICAL GABLE END (X-BRACING)

STRUCTURAL NOTES
 1. ALL LAPS IN TOP PLATE OF BEARING WALLS SHALL BE A MINIMUM OF 4'-0" AND NAILED WITH 12-16d COM NAILS OR 16-3X 1/4" GALV NAILS.
 2. ALL GABLE ENDS SHALL BE BALLOON FRAMED OR BRACED PER DETAIL.
 3. ALL SHEARWALLS SHALL BE NAILED AT 3" o.c. OR 6" o.c. (AS NOTED) ON ALL EDGES AND 12" o.c. INTERMEDIATE. ALL 8d COM NAILS (U.O.N.) BLOCK ALL UNPROTECTED EDGES WITH 2x4 FLAT WISE BLOCKING. SHEARWALLS SHALL BE 15/32" CDX OR 7/16" OSB (U.O.N.)
 4. HEADER STUDS AND HEADER COUPLERS SHOULD BE NAILED TOGETHER AT 6" o.c. W/ 12d GALV NAILS (3/4" STAGGERED).
 5. ALL WINDOW AND DOOR COMPONENTS MUST BE DESIGNED TO WITHSTAND THE DESIGN WIND LOADS.
 6. ALL CONNECTORS ARE SIMPSON OR EQUAL (U.O.N.)
 7. FOUNDATION DESIGN IS BASED ON MINIMUM SOIL BEARING CAPACITY OF 2000 psf.



DESCRIPTION: **HULSBURG ENGINEERING, INC.**
 2955 HARTLEY RD., SUITE 202
 JACKSONVILLE, FL 32257
 Ph. (904) 886-2401 Fax (904) 260-4367
 (FL. CERT. #: 25846)
 (FL. PE. NO. 50781)
 (FL. PE. NO. 33152)

JEFFREY K. HULSBURG, P.E.
 SCALE: 1/2" = 1'-0"
 • U.O.N.
 • DO NOT SCALE THIS DRAWING
 RELEASE DATE: 03-25-03
 REVISION DATE: 01-12-04
 REVIEWED BY: John Rulcy, Plans Examiner, 30883 ST. JOHNS COUNTY FIRE RESCU
 DRAWN BY: DJM II
 CHECKED BY: JKH
 SHEET: S-1

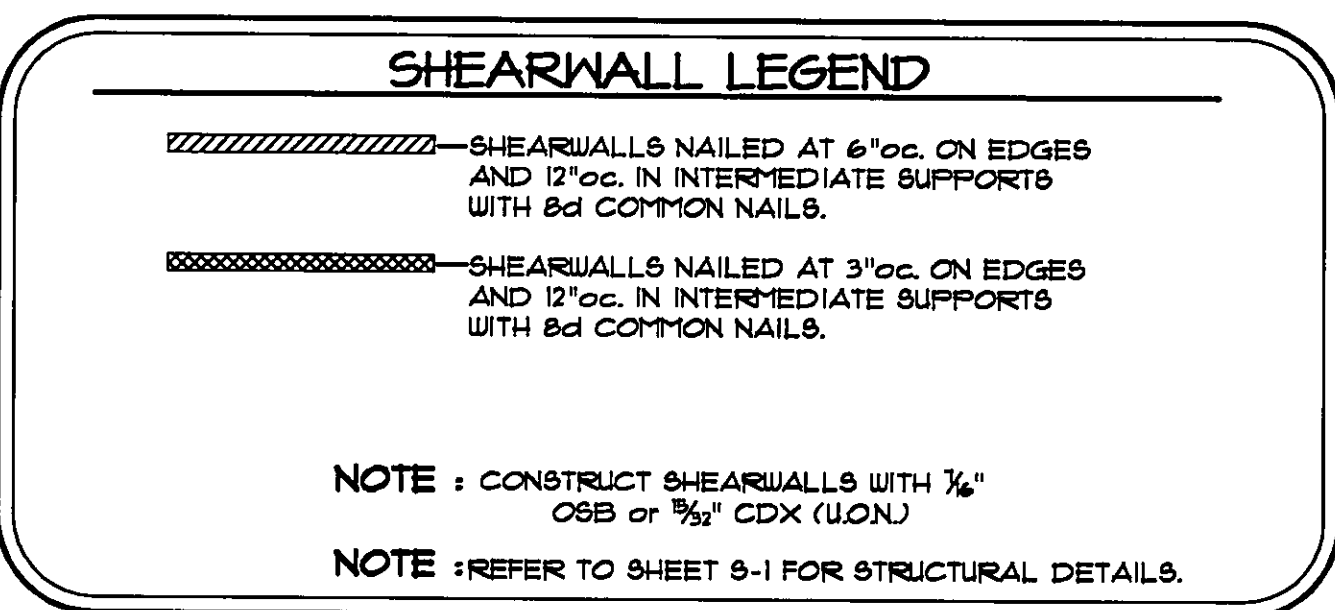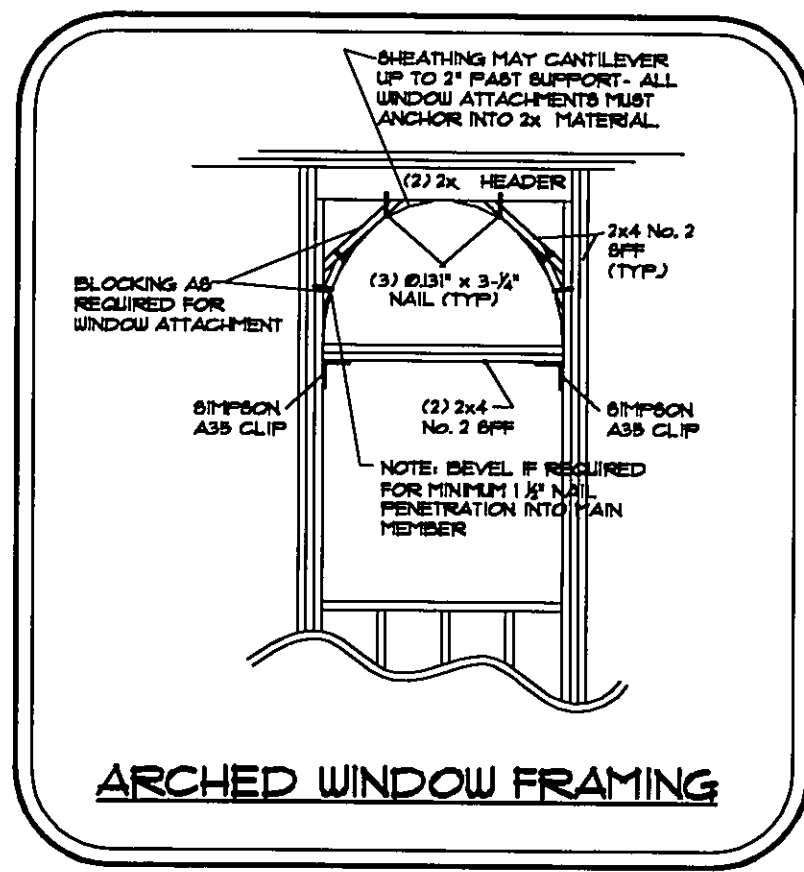

OPEN PORCH CEILING REQUIREMENTS:
 MINIMUM 3/4" SHEATHING REQUIRED ON EXTERIOR CEILINGS, NAILED WITH 6d COM OR BOX AT 6" o.c. ON EDGES AND 12" o.c. IN THE FIELD. (TYPICAL) THIS IS NOT REQUIRED ON THE UNDERSIDE OF FLAT DECKS/ BALCONIES.

NOTE: ALL SIMPSON METAL PRODUCTS WILL REQUIRE THE Z-MAX FINISH WHEN USED IN CONJUNCTION WITH ACQ PRESSURE TREATED LUMBER.

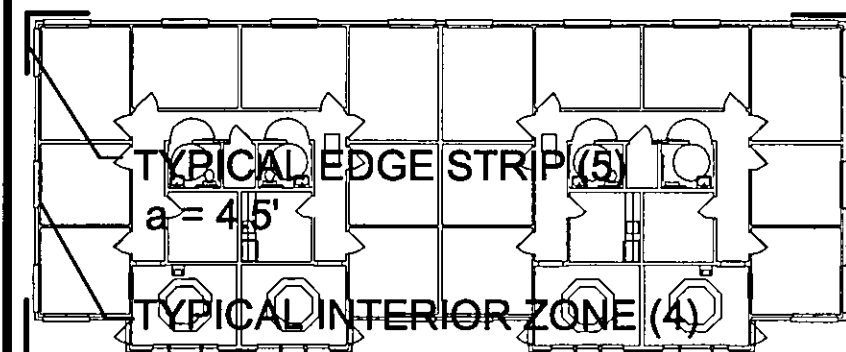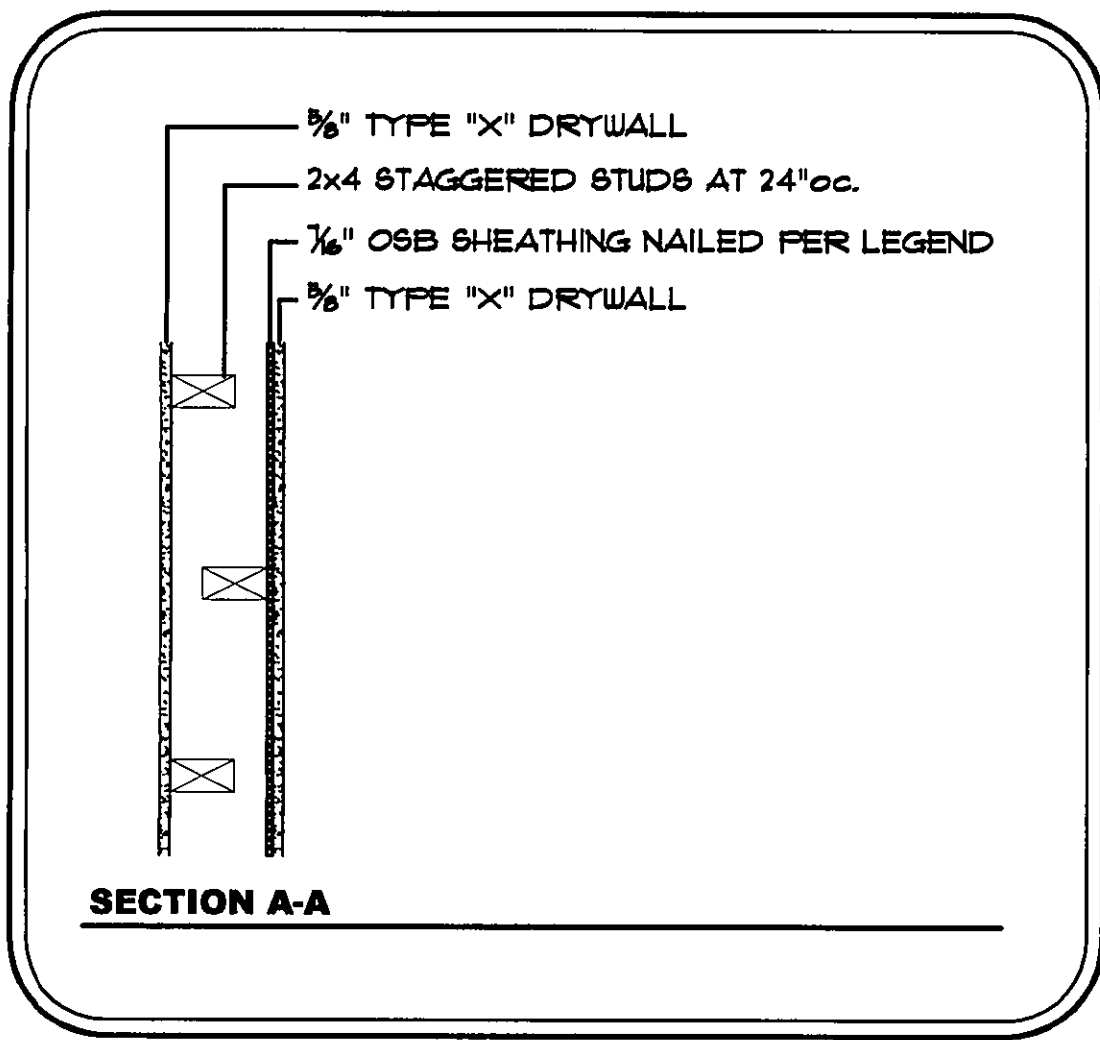

WIND PRESSURES ON WINDOWS & DOORS (psf)

AREA OF OPENING	Enclosed Structure		Interior Zone (4)	
	Pos	Neg	Pos	Neg
0 to 20 sf	26.0	-34.8	25.0	-29.2
20.1 to 50 sf	24.9	-32.3	24.9	-27.1
50.1 to 100 sf	23.3	-29.3	23.3	-25.5
100.1 to 200 sf	22.0	-27.1	22.0	-24.2
200.1 to 500 sf	20.8	-24.6	20.9	-23.1
Base Design Pressure	22.00		GCp1 = ±0.18	

DESIGN LOADS:

FLOORS:
 LIVE LOAD = 40psf
 DEAD LOAD = 15psf
 (CARPET or WOOD)
 DEAD LOAD = 20psf
 (TILE)
 DEFLECTION CRITERIA:
 CARPET or WOOD = L/480 LL
 L/240 DL
 L/600 LL
 L/500 DL
 TILE =

ROOF (TRUSS):
 LIVE LOAD = TC 20psf
 BC 10psf
 DEAD LOAD = TC 7psf
 BC 5psf

ROOF (CONV. FRAME):
 RAFTER LOAD = 20psf LL
 10psf DL
 DURATION FACTOR = 1.25
 CEILING LOAD = 20psf LL
 10psf DL


DESIGN CRITERIA:

BUILDING CODE: 2001 FLORIDA BUILDING CODE
 WIND DESIGN METHOD: ASCE 7-98
 BASIC WIND SPEED: 120 mph
 BUILDING CATEGORY: II
 WIND IMPORTANCE FACTOR: 1.00
 WIND EXPOSURE: B
 DESIGN FOR ENCLOSED STRUCTURE

NOTE: ALL LOAD BEARING HEADERS SHALL BE A MINIMUM OF (2) 2x10 No.2 or BT 5YP (U.O.N.)

NOTE: LADDER FRAME FLOOR SYSTEM BETWEEN TRUSS E-06 AND E-06A WITH 2x8 JOISTS AT 24" o.c. - INSTALL DOUBLE JOISTS AT EACH END OF ATTIC LADDER. LADDER FRAME ROOF IN THIS AREA USING 2x4 MEMBERS AT 24" o.c.

NOTE: LADDER FRAME FLOOR SYSTEM BETWEEN TRUSS E-03 AND D-04 WITH 2x8 JOISTS AT 24" o.c. - INSTALL DOUBLE JOISTS AT EACH END OF ATTIC LADDER. LADDER FRAME ROOF IN THIS AREA USING 2x4 MEMBERS AT 24" o.c.

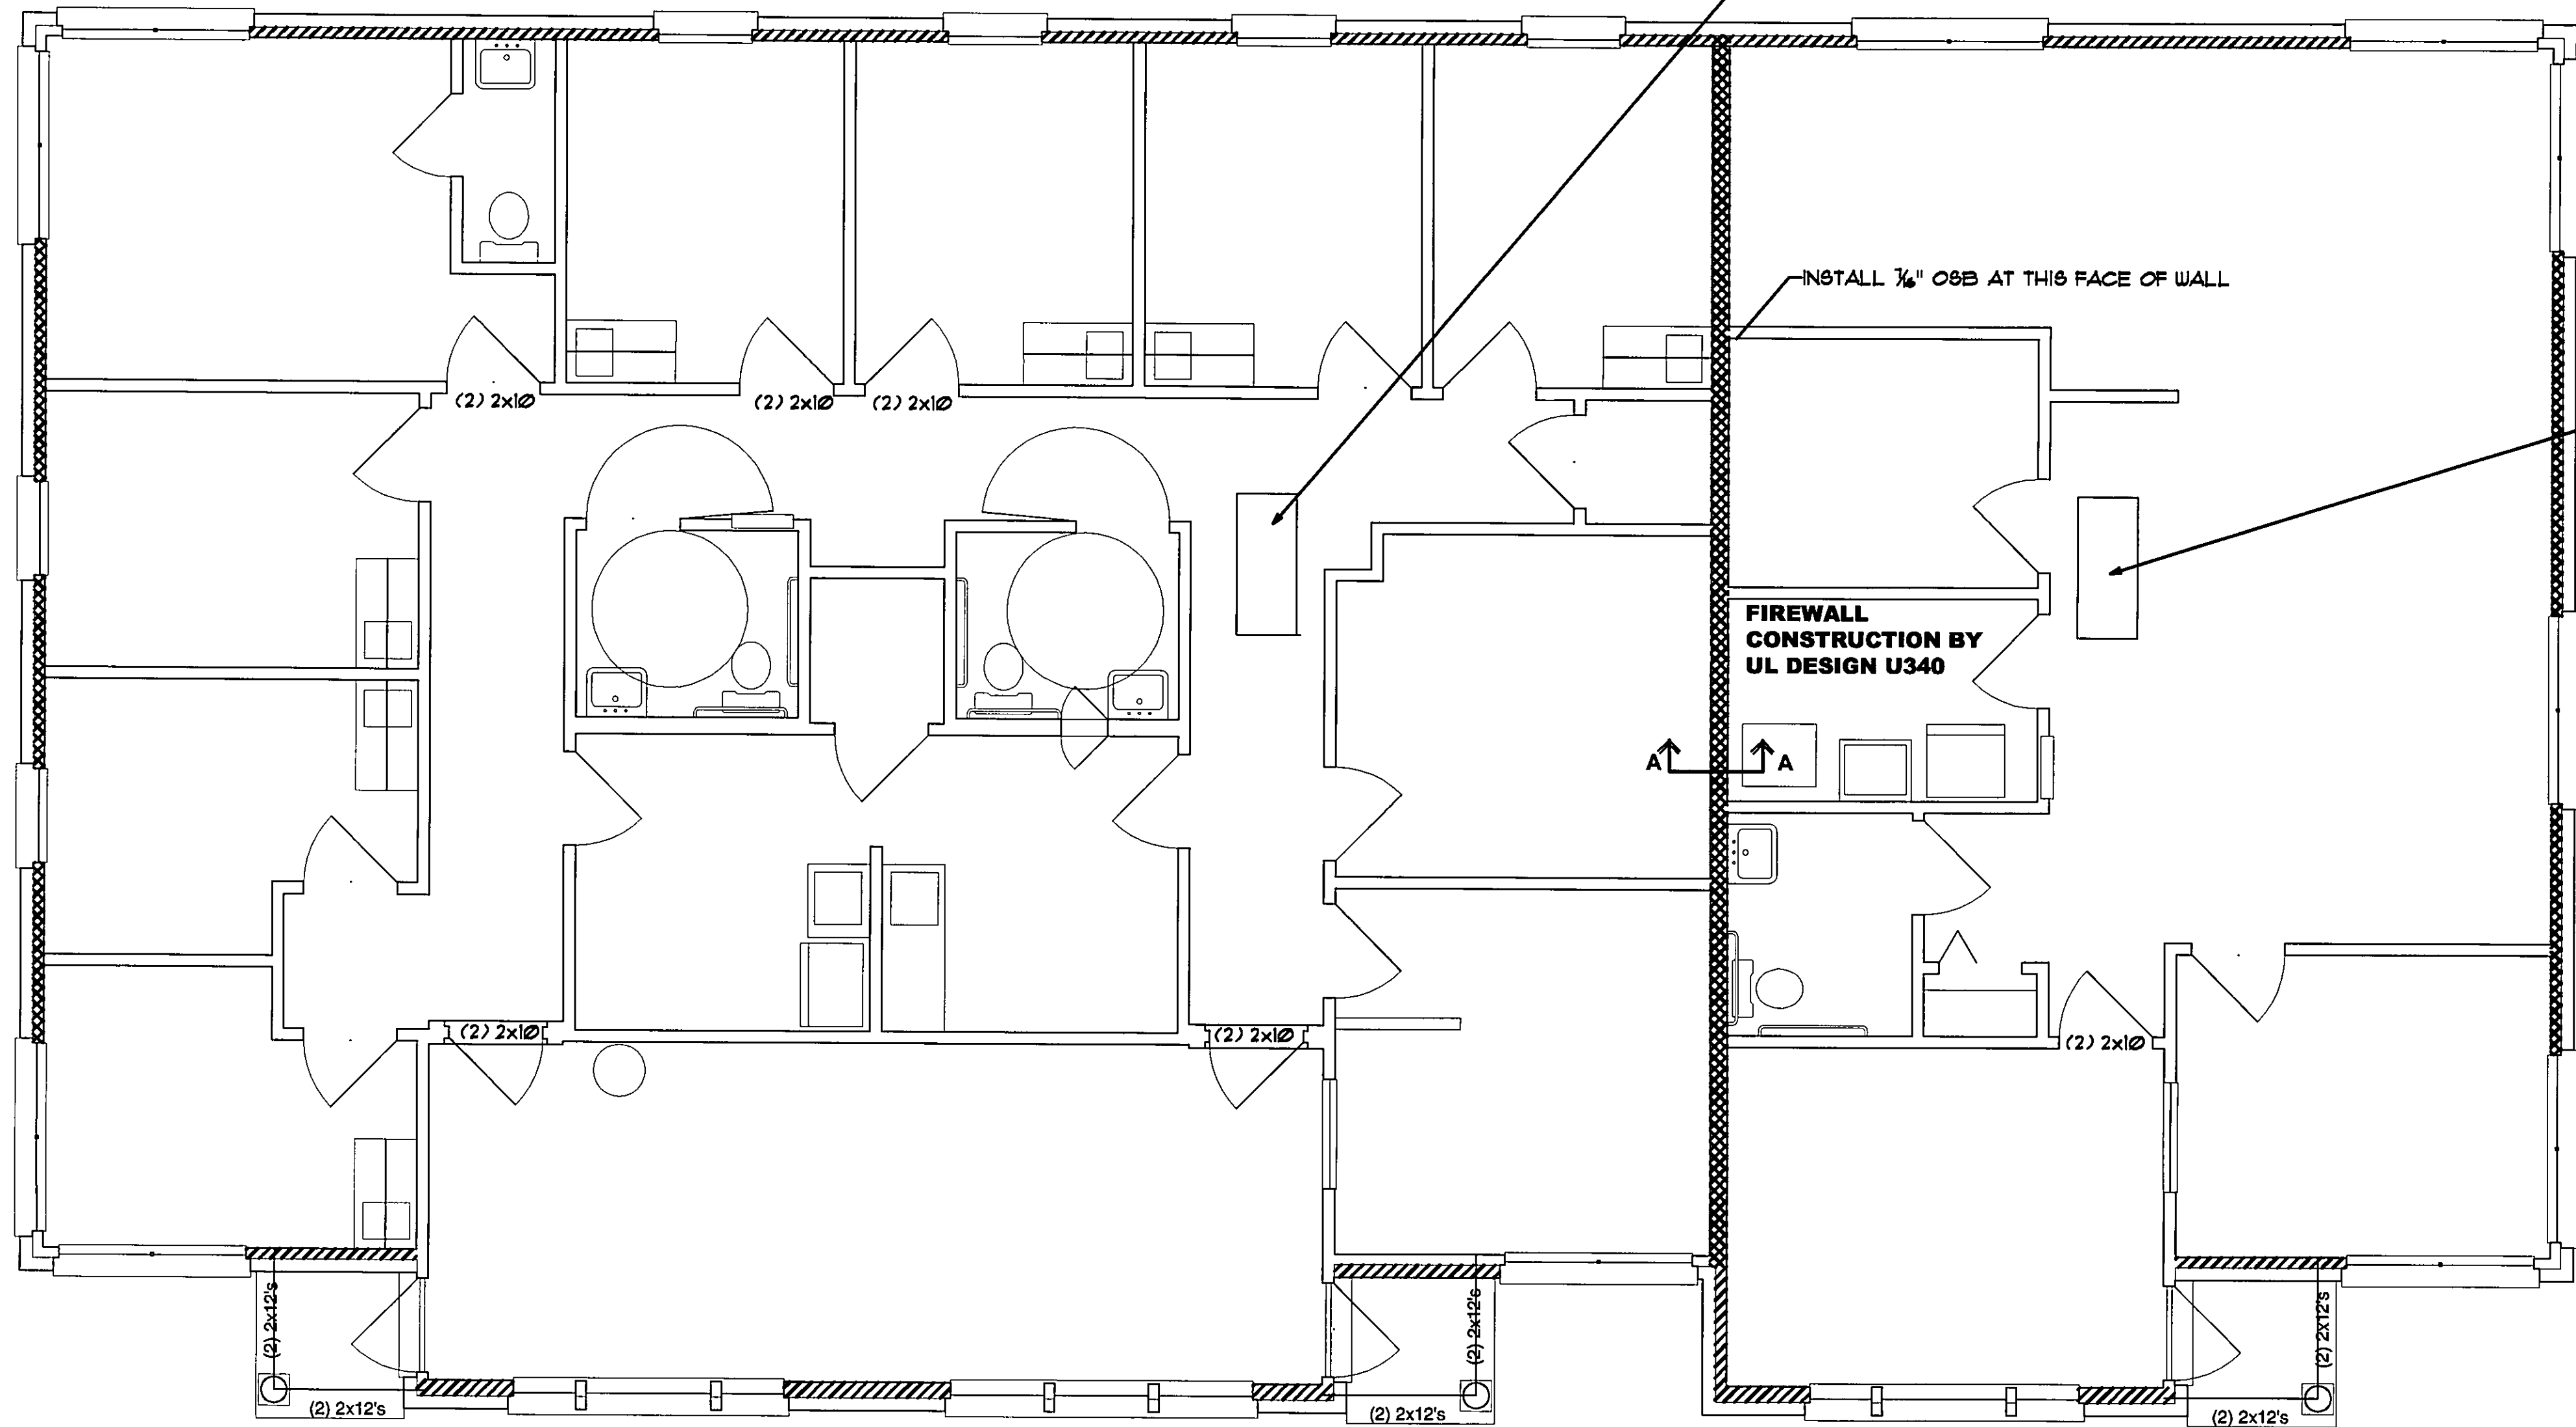

4x4 FT POST ON SIMPSON ABU44 Z POST BASE w/ (2) SIMPSON H6 Z CLIPS AT BEAM ABOVE OR USE PRE-CAST DETAIL. (TYPICAL EACH PORCH)

NOTICE TO ALL CONTRACTORS

REVIEW & APPROVAL BY THE AUTHORITY HAVING JURISDICTION SHALL NOT RELIEVE THE APPLICANT OF THE RESPONSIBILITY OF COMPLIANCE WITH THE FIRE CODE.

REVIEWED BY: John Rulby, Plans Examiner, 30883 ST. JOHNS COUNTY FIRE RESCUE

DESCRIPTION: **ENGINEERING (ASCE 7-98)**

JOB: **LANDMARK HOMES (THREE UNIT - TWO TENANTS) BUILDING 800 (SOUTHLAKE OFFICE CENTER)**

HULSBURG ENGINEERING, INC.
 (FL. CERT. #: 25846)
 2955 HARTLEY RD., SUITE 202
 JACKSONVILLE, FL 32257
 Ph. (904) 886-2401 Fax (904) 260-4367

JEFFREY K. HULSBURG, PE. (FL. PE. NO. 33152)
 FLOYD S. SIMPSON, PE. (FL. PE. NO. 50791)

SCALE: 1/4" = 1'-0"

- U.O.N.
- DO NOT SCALE THIS DRAWING

RELEASE DATE: 04-19-04

REVISION DATE: 00-00-00

DRAWN BY: DJM II

CHECKED BY: JKH


SHEET: S-2

NOTE: ALL SIMPSON METAL PRODUCTS WILL REQUIRE THE Z-MAX FINISH WHEN USED IN CONJUNCTION WITH ACQ PRESSURE TREATED LUMBER.

- = 1/2" THREADED ROD FROM FOUNDATION TO DOUBLE TOP PLATE. (7" EMBEDMENT)
- ⊙ = 1/2" THREADED ROD FROM FOUNDATION TO SECOND FLOOR TOP PLATE. (7" EMBEDMENT)
- * = 1/2" THREADED ROD FROM FOUNDATION TO DOUBLE TOP PLATE. (12" EMBEDMENT)
- ⊗ = 1/2" THREADED ROD FROM FOUNDATION TO SECOND FLOOR TOP PLATE. (12" EMBEDMENT)

TYPICAL THREADED ROD NOTES:

1. IF HEADER LENGTH EXCEEDS ROD SPACING NOTED THEN SST- SPH4 OR SST- LST118 SHALL BE INSTALLED FROM HEADER TO TOP PLATE TO ACHIEVE PROPER SPACING
2. IF SPACING OF THREADED RODS EXCEED 5'-0" THEN ADDITIONAL ANCHORS SHALL BE ADDED TO THE SILL AT A MAXIMUM SPACING OF 5'-0". USE 1/2" EPOXIED ANCHORS WITH A 5" EMBEDMENT.

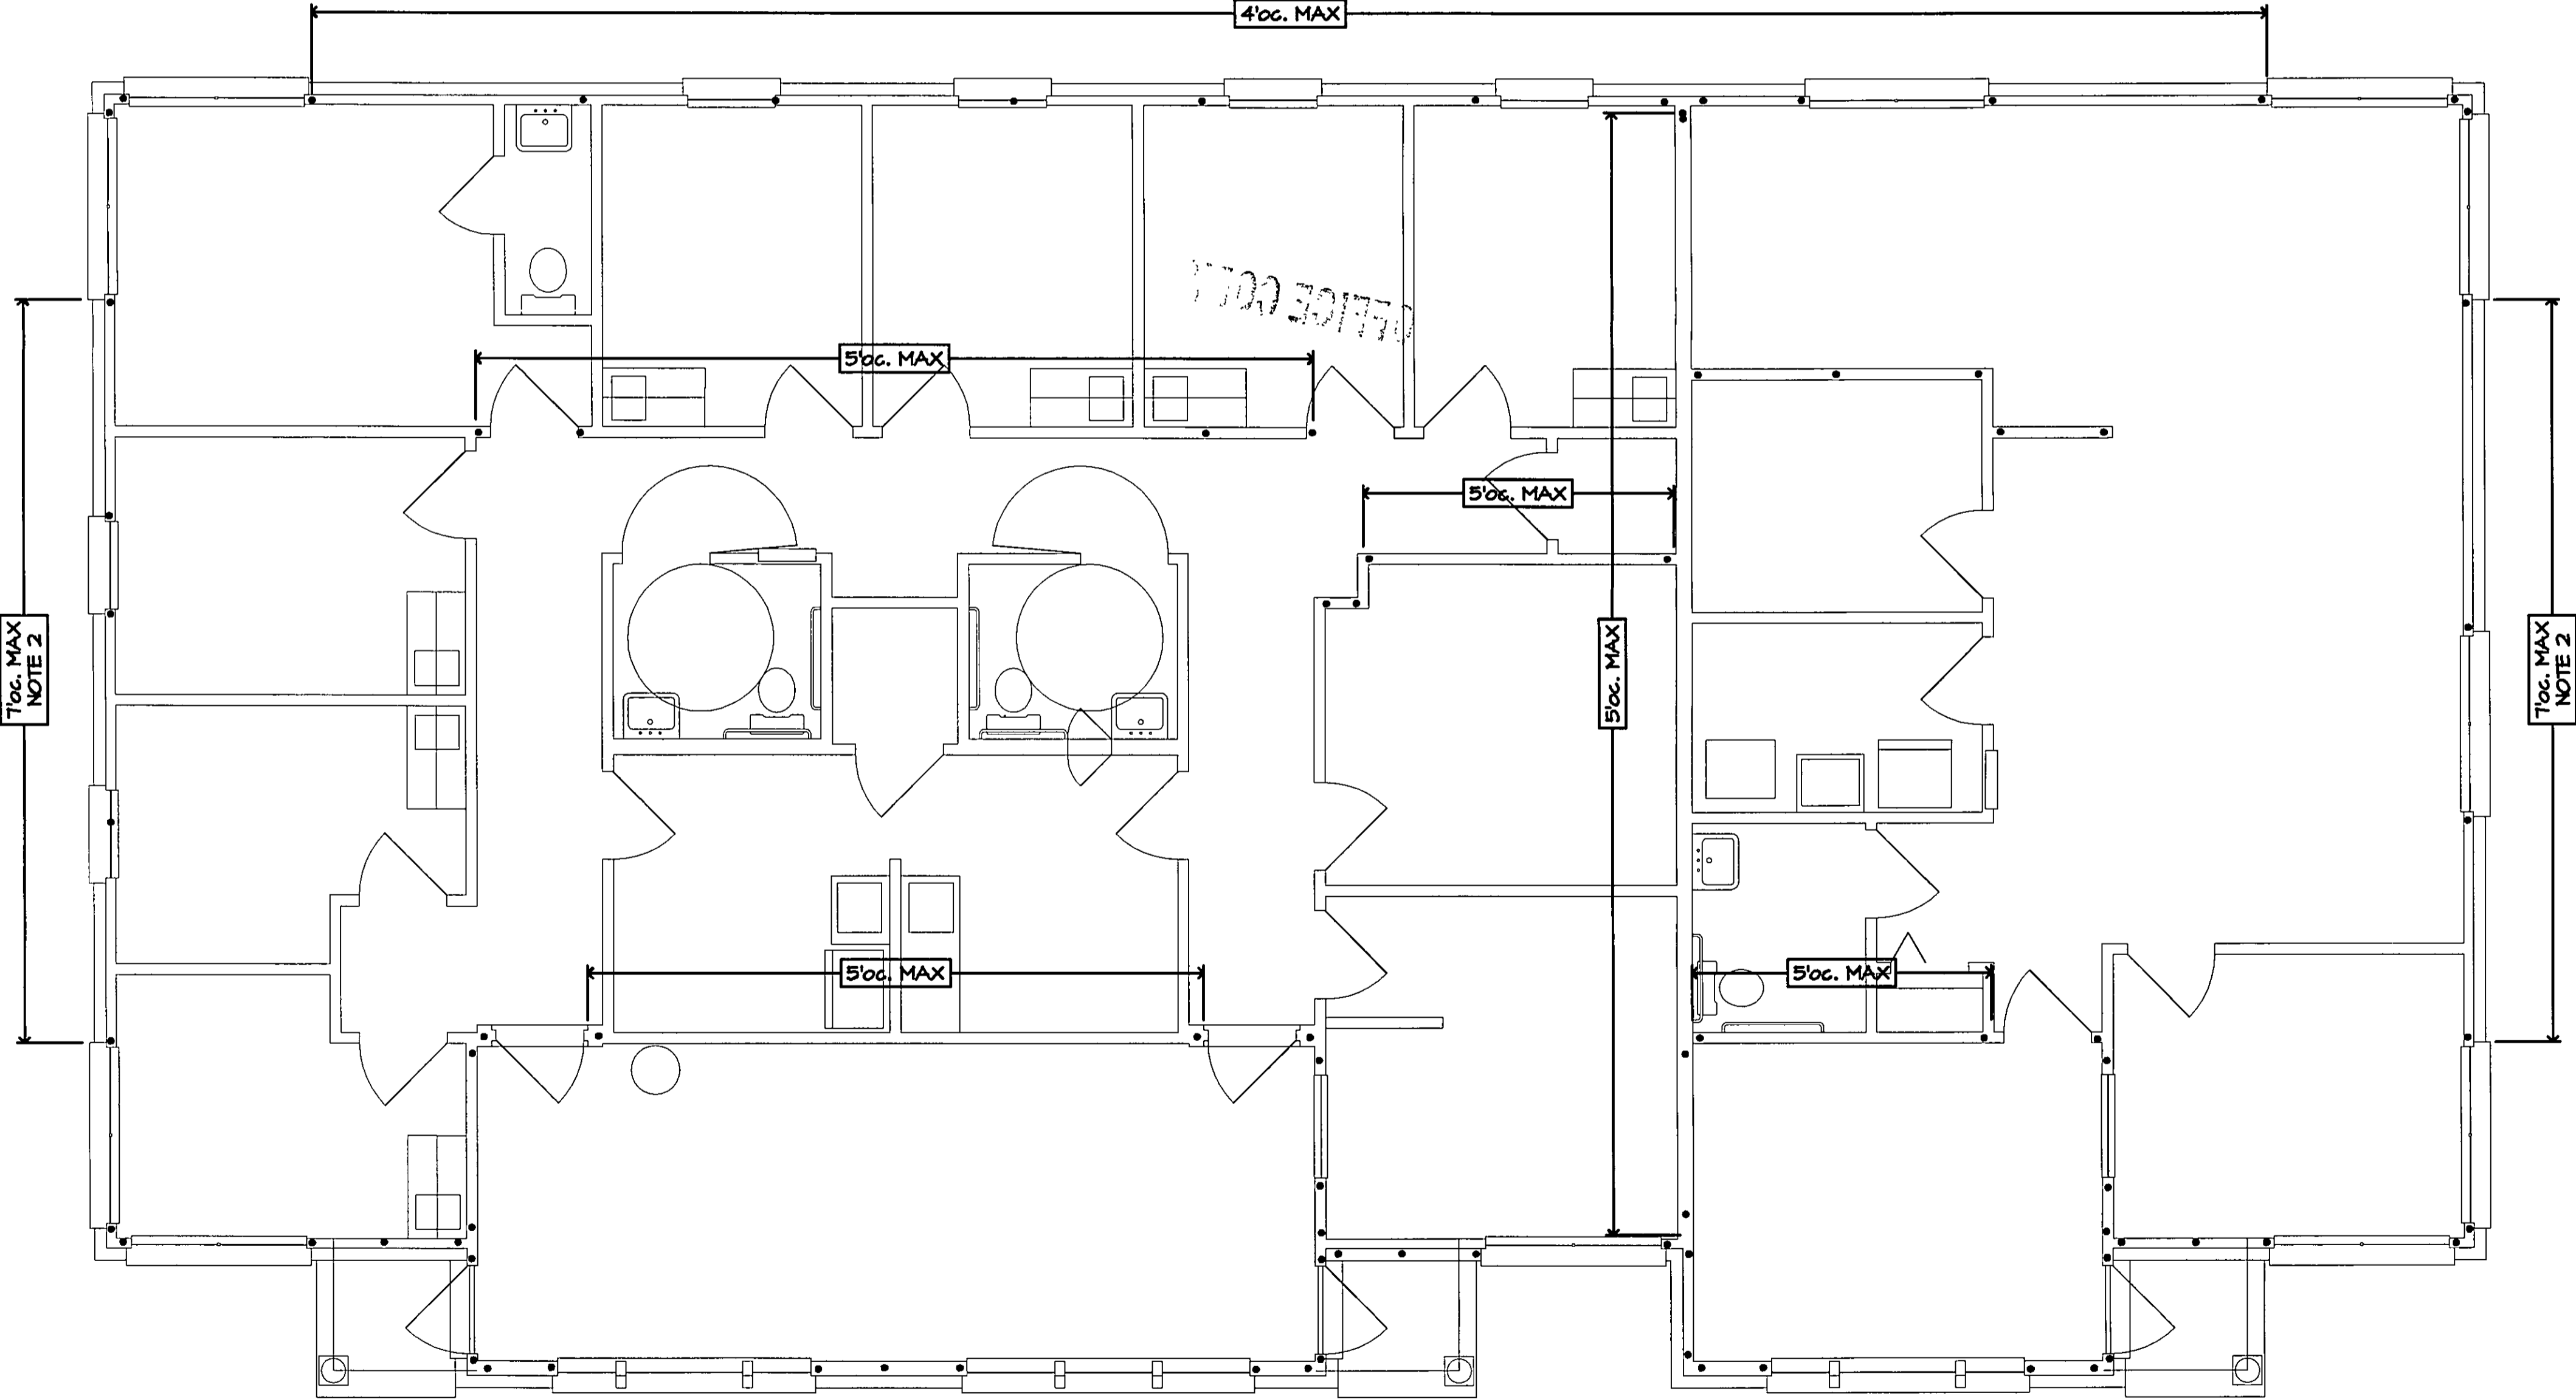

4x4 FT POST ON SIMPSON ABU44 Z POST BASE w/ (2) SIMPSON H6 Z CLIPS AT BEAM ABOVE or USE PER-CAST DETAIL (TYPICAL EACH PORCH)

DESCRIPTION:
THREADED ROD LAYOUT
 JOB:
LANDMARK HOMES (THREE UNIT - TWO TENANTS) BUILDING 800 (SOUTHLAKE OFFICE CENTER)

HULSBURG ENGINEERING, INC.
 (FL. CERT. # 25846)
 2955 HARTLEY RD., SUITE 202
 JACKSONVILLE, FL 32257
 Ph. (904) 886-2401 Fax (904) 260-4367
 FLOYD S. SIMPSON, P.E. (FL. P.E. No. 50791)
 JEFFREY K. HULSBURG, P.E. (FL. P.E. No. 33152)

SCALE:
 1/4" = 1'-0"
 • U.O.N.
 • DO NOT SCALE THIS DRAWING
 RELEASE DATE:
 04-19-04

REVISION DATE:
 00-00-00
 DRAWN BY:
 DJM II

NOTICE TO ALL CONTRACTORS
 REVIEW & APPROVAL BY THE AUTHORITY HAVING JURISDICTION SHALL NOT RELIEVE THE APPLICANT OF THE RESPONSIBILITY OF COMPLIANCE WITH THE FIRE CODE.
 REVIEWED BY: John Rulley, Plans Examiner, 30883 ST. JOHNS COUNTY FIRE RESCUE

CHECKED BY:
 JKH
 SHEET:
S-3