


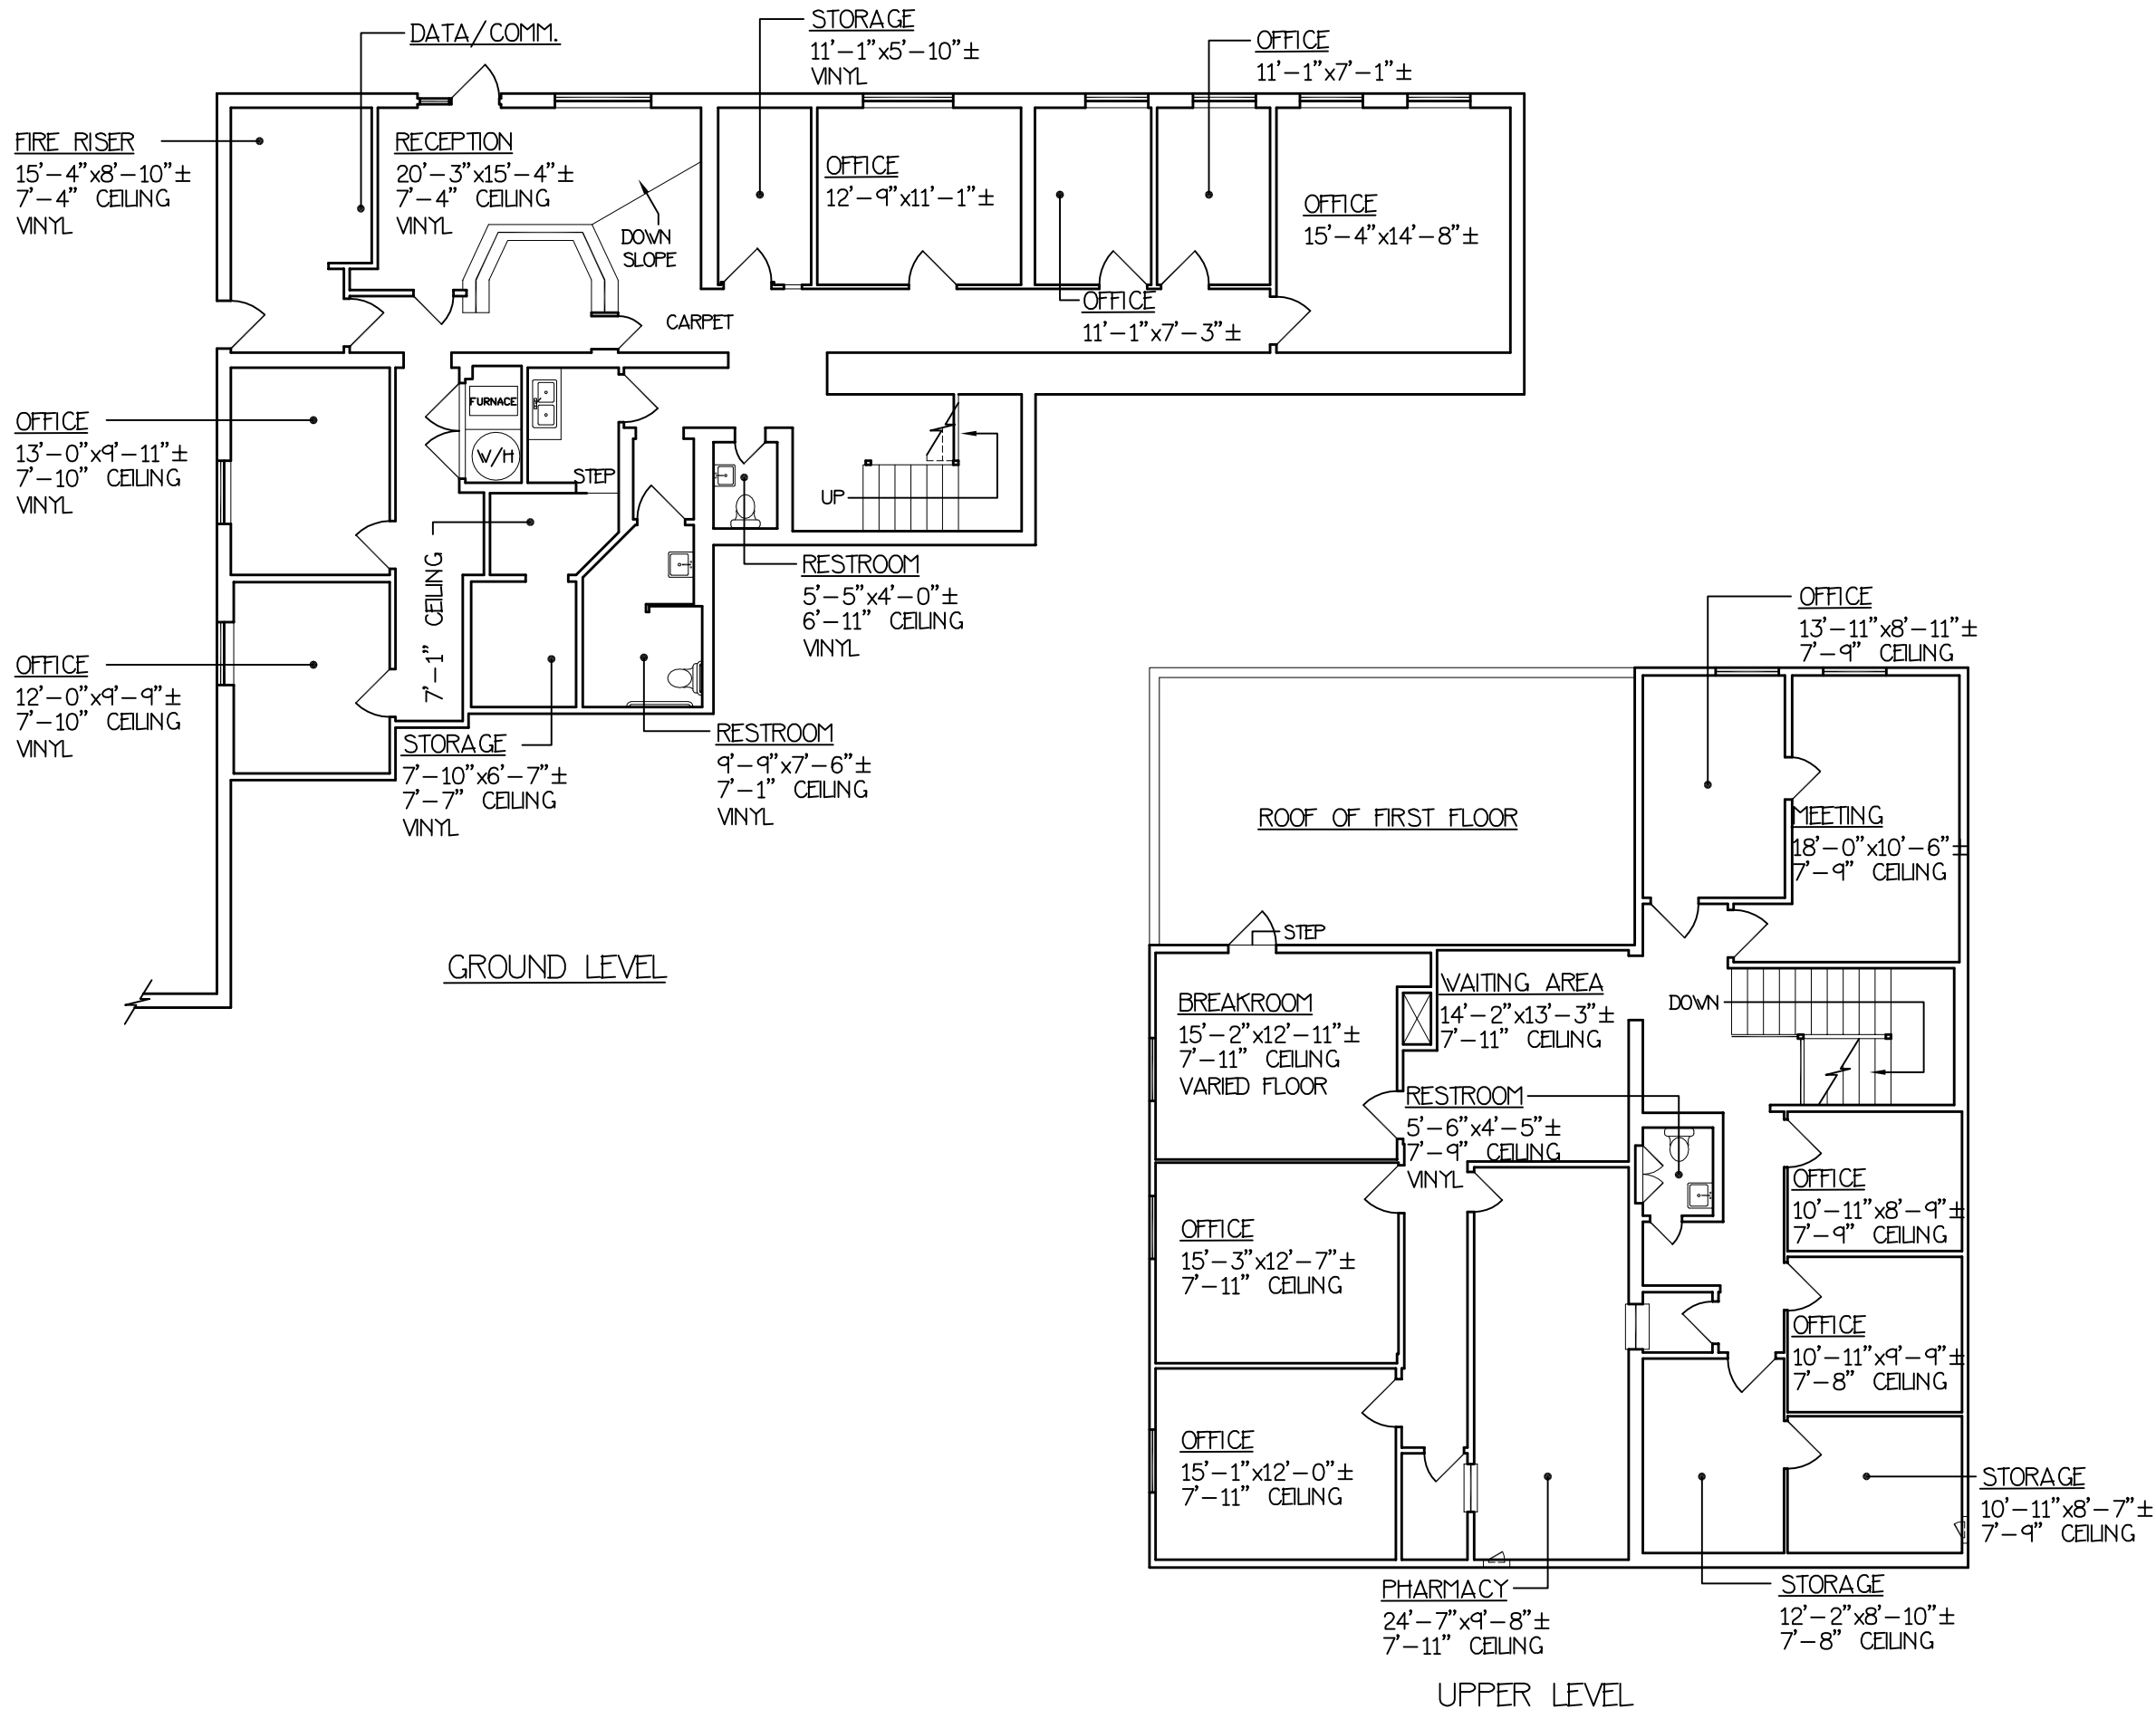

NOTES

1. ALL CALCULATIONS INDICATE "GROSS RETAIL" AREA AS PER "BOMA" STANDARDS.
2. ALL FIXTURES INDICATED ARE BUILT-IN.
3. ALL FLOORS ARE CARPET UNLESS OTHERWISE INDICATED.
4. ALL CEILING HEIGHTS ARE 8'-0" UNLESS OTHERWISE NOTED.
5. ALL DIMENSIONS TO BE FIELD VERIFIED PRIOR TO ANY CONSTRUCTION.
6. AREA CALCULATIONS EXCLUDE ANY VERTICAL PENETRATIONS.

AREA CALCULATIONS:

GROUND FLOOR AREA	2256.60 SQ. FT.
UPPER FLOOR AREA	2249.41 SQ. FT.
TOTAL AREA	4506.01 SQ. FT.

ORIENTATION 	MEASURED BY	JR	REFERENCE 1 2 0 6 0
	DESIGNED BY	N.A.	
	DRAFTED BY	JR	
	CHECKED BY	P.M.	
	REVISED:		
SCALE	DATE		
3/32"=1'-0"	03/20/12		



YCD DESIGNS
505-899-1199


PROJECT:
630 HAINES AVE. NW

DESCRIPTION:
AS-BUILT DRAWING

CLIENT:
HANNA COMMERCIAL

SHEET #
01
OF 01

YCD DESIGNS
505-899-1199

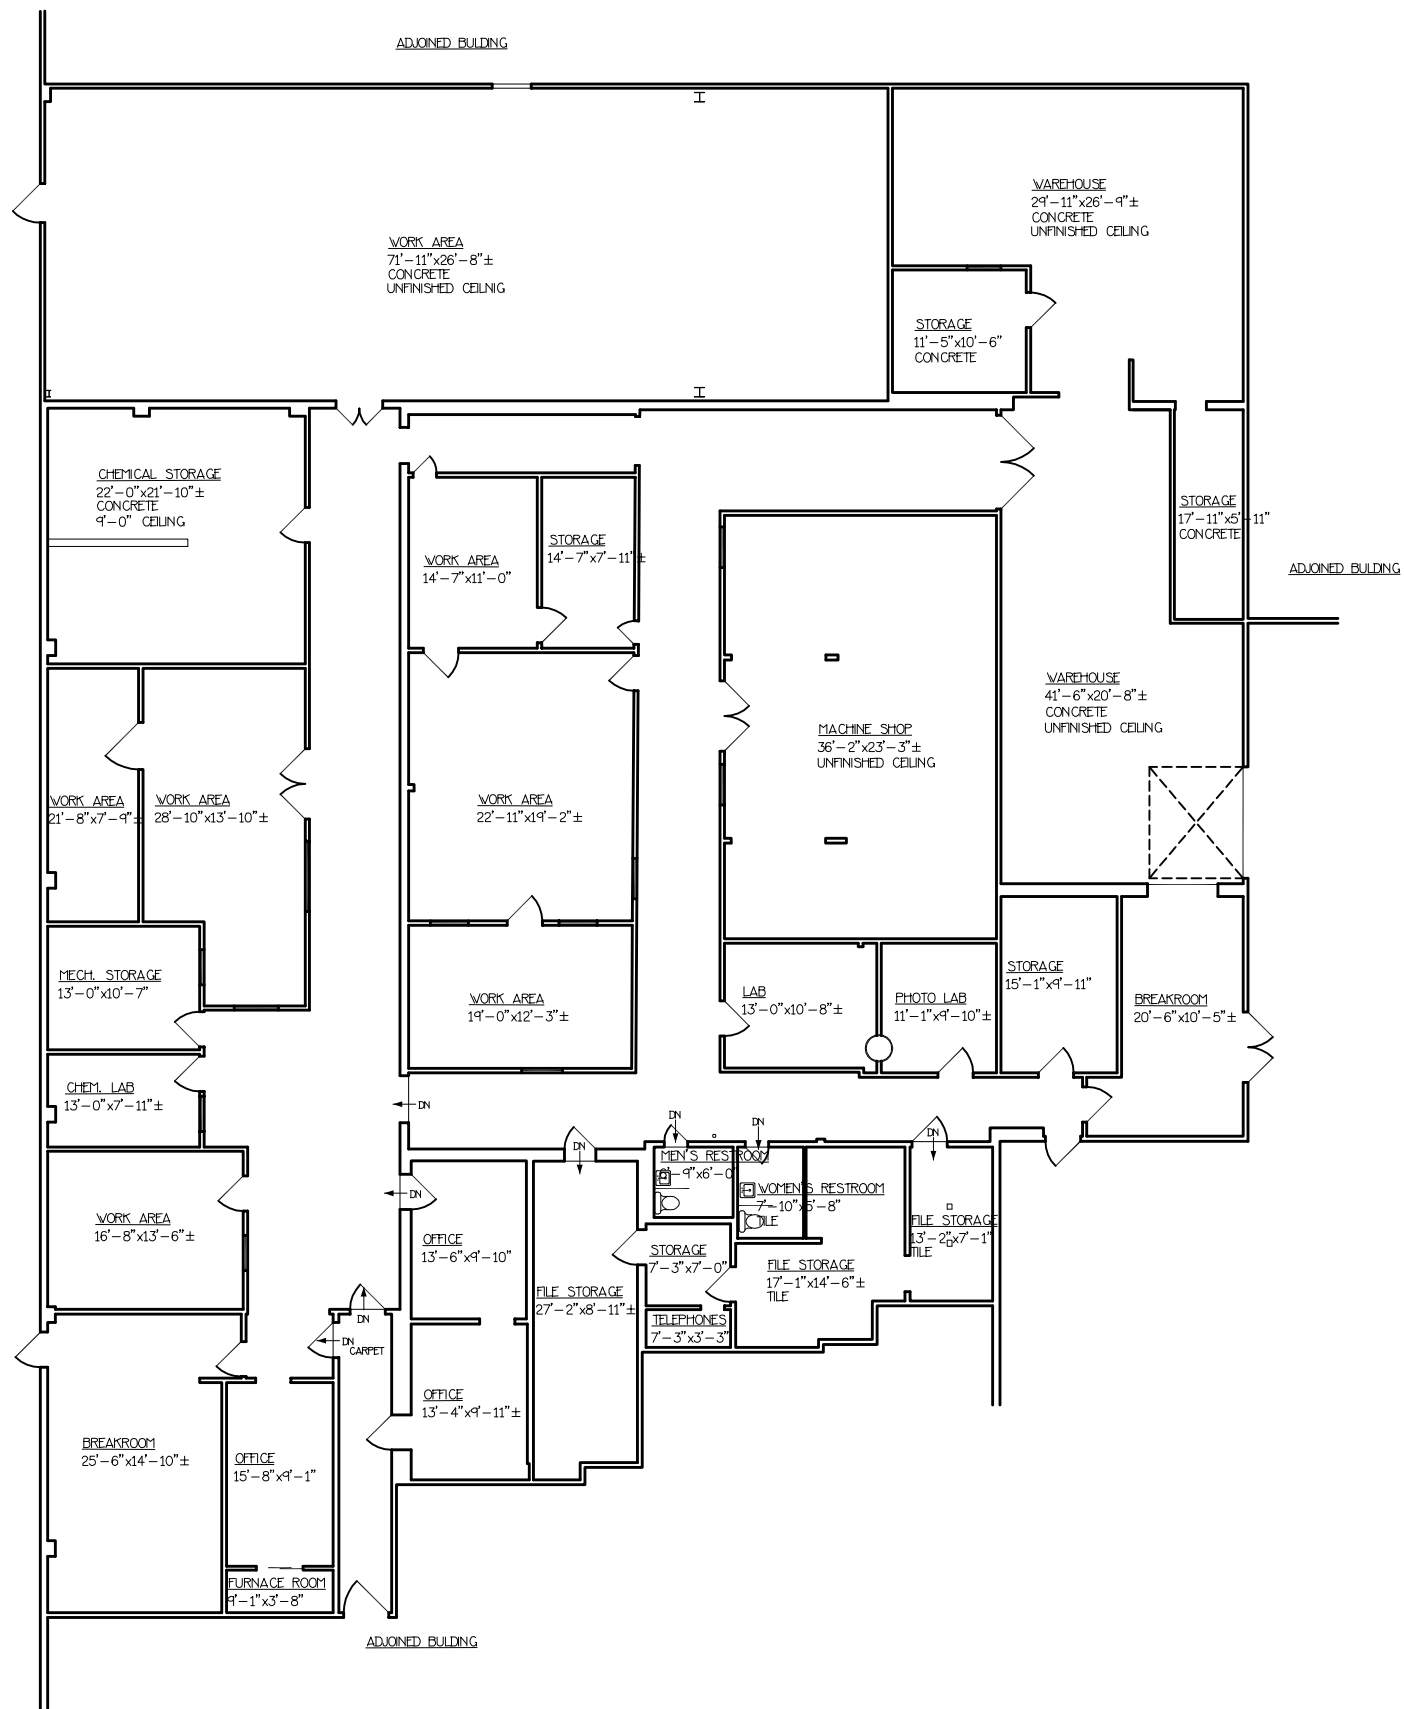

NOTES

1. ALL CALCULATIONS INDICATE "GROSS RETAIL" AREA AS PER "BOMA" STANDARDS.
2. ALL FIXTURES INDICATED ARE BUILT-IN.
3. ALL FLOORS ARE VINYL UNLESS OTHERWISE INDICATED.
4. ALL CEILINGS 8'-0" UNLESS OTHERWISE INDICATED.
5. ALL DIMENSIONS TO BE FIELD VERIFIED PRIOR TO ANY CONSTRUCTION

AREA CALCULATIONS:
11578.54 SQ. FT.

PROJECT:
650 HAINES

DESCRIPTION:
AS-BUILT
DRAWING

CLIENT:
HANNA COMMERCIAL

SHEET #

01
OF 01

CLIENT REFERENCE #

MEASURED BY: D. V.

DRAFTED BY: D. V.

CHECKED BY: M. G.

REVISED ON: / /

SCALE: 1/16" = 1'-0" DATE: 12/19/06


ORIENTATION:



0
6
3
5
7

COMPUTER DRAFTING
& DESIGN BY:

YOUR CAD DRAFTING
CALL: 505-899-1199

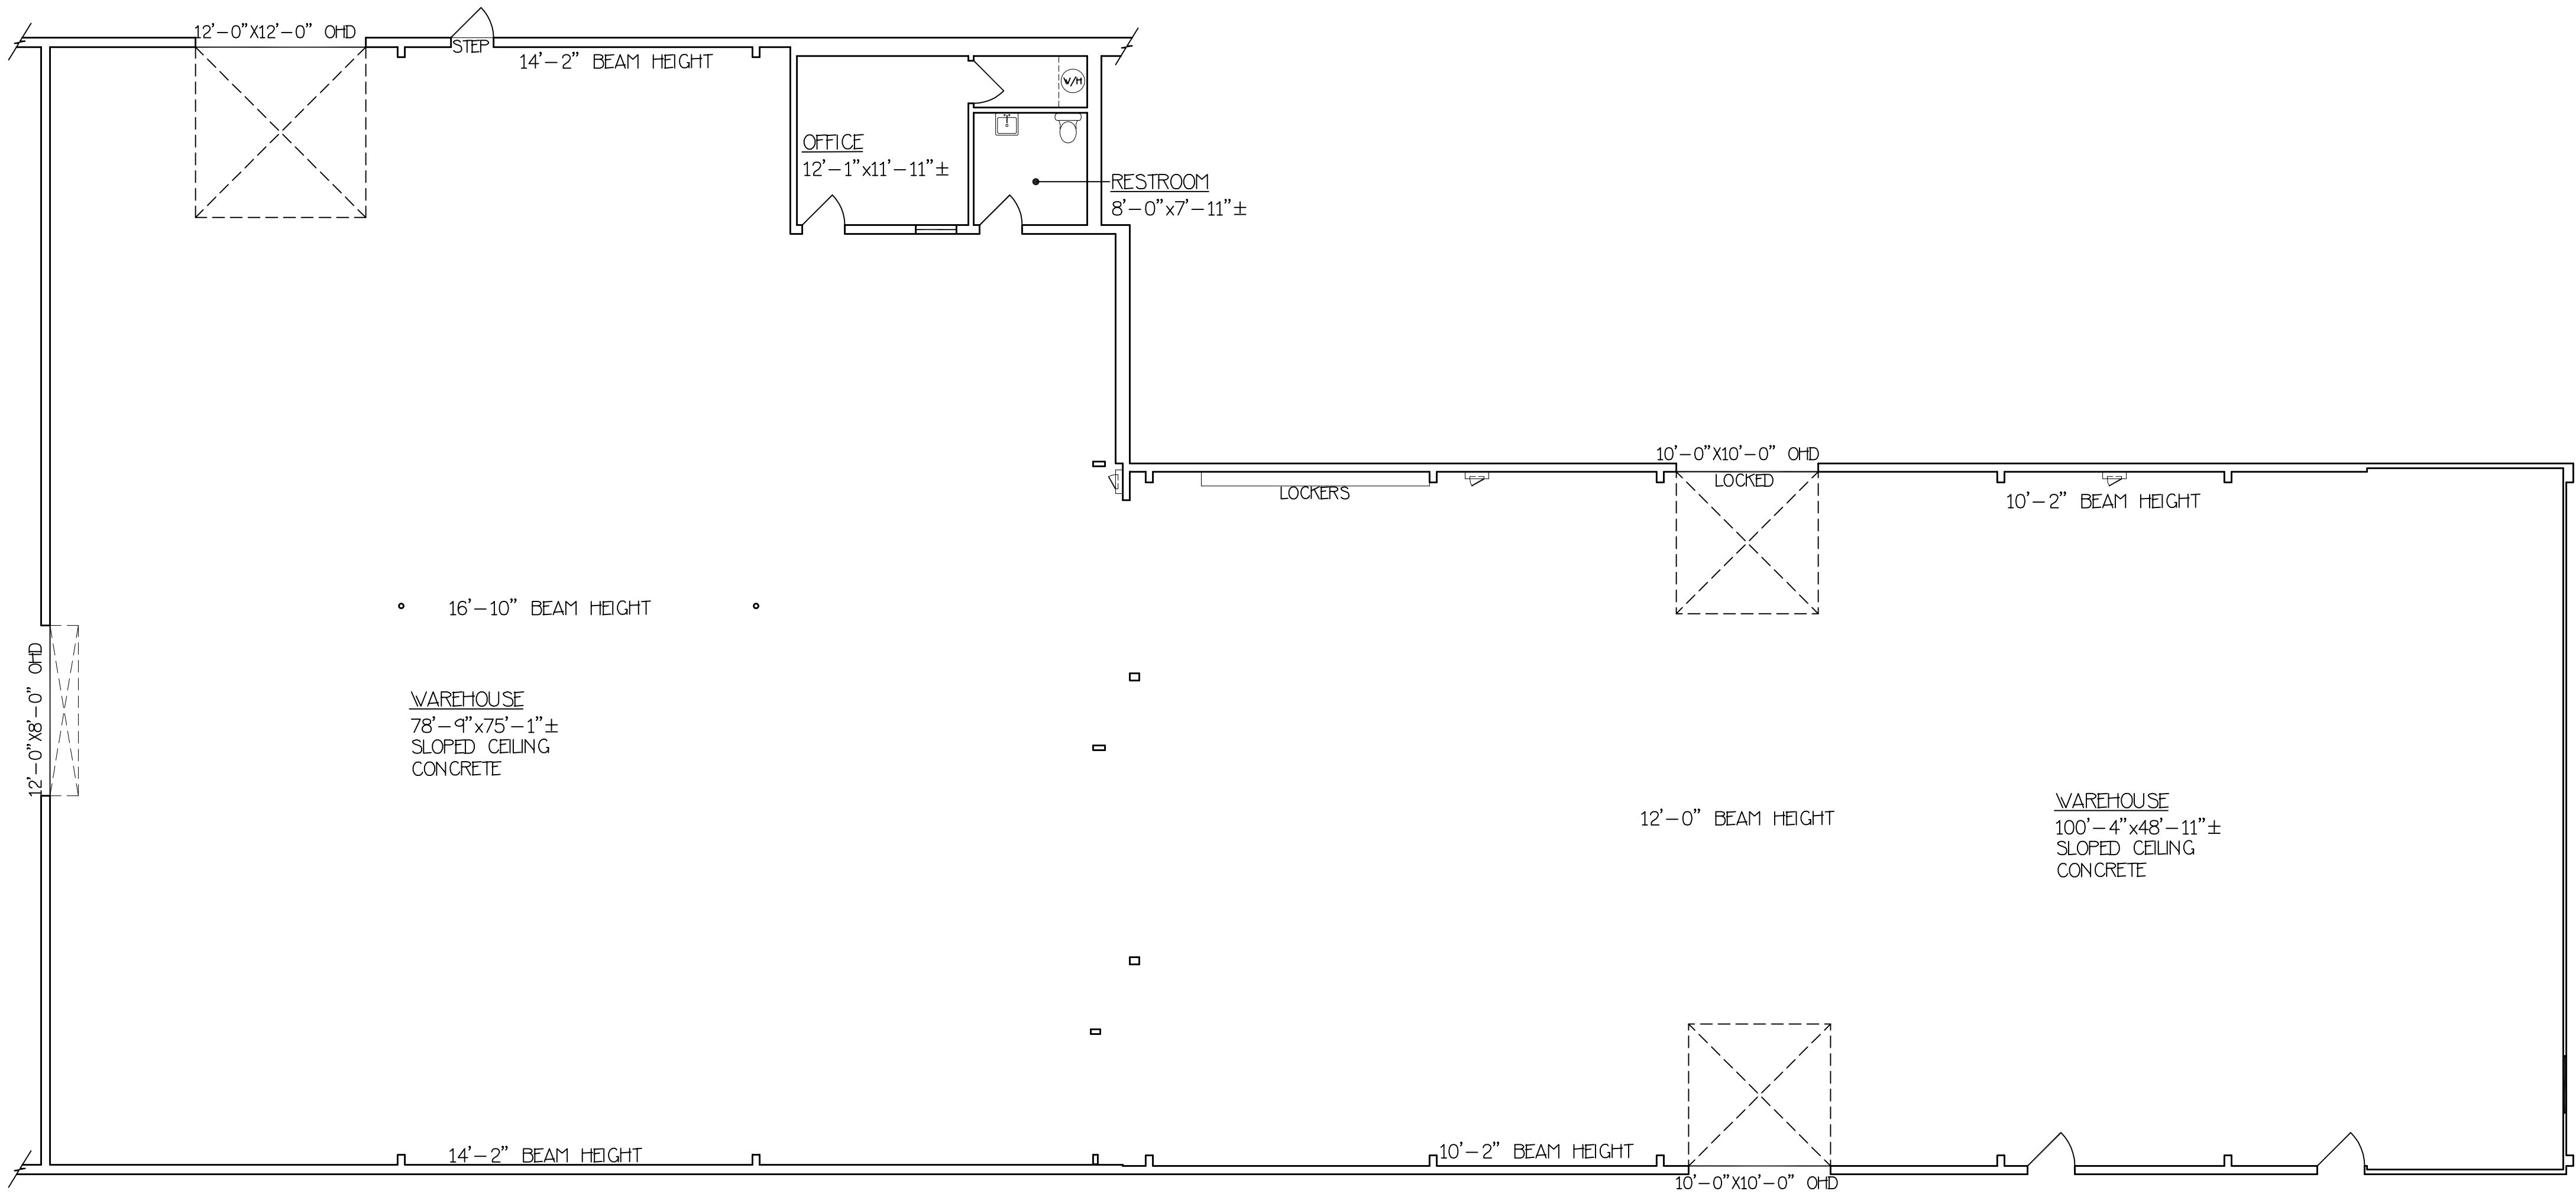

660 HAINES NW

NOTES

1. ALL CALCULATIONS INDICATE "GROSS RETAIL" AREA AS PER "BOMA" STANDARDS.
2. ALL FIXTURES INDICATED ARE BUILT-IN.
3. ALL FLOORS ARE VINYL UNLESS OTHERWISE INDICATED.
4. ALL CEILING HEIGHTS ARE 9'-1" UNLESS OTHERWISE NOTED.
5. ALL DIMENSIONS TO BE FIELD VERIFIED PRIOR TO ANY CONSTRUCTION.

AREA CALCULATIONS:

TOTAL AREA 11117.96 SQ. FT.

PROJECT:
**660
HAINES NW**


DESCRIPTION:
**AS-BUILT
DRAWING**

CLIENT:
**HANNA
COMMERCIAL**


SHEET #
01
OF 01

ORIENTATION	MEASURED BY	JR	REFERENCE
	DESIGNED BY	N.A.	1
	DRAFTED BY	JR	1
	CHECKED BY	P.M.	0
	REVISED:		9
SCALE	DATE		9
1/8"=1'-0"	05/06/11		


YCD DESIGNS
505-899-1199

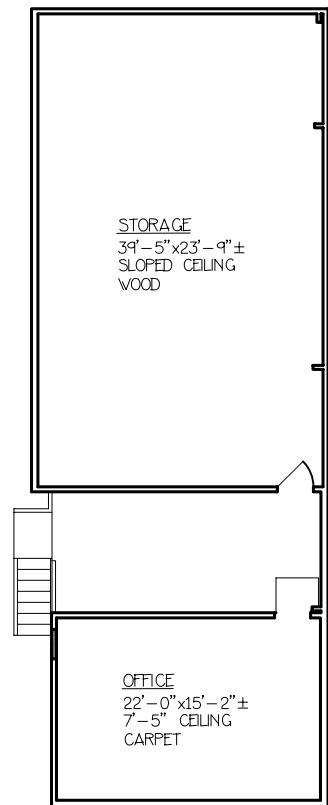

AREA CALCULATIONS:
AREA 1600.86 SQ. FT.

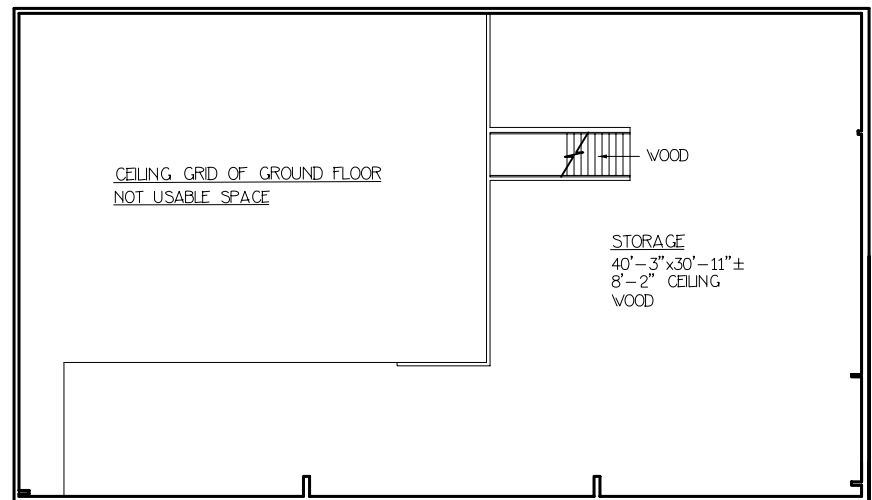

AREA CALCULATIONS:
AREA 1668.92 SQ. FT.

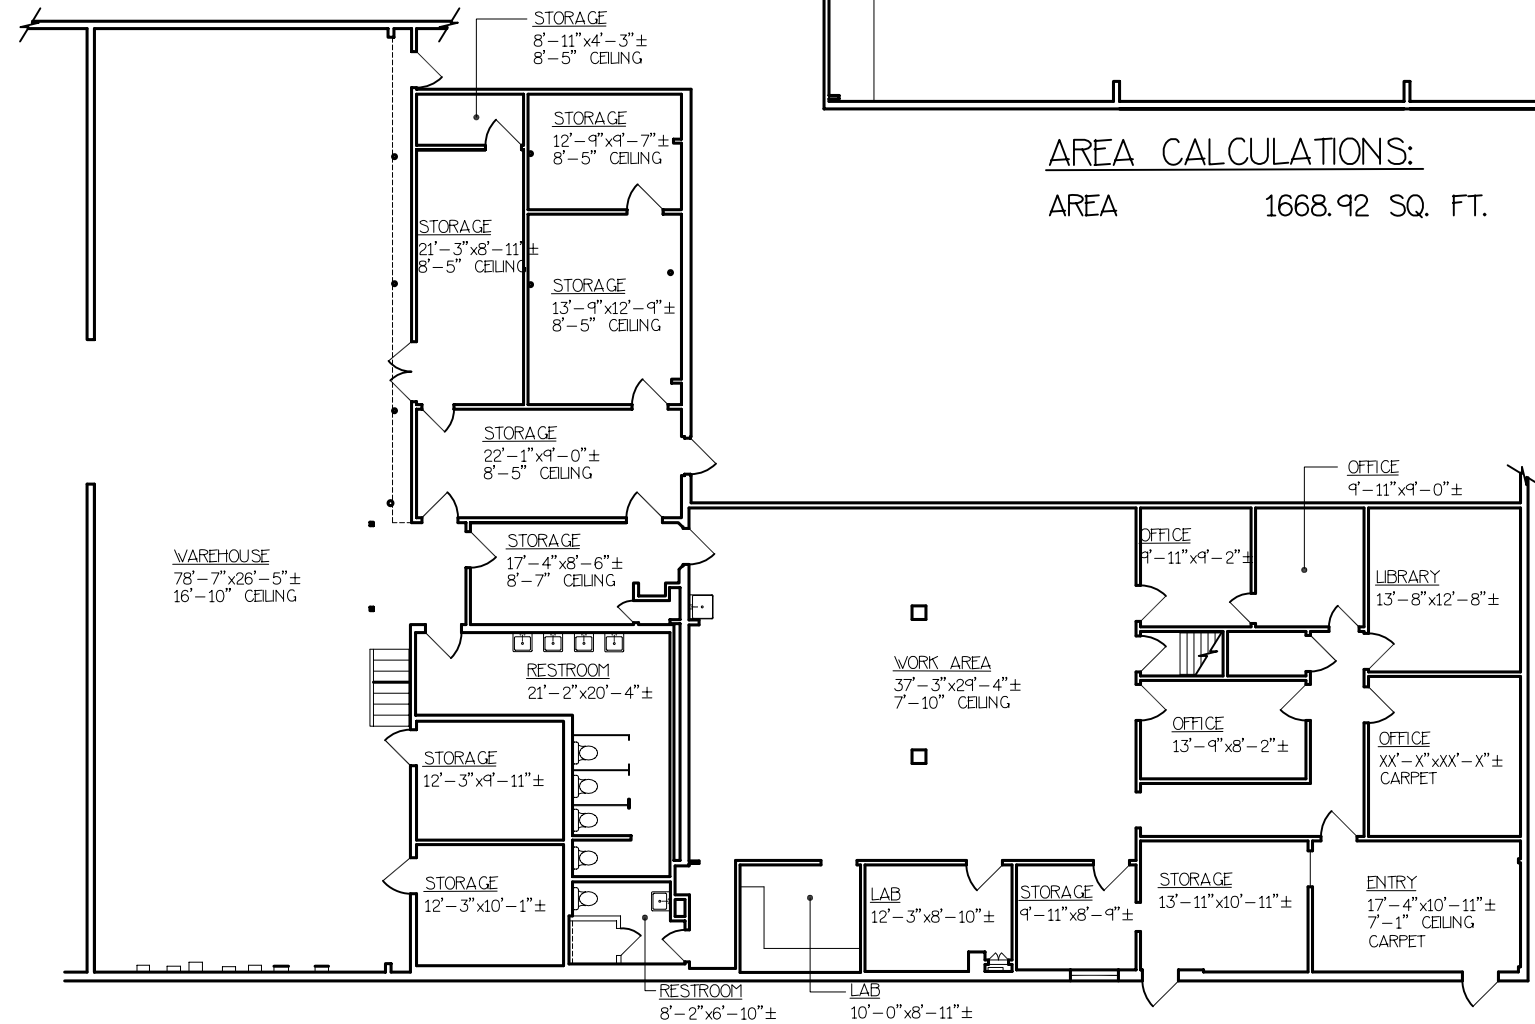

AREA CALCULATIONS:
WAREHOUSE 2154.42 SQ. FT.
OFFICE 4435.22 SQ. FT.

- NOTES
1. ALL CALCULATIONS INDICATE "GROSS RETAIL" AREA AS PER "BOMA" STANDARDS.
 2. ALL FIXTURES INDICATED ARE BUILT-IN.
 3. ALL FLOORS ARE VINYL UNLESS OTHERWISE INDICATED.
 4. ALL CEILING HEIGHTS ARE 8'-0" UNLESS OTHERWISE NOTED.
 5. ALL DIMENSIONS TO BE FIELD VERIFIED PRIOR TO ANY CONSTRUCTION.


PROJECT:
680 HAINES N.W.

DESCRIPTION:
AS-BUILT DRAWING

CLIENT:
HANNAH COMMERCIAL

SHEET #
01
OF 01

MSR'D BY: D. G.		R E V I S I O N S	0 8 1 9 4	COMPUTER DRAFTING & DESIGN BY: CALL: 505-899-1199
DRAFTED BY: D. G.				
CHECKED BY: P.M.				
REVISED ON: / /				
SCALE: 1/16" = 1'-0"		DATE: 06/05/08		

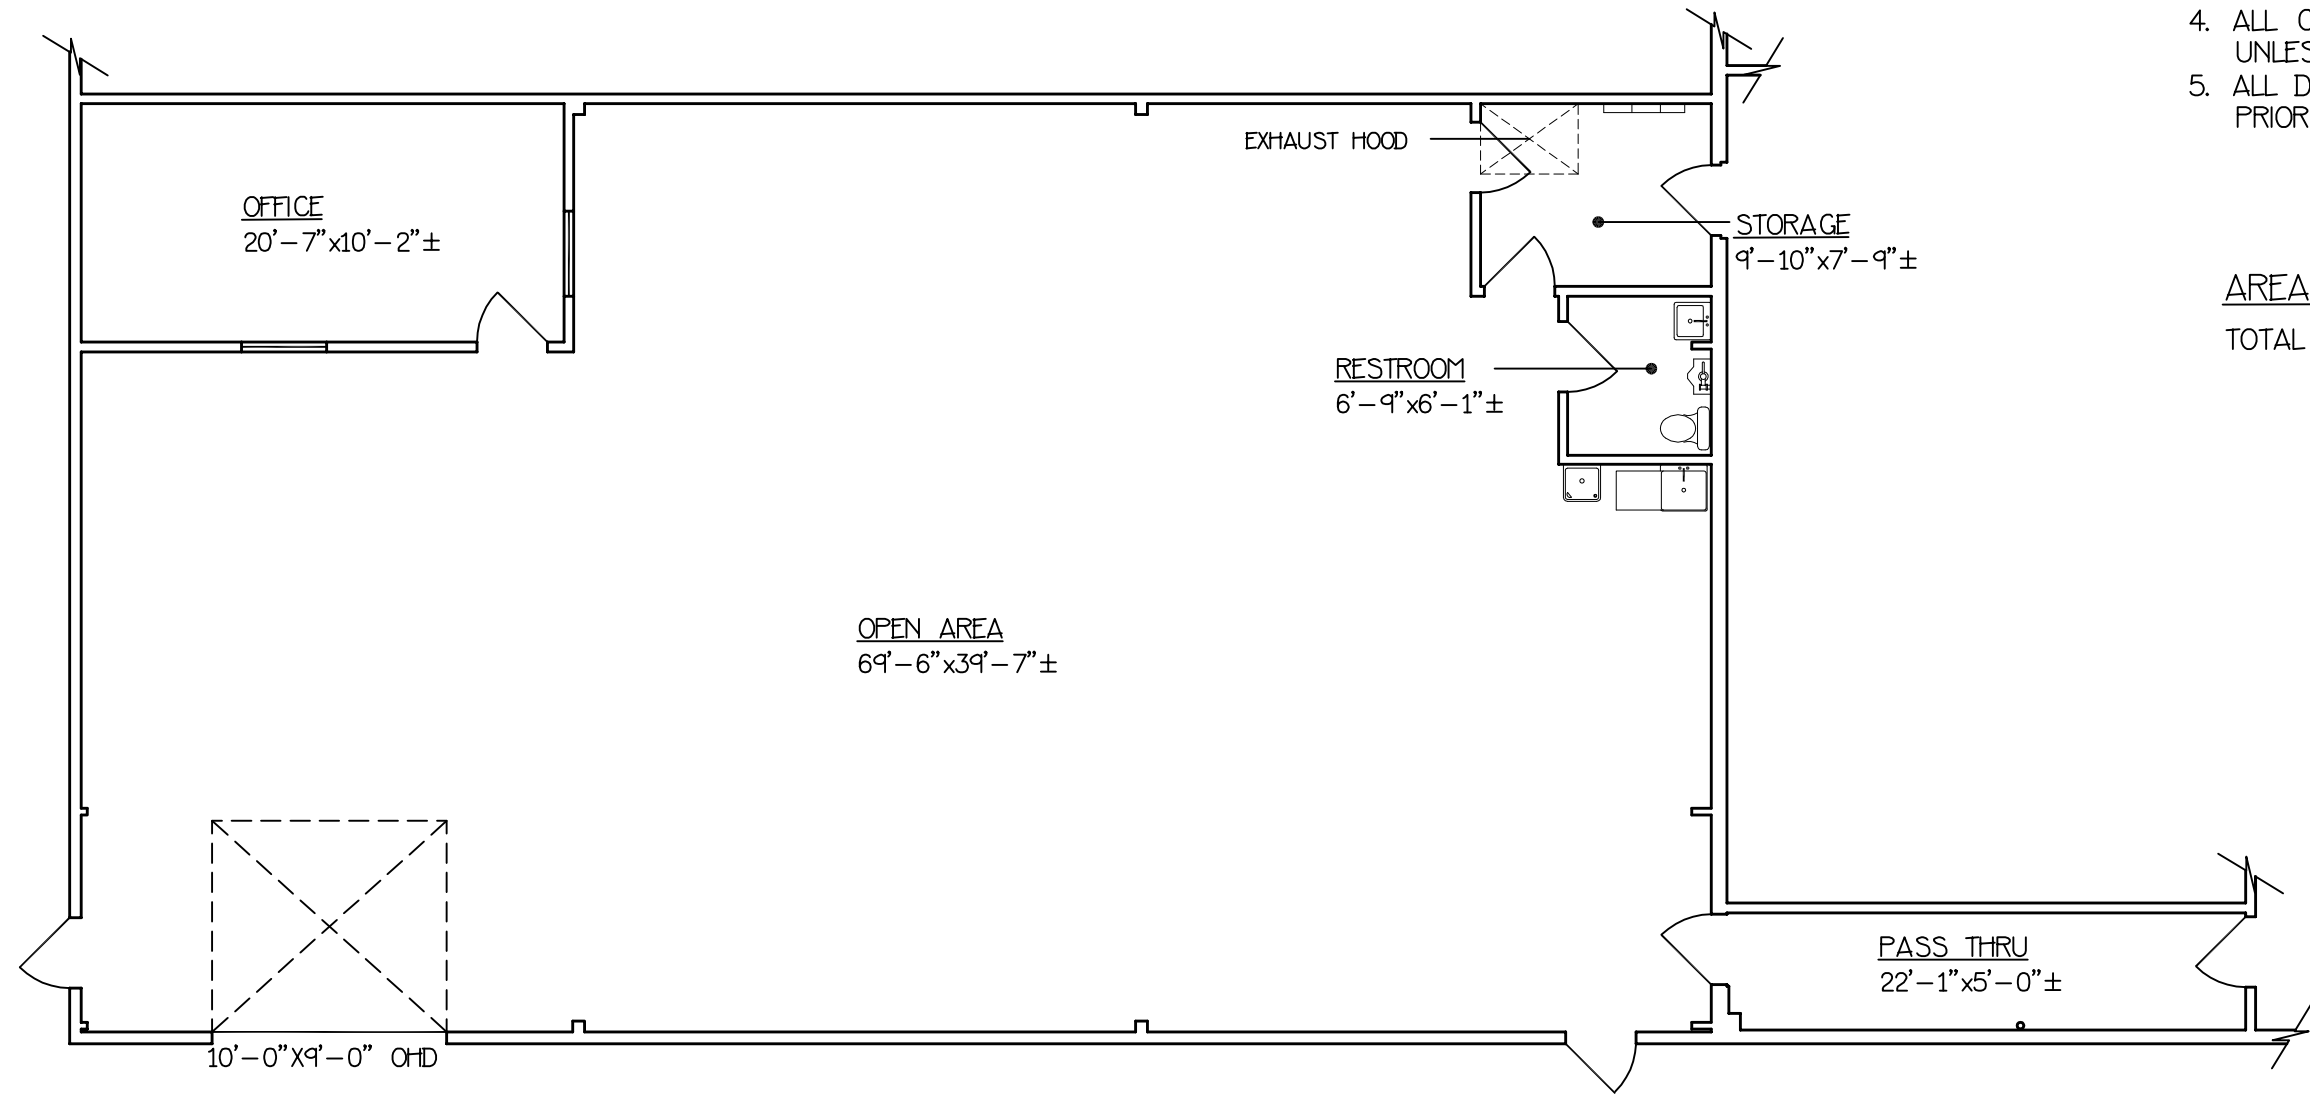

1770 SEVENTH STREET NW

NOTES

1. ALL CALCULATIONS INDICATE "GROSS RETAIL" AREA AS PER "BOMA" STANDARDS.
2. ALL FIXTURES INDICATED ARE BUILT-IN.
3. ALL FLOORS ARE VINYL UNLESS OTHERWISE INDICATED.
4. ALL CEILING HEIGHTS ARE 9'-2" UNLESS OTHERWISE NOTED.
5. ALL DIMENSIONS TO BE FIELD VERIFIED PRIOR TO ANY CONSTRUCTION.

AREA CALCULATIONS:

TOTAL AREA 2965.12 SQ. FT.

PROJECT:

1770
SEVENTH
STREET NW

DESCRIPTION:

AS-BUILT
DRAWING

CLIENT:

HANNA
COMMERCIAL

SHEET #

01

OF 01

	MEASURED BY	JR	REFERENCE # 3
	DESIGNED BY	N.A.	
	DRAFTED BY	JR	
	CHECKED BY	P.M.	
	REVISED:		
SCALE	DATE		
1/8" = 1'-0"	05/05/11		



YCD DESIGNS
505-899-1199