


West Building

2105 AZTEC ROAD NE, WEST BLDG.

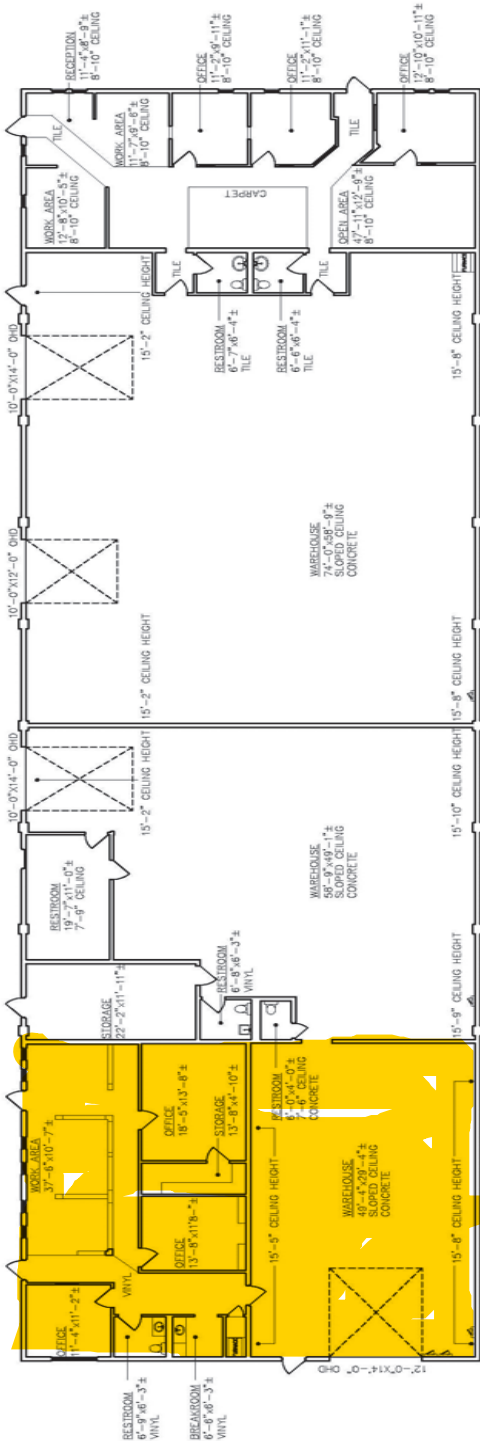

NOTES

1. ALL CALCULATIONS INDICATE "GROSS RETAIL" AREA AS PER "BOMA" STANDARDS.
2. ALL FIXTURES INDICATED ARE BUILT-IN.
3. ALL FLOORS ARE CARPET UNLESS OTHERWISE INDICATED.
4. ALL CEILING HEIGHTS ARE 8'-0"
5. ALL DIMENSIONS TO BE FIELD VERIFIED PRIOR TO ANY CONSTRUCTION.

AREA CALCULATIONS:

NORTH OFFICE AREA	2110.00 SQ. FT.
NORTH WAREHOUSE AREA	3894.86 SQ. FT.
SOUTH OFFICE AREA	1698.48 SQ. FT.
SOUTH WAREHOUSE AREA	4312.35 SQ. FT.
TOTAL AREA	12,015.69 SQ. FT.

PROJECT:
2105
AZTEC ROAD NE
WEST
BLDG.

DESCRIPTION:
AS-BUILT
DRAWING

CLIENT:
COMMERCIAL
REAL
ESTATE
MANAGEMENT


YCD DESIGNS
505-899-1199

SHEET #	01	OF	01
ORIGINATOR	MEASURED BY	JR	1
	DESIGNED BY	N.A.	1
	DRAFTED BY	JR	0
	CHECKED BY	P.M.	0
	REVISED		
SCALE	DATE		
1/16"=1'-0"	01/06/10		