




TRACHTENBERG
ARCHITECTS

2421 Fourth Street
Berkeley, California 94710
Tel: 510.649.1414
Fax: 510.649.0604
www.TrachtenbergArch.com

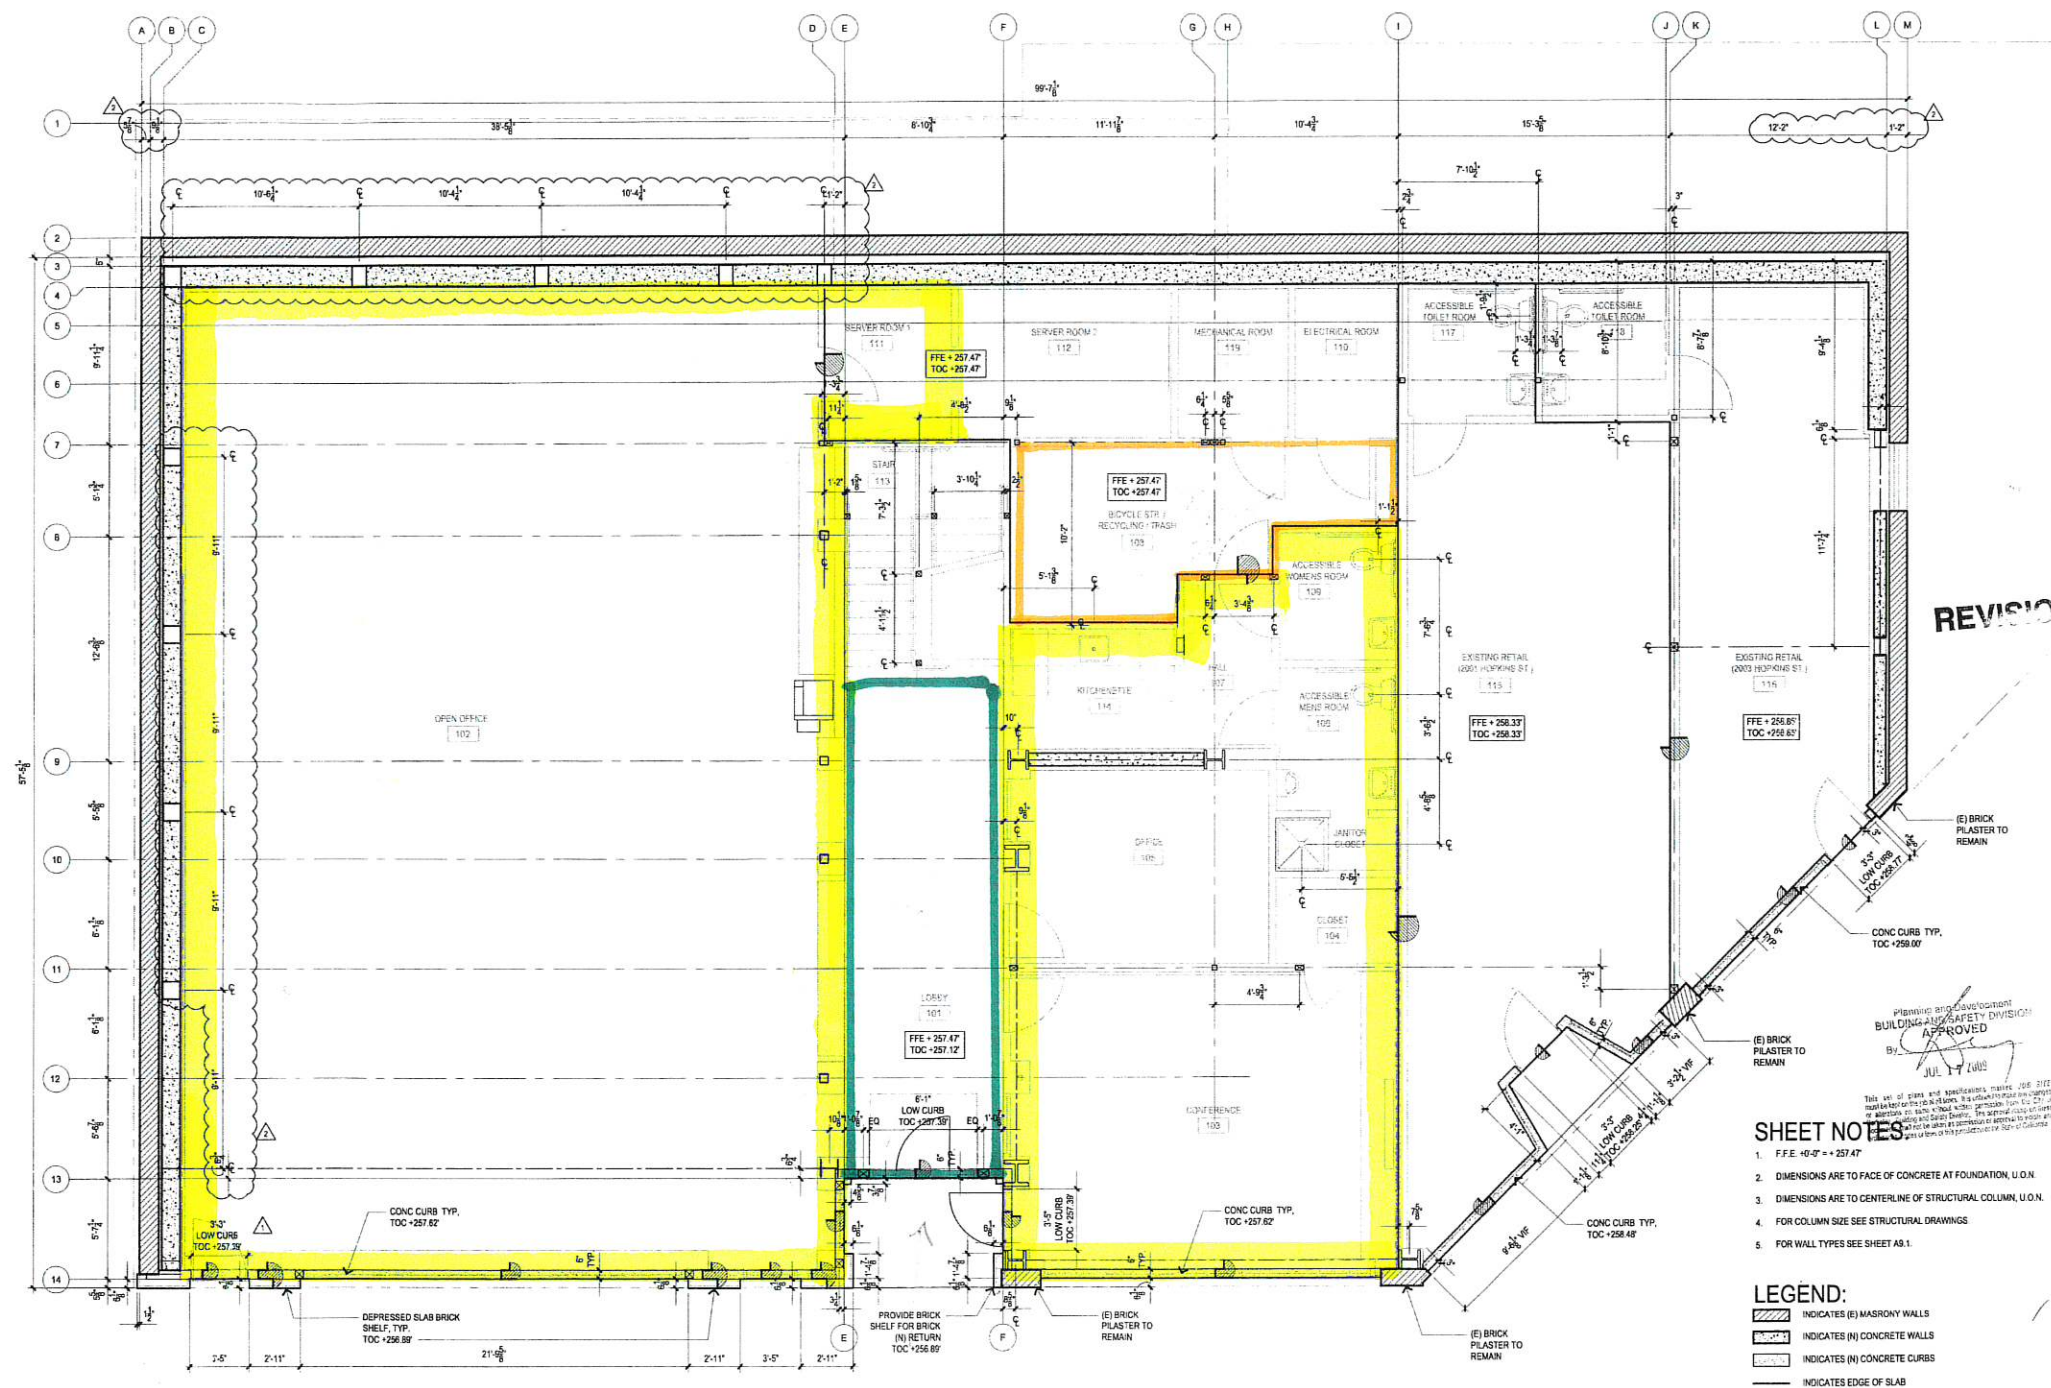

TOM SAWYER
SOFTWARE

1995-1999 El Dorado Ave.
Berkeley, CA

REVISIONS

- 10.15.08 PERMIT SET
- 01.15.09 PLAN CHECK COMMENTS
- 05.10.09 STRUCTURAL REVISIONS

SHEET NOTES

- FFE: 10'-0" = +257.47'
- DIMENSIONS ARE TO FACE OF CONCRETE AT FOUNDATION, U.O.N.
- DIMENSIONS ARE TO CENTERLINE OF STRUCTURAL COLUMN, U.O.N.
- FOR COLUMN SIZE SEE STRUCTURAL DRAWINGS
- FOR WALL TYPES SEE SHEET A8.1

LEGEND:

- INDICATES (E) MASONRY WALLS
- INDICATES (N) CONCRETE WALLS
- INDICATES (N) CONCRETE CURBS
- INDICATES EDGE OF SLAB

ALL DRAWINGS AND WRITTEN MATERIAL APPEARING HEREIN CONSTITUTE ORIGINAL AND UNPUBLISHED WORK OF THE ARCHITECT AND MAY NOT BE DUPLICATED, USED OR DISCLOSED WITHOUT WRITTEN CONSENT OF TRACHTENBERG ARCHITECTS.

JOB: 0706

SHEET:

GROUND FLOOR
SLAB PLAN

A2.0

1
A2.0
GROUND FLOOR SLAB PLAN
1/8" = 1'-0" @ 11X17 1/4" = 1'-0" @ 24X36
0 2 4 8



JOB SITE