




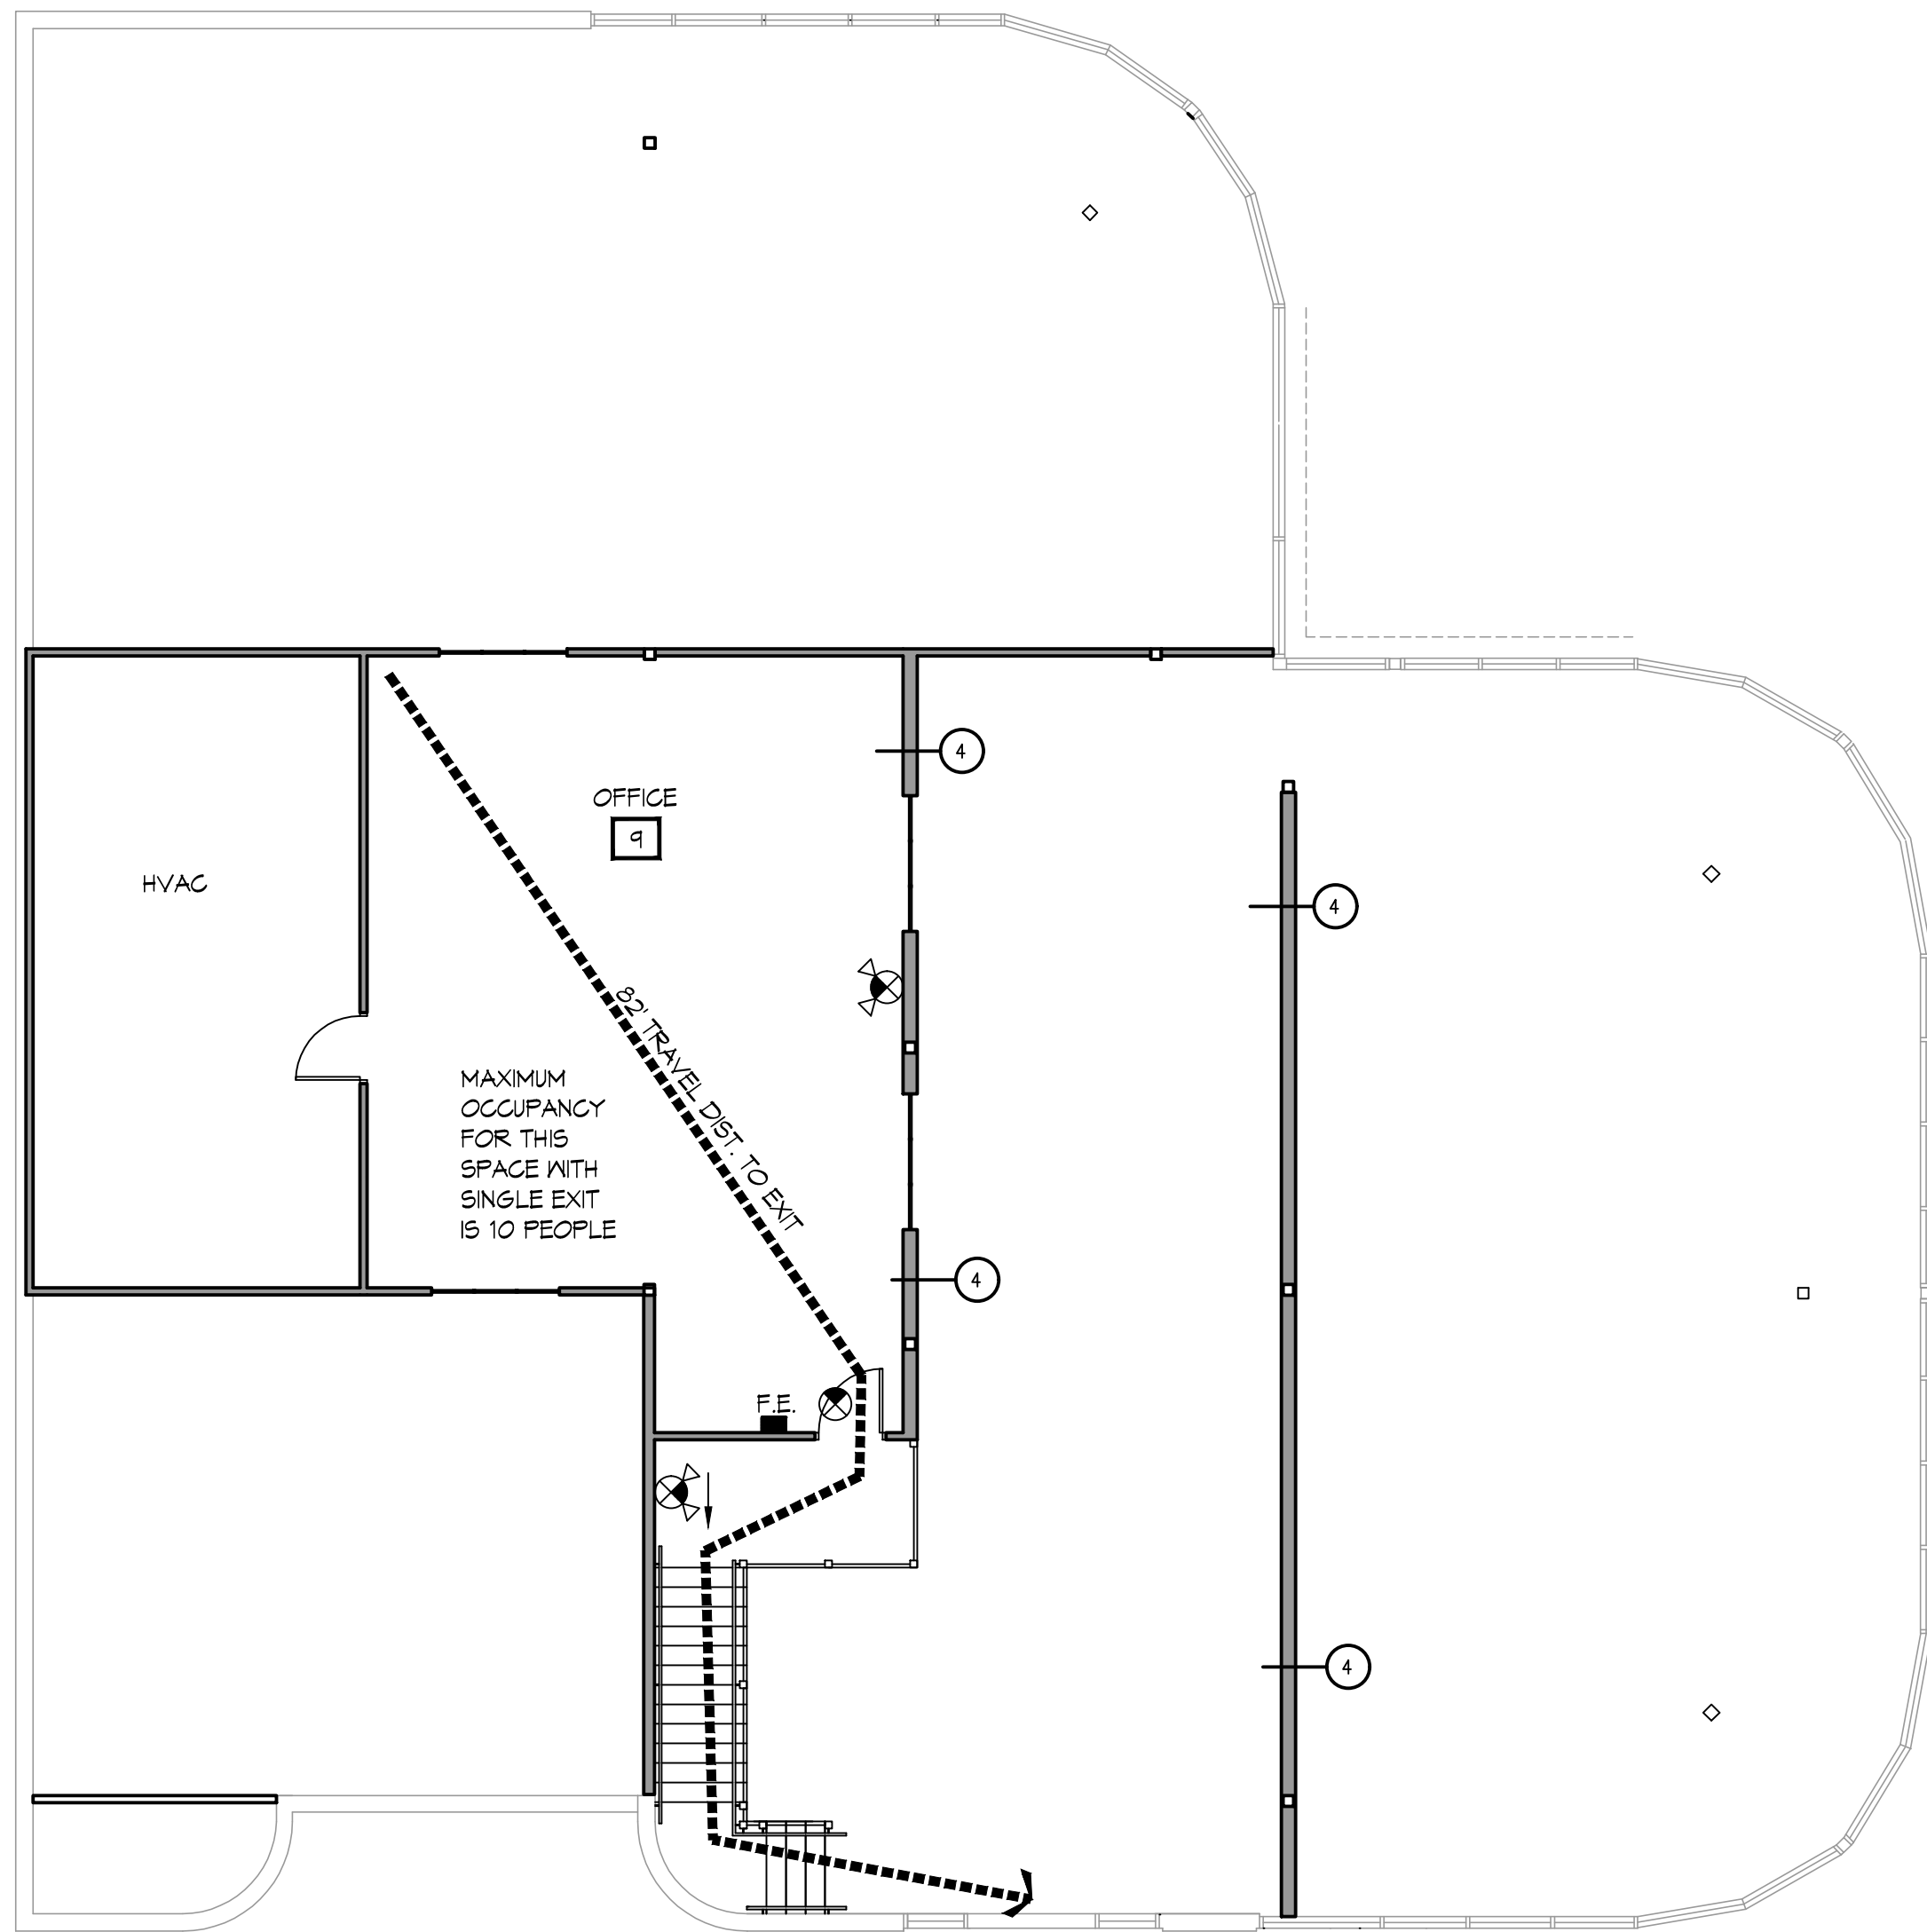


2 SECOND FLOOR
A0.1 SCALE: 1/8"=1'-0"

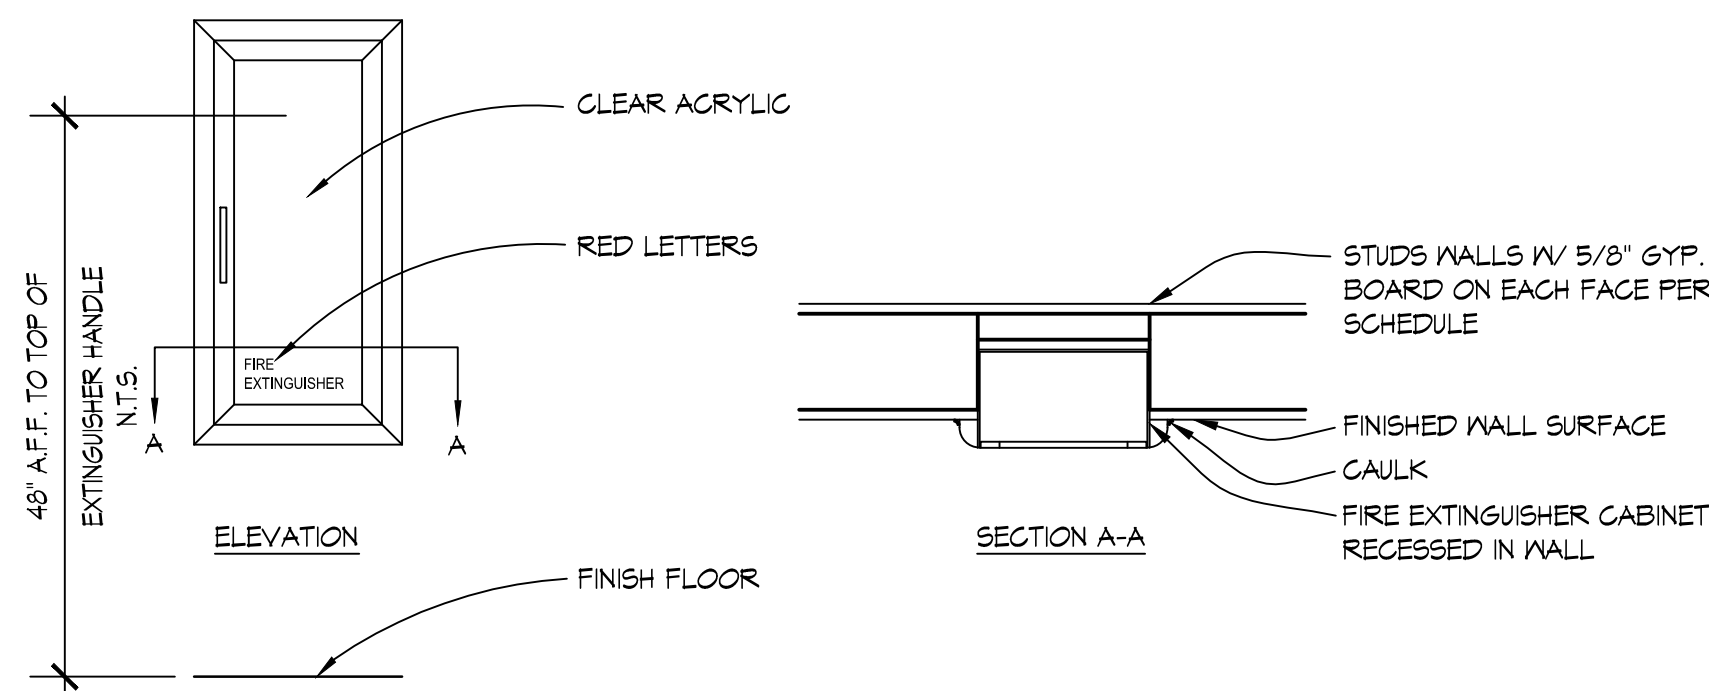

3 FIRE EXTINGUISHER CABINET
A0.1 SCALE: 1"=1'-0"

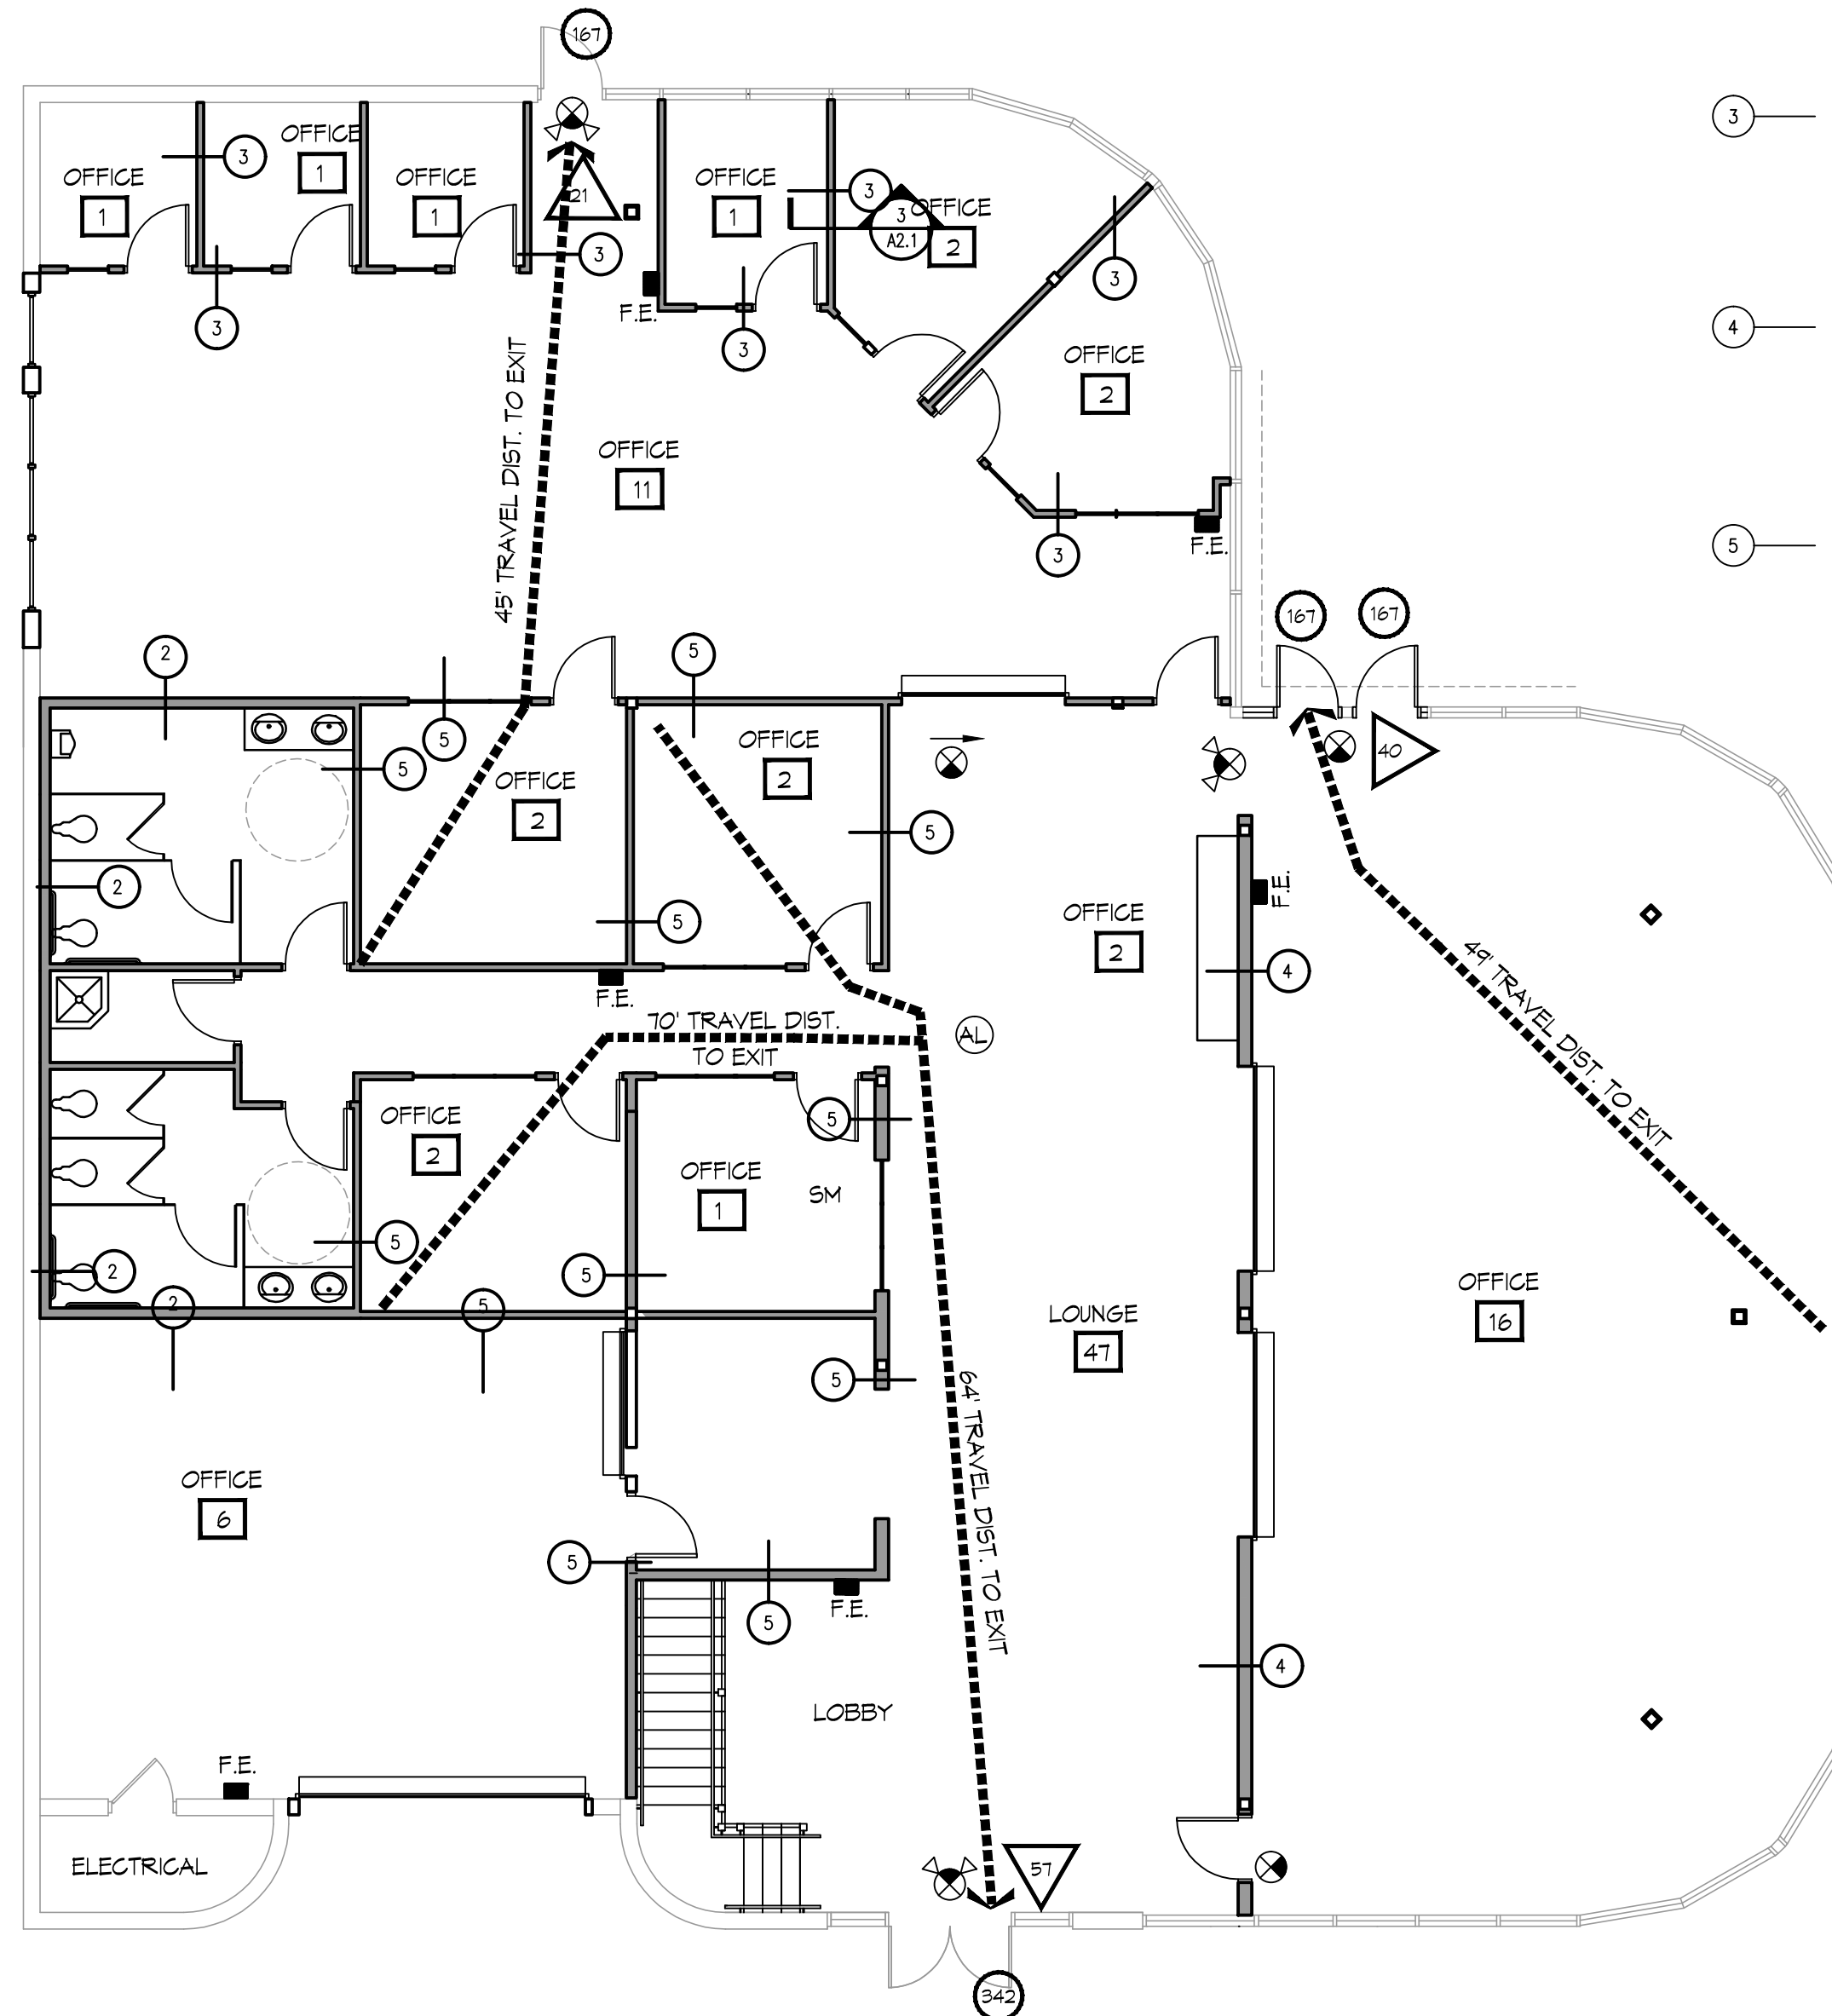


1 FIRST FLOOR
A0.1 SCALE: 1/8"=1'-0"

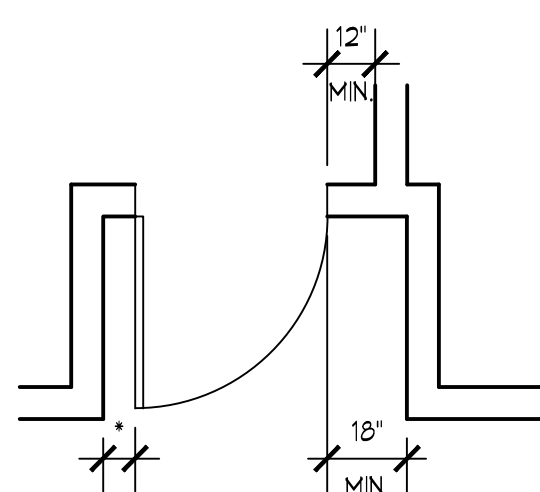

* MIN. DIM. IS FRAME WIDTH OR TRIM WIDTH + 1".
RECOMMENDED DIM. IS 6"

4 DOOR PLAN TYP.
A0.1 SCALE: 1/4"=1'-0"

- NOTE:
1. UNLESS OTHERWISE NOTED, ALL WALLS ARE TO BE WALL TYPE 1.
 2. ALL WALLS AROUND RESTROOMS TO HAVE SOUND ATTENUATION BLANKETS.
 3. USE WATER RESISTANT GYP. BD AT ALL 'NET' WALLS.
 4. ALL SOUND ATTENUATION BLANKETS SHALL BE 2 1/2" U.N.O.
 5. ALL DIMENSIONS ARE TO FACE OF STUD OR STRUCTURE, U.N.O.

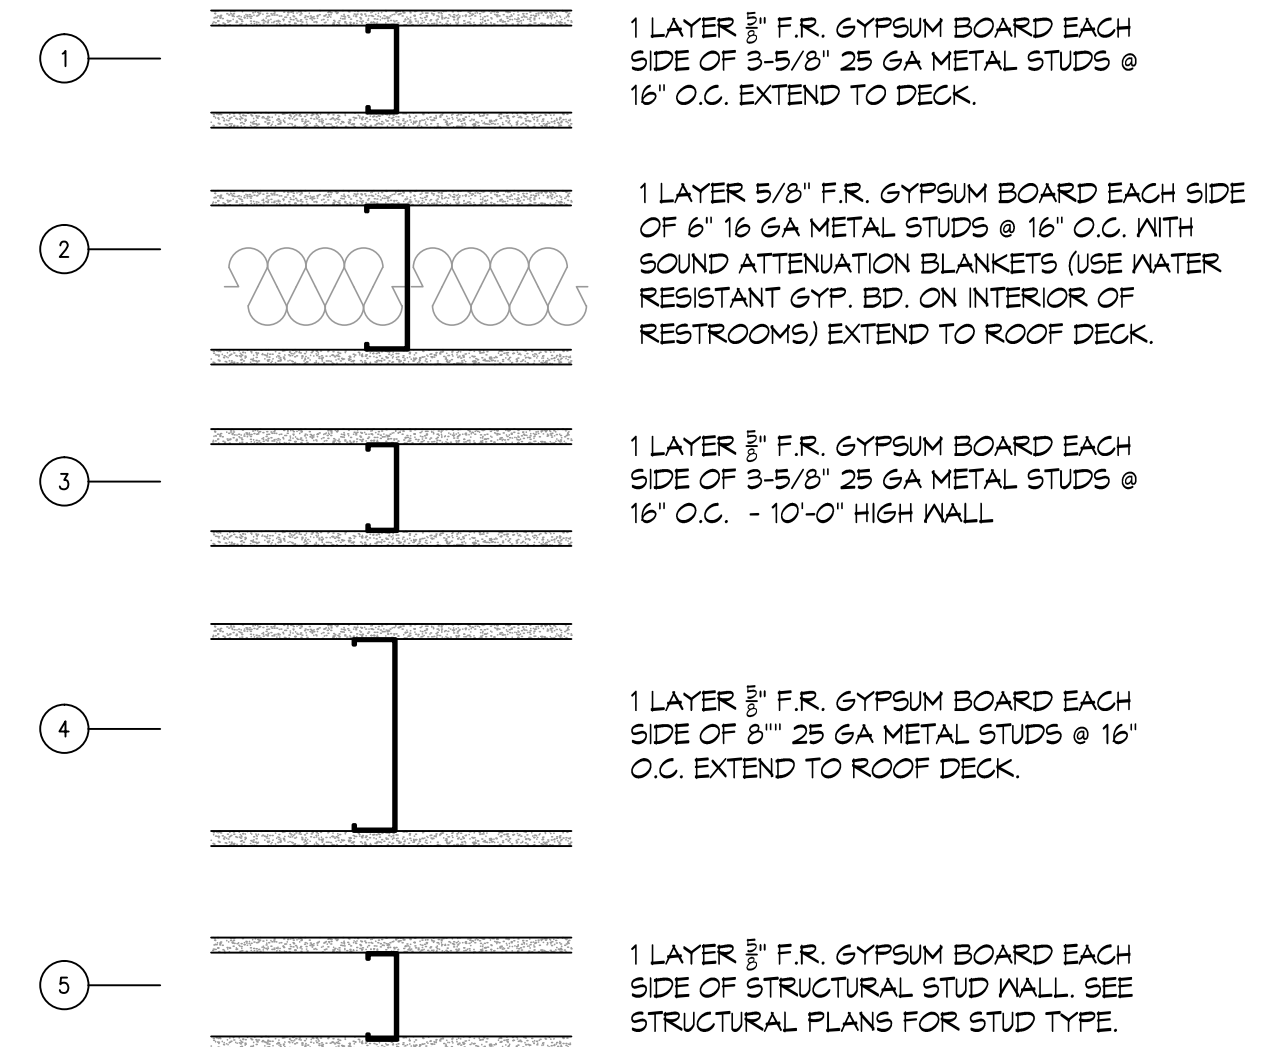

1 PARTITION SCHEDULE
A0.1 SCALE: 1-1/2"=1'-0"

LIFE SAFETY LEGEND	
OCCUPANCY CLASSIFICATIONS PER 2012 LIFE SAFETY CODE, TABLE 7.3.1.2 & 2012 INTERNATIONAL BUILDING CODE, TABLE 1004.1.1 BUSINESS AREAS - 100 SF GROSS ASSEMBLY (TABLES & CHAIRS) - 15 SF NET MECHANICAL - 300 SF GROSS EGRESS COMPONENT CAPACITY PER 2012 LIFE SAFETY CODE, TABLE 7.3.3.1 DOORS - 0.2" CLEAR PER PERSON RAMPS - 0.2" CLEAR PER PERSON STAIRS - 0.3" CLEAR PER PERSON *TYP. 36" SINGLE DOOR = 34" CLEAR / 2 = 167 PERSONS *TYP. 72" SINGLE DOOR = 68 1/2" CLEAR / 2 = 342 PERSONS NOTES: 1. ALL PORTIONS OF THE BUILDING ARE WITHIN 100' FEET OF AN EXIT. BUILDING OCCUPANT LOAD = 106 TOTAL BUILDING EXIT CAPACITY = 835	
LIFE SAFETY SYMBOLS LEGEND	
OCCUPANT LOAD @ ROOM	32
EGRESS LOAD @ EXIT	42
CAPACITY @ EXIT DOOR	167
TRAVEL DISTANCE TO EXIT (MAX. 75')	←--
FIRE EXTINGUISHER	FE
EXIT SIGN/EMERG. LIGHT COMBO - WALL OR CLG. MOUNTED	⊗
EXIT SIGN - WALL OR CLG. MOUNTED	⊗
SMOKE DETECTOR	⊗
ALARM / STROBE	AL

FOR CONSTRUCTION

COPYRIGHT OWNERSHIP:
This drawing is the property of Foreman Seelye Fountain Architecture and may not be used, copied or revised without expressed written permission.
© 2017

Revisions:	
as built	2.24.2020

OPTIMA PROPERTIES
VERANDA WORKS, LLC
3135 Reps Miller Road
NORCROSS, GA 30071

FOREMAN | SEELEY | FOUNTAIN
architecture
3091 Governors Lake Drive, Suite 150, Peachtree Corners, Georgia 30071
(770) 729-8433 www.FSFArchitecture.com fax (770) 729-8466

Sheet Title:
LIFE SAFETY PLAN
Drawn By: DBW
Scale: AS NOTED
Date: 10/18/2019
Job No.: 1814
Sheet No.:

A0.1