


Scottsdale City Center

7201 East Camelback Road . Scottsdale
Suite 302 - 1,468 RSF

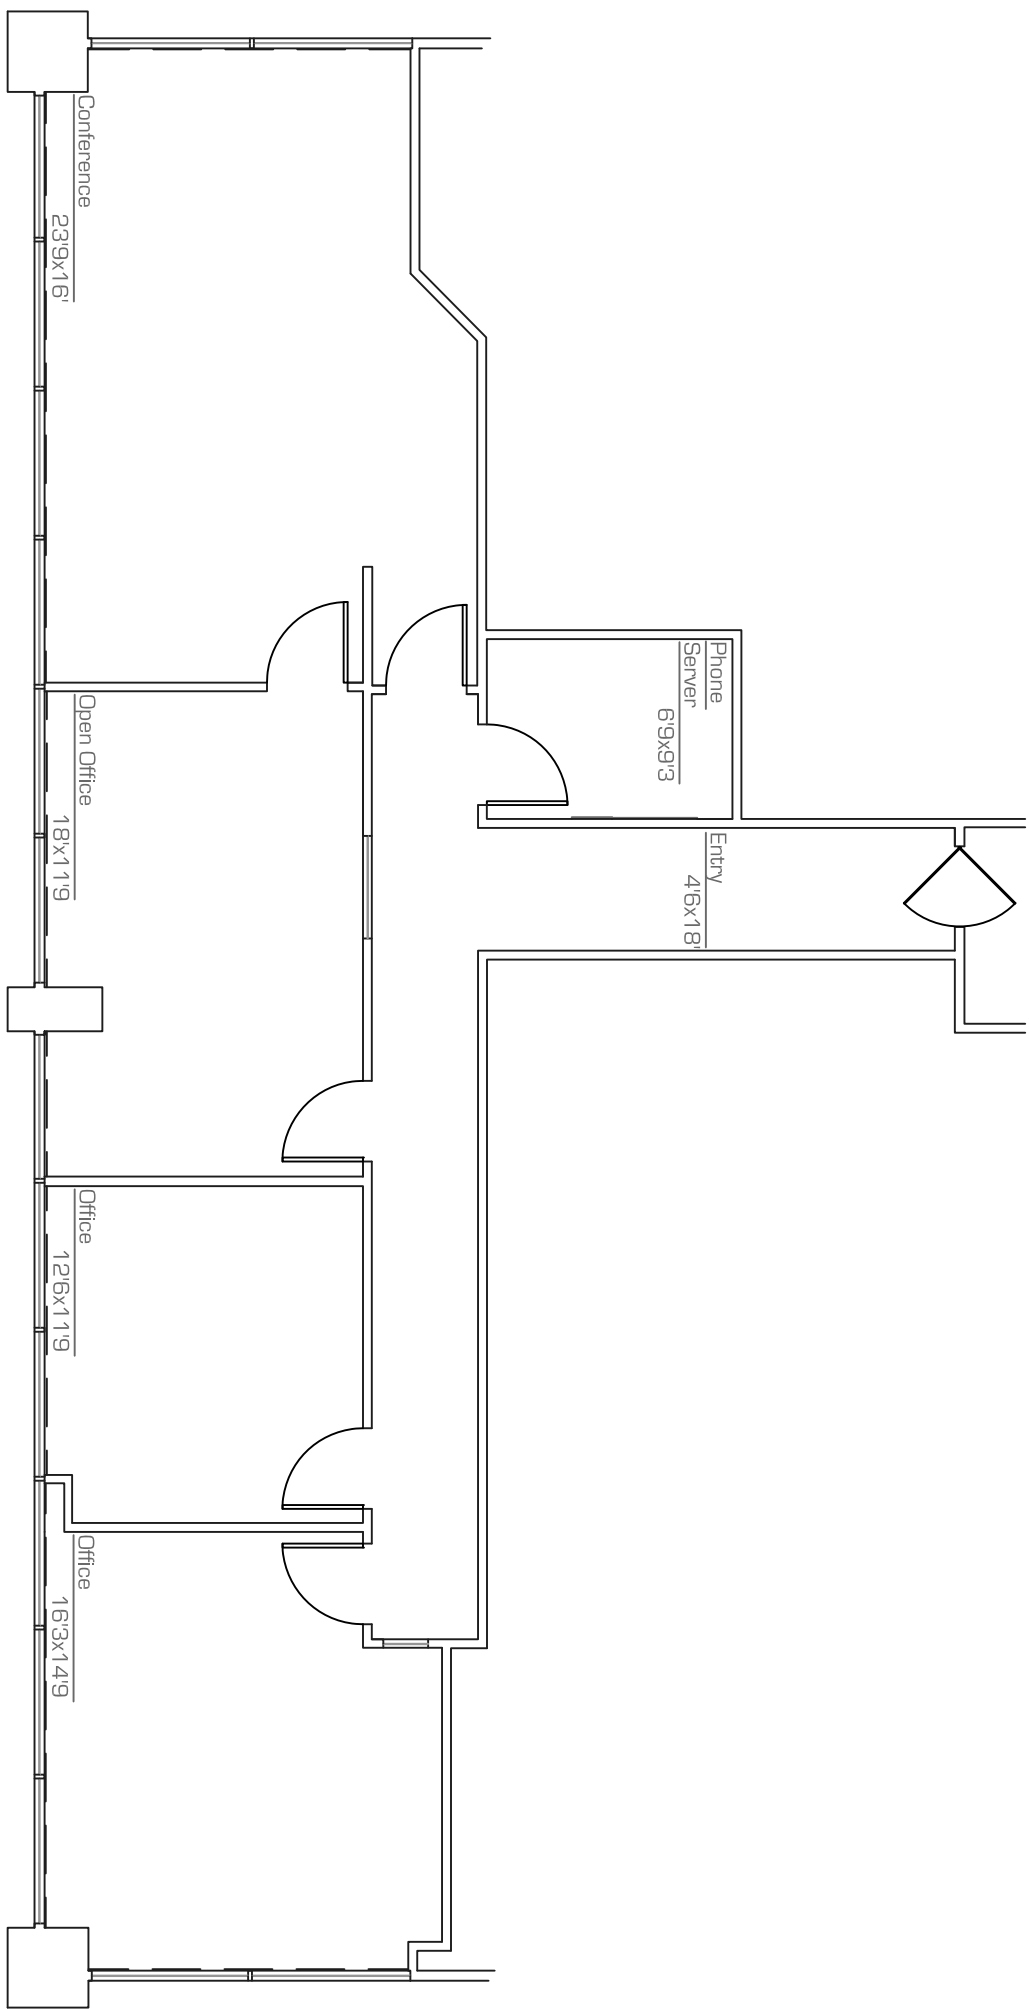

as-built
scale: nts
15.July.2008

* All dimensions are approximate and
all information is of general nature.