


STEWART GORDON STRAUS
ARCHITECT PC
12600 SW CRESCENT ST
SUITE #100
BEAVERTON, OR 97005
(503) 672-7517 (OFFICE)
(503) 672-7808 (FAX)
(971) 506-2724 (MOBILE)
sgs@s-strauss.com (e-mail)

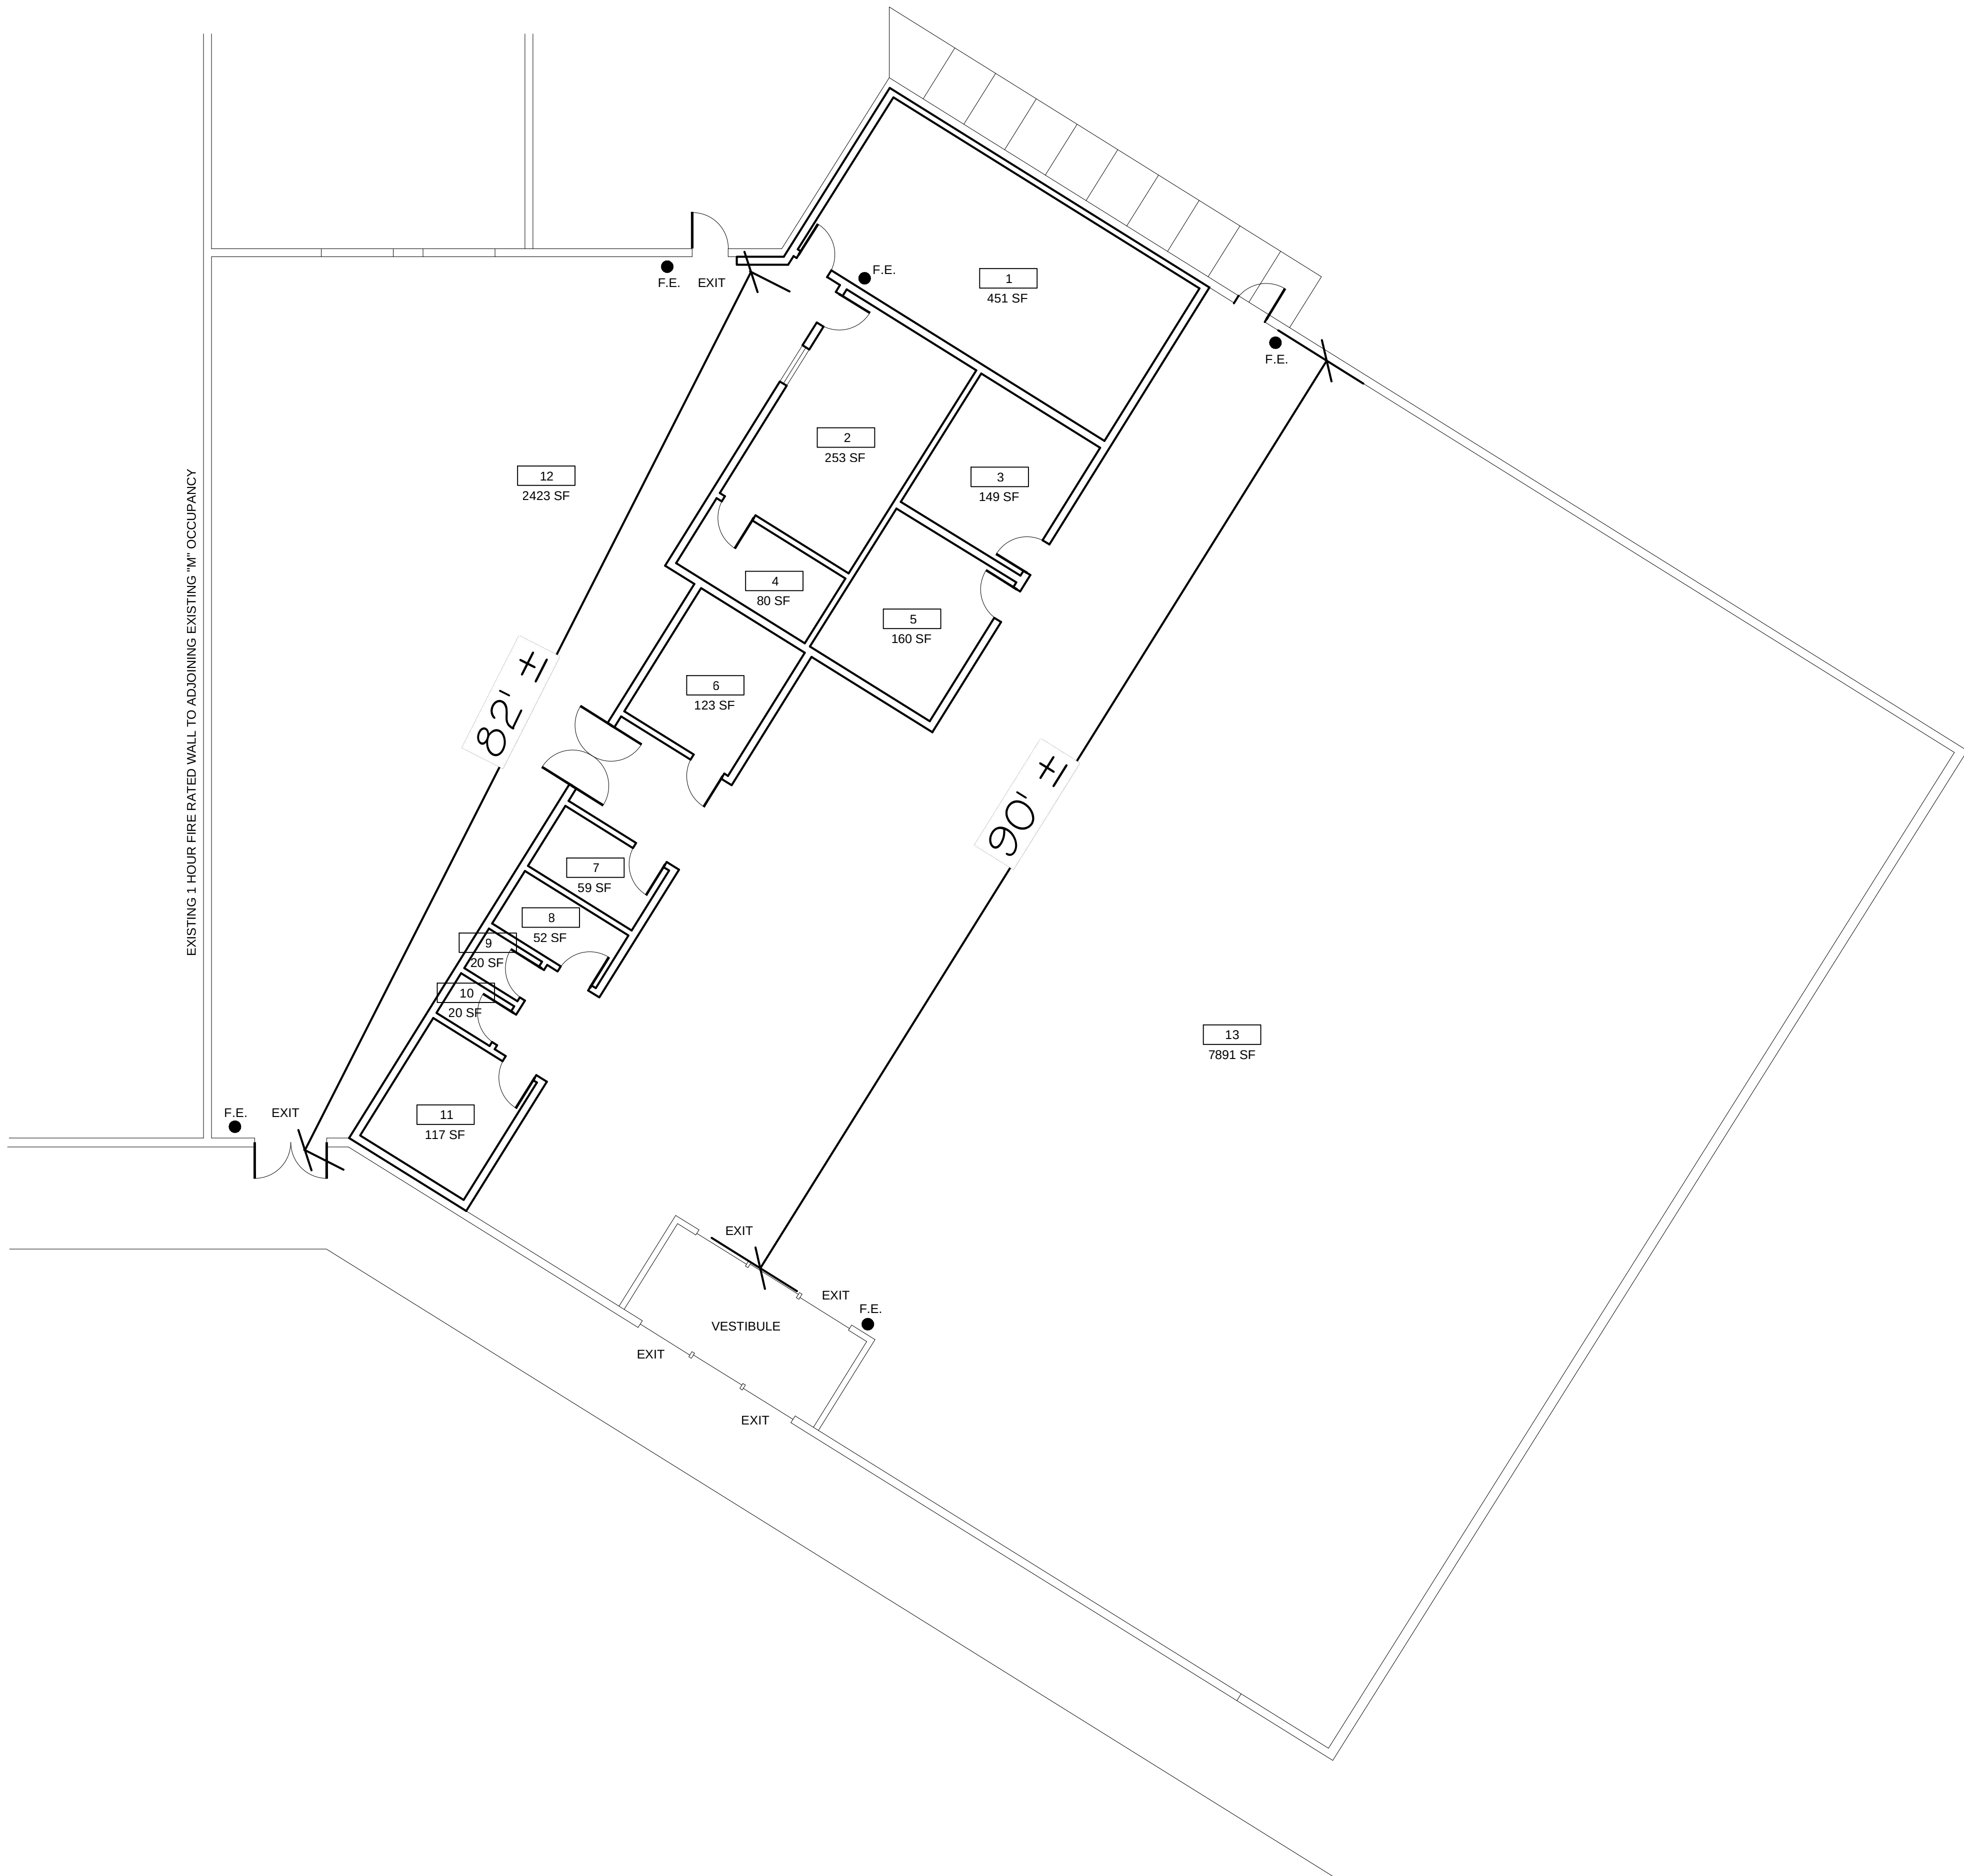

FORMER GOODWILL STORE
LIGHTHOUSE SQUARE
LINCOLN CITY, OREGON

PROJECT
NUMBER: 1831

DRAWING	DATE	BY
DESIGN		
PERMIT		
	26 SEPT 2018	SGS
CONST.		

SHEET TITLE
FLOOR PLAN

SHEET #
A2