


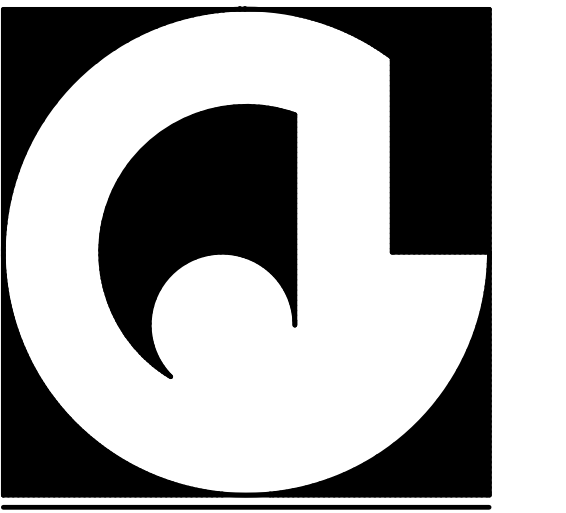

ARCHITECTURE . ENGINEERING

855 MISSION STREET, SOUTH PASADENA, CA 91030
OFFICE : 626-799-4400 FAX : 626-799-7010

PROJECT NAME & SITE ADDRESS:

14930 SAN PEDRO ST
GARDENA, CA. 90248

DEVELOPER :

Drawing Content :


SITE PLAN

Revisions : Date :

Designer : JC
Manager : MB
Date : 03-03-2021
Job No : 2021-017
Scale : AS NOTED
Drawing No :

A-1

SHEET : OF :

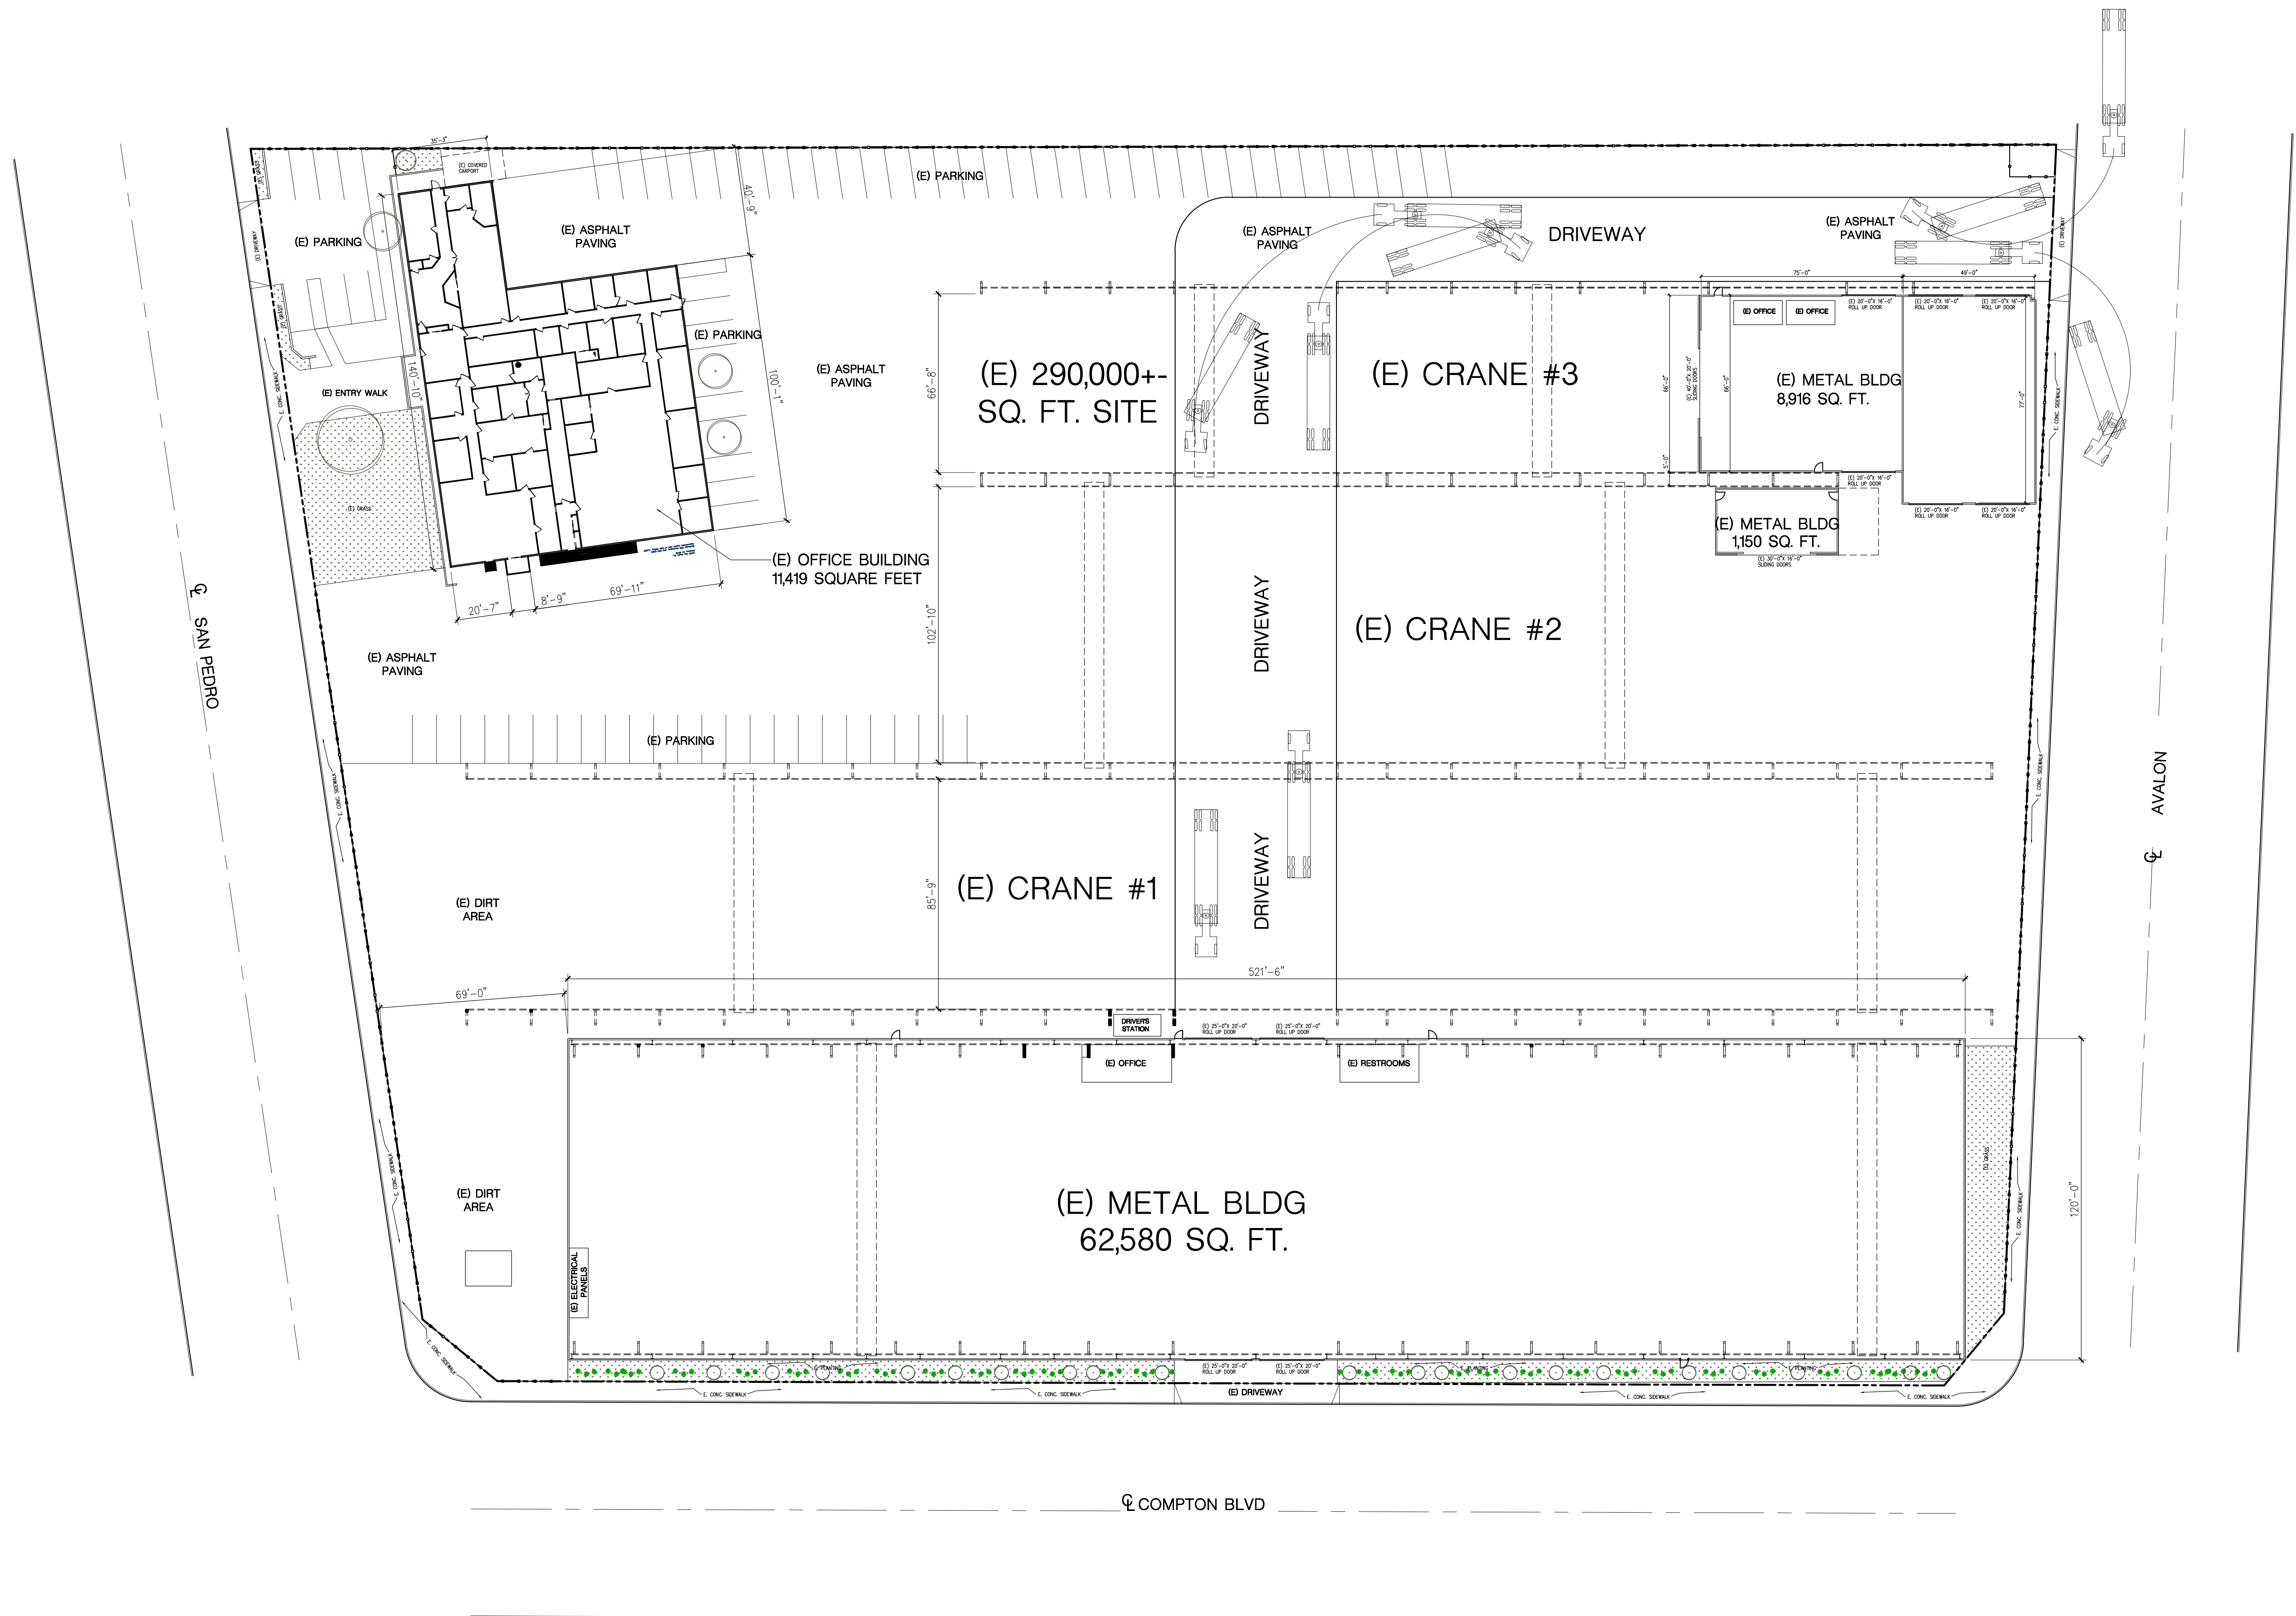

EXISTING SITE PLAN
SCALE: 1" = 30'-0"

