



Bellevue Corporate Plaza
600 108th Avenue NE
Bellevue, Washington



OSCAR OLIVEIRA
425.646.3444
oscar@broderickgroup.com

MATT SCHRECK
425.646.5232
schreck@broderickgroup.com

Broderick Group, Inc.
10500 NE 8th Street
Suite 900
Bellevue, Washington 98004
main: 425.646.3444

broderickgroup.com


The information contained herein has been given to us by the owner or sources that we deem reliable. We have no reason to doubt its accuracy, but we do not guarantee it. Prospective tenants should carefully verify all information contained herein.




FLOOR 1 | SUITE 116

2,906 RSF

As-Built Space Plan

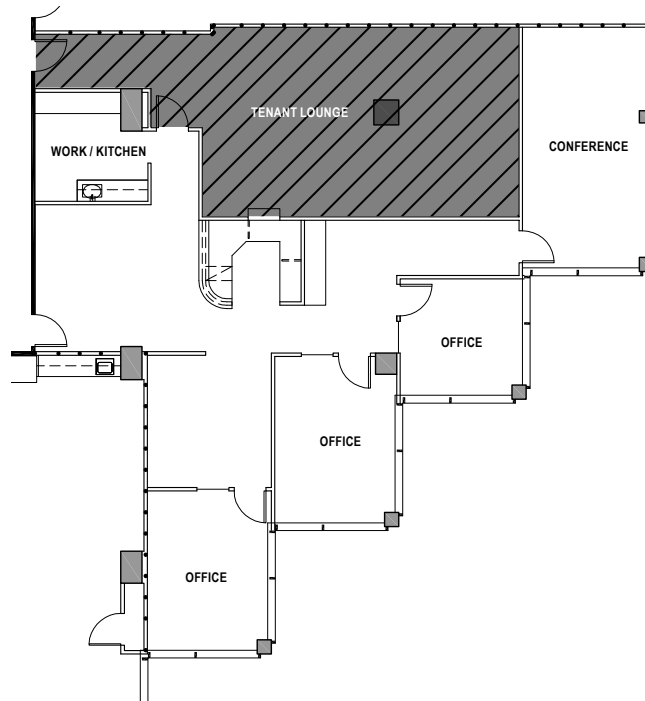

Proposed Space Plan

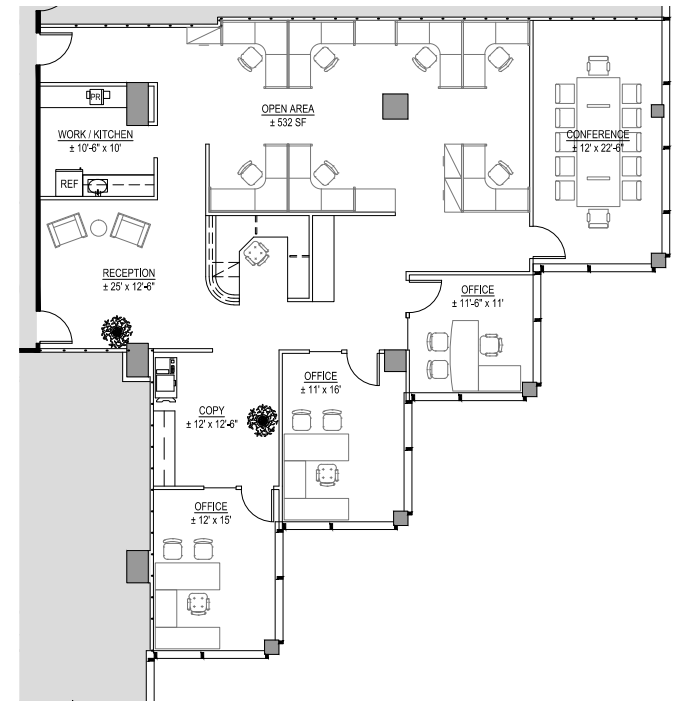

Floor 1 Plan

