
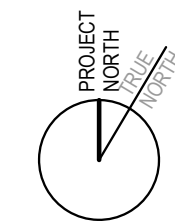


EXISTING FIRST FLOOR PLAN

NOTES:

1. DIMENSIONS ARE TO FACE OF FINISH. ACCURACY OF DIMENSIONS IS SUFFICIENT FOR GENERAL PLANNING USE. ANY SPECIFIC DESIGN PROJECT SHALL REQUIRE FIELD VERIFICATION OF PERTINENT DIMENSIONS.
2. WALL CONSTRUCTION TYPES VARY AND MAY INCLUDE CAST CONCRETE, FRAMING, STEEL COLUMNS, OR A COMBINATION THEREOF. THICKNESSES VARY ACCORDINGLY.

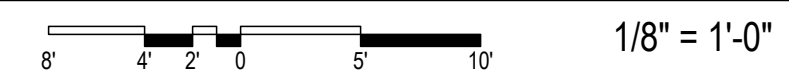

© 2012 C.F.H. Svoboda-Spanbock, Architect
 All rights reserved. No part of this drawing may be reproduced except as in accordance with the Agreement between Architect and Owner, executed April 1, 2011. These drawings are intended for general planning use only. No warranty, expressed or implied, is conveyed as to their accuracy or sufficiency for any specific use. All relevant dimensions shall be verified in field prior to commencement of any specific design project.

Interior Drawings of Existing Facility:

417 BRYANT CIRCLE
 OJAI, CA 93023

03.30.12

EX-2.1

EXISTING FIRST FLOOR PLAN