

THUNDERBIRD  
MEDICAL  
PLAZA I


## Floor 01

### Suite 3

AS-BUILT

### 2,735 SF

AVAILABLE

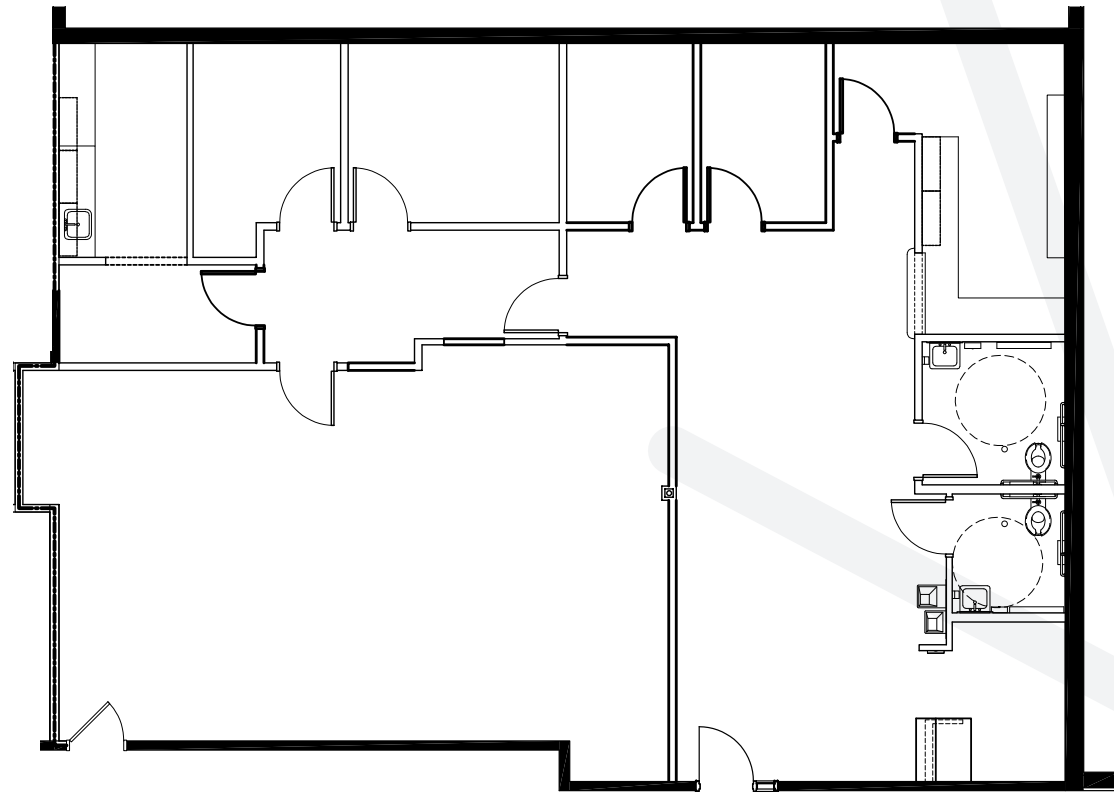

**RACHAEL THOMPSON**  
Senior Vice President  
602.513.5122  
rachael.thompson@kidder.com

**PERRY GABUZZI, CCIM**  
Executive Vice President  
602.513.5116  
perry.gabuzzi@kidder.com