


I CERTIFY THAT THIS PLAN FULLY AND ACCURATELY DEPICTS THE LAYOUT, LOCATION, UNIT, NUMBER AND DIMENSION OF UNITS, AS BUILT, AS OF JANUARY 16, 2022.

THIS DRAWING HAS BEEN PREPARED IN CONFORMANCE WITH THE RULES AND REGULATIONS OF THE REGISTRY OF DEEDS.



REGISTERED ARCHITECT

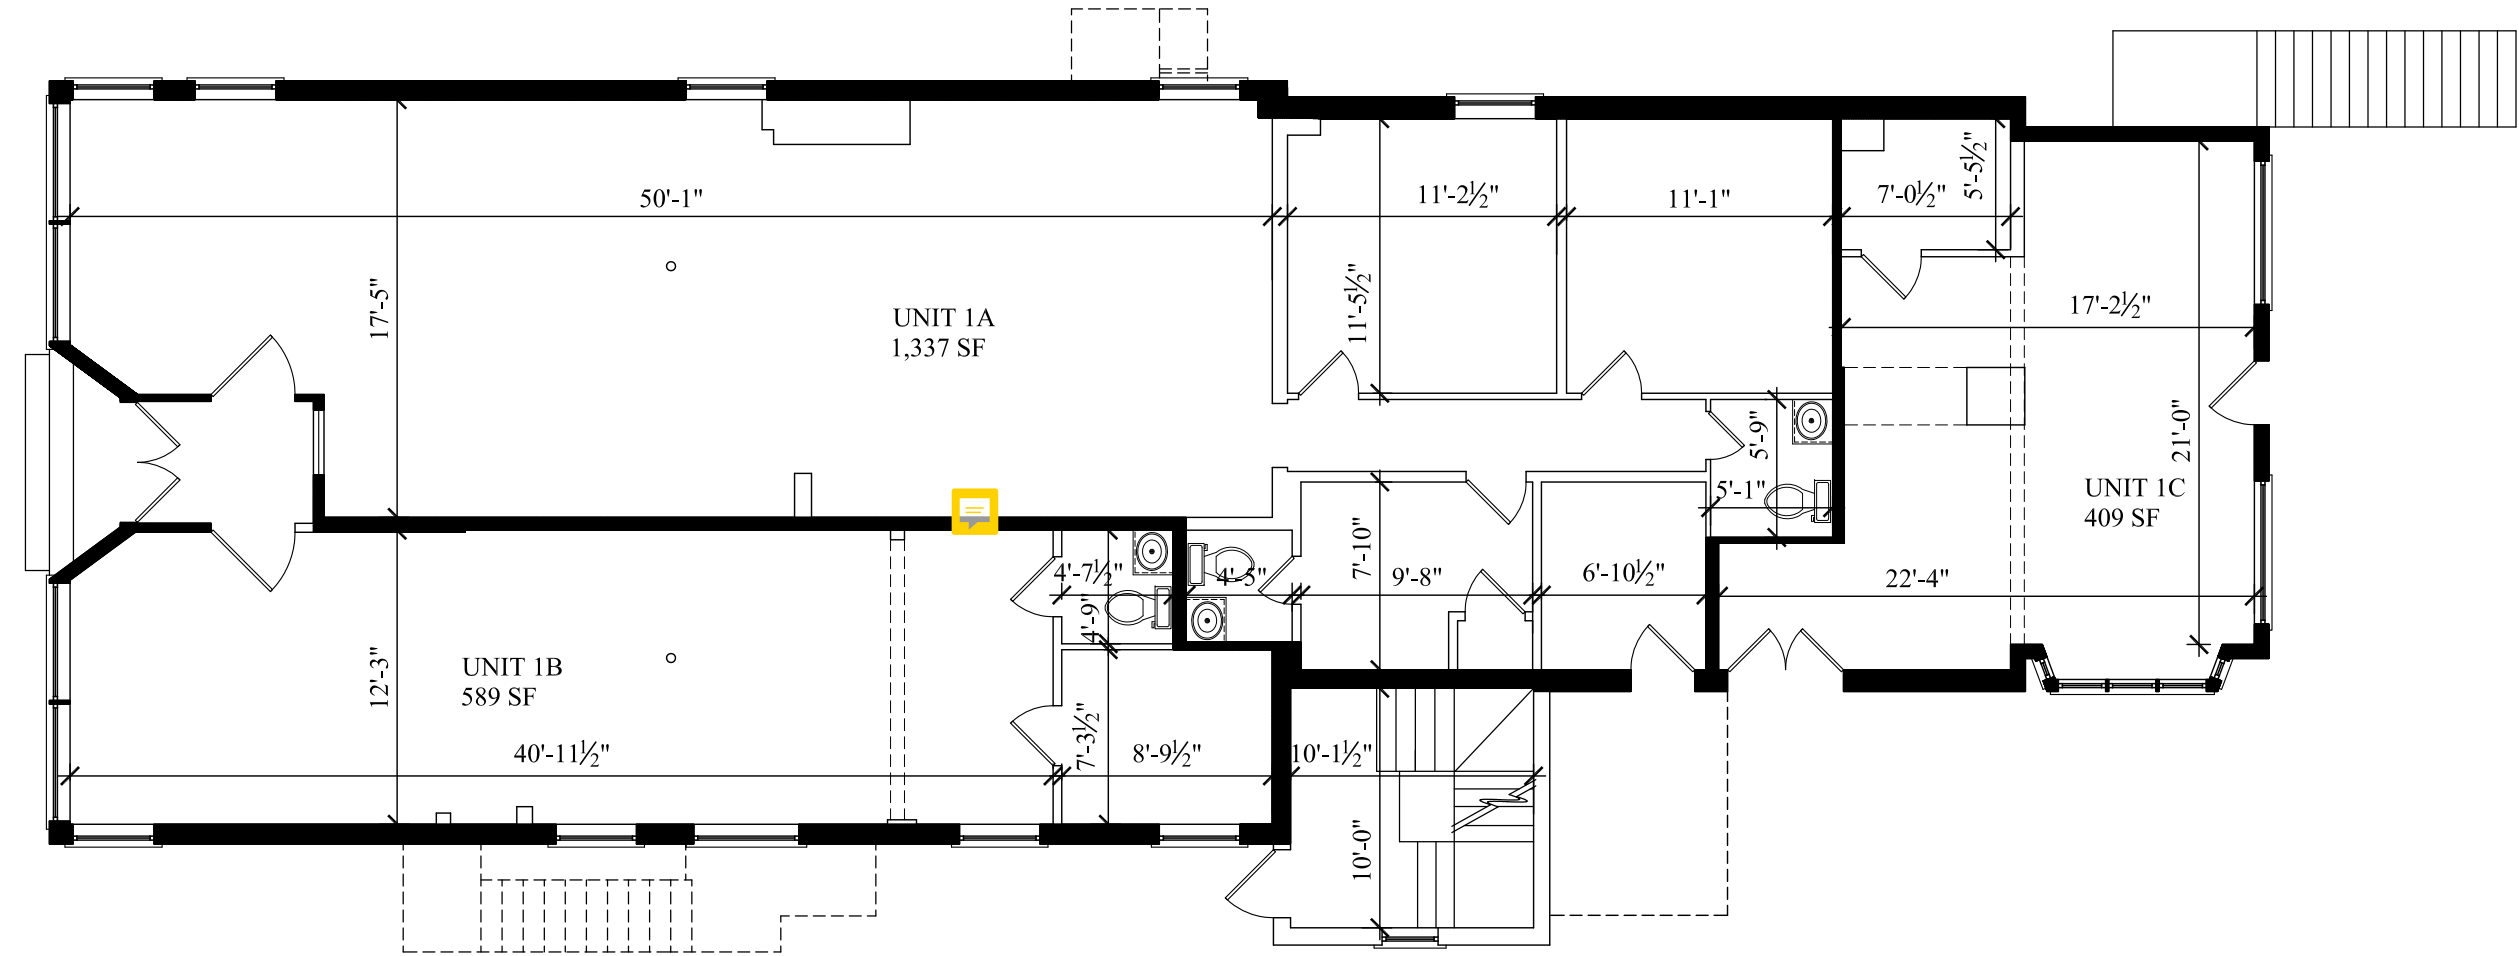

FIRST FLOOR PLAN

SCALE: 1/8" = 1'-0"



ARCHITECTS INC.

BRADLEY
EST. 1896

8 BANK ROW
PITTSFIELD, MA 01201
413 448 8253



MIXED USE
BUILDING

PROJECT:

EXISTING

44 MAIN STREET
STOCKBRIDGE, MA 01262

DWG. TITLE:

FIRST FLOOR PLAN

DATE: 01-16-2022

DRAWN BY: REH

CHK. BY:

DWG. NO.:

Ex1.1