

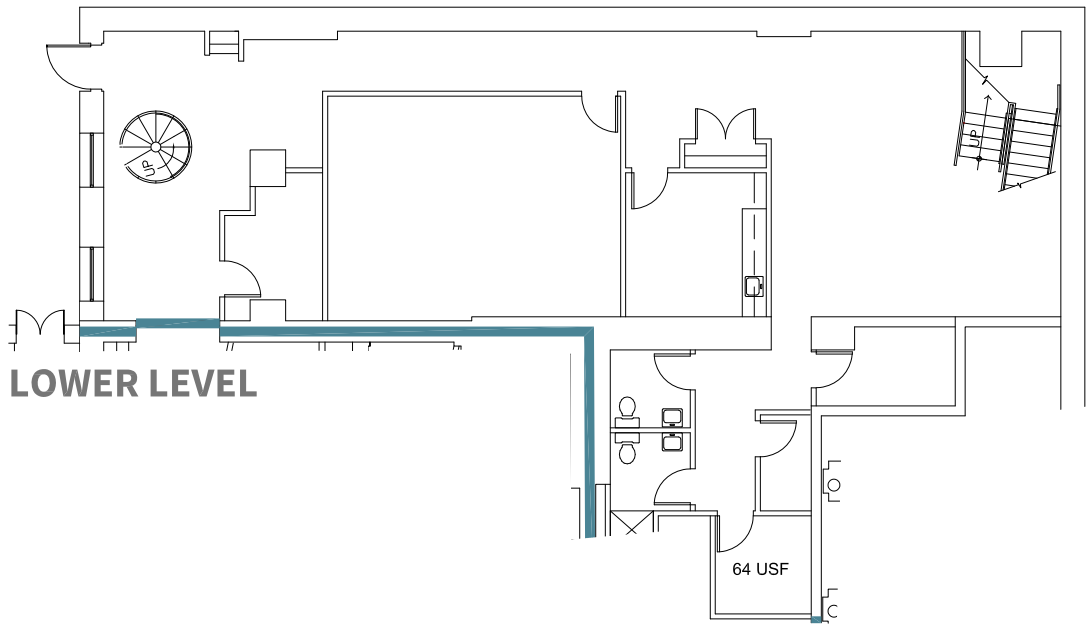
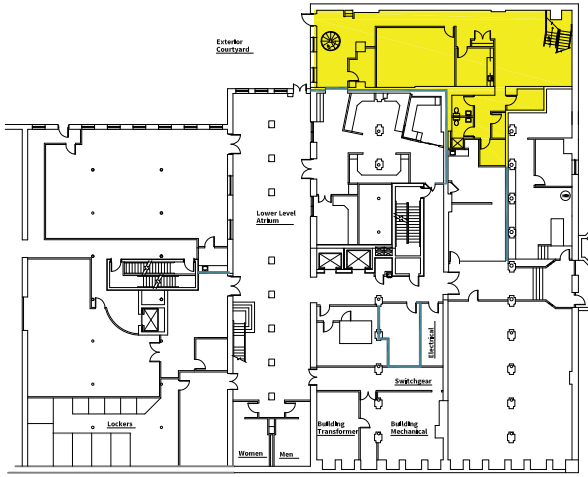



KEY PLAN

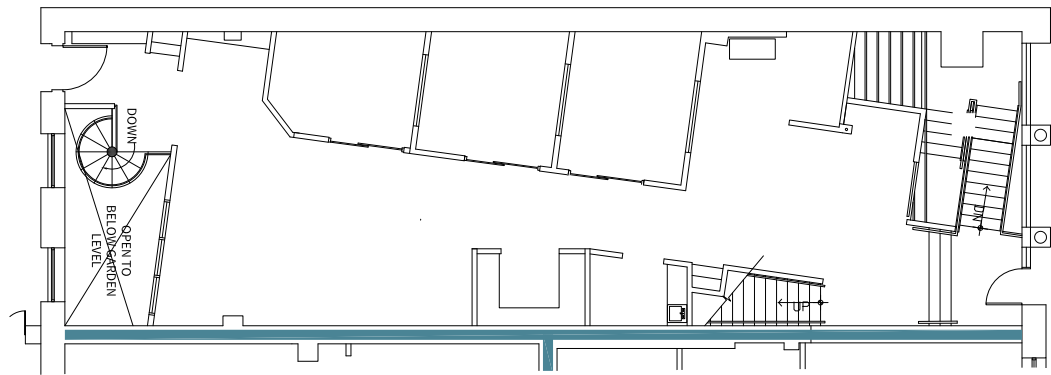

LOWER LEVEL

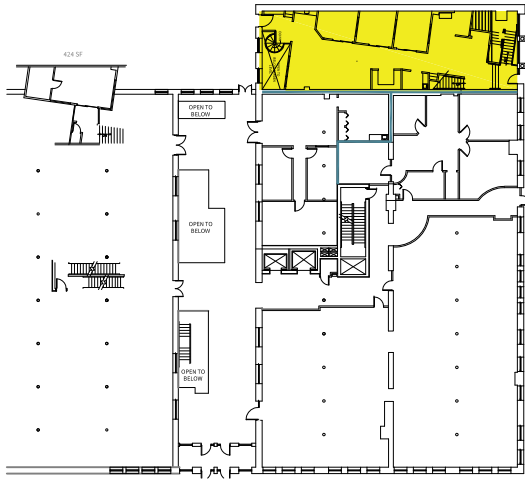

1ST FLOOR

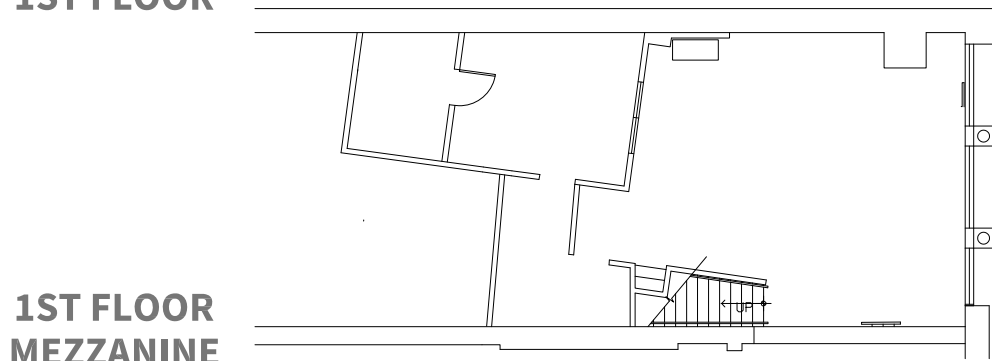

**1ST FLOOR
MEZZANINE**

HOYT BLOCK

700 W. St. Clair Avenue
Cleveland, Ohio 44113

SUITE 106 - 5,042 RSF

Scale : NTS