


THIS DOCUMENT IS THE EXCLUSIVE PROPERTY OF CASTELLANOS + TRAMONTE ARCHITECTS. THE DOCUMENT AND INFORMATION IT CONTAINS MAY NOT BE REPRODUCED OR USED FOR OTHER THAN THE SPECIFIC PROJECT FOR WHICH IT WAS PREPARED WITHOUT THE EXPLICIT CONSENT OF CASTELLANOS + TRAMONTE ARCHITECTS.

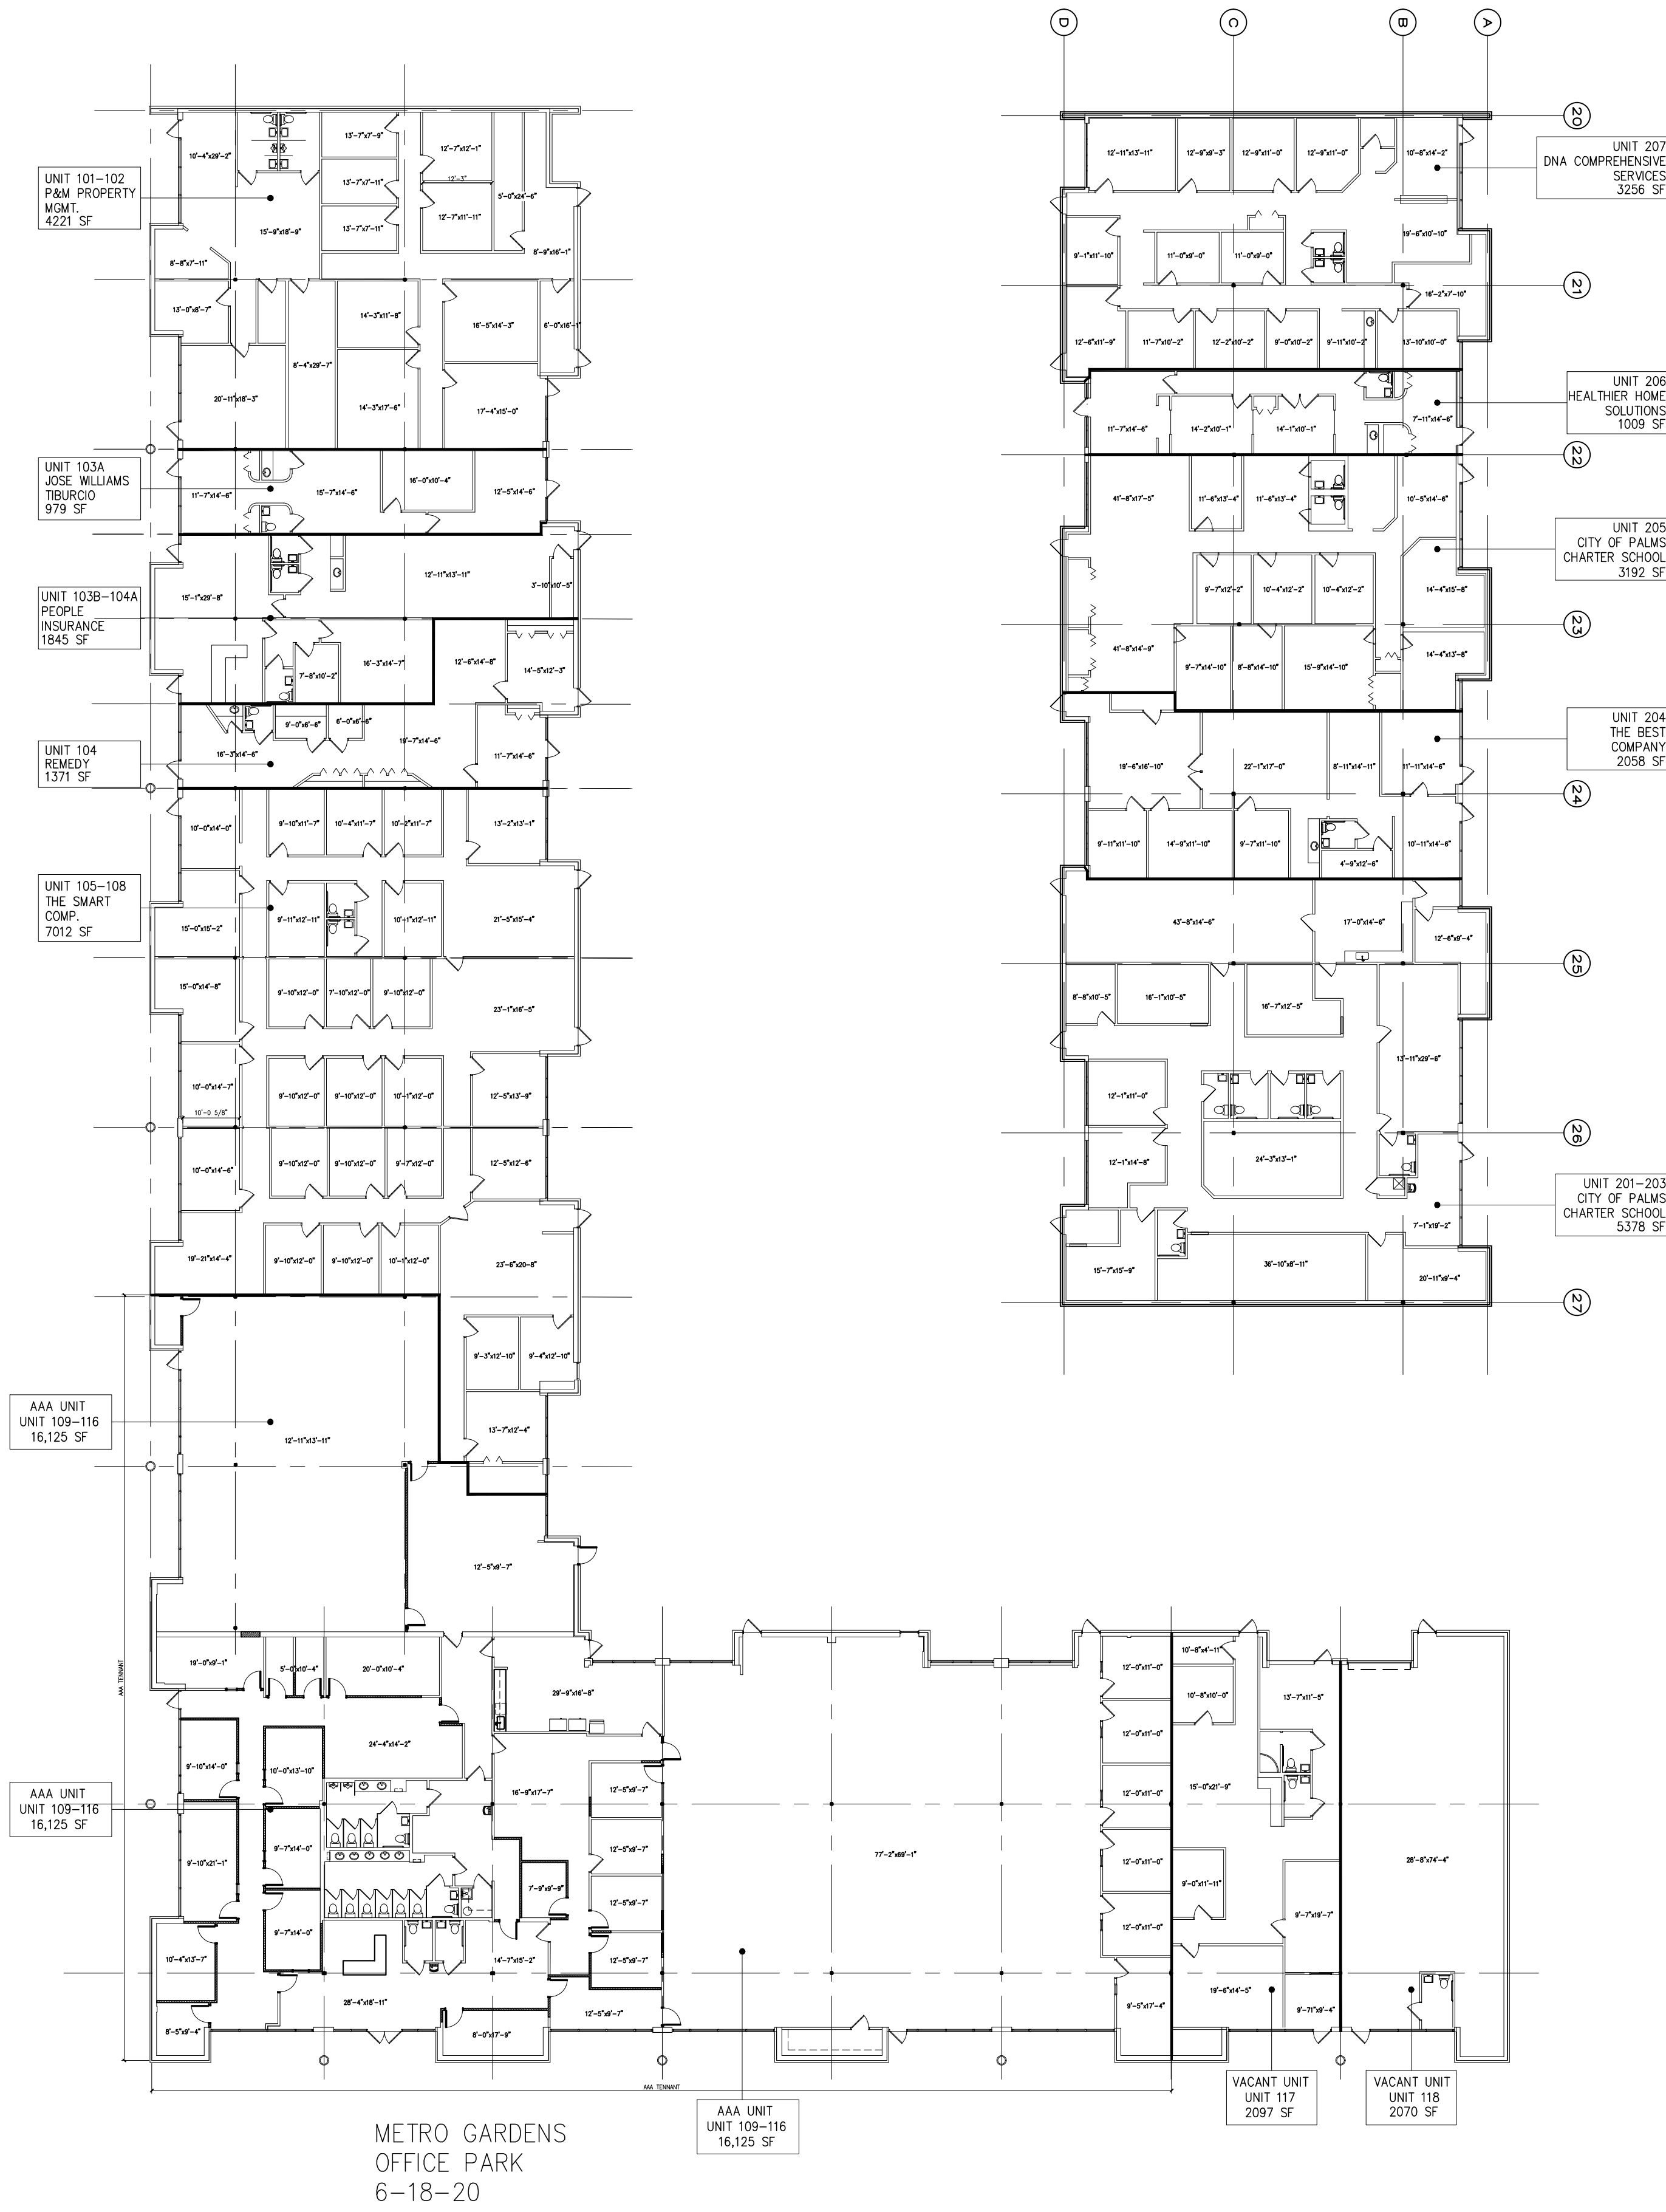

METRO GARDENS OFFICE COMPLEX – MASTER PLAN

AS-BUILT MEASUREMENT FOR:
METRO GARDENS OFFICE COMPLEX
FORT MYERS, FLORIDA

CASTELLANOS + TRAMONTE ARCHITECTS
1228 LAFAYETTE STREET SUITE #1 CAPE CORAL, FLORIDA 33904
(239) 549-0997 AA 260003303

DRAWN BY	BAM
CHECKED BY	AAC
ISSUED FOR:	
SPACE PLAN	7/20/20
SPACE PLAN	7/27/20

ARCHITECT/ENGINEER STAMP

DRAWING NAME:

SHEET

A1