




1201 F STREET, NW

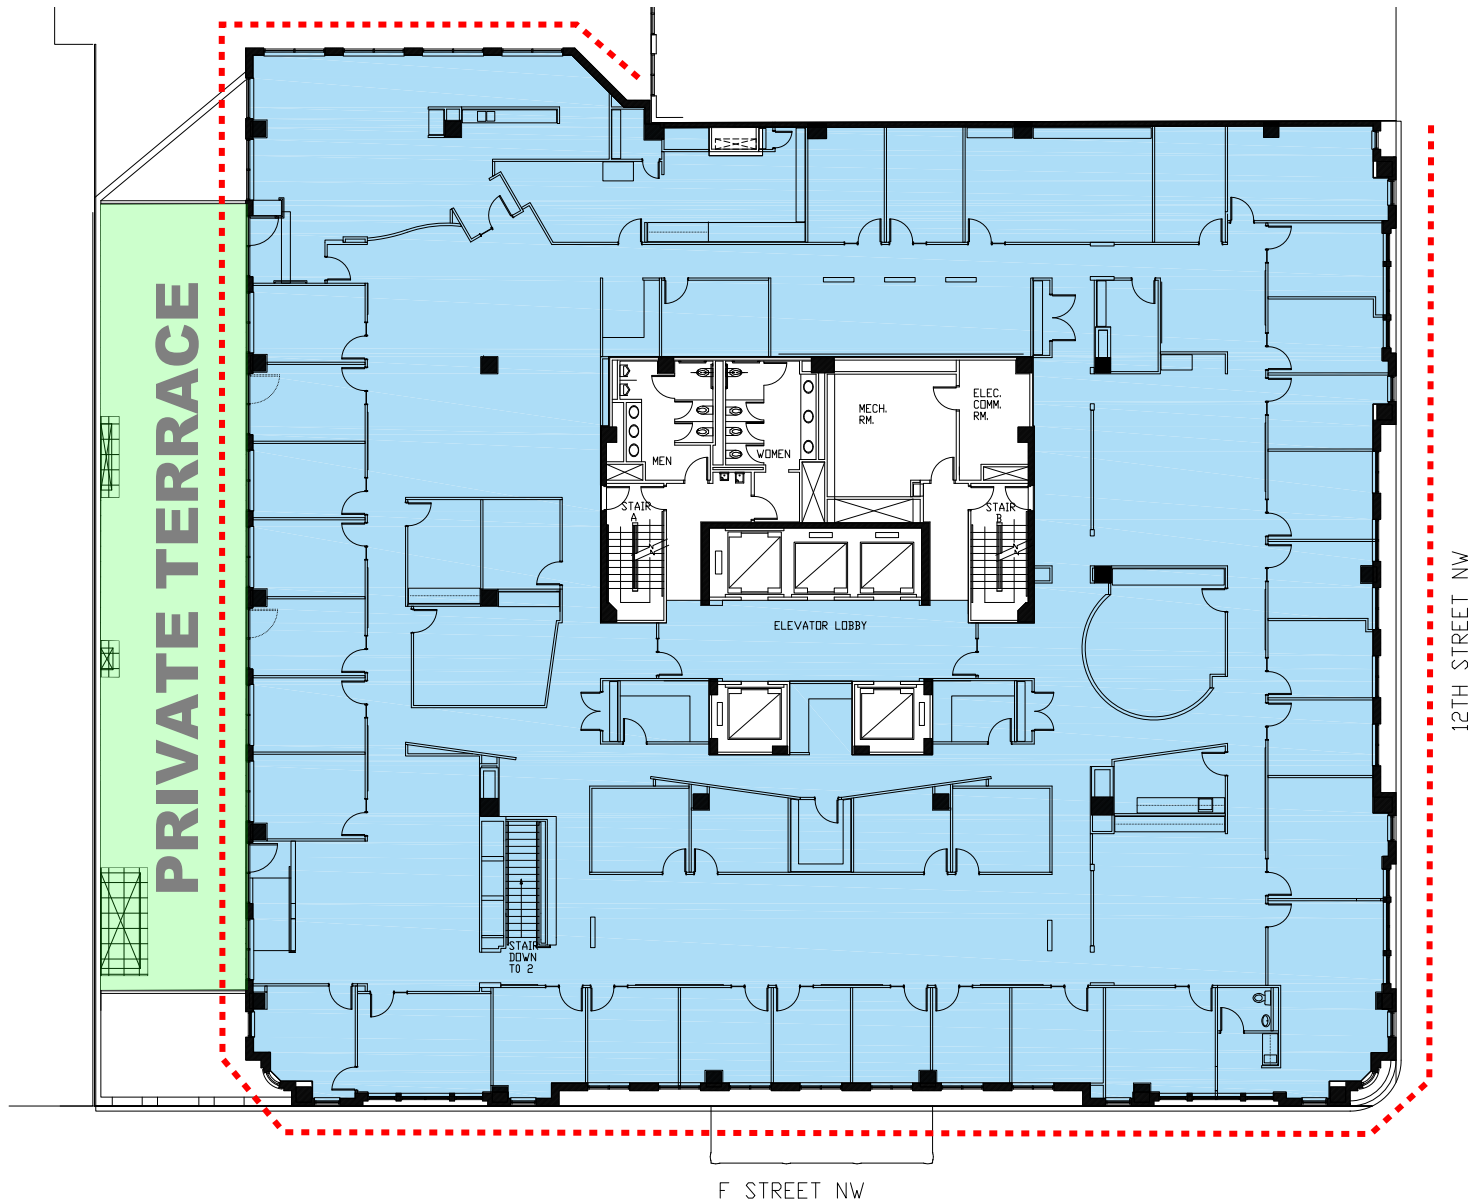

Third Floor As-Built Plan Approx. 20,802 SF

FOR LEASING INFORMATION
PLEASE CONTACT

Dan Dooley
202.420.2110
DDooley@TishmanSpeyer.com

Amy K. Brendler
202.420.2111
ABrendler@TishmanSpeyer.com

Rafael V. Notario
202.420.2118
RNotario@TishmanSpeyer.com



TISHMAN SPEYER