


BUILDING LOCATION

GROSS SQUARE FOOTAGE: 10,051 S.F.
NET / USABLE SQUARE FOOTAGE: 9,650 S.F.

Drawings Prepared By:
Maloney Services
832.257.4619
maloneyservices@yahoo.com

**PLAZA ONE
AS BUILT PLANS
11703 BUILDING "C" SPRING CYPRESS
TOMBALL, TEXAS 77377**

MALONEY SERVICES, L.L.C. 2025. THIS OFFICE ASSUMES NO LIABILITY FOR ERRORS OR OMISSIONS ON THESE PLANS. ALL INFORMATION MUST BE CONFIRMED PRIOR TO COMMENCEMENT OF CONSTRUCTION. IT IS THE OWNER'S AND BUILDER'S RESPONSIBILITY FOR FOLLOWING MATERIAL AND MANUFACTURER'S INSTRUCTIONS, AND USING RECOGNIZED STANDARDS FOR EACH TRADE, AS WELL AS COMPLIANCE IN FULL WITH ALL GOVERNING CODE REQUIREMENTS FOR THE GEOGRAPHIC AREA IN WHICH THIS PROJECT IS TO BE CONSTRUCTED.

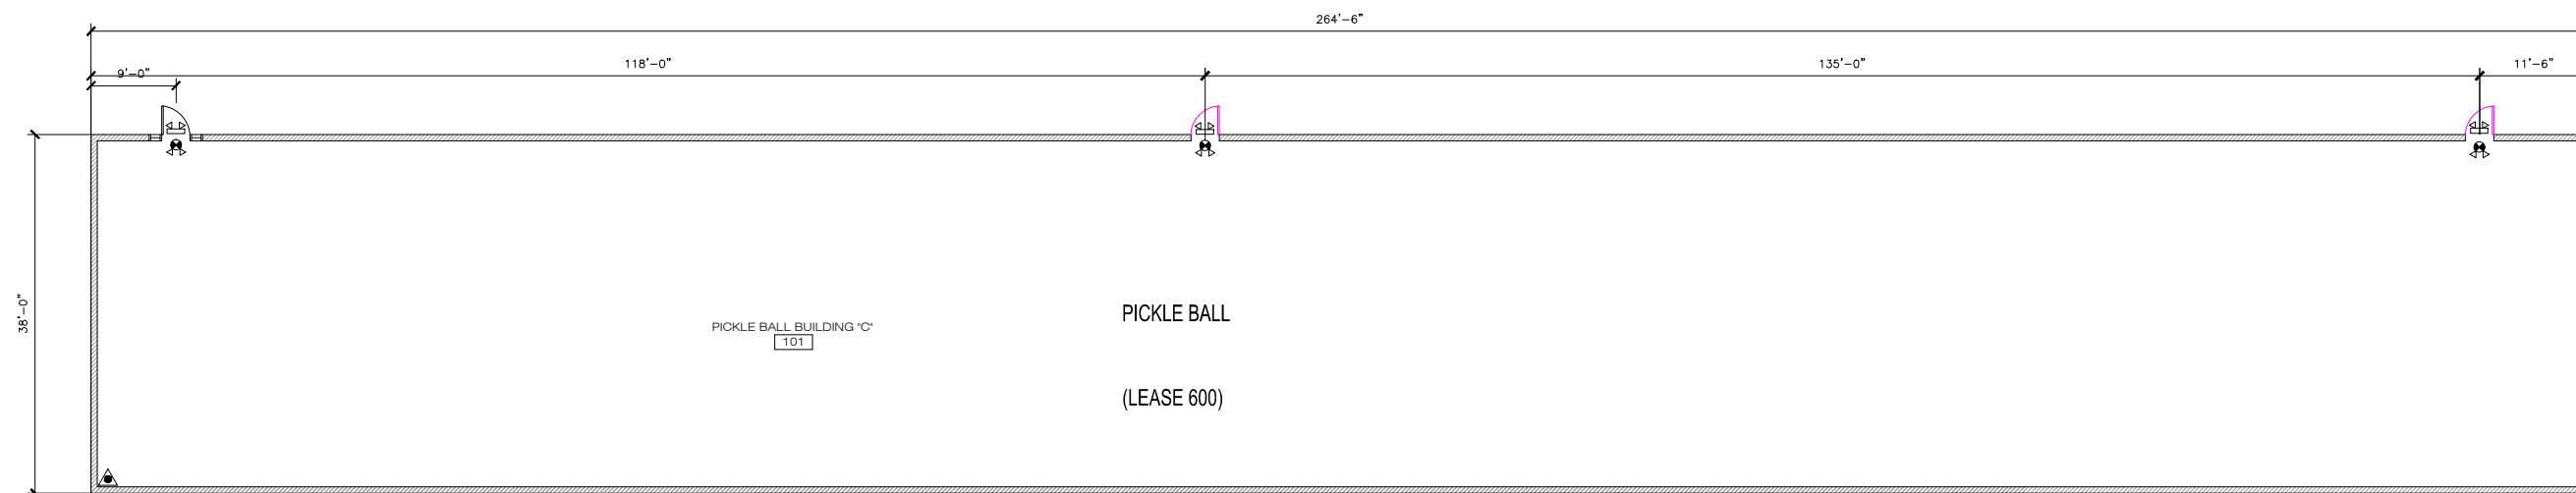

10,051 S.F. BUILDING
SCALE: 1/8" = 1'-0"

BUILDING PLAN

Issue:
AS-BUILT DRAWINGS 10-27-2025

Date
10-27-2025

Project Number
08242025

Sheet Name
BUILDING PLAN

Sheet Number
A1.10