


Olive West
5700 West Olive Ave
Glendale . Arizona
Suite 107 - 1,111 RSF

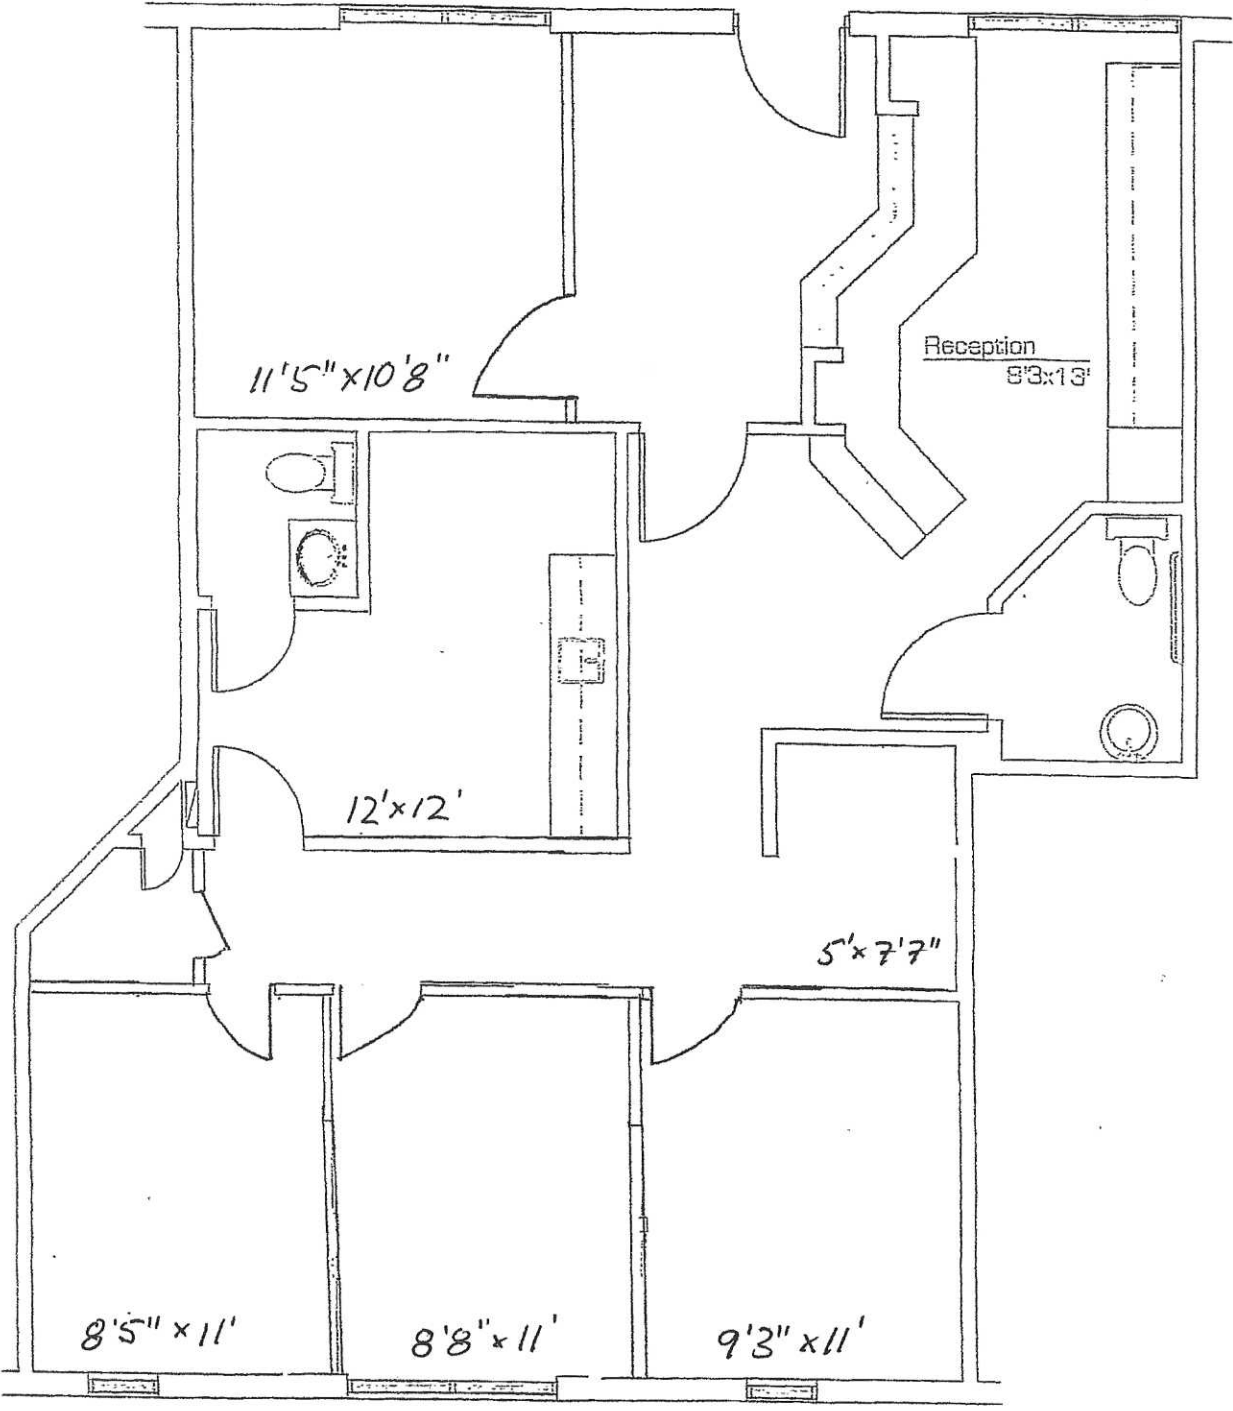

as-built
scale: nts



*All dimensions are approximate at $\pm 3"$
*All information is of general nature

precisionDIMENSIONS



as built . space plans
architectural design
602.790.6412