

DAVID STERN
CONSTRUCTION COMPANY

SEAL

CONSULTANTS

Consultant:
Address:
Phone:
Fax:
Email

No.	Description	Date


**970 NEW BRUNSWICK AVE.
RAHWAY, NJ**

**AS-BUILT
SITE PLAN
FIRST FLOOR**

Project Number	-
Date	11/18/2020
Drawn By	M. McCANTS
Checked By	-

A-100

Scale AS NOTED

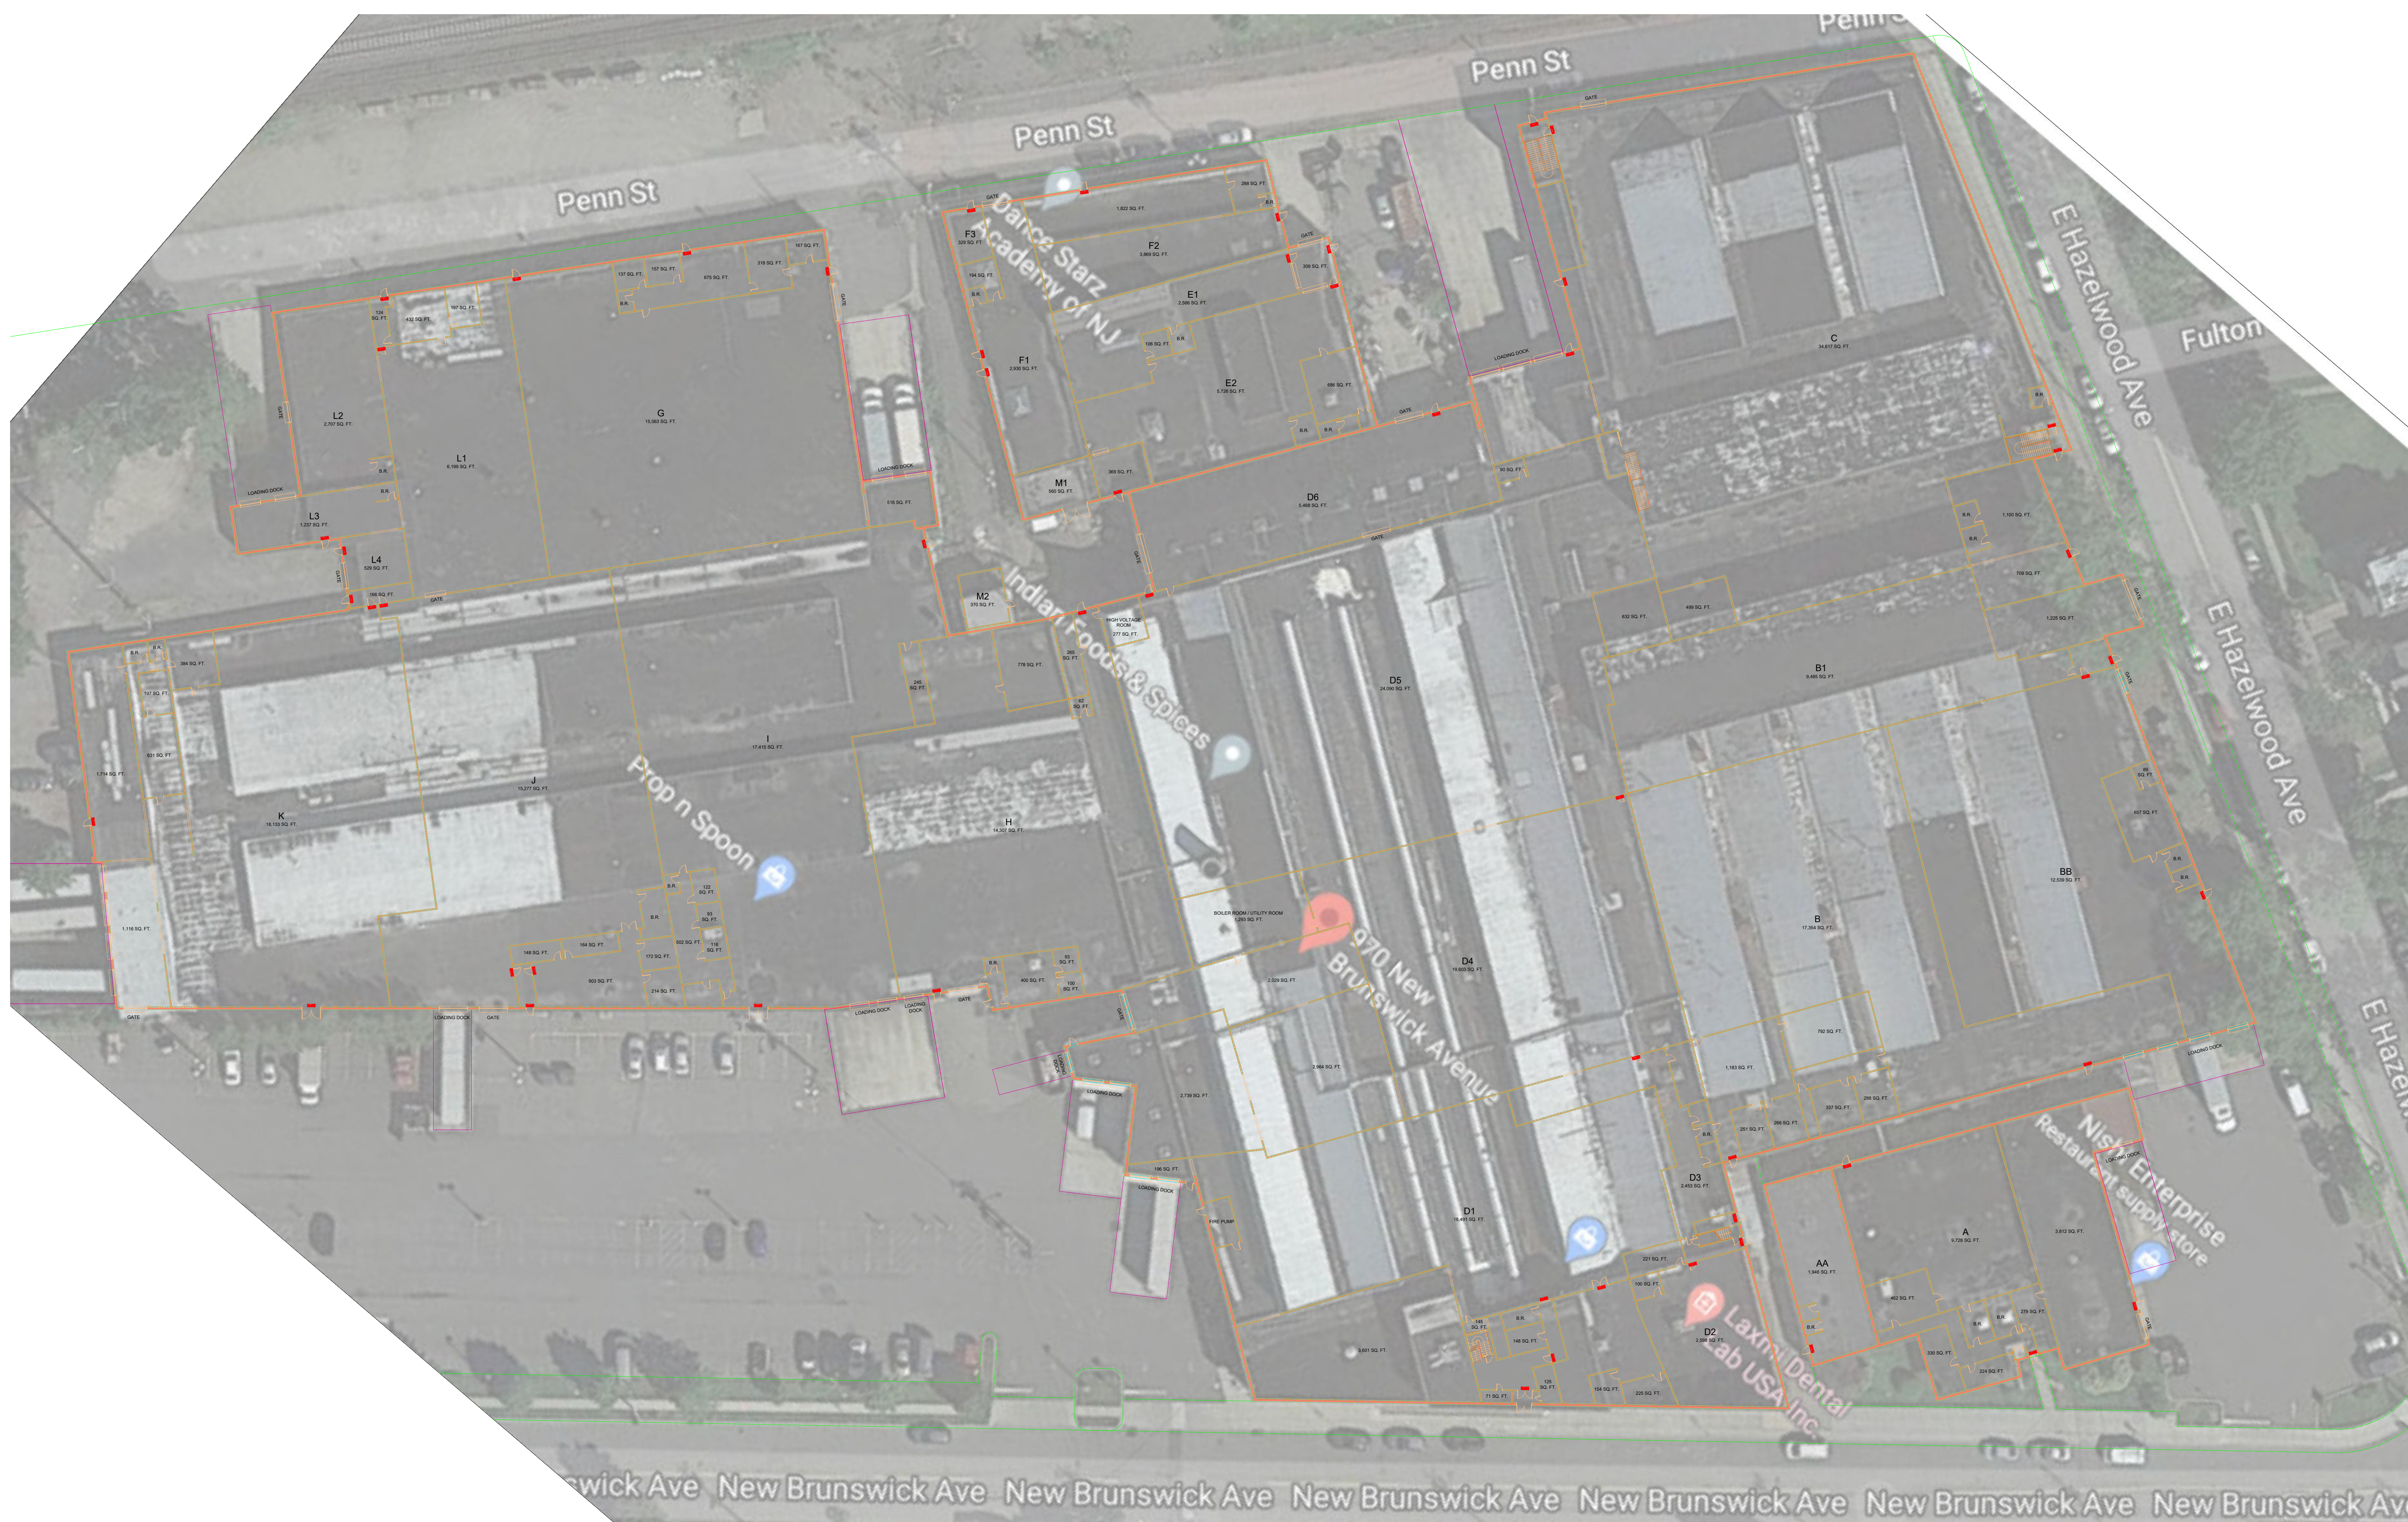

SITE PLAN FIRST FLOOR
267,551 TOTAL SQ.FT.
SCALE: N.T.S.