


N:\0\25115-00\_Deerbrook Shopping Center\400\_CD\420\_WORKING\_AUTOCAD\423\_SBUILT\251010\_ASBuilt\_Brewingz.dwg plotted by Natalia Beltran on 2025-10-27 at 4:31 PM

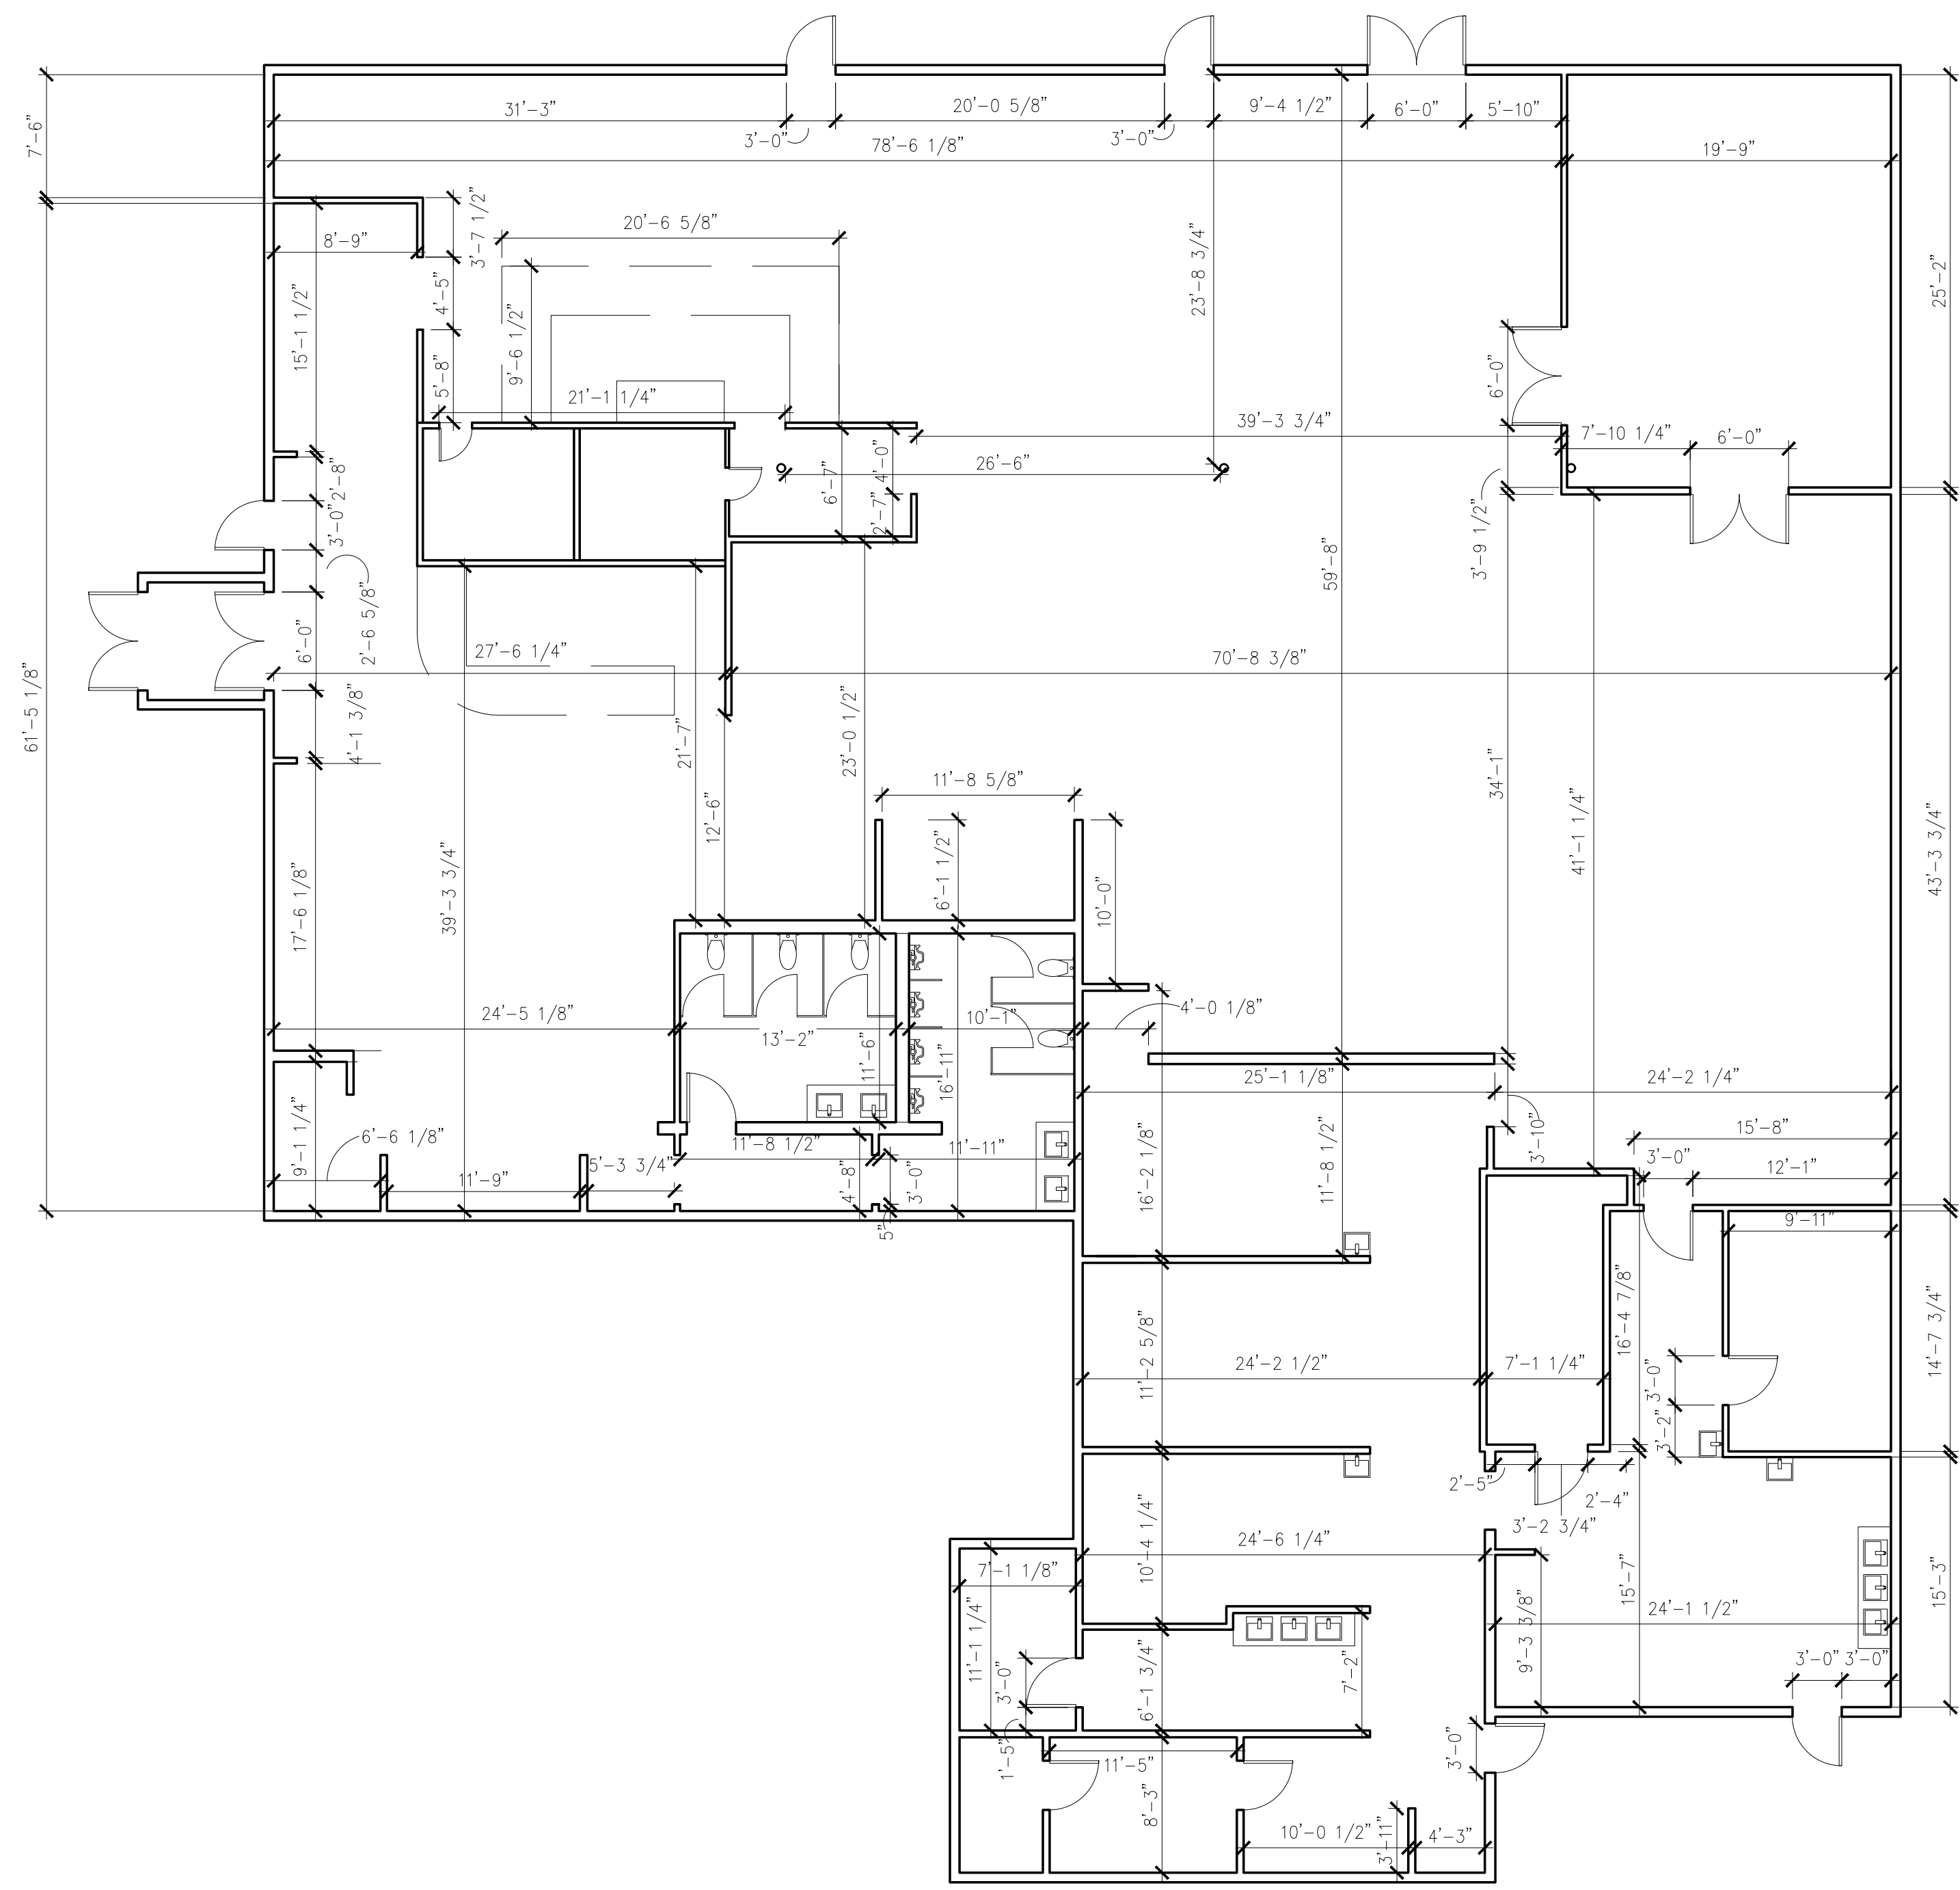

251010 - BREWINGZ

AREA: 8990.85 SQ. FT.




111 TRAVIS STREET  
HOUSTON TX 77002  
713.595.2150  
www.identityarchitects.com

THIS DRAWING IS FOR PRESENTATION PURPOSES ONLY. ANY AND ALL FEATURES, MATTERS AND OTHER INFORMATION DEPICTED HEREON OR CONTAINED HEREIN ARE FOR ILLUSTRATIVE MARKETING PURPOSES ONLY. ARE SUBJECT TO MODIFICATION WITHOUT NOTICE. ARE NOT INTENDED TO BE RELIED UPON BY ANY PARTY AND ARE NOT INTENDED TO CONSTITUTE REPRESENTATIONS AND WARRANTIES AS TO THE SIZE AND NATURE OF IMPROVEMENTS TO BE CONSTRUCTED (OR THAT ANY IMPROVEMENTS WILL BE CONSTRUCTED) OR AS TO THE IDENTITY OR NATURE OF ANY OCCUPANTS THEREOF.

AS-BUILT - Brewingz

October 17, 2025  
25115-00 DEERBROOK SHOPPING CENTER

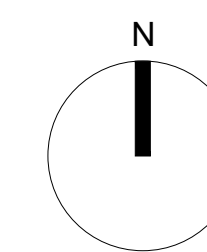

Scale: 1/8" = 1'-0"

