

Property Key



A small map showing the location of the property within a larger building complex. The property is highlighted in blue. The map includes labels for 'HOFFNER AVENUE' and 'S SEMORAN BOULEVARD'. A north arrow is also present.

Alt Springs As Built Marketing Package


5842-5856 S Semoran Blvd, Orlando, FL 32809, US

Building: C

Suite: 5848-5

Sheet **E1**

Scale: Not to Scale
Sheet Size: 42" x 30"
Not For Construction

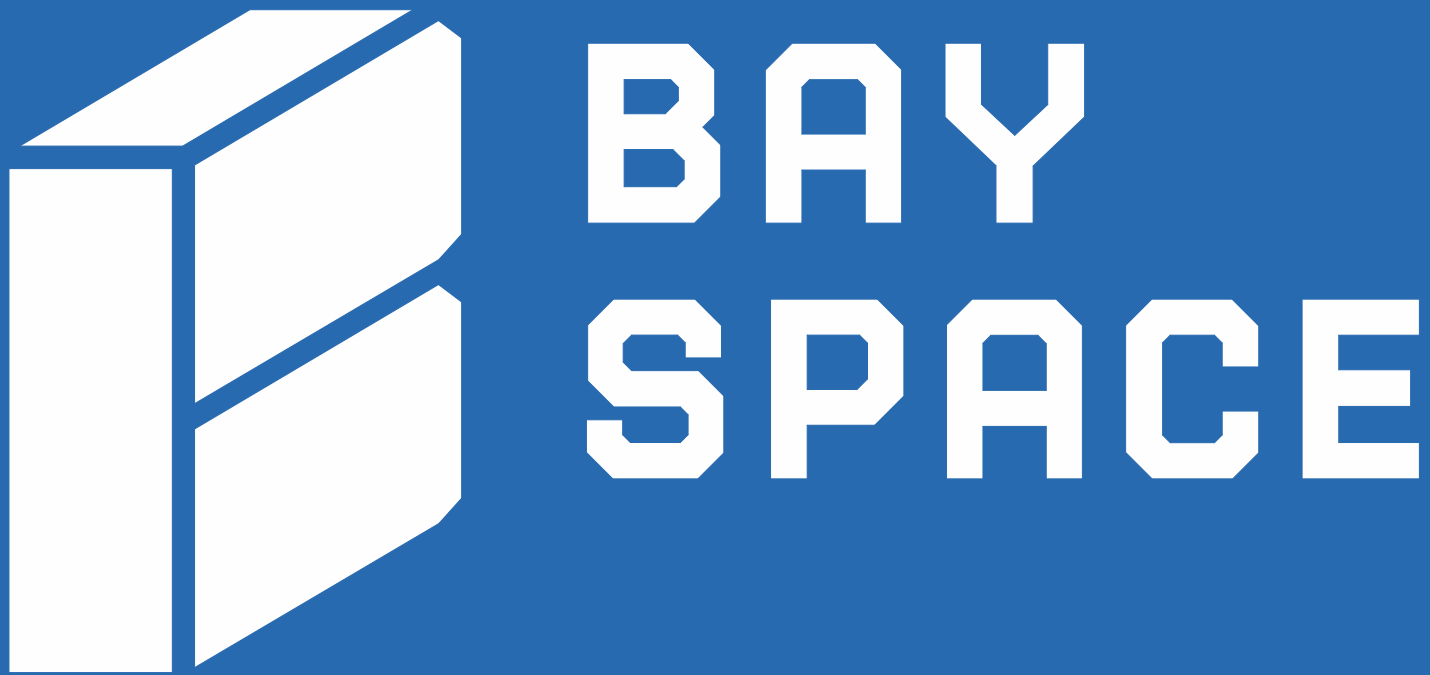

Usable Square Foot Analysis

Office Area	3,598	100 %
Warehouse Area	0	0%
Total Area	3,598	

Building Information

Deck Height:	14' - 10"
Clear Height:	7' - 9"
Ceiling Height:	7' - 9"
Sprinklered:	☐ Yes ☒ No
Mechanical Area:	7 SQFT

