

GENERAL NOTES

THIS PLAN WAS PREPARED BY ANDRIPOLLO'S DESIGN ASSOC. ARCHITECT'S, LLC DOCUMENTING EXISTING CONDITIONS. THIS PLAN IS DIAGNOSTIC AND FOR ZONING PURPOSES ONLY. NO RESPONSIBILITY IS EXPRESSED OR IMPLIED BY THE ARCHITECT FOR THIS STRUCTURE OR ITS IMPROVEMENTS.

NO	DATE	ISSUED/ REVISION
1	11/14/12	ISSUE FOR ZONING & CONSERVATION REVIEW

THIS DRAWING IS THE PROPERTY OF ANDRIPOLLO'S DESIGN ASSOCIATES AND IS NOT TO BE REPRODUCED OR USED IN PART OR IN WHOLE IS STRICTLY PROHIBITED.

Client:
MULLER INDUSTRIAL PARK
1 MILLER AVENUE
NORWALK, CT

Project:
EXISTING & AS-BUILT CONDITIONS
1 MILLER AVENUE
NORWALK, CT

Drawing Title:
EXISTING CONDITIONS -
SPACE #1 - VACANT
SPACE #2 - PARK MAINTENANCE
SPACE #3 - FALLON LANDSCAPING
SPACE #4 - MILLER PARK REALTY OFFICE

Scale: AS NOTED Drawing No: **EX-1**


Date: 11/7/12

Drawn By: PGR

Project No: 10-129





Andriopoulos Design Associates, LLC
32 Main Street, Suite 203
Norwalk, Connecticut 06851
203-853-8006 203-855-7567 fax
E-MAIL: ADAARCHITECTS@NET.net

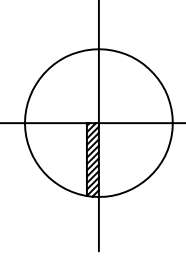

EXISTING CONDITIONS - FIRST FLOOR PLAN

SCALE: 1/8" = 1'-0"
140,151.5 SF. (GRCS6)

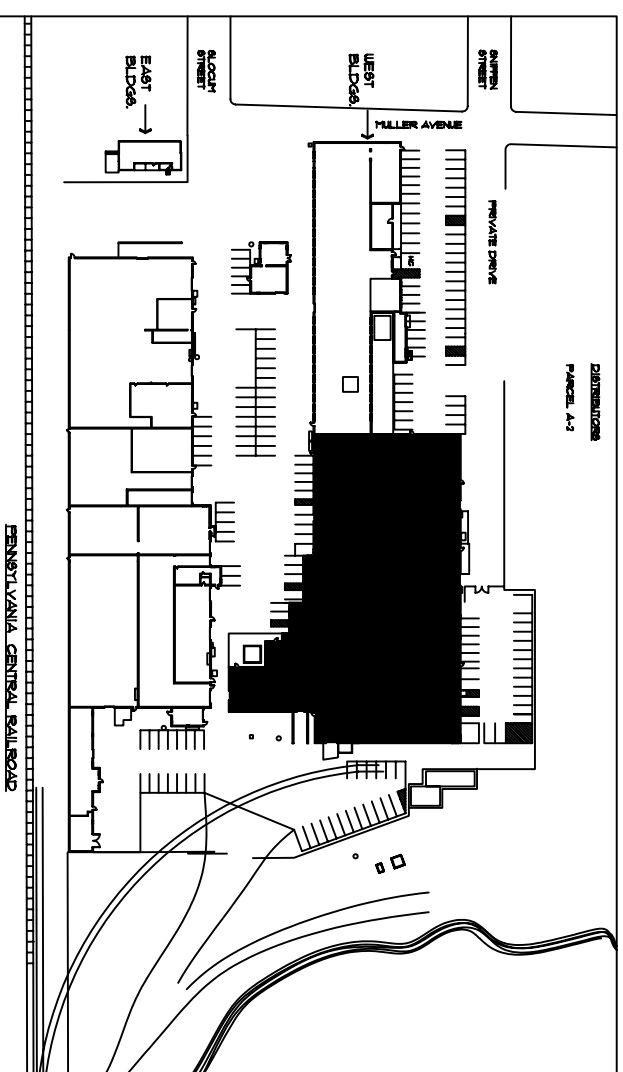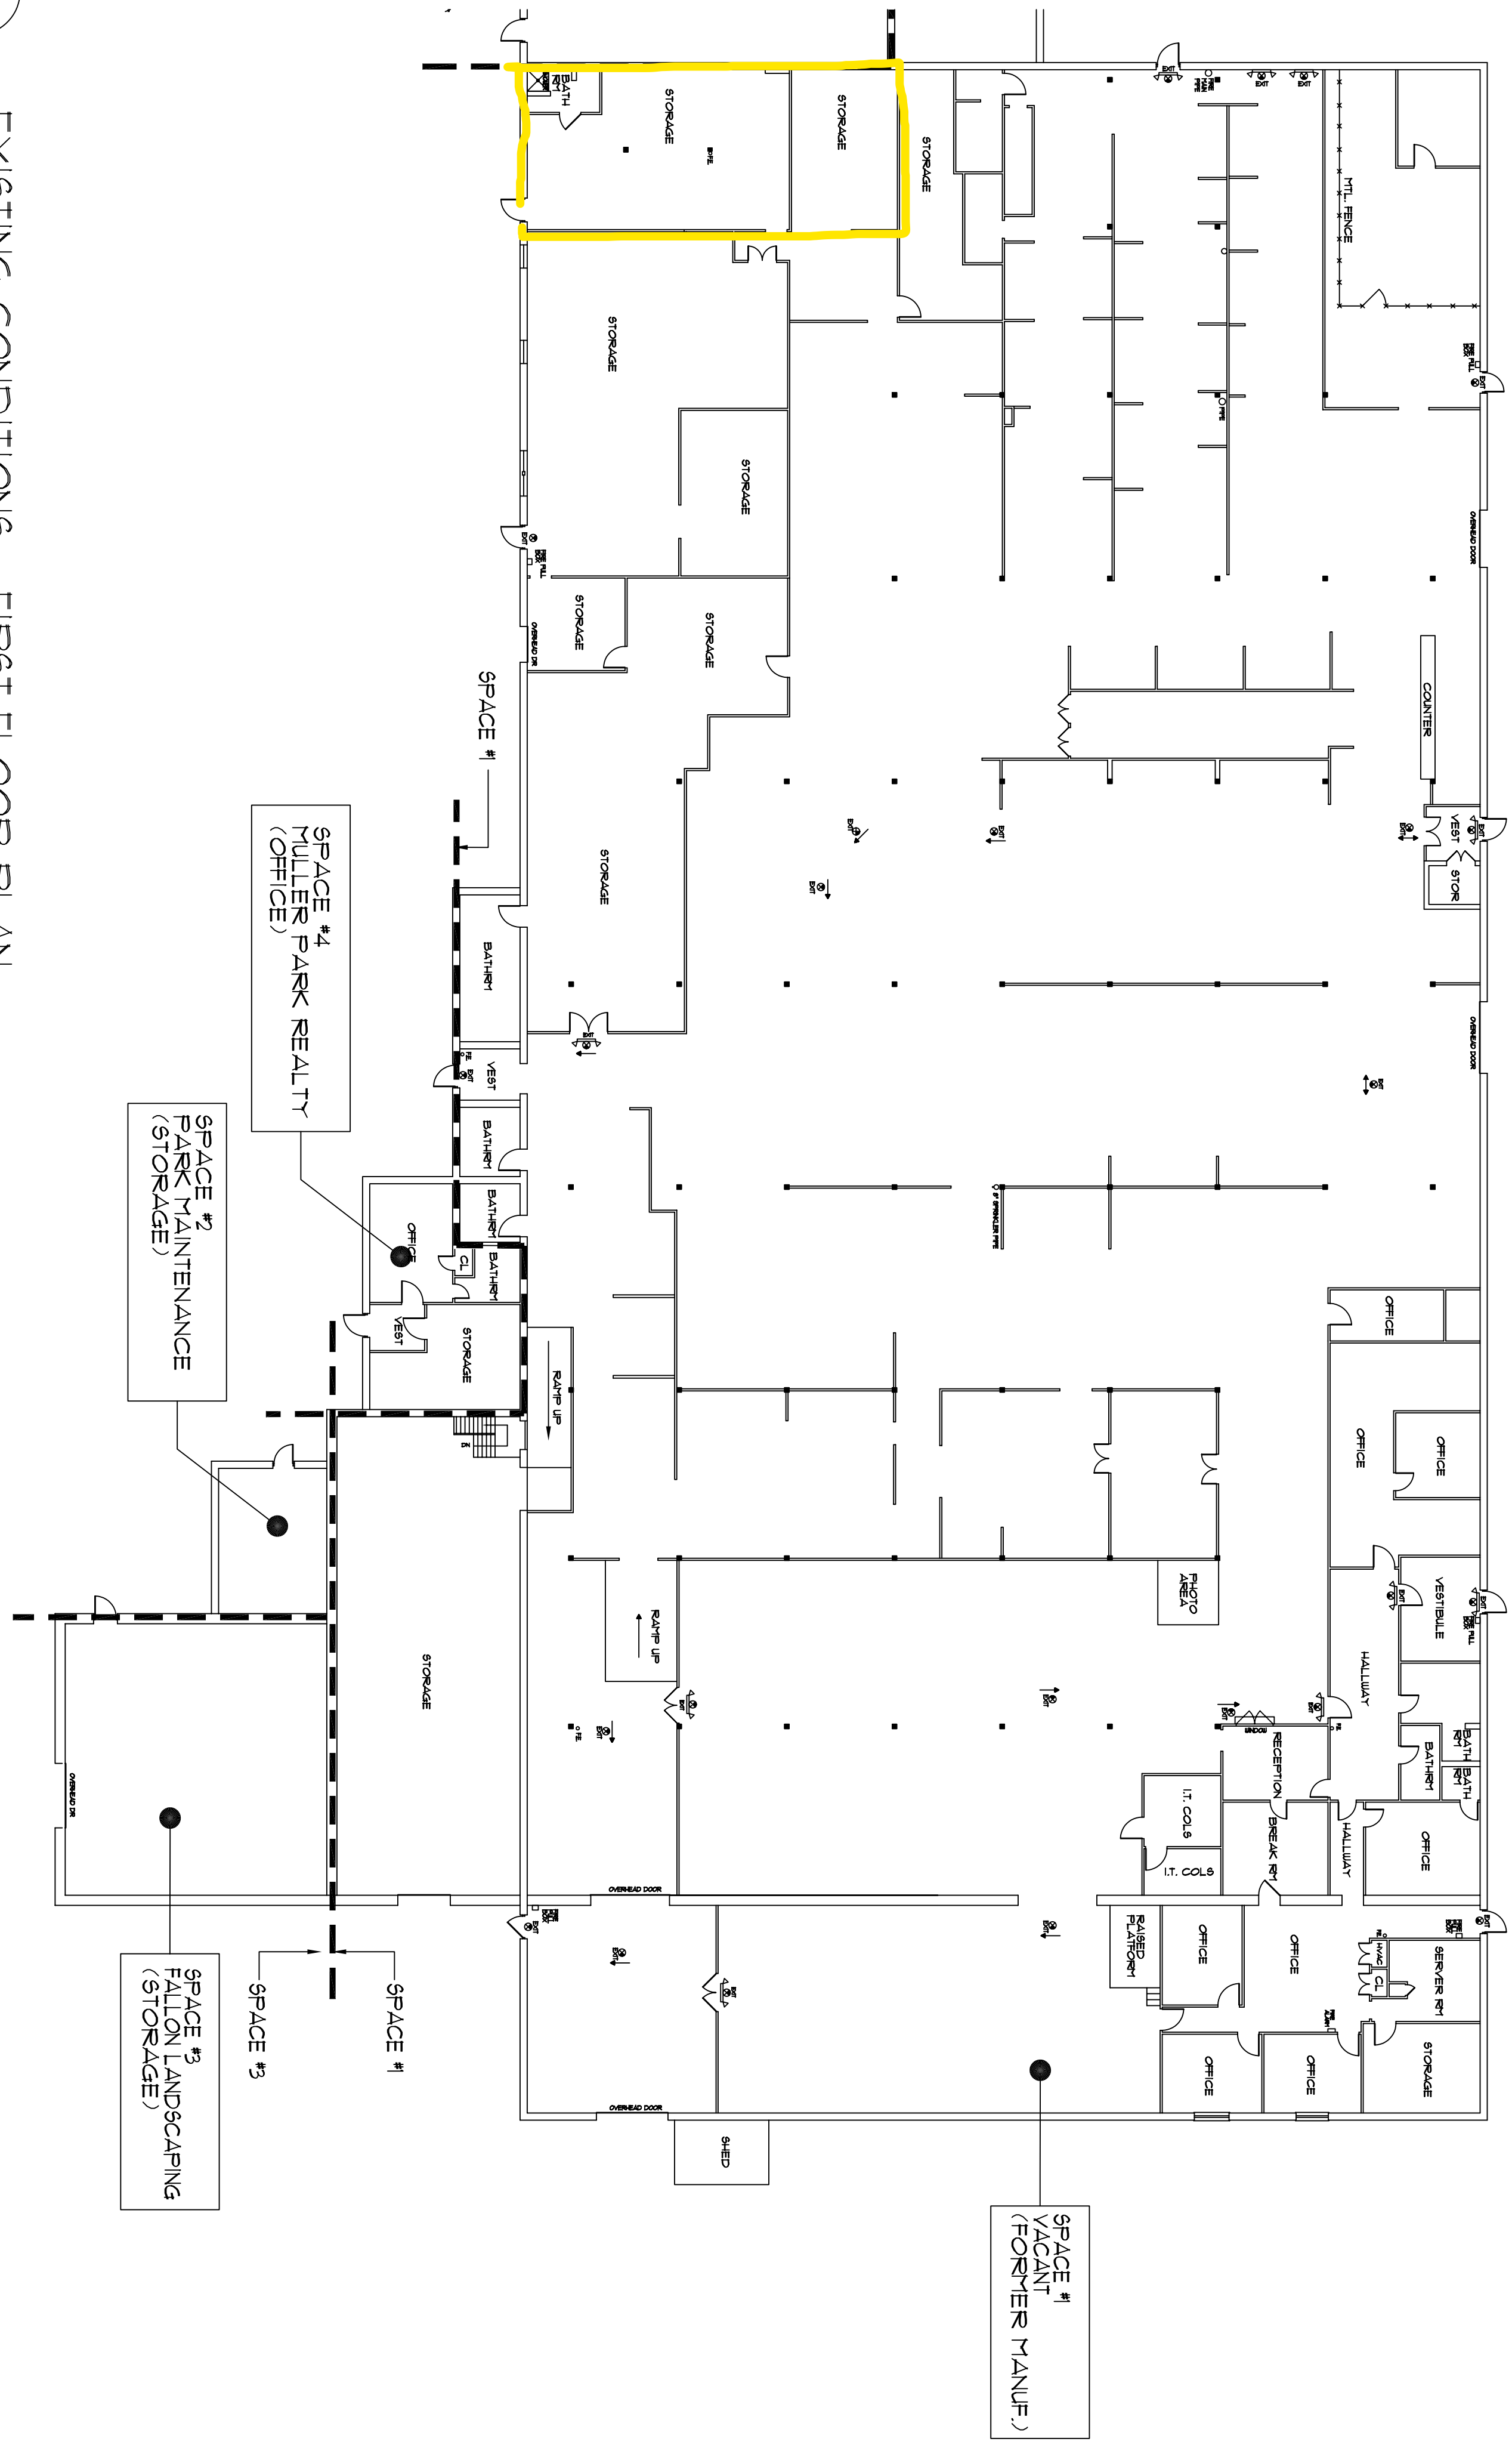

KEY PLAN

SCALE: NTS