
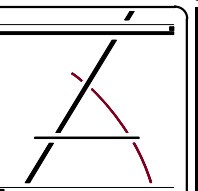


E:\2023\2023 TENANT\2023 MARKETPLACE AT PINHOOK\08 Create\p1\ARCH\212 MARKETPLACE AT PINHOOK.dwg

1 PARTIAL FLOOR PLAN

SCALE: 1" = 20'-0"

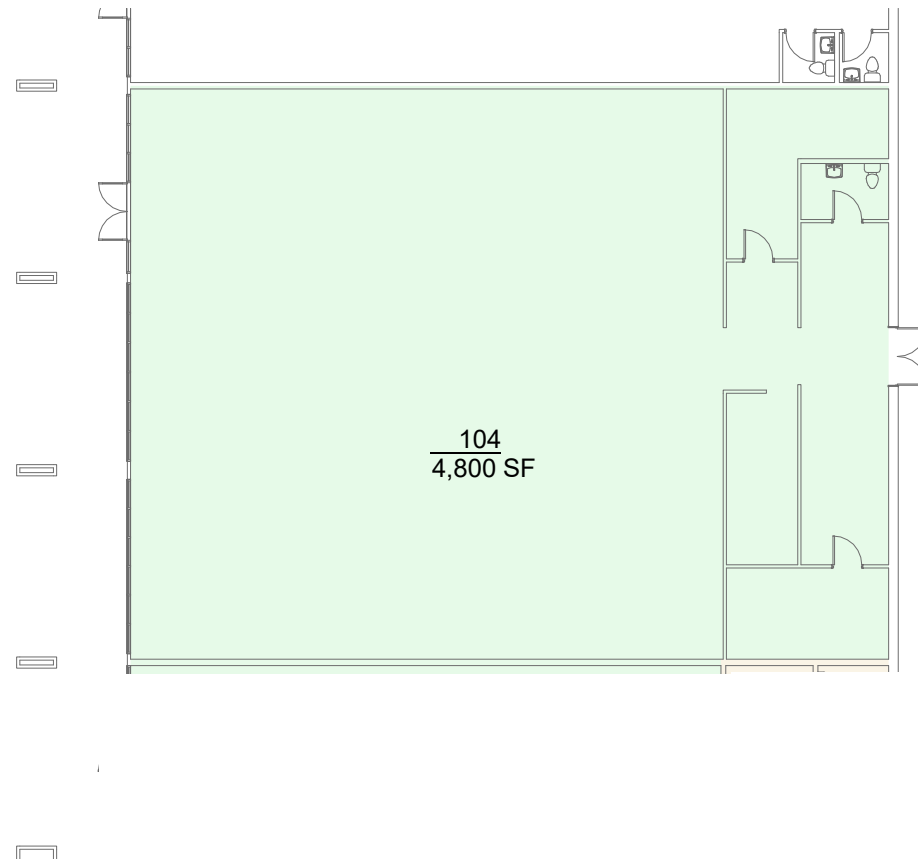

ZILER
ARCHITECTS
A PROFESSIONAL
ARCHITECTURAL
CORPORATION


JAMES O. ZILER, ARCHITECT
SEAN R. PRIMEAUX, ARCHITECT
101 Calco Boulevard
Lafayette, Louisiana 70503
Ph: 337-269-6326
10610 Florida Boulevard
Walker, Louisiana 70785
Ph: 225-424-6990
www.zilerarchitects.net

DOCUMENTS PREPARED BY ZILER ARCHITECTS ARE INSTRUMENTS OF THE ARCHITECT'S SERVICE FOR USE SOLELY WITH RESPECT TO THIS PROJECT. THE ARCHITECT SHALL RETAIN ALL COMMON LAW, STATUTORY AND OTHER RESERVED RIGHTS, INCLUDING THE COPYRIGHT. THEY ARE NOT TO BE USED BY THE CONTRACTOR OR ANY SUBCONTRACTOR, MATERIAL OR EQUIPMENT SUPPLIERS OR ANYONE FOR OTHER PROJECTS OR FOR ADDITIONS TO THIS PROJECT OUTSIDE THE SCOPE OF THE WORK WITHOUT THE SPECIFIC WRITTEN CONSENT OF ZILER ARCHITECTS.

RECORD DRAWINGS FOR:

MARKETPLACE AT PINHOOK

JAMES COMEAUX ROAD
LAFAYETTE, LA 70508

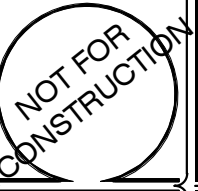

DATE ISSUED	04/03/23
REVISED	-
PLOT DATE	04/03/23 9:06:29 AM
DRAWN BY	SRP
CHECKED BY	SRP
PROJECT NO.	2214-A
SHEET NO.	AC1.1
	OF